
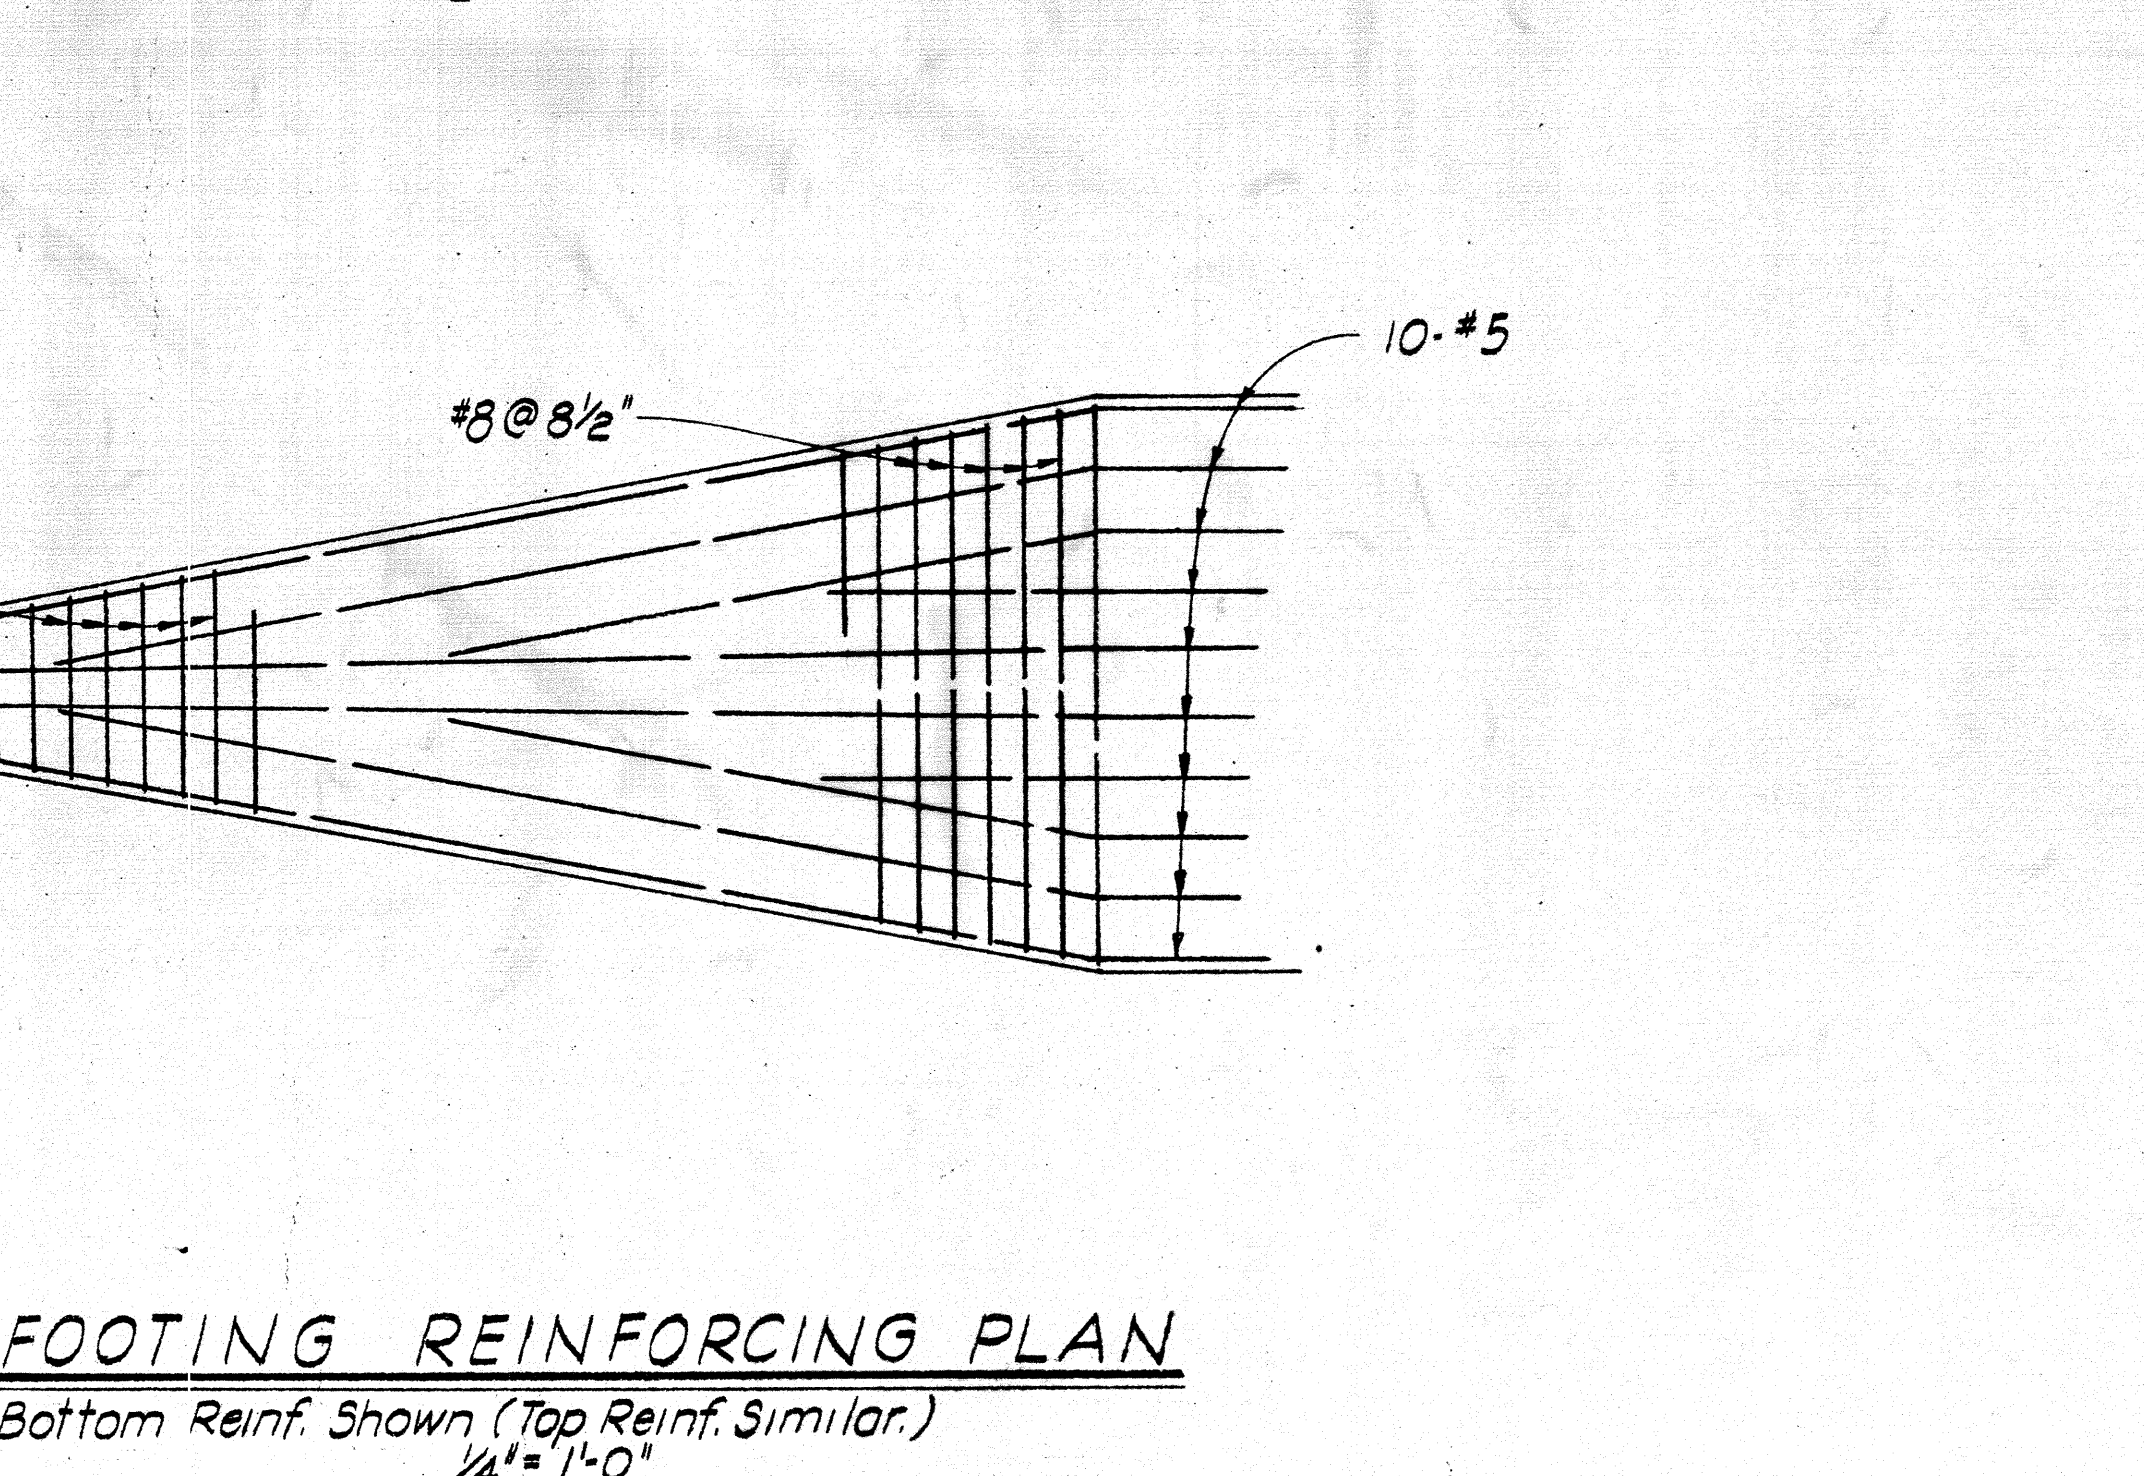
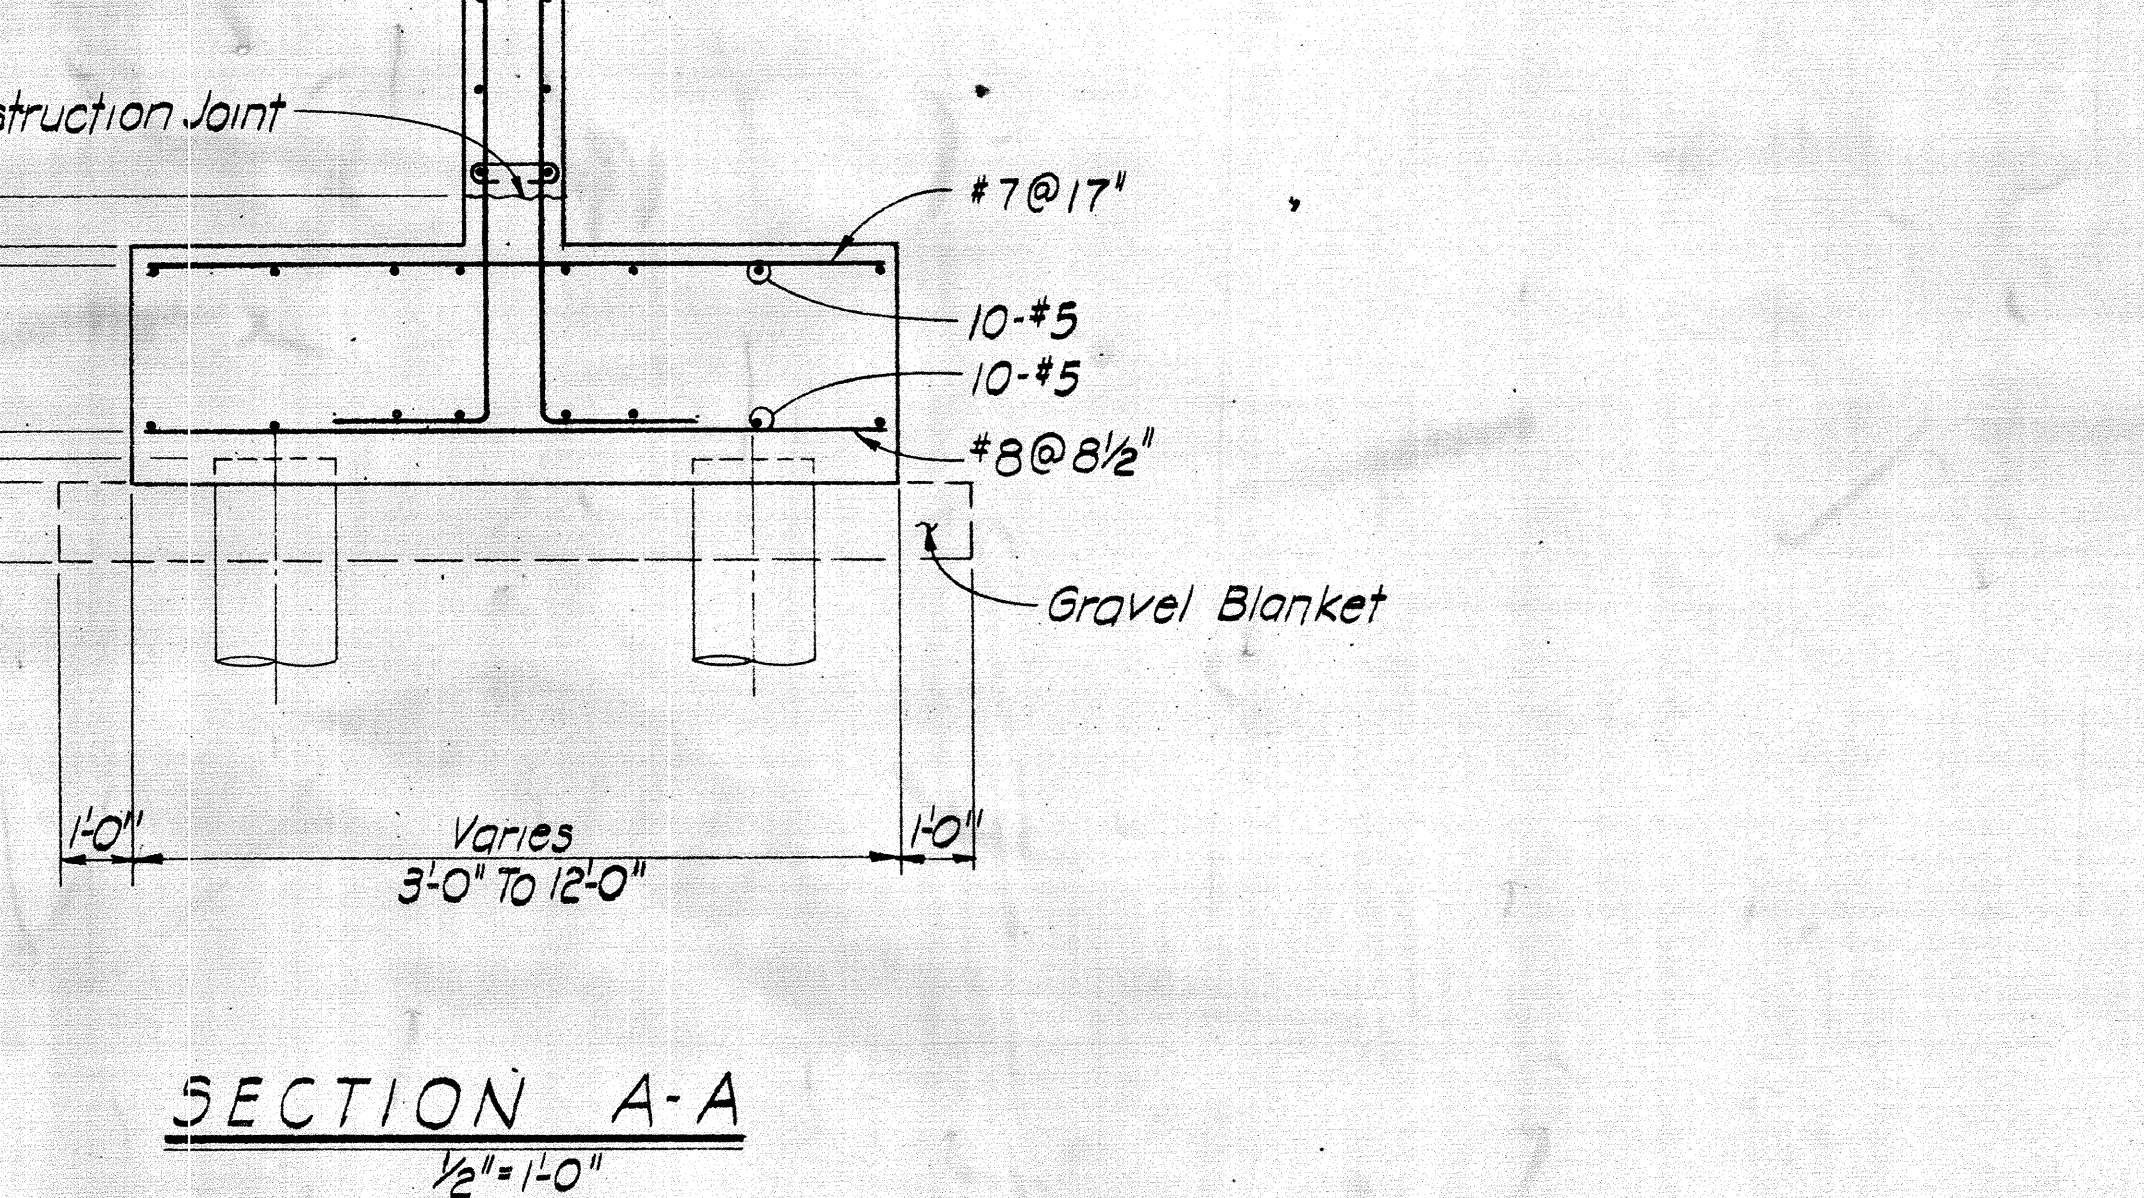
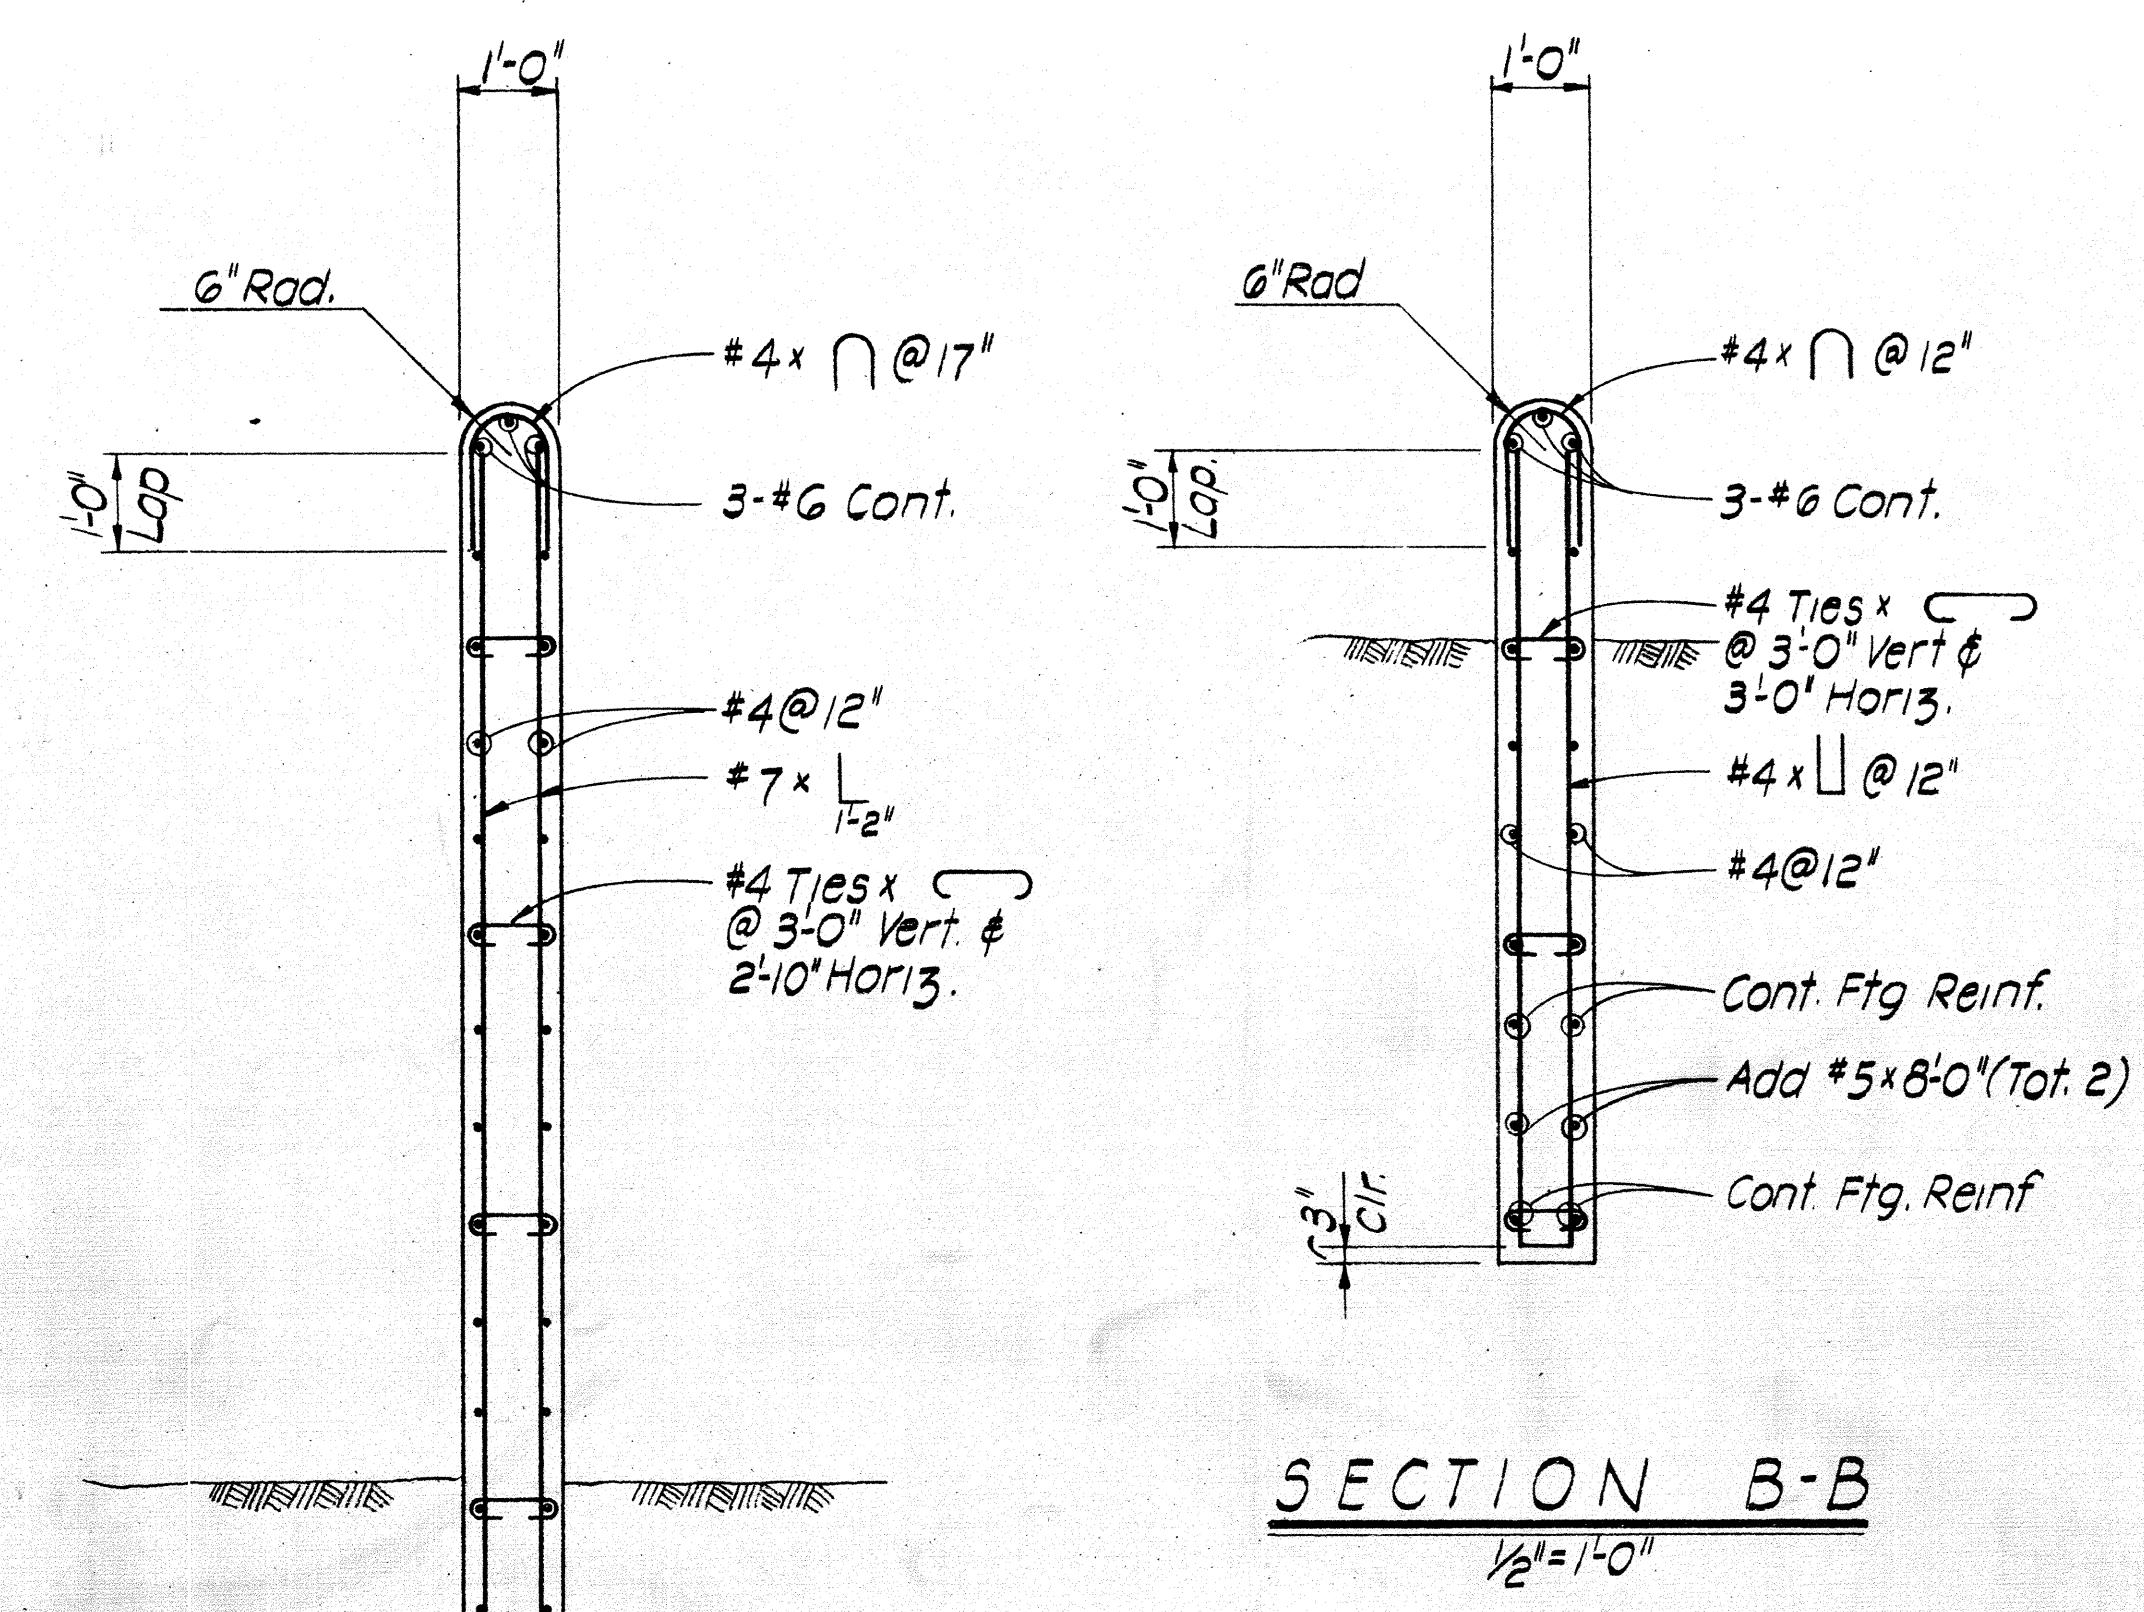
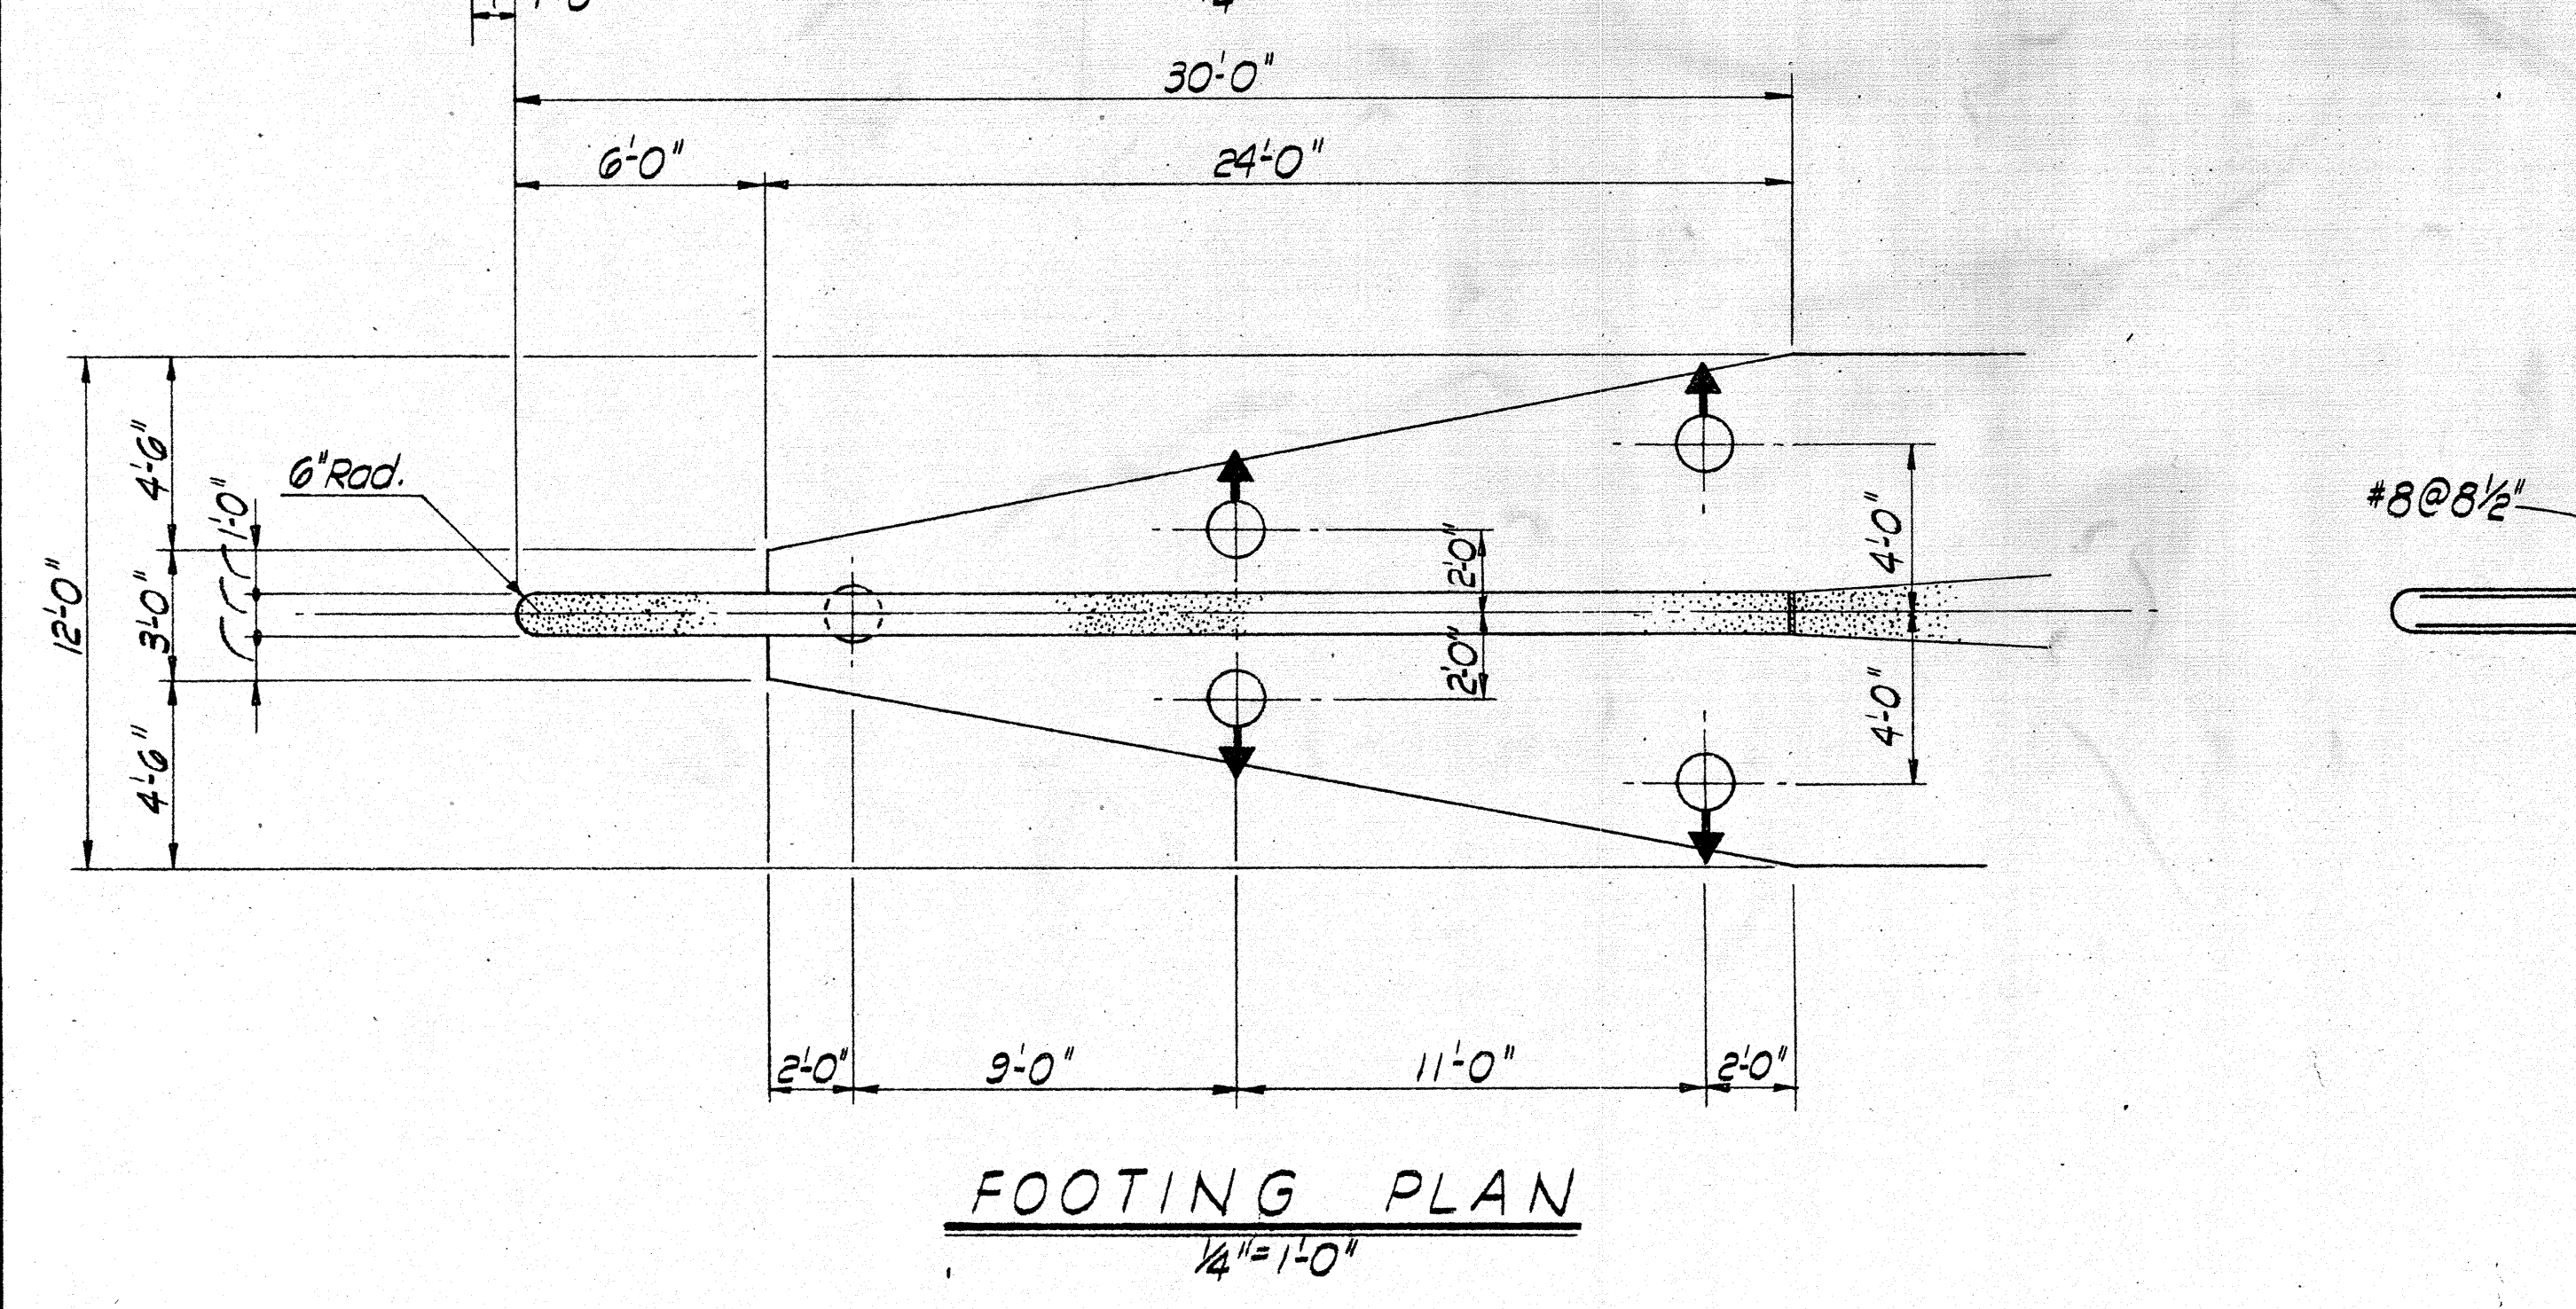
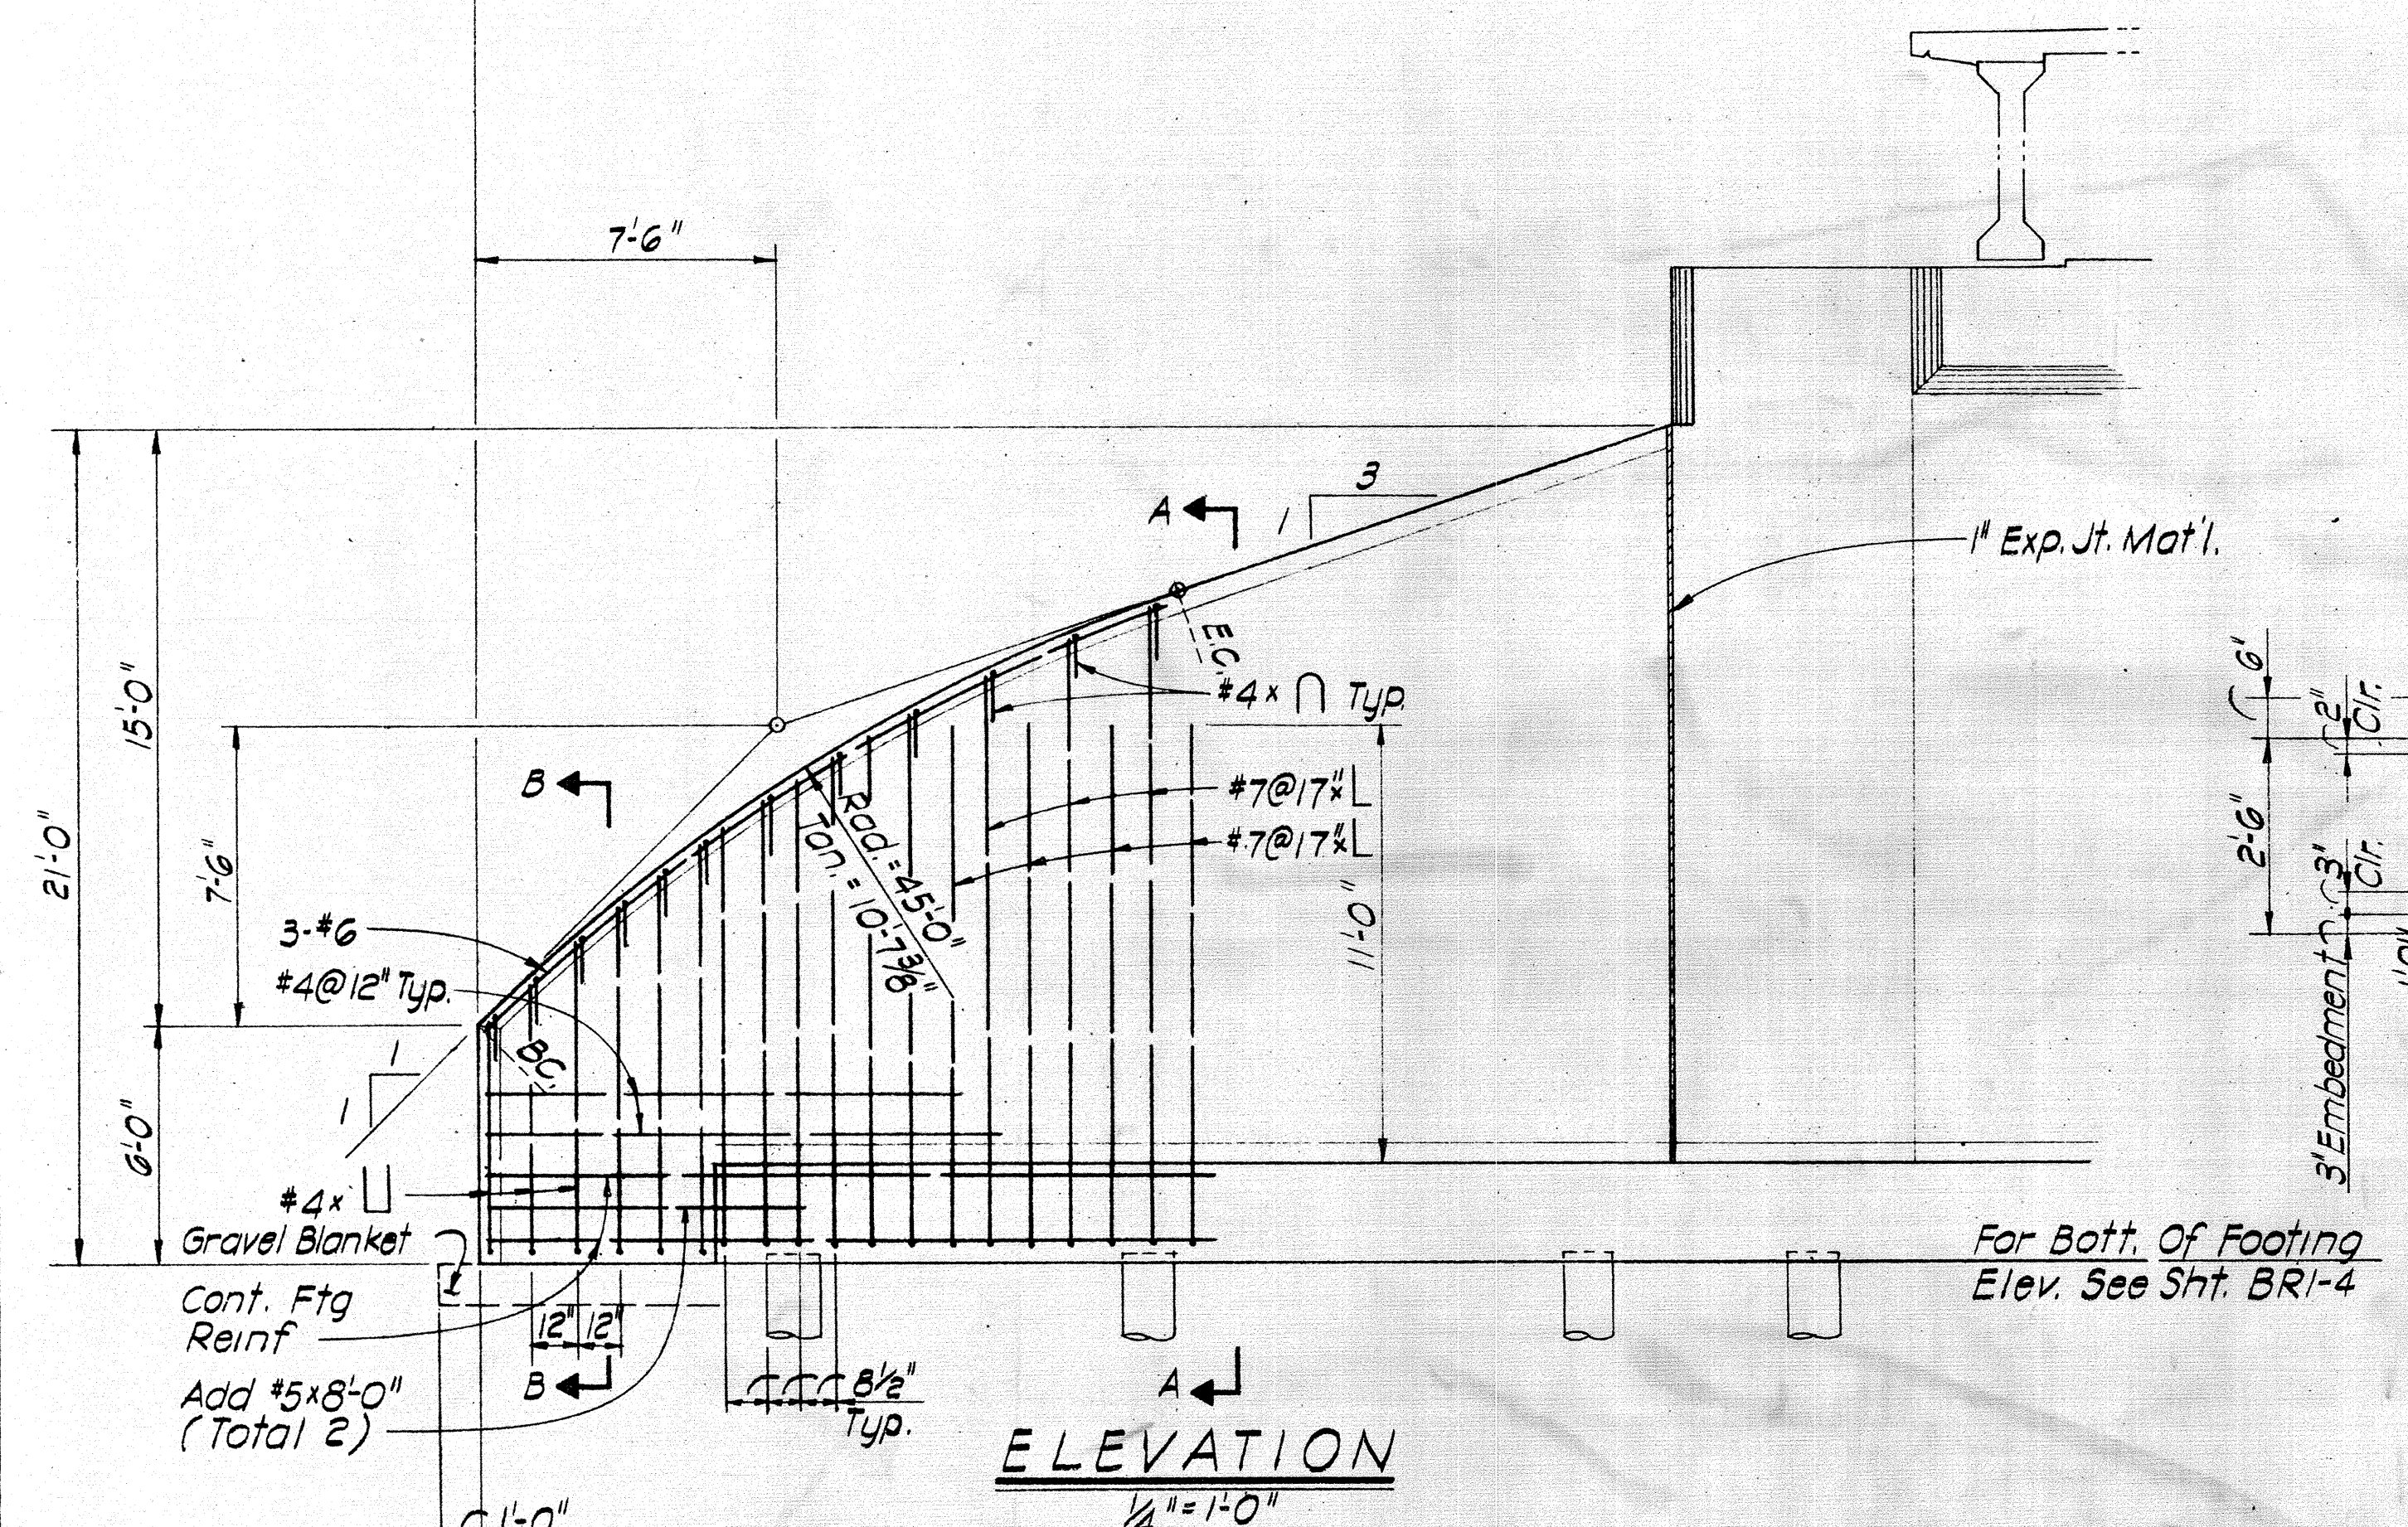


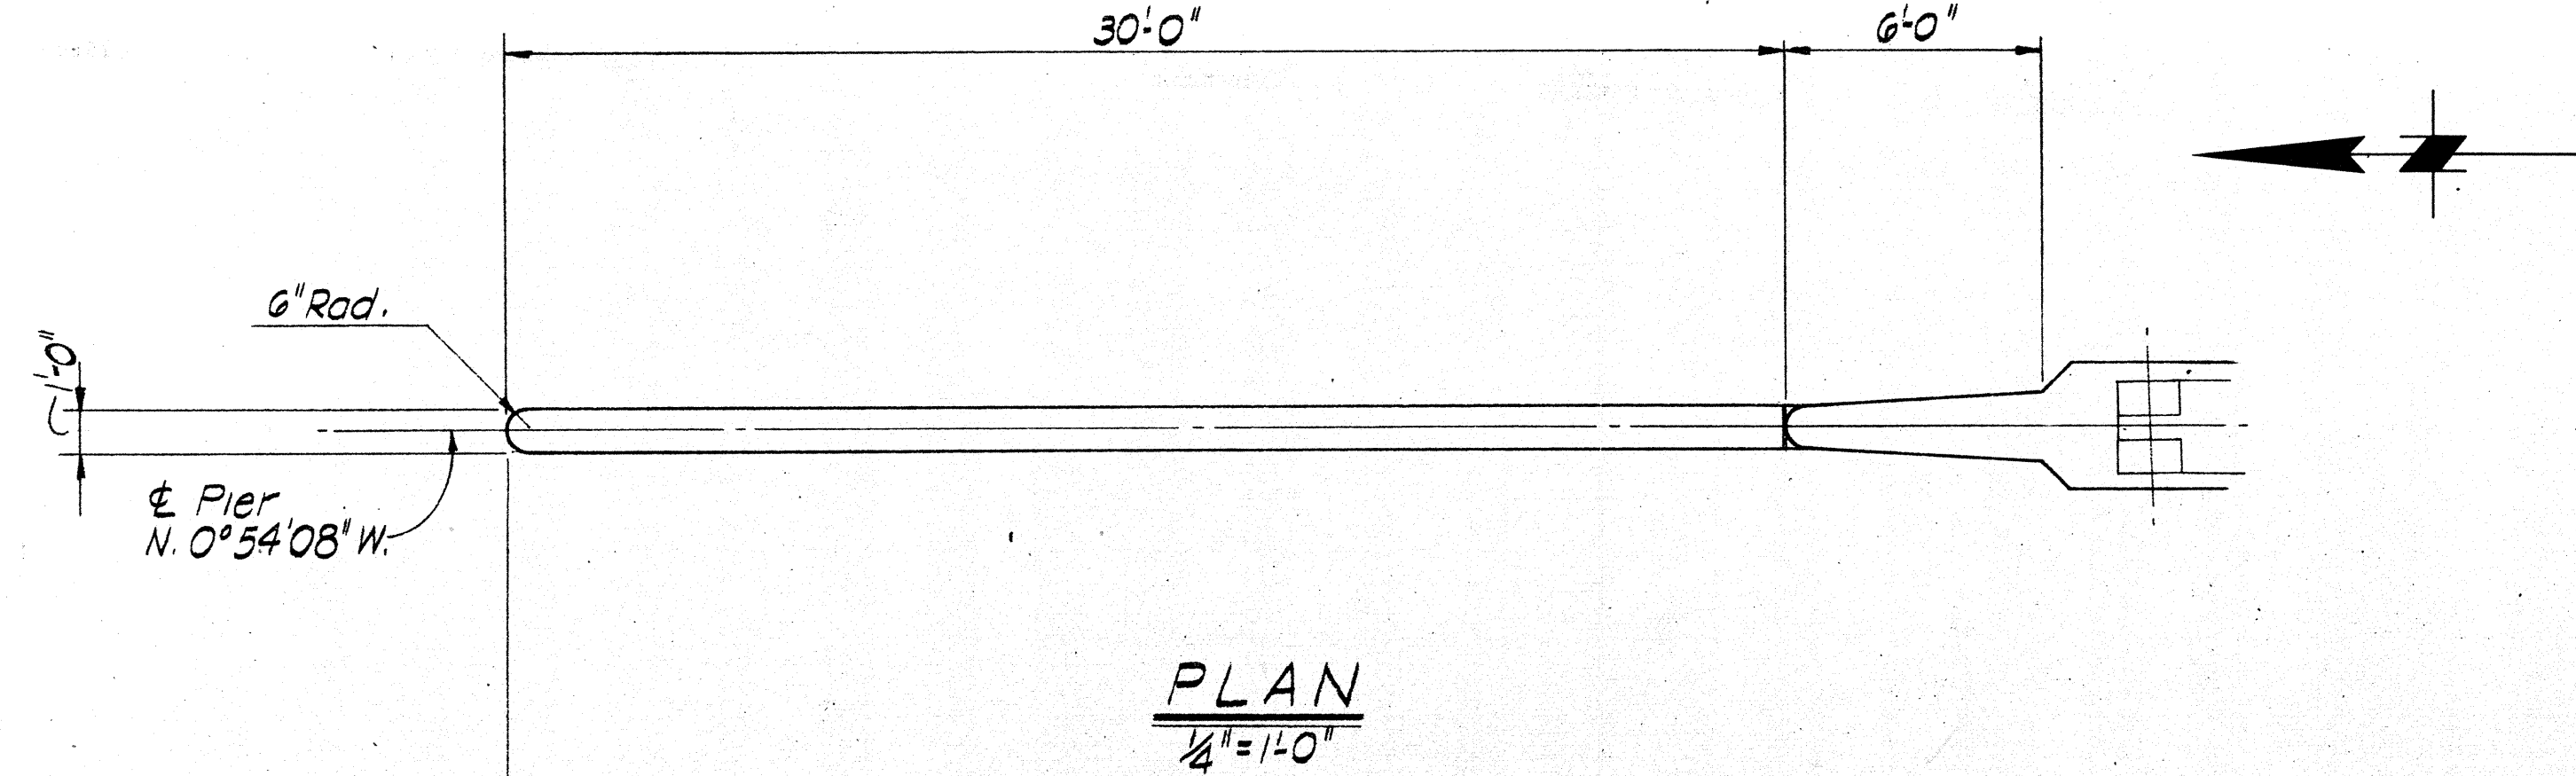

LEGEND

○ Indicates Vertical Pile
←○ Indicates Batter 3:1/2 In Direction of Arrow

NOTE:
Cement For Debris Nosing Concrete Shall Be Type II

ORANGE COUNTY ROAD DEPARTMENT	
MICHELSON DRIVE BRIDGE (SD-25) ACROSS SAN DIEGO CREEK	
DEBRIS NOSINGS	
SCALE: Noted	SHEET BRI-5 OF 14

OFFICE: 1100 N. GARDEN ST., LONG BEACH, CALIF. 90801
 MICHELSON ENGINEERS
 LONG BEACH, CALIFORNIA