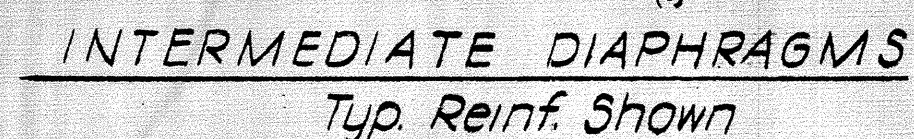
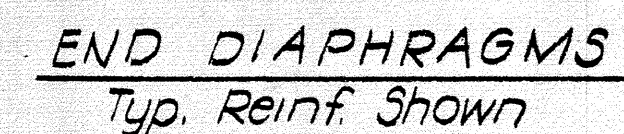


Looking East
1/4" = 1'-0"


$$\frac{1}{4}'' = 1'-0''$$
