


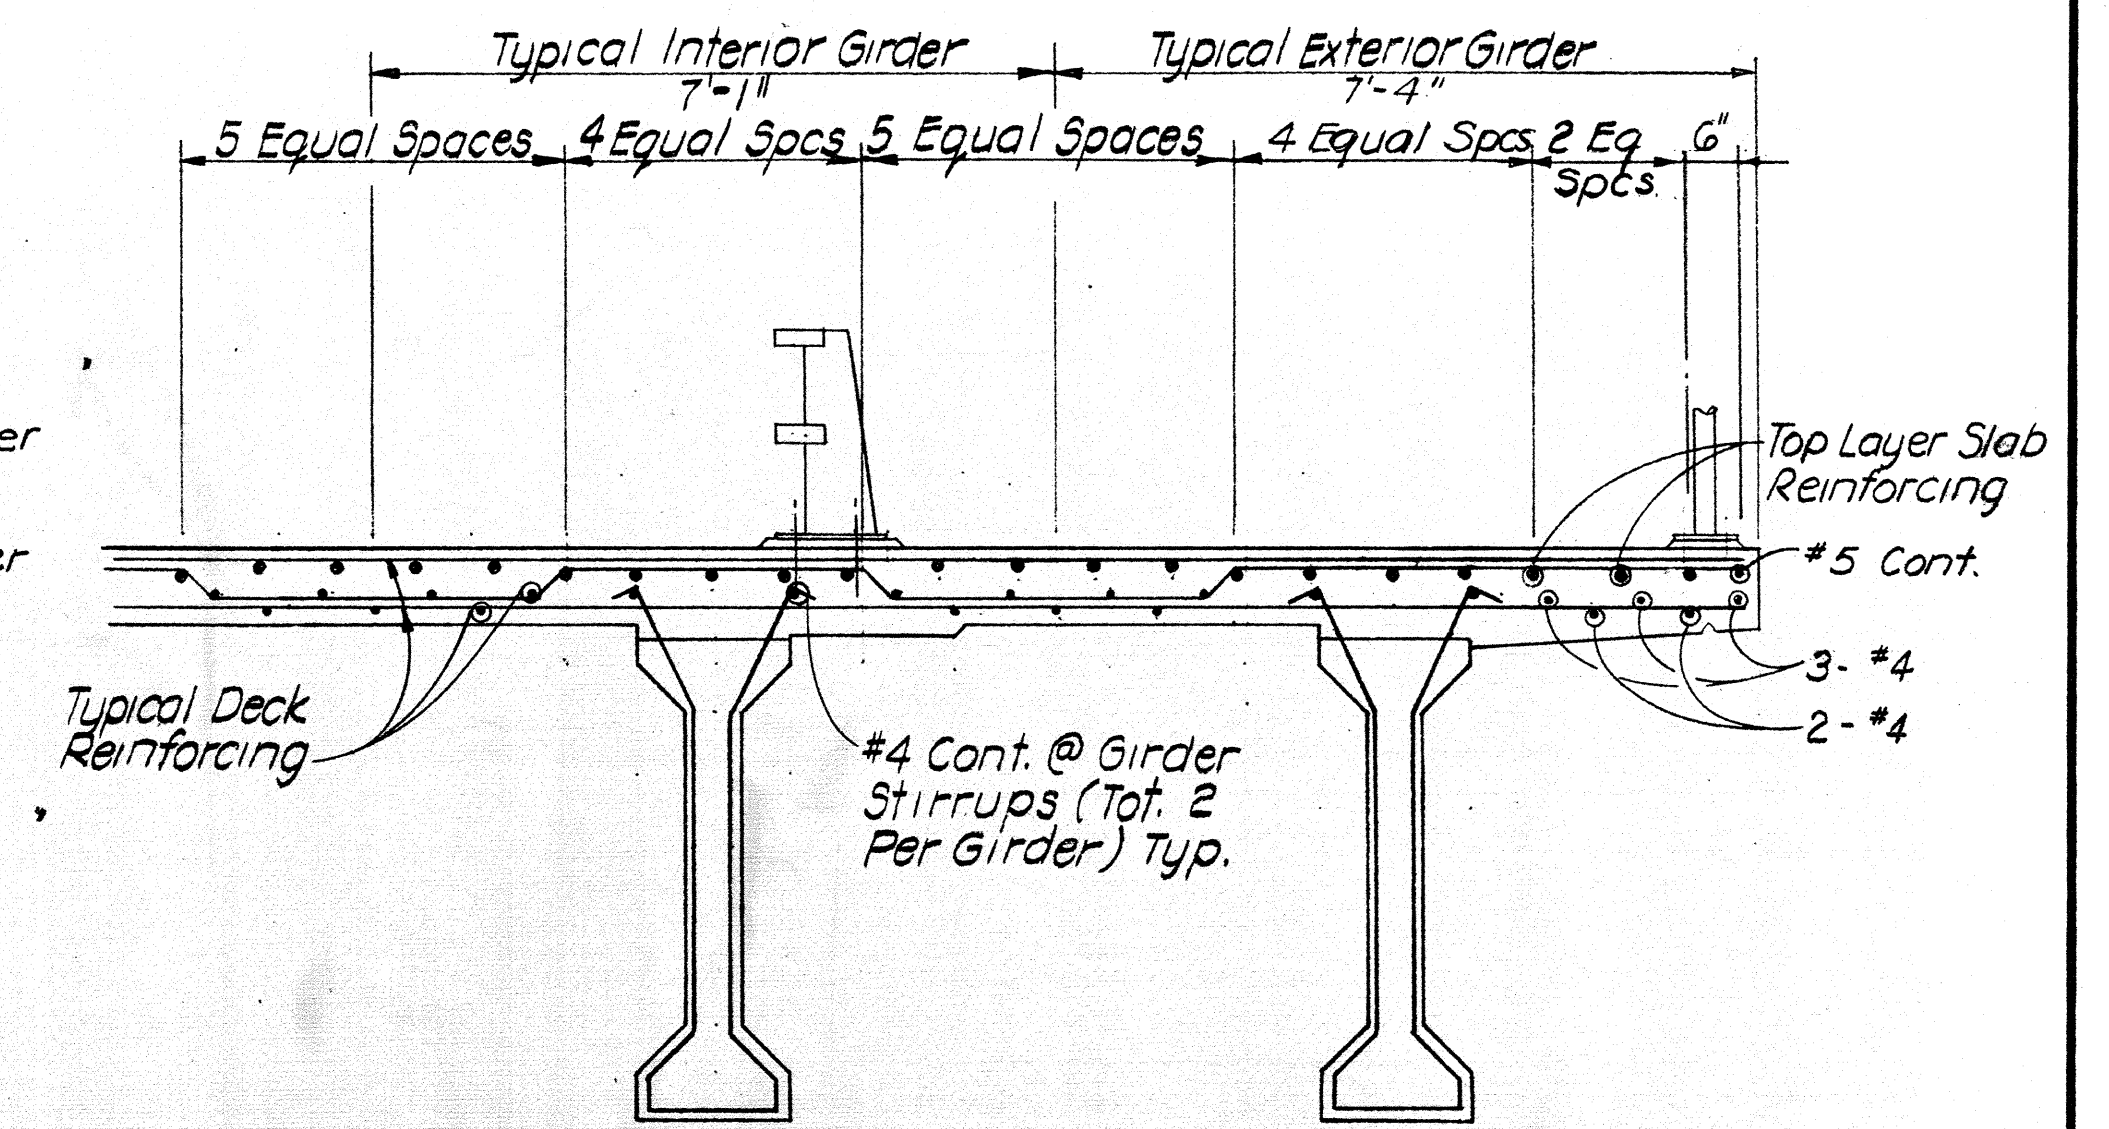

Scale: Vert 1"=2'
Horiz 1"=20'