
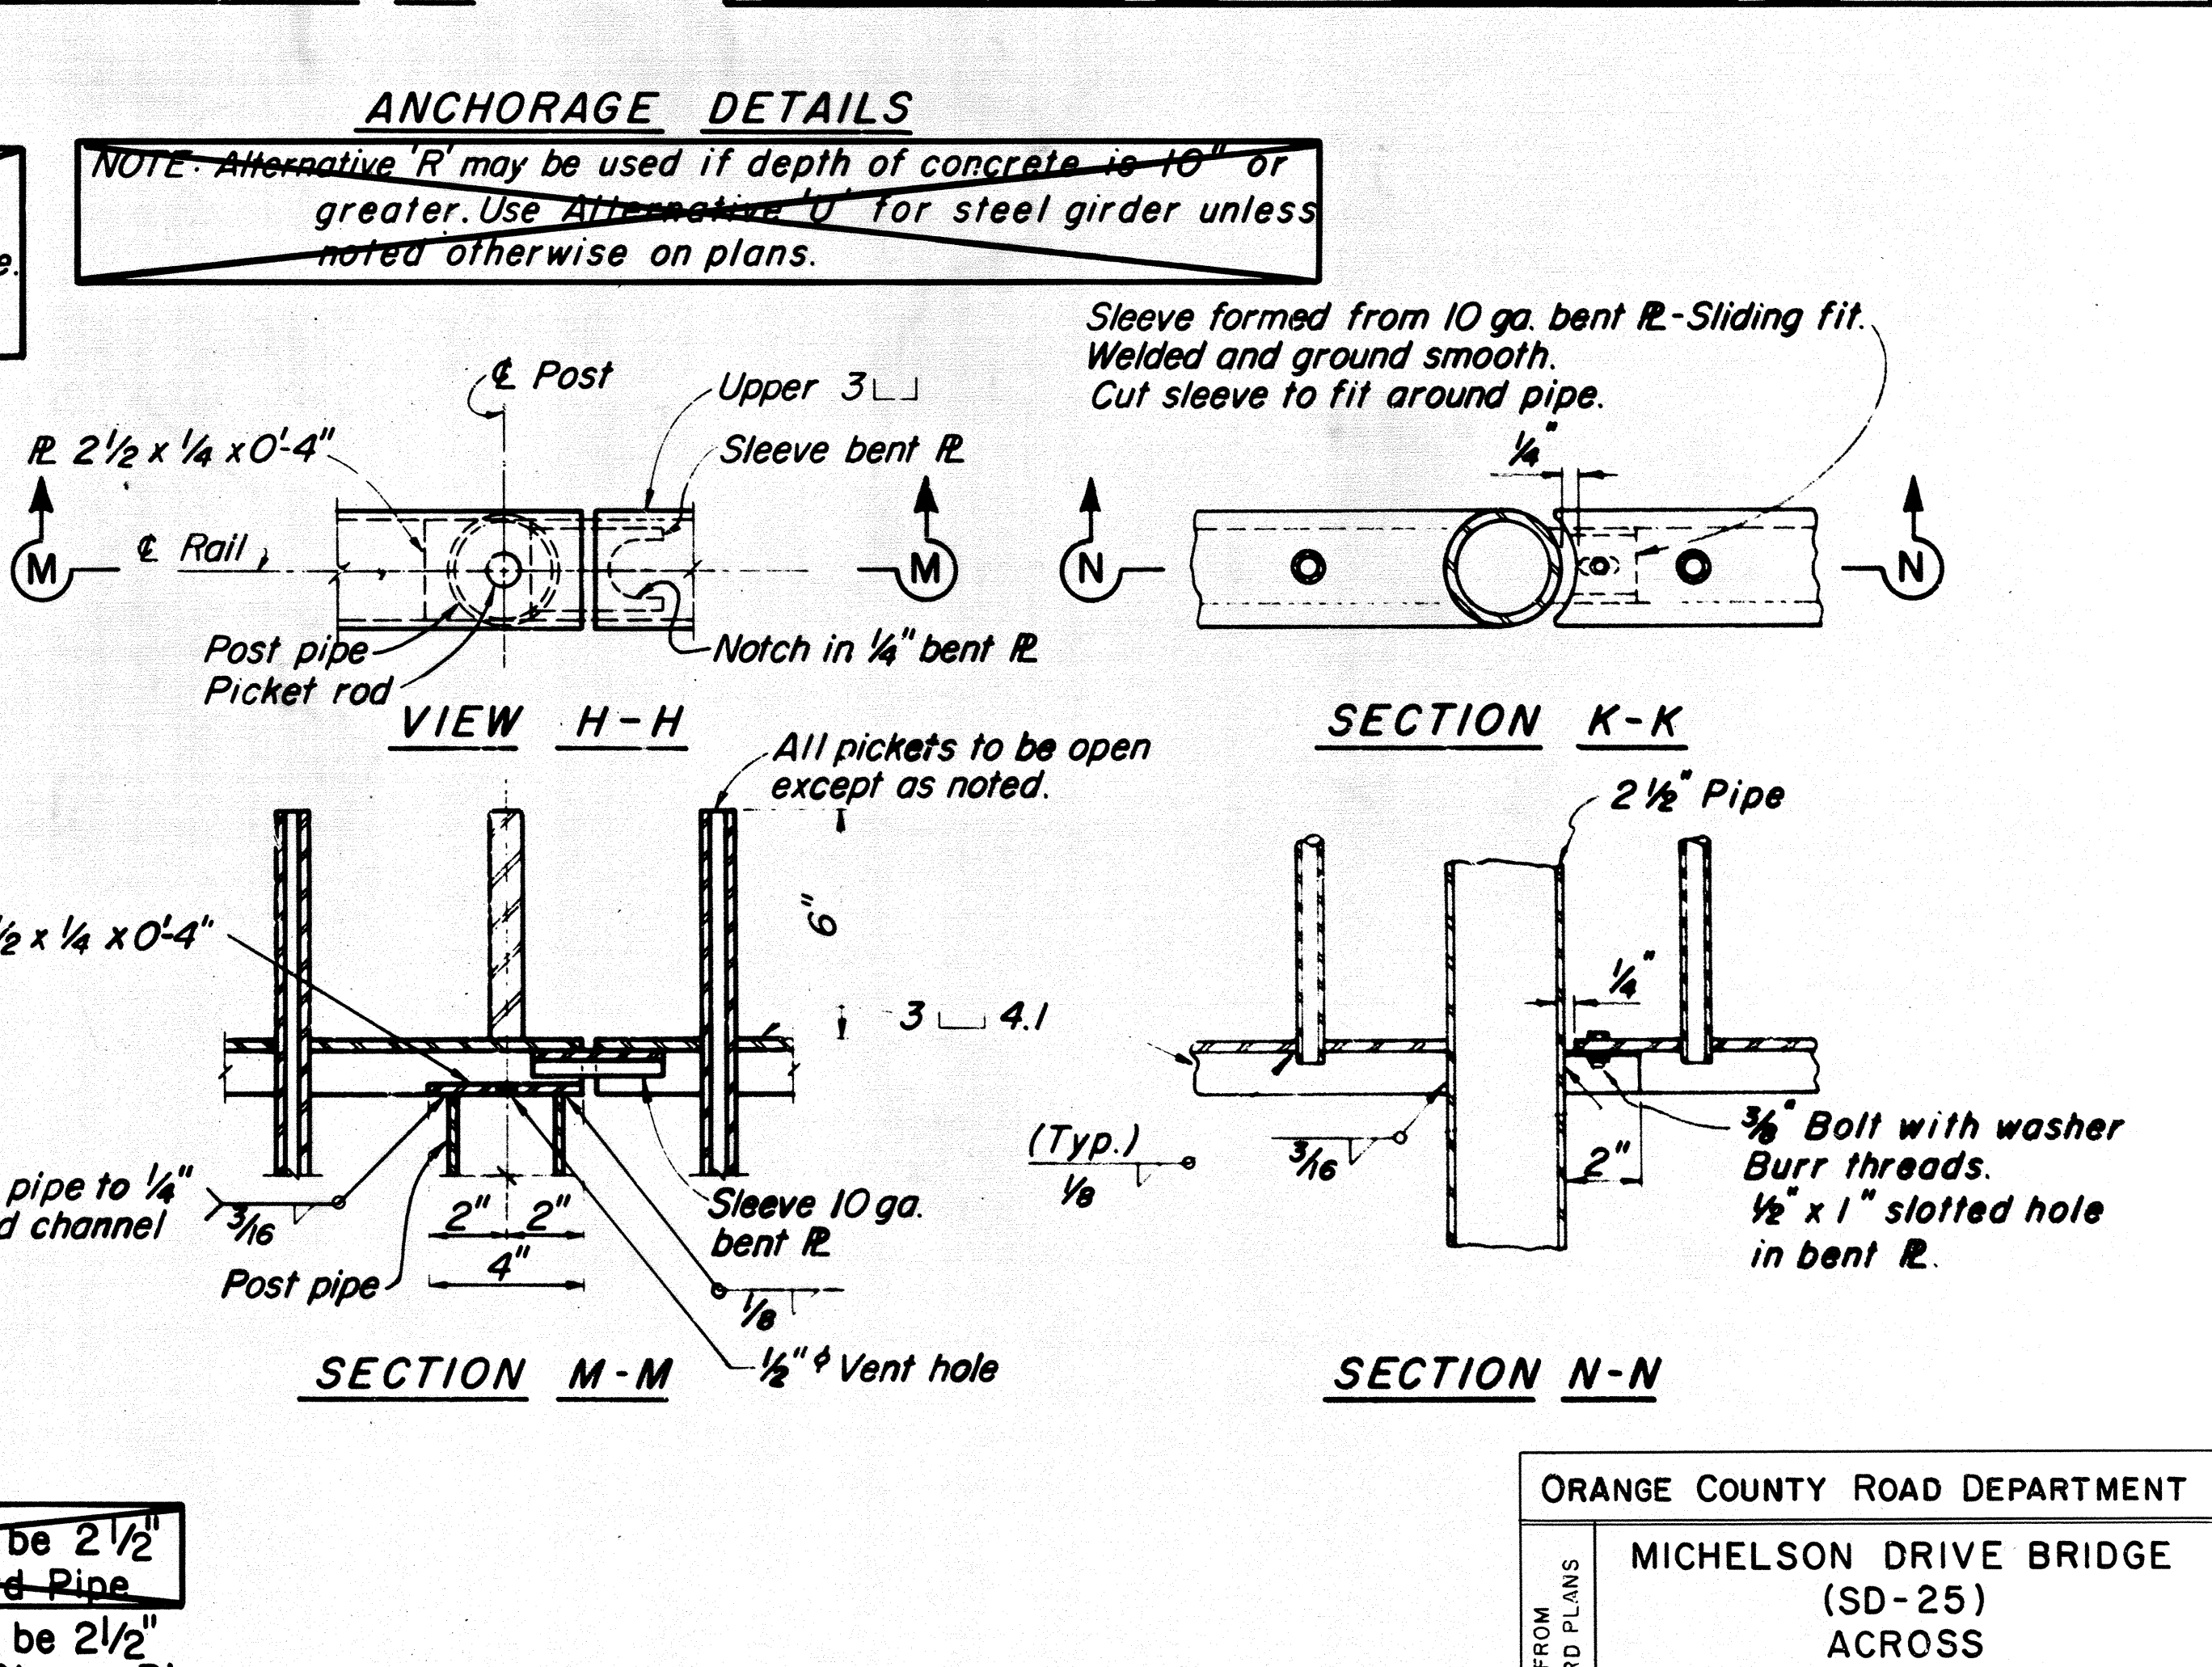
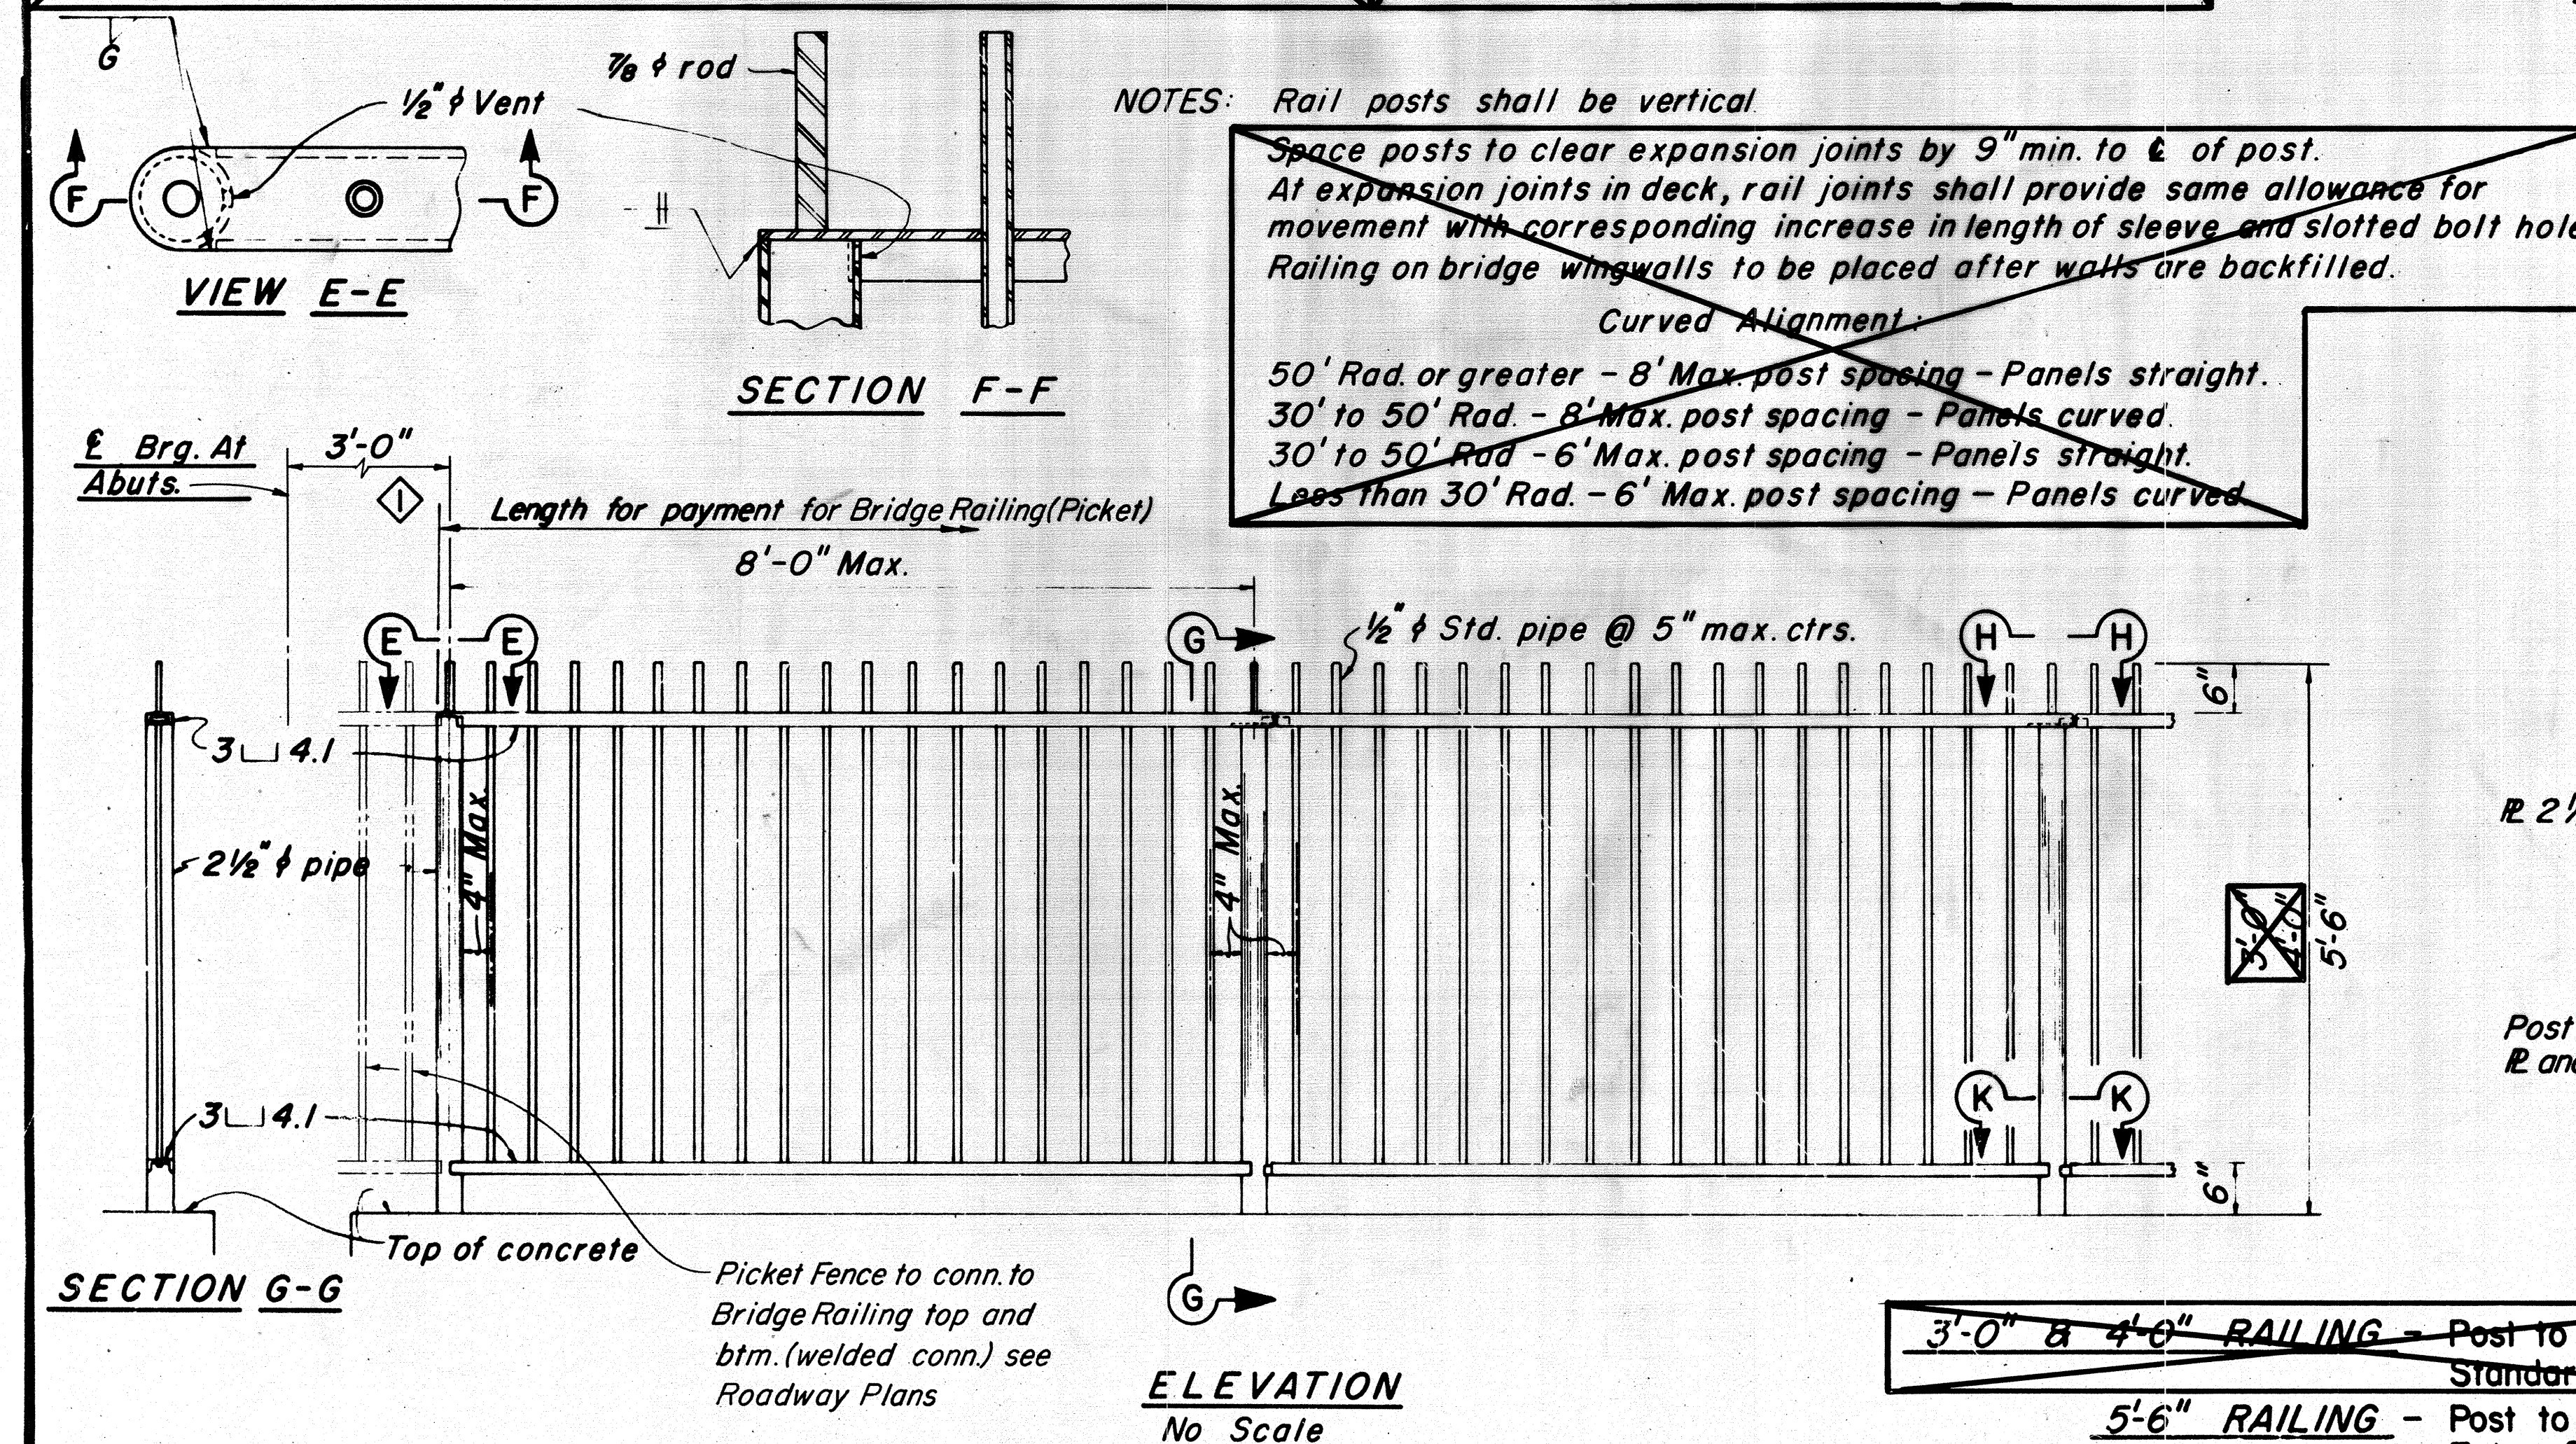


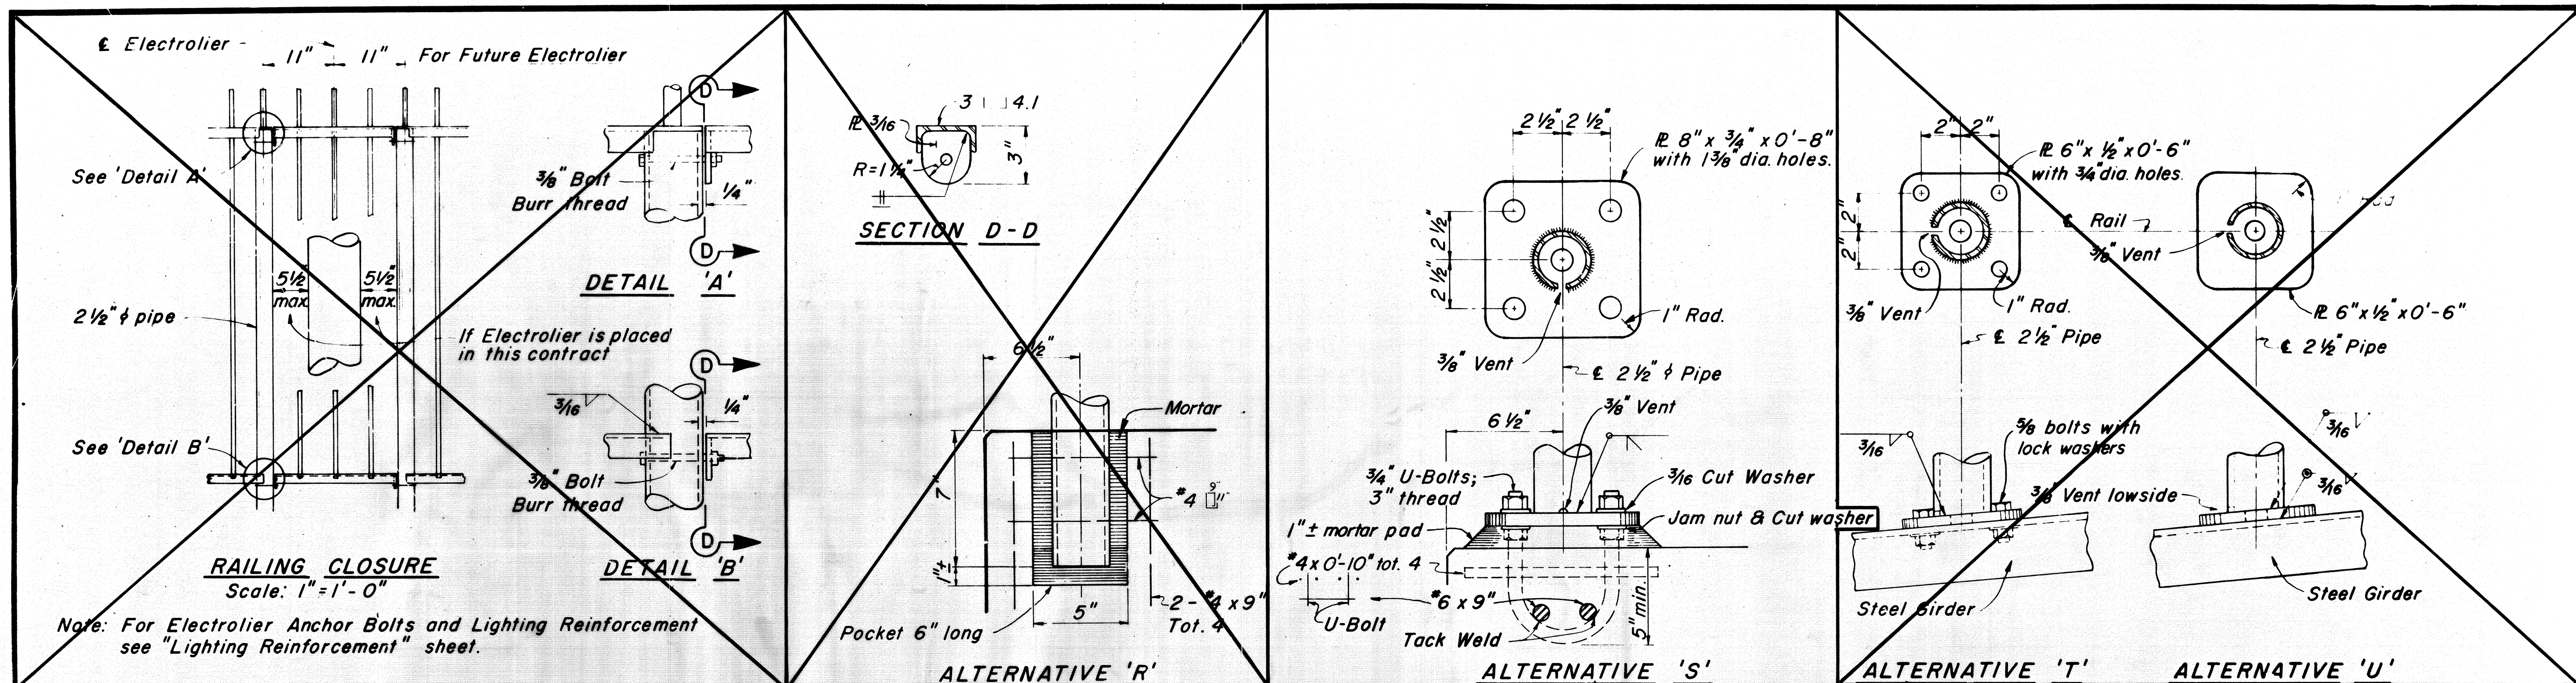

3'-0" RAILING - Post to be 2 1/2" Standard Pipe
5'-6" RAILING - Post to be 2 1/2" Extra Strong Pipe
3'-0" Railing - approx. 16 lbs. per lineal foot
4'-0" Railing - approx. 19 lbs. per lineal foot
5'-6" Railing - approx. 20 lbs. per lineal foot