


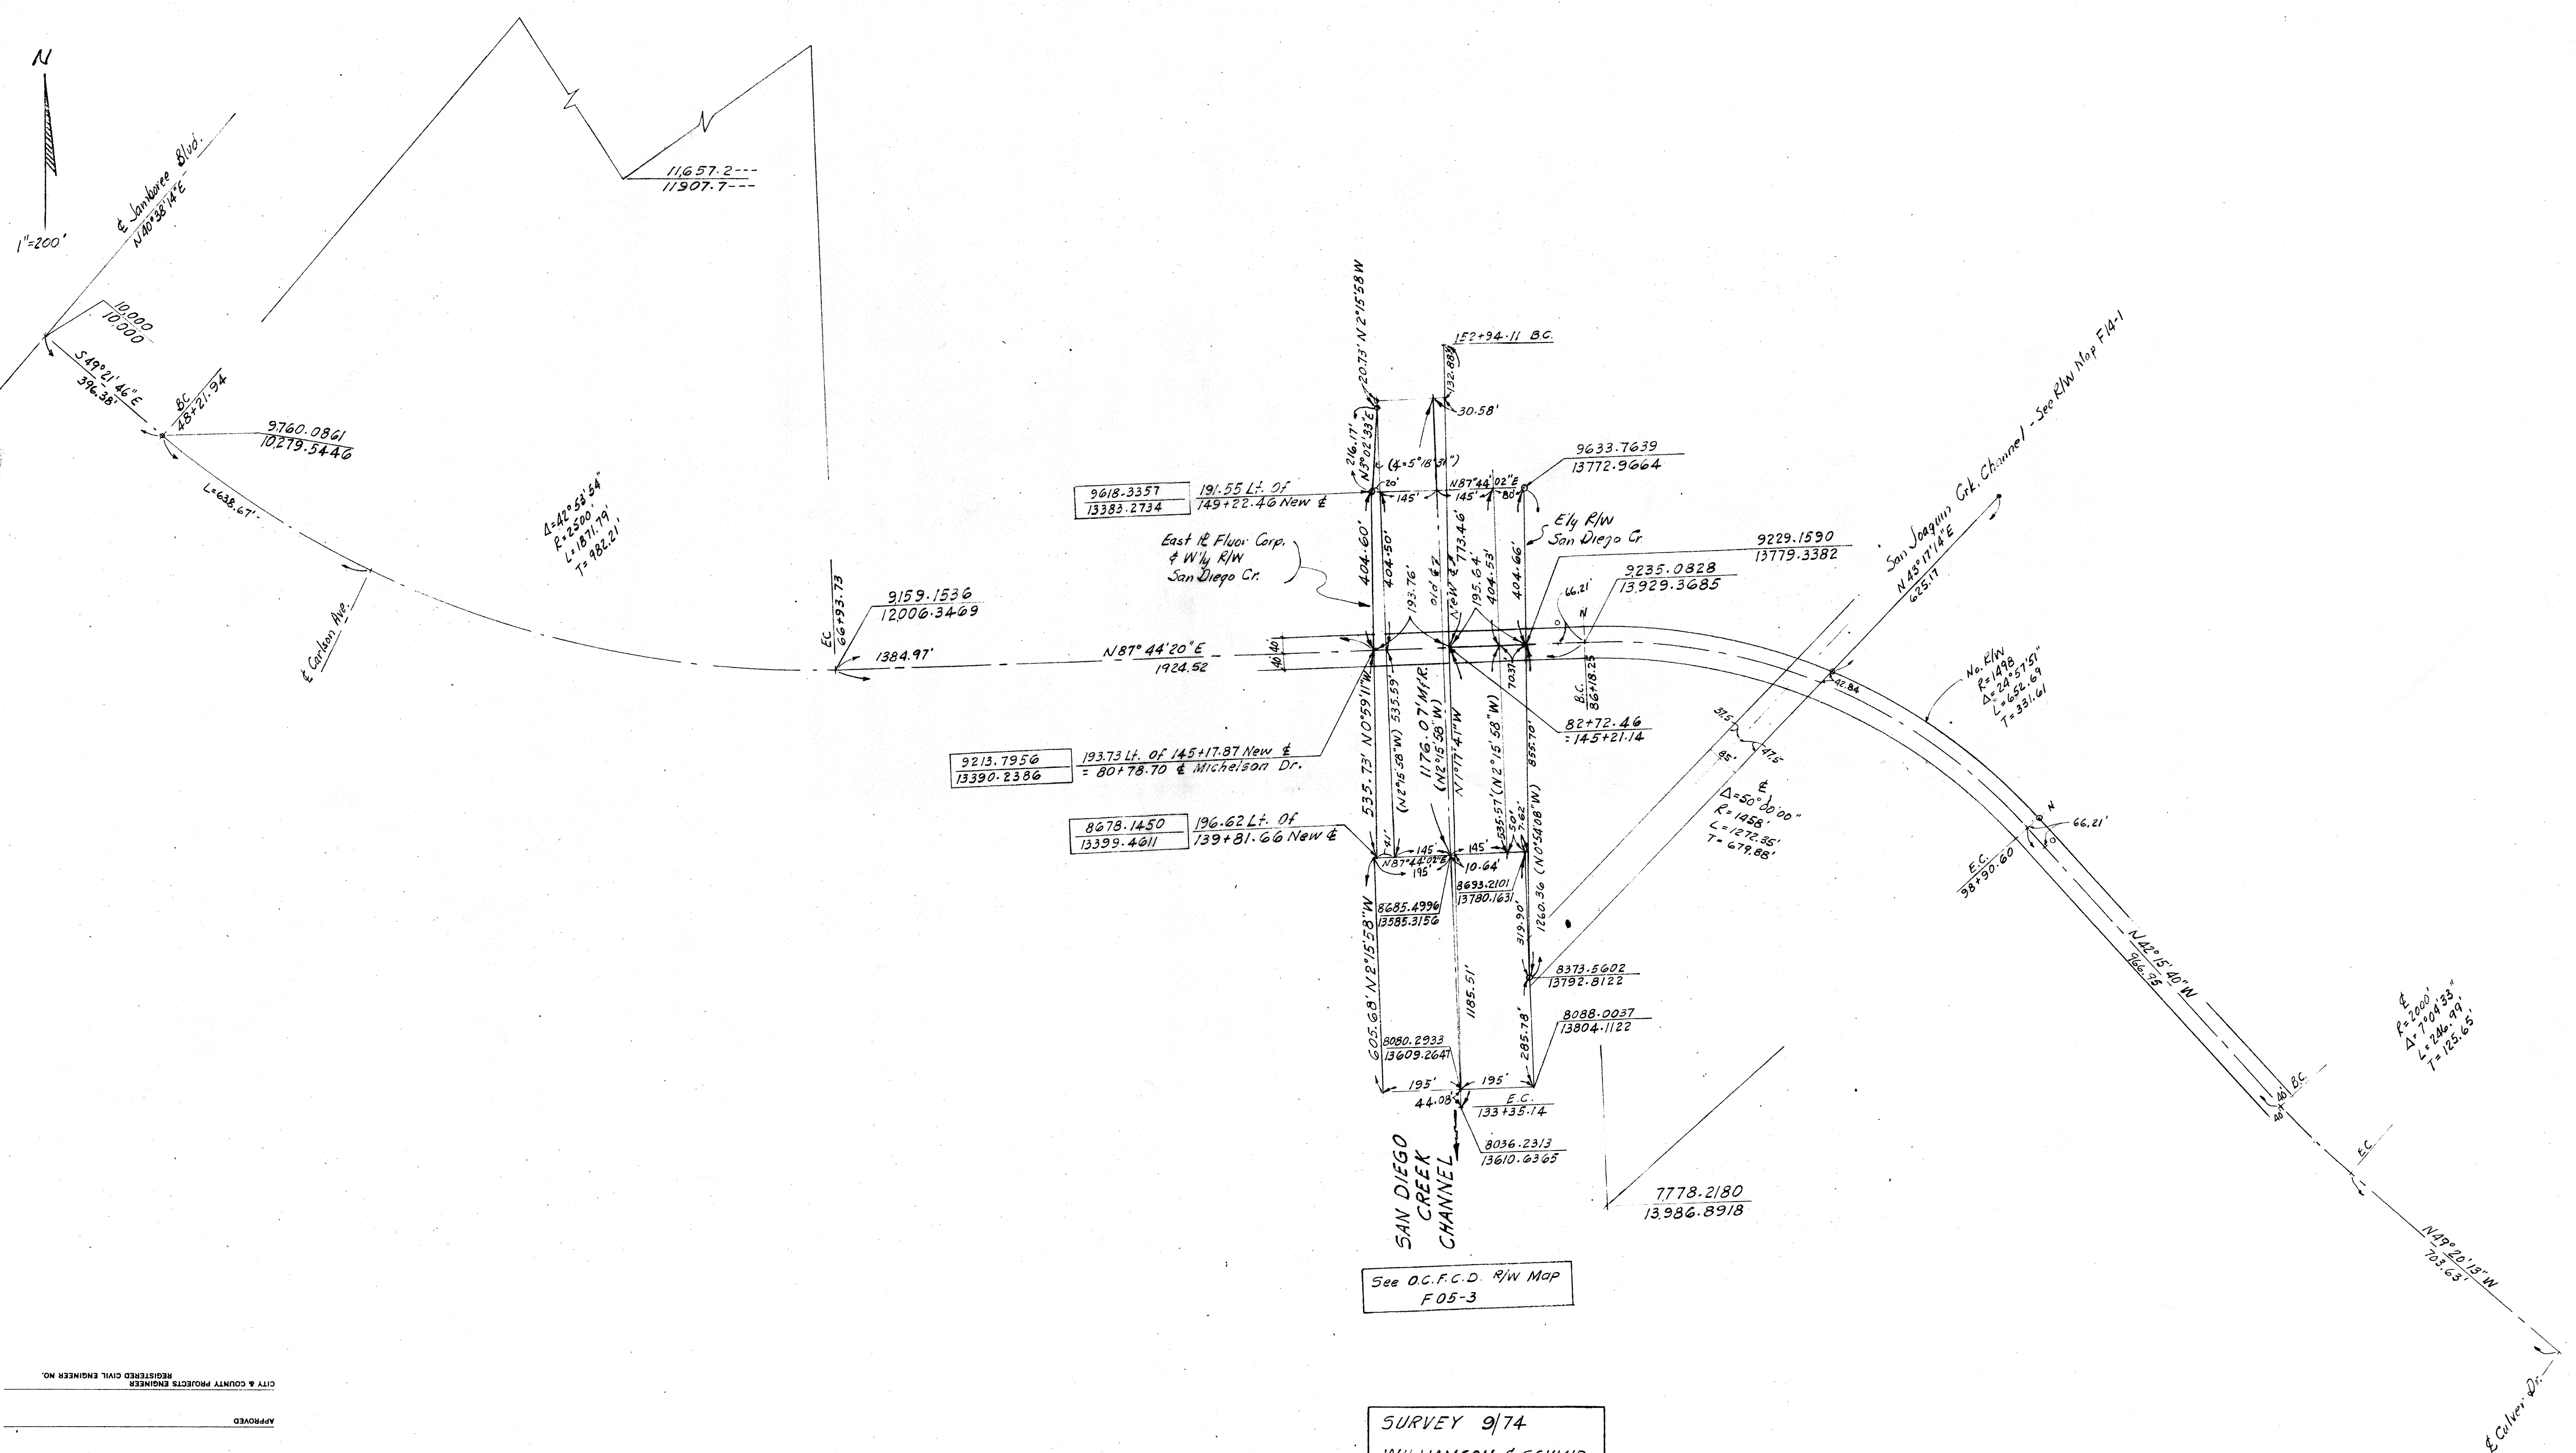

CITY & COUNTY PROJECTS REGISTERED CIVIL ENGINEER NO.									
APPROVED									
DISTRICT VIII									
COUNTY ENGINEER REGISTERED CIVIL ENGINEER NO.									
DIST. COUNTY ROUTE SEC. SHEET NO. TOTAL SHEETS									
FEDERAL PROJECT NO. STATE DIV. NO. 7 CALIF. 10/74									

REVISED: 10-22-74

See O.C.F.C.D. R/W Map F05-3

SURVEY 9/74
WILLIAMSON & SCHMID

BASIS OF BEARINGS:
O.C.F.C.D. - 0°48'29" TO EAST = BASIS OF BEARINGS

HORIZONTAL CONTROL
MICHELSON DRIVE
10/74 L-1571