


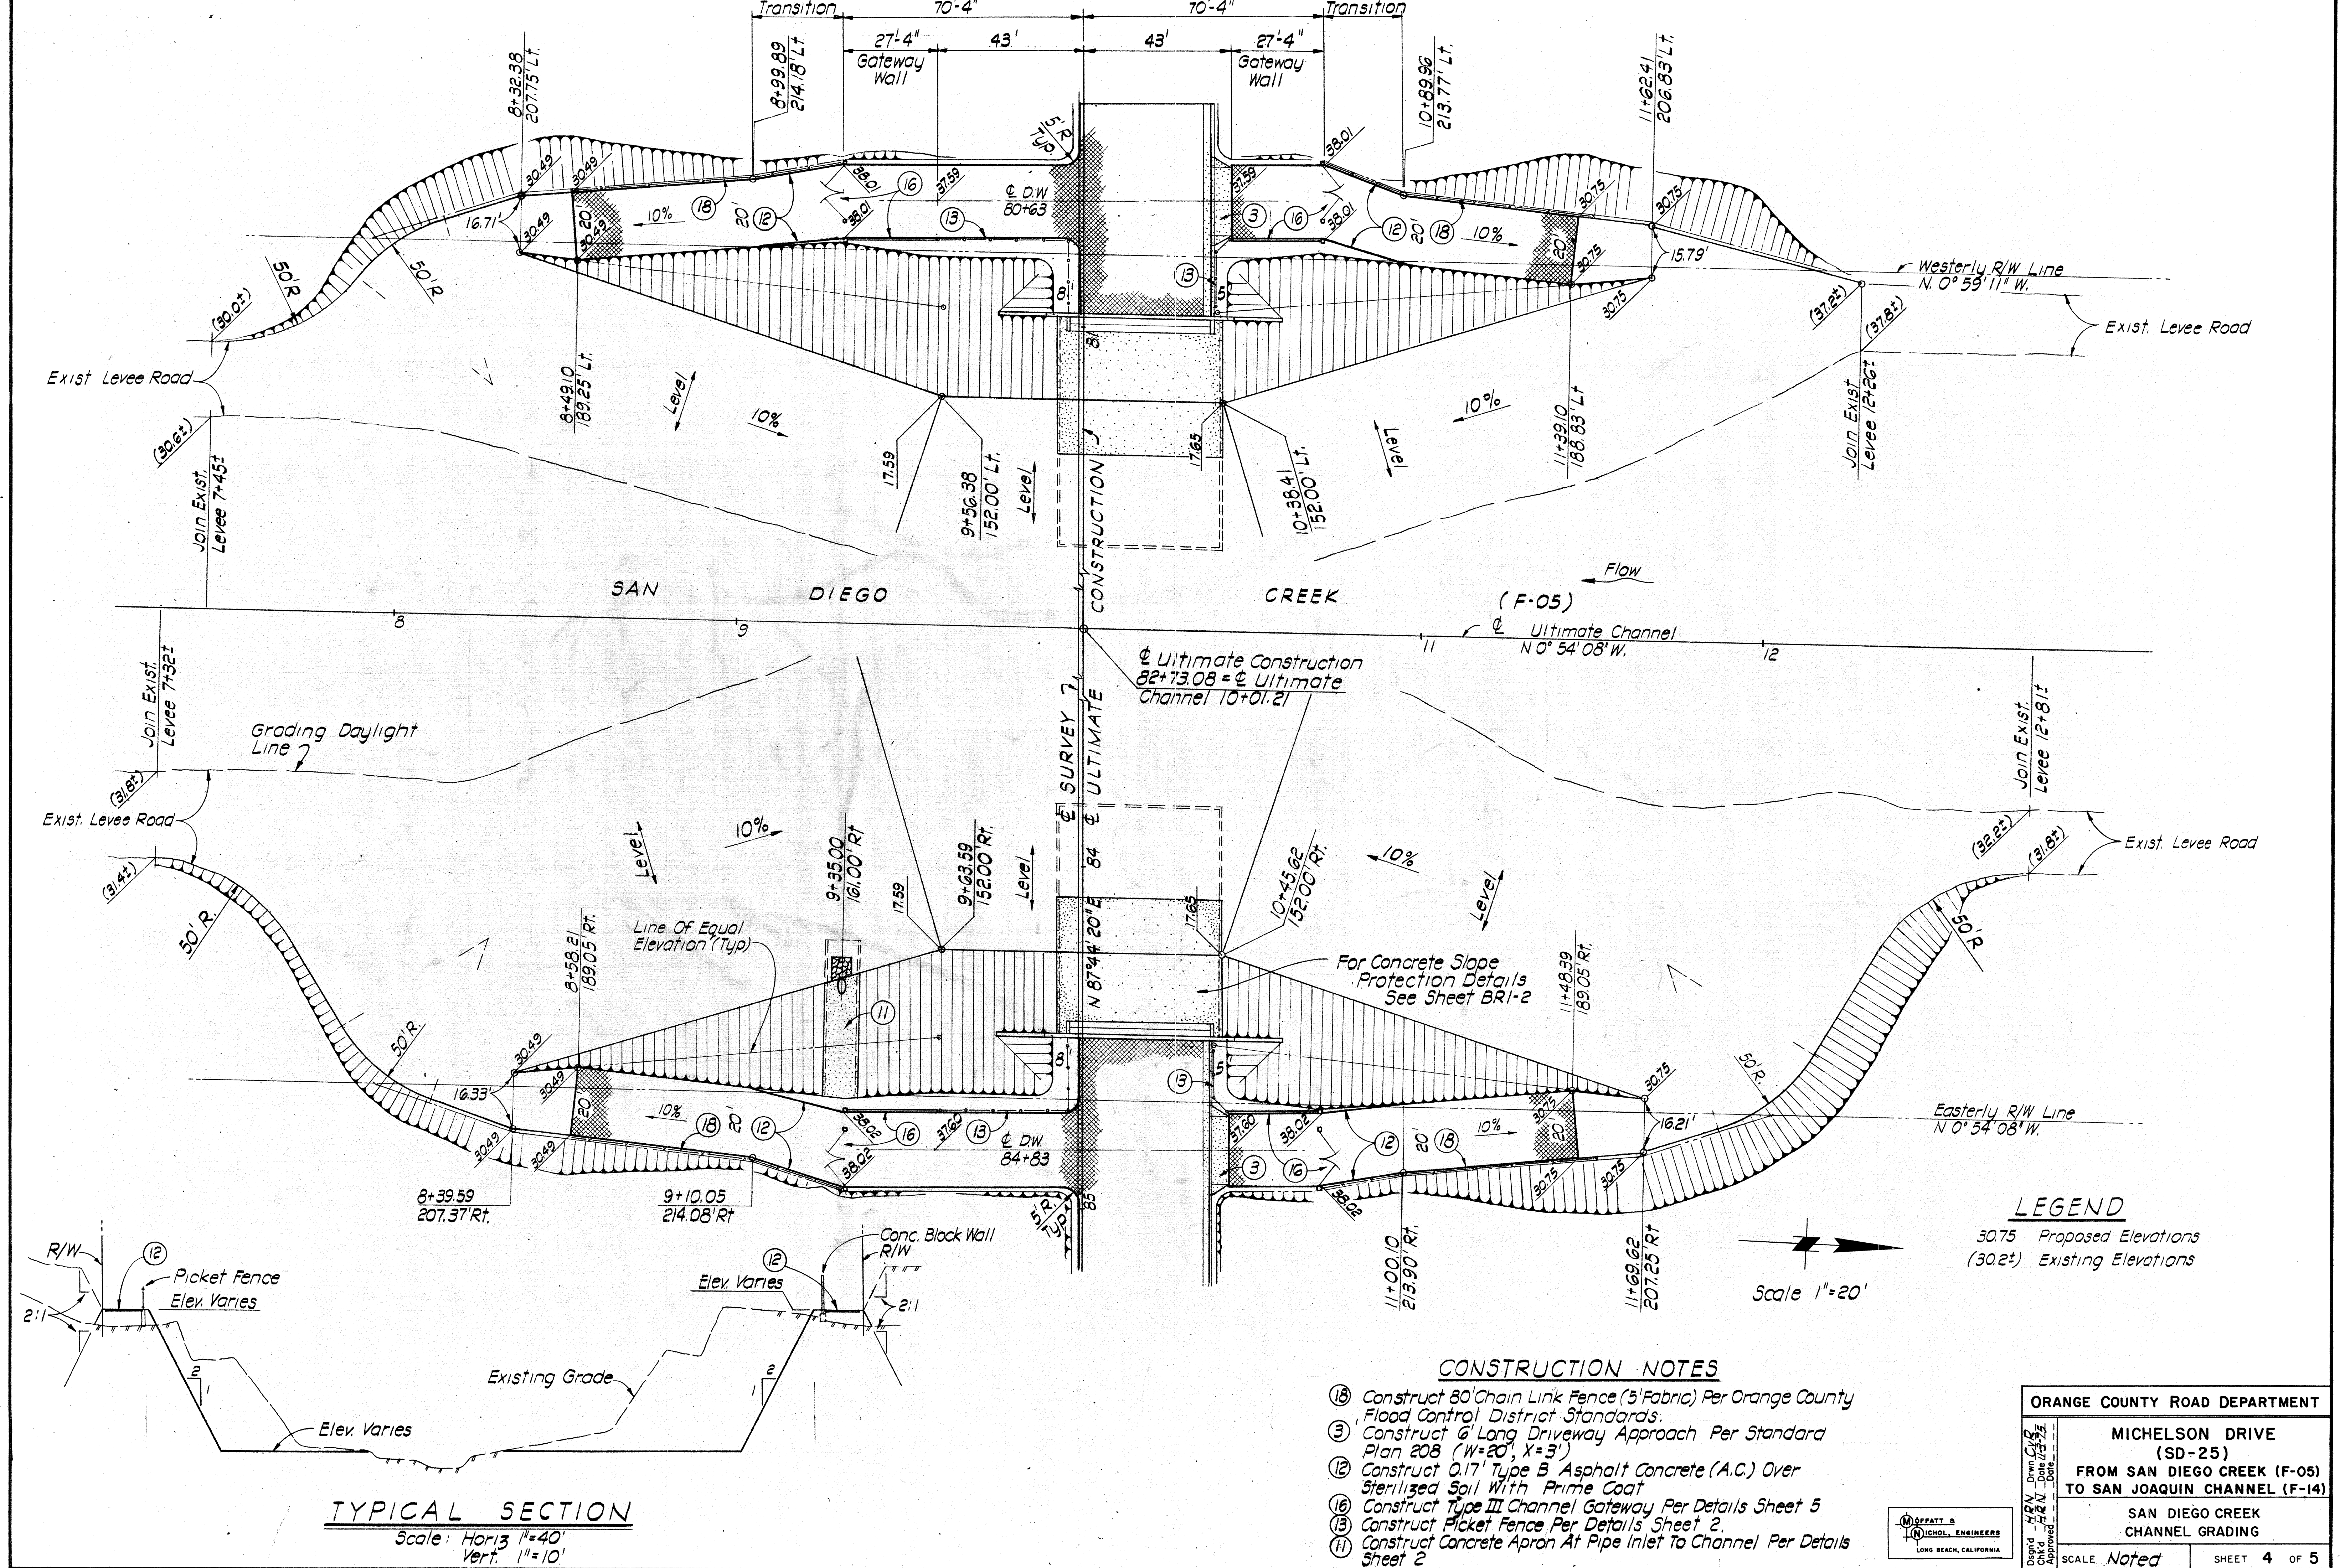

TYPICAL SECTION
 Scale: Hor: 1"=40'
 Vert: 1"=10'

LEGEND
 30.75 Proposed Elevations
 (30.2±) Existing Elevations

- CONSTRUCTION NOTES**
- (18) Construct 80' Chain Link Fence (5' Fabric) Per Orange County Flood Control District Standards.
 - (3) Construct 6' Long Driveway Approach Per Standard Plan 208 (W=20', X=3')
 - (12) Construct 0.17" Type B Asphalt Concrete (A.C.) Over Sterilized Soil With Prime Coat
 - (16) Construct Type III Channel Gateway Per Details Sheet 5
 - (13) Construct Picket Fence Per Details Sheet 2.
 - (11) Construct Concrete Apron At Pipe Inlet To Channel Per Details Sheet 2

ORANGE COUNTY ROAD DEPARTMENT	
MICHELSON DRIVE (SD-25)	
FROM SAN DIEGO CREEK (F-05) TO SAN JOAQUIN CHANNEL (F-14)	
SAN DIEGO CREEK CHANNEL GRADING	
SCALE: <i>Noted</i>	SHEET 4 OF 5