


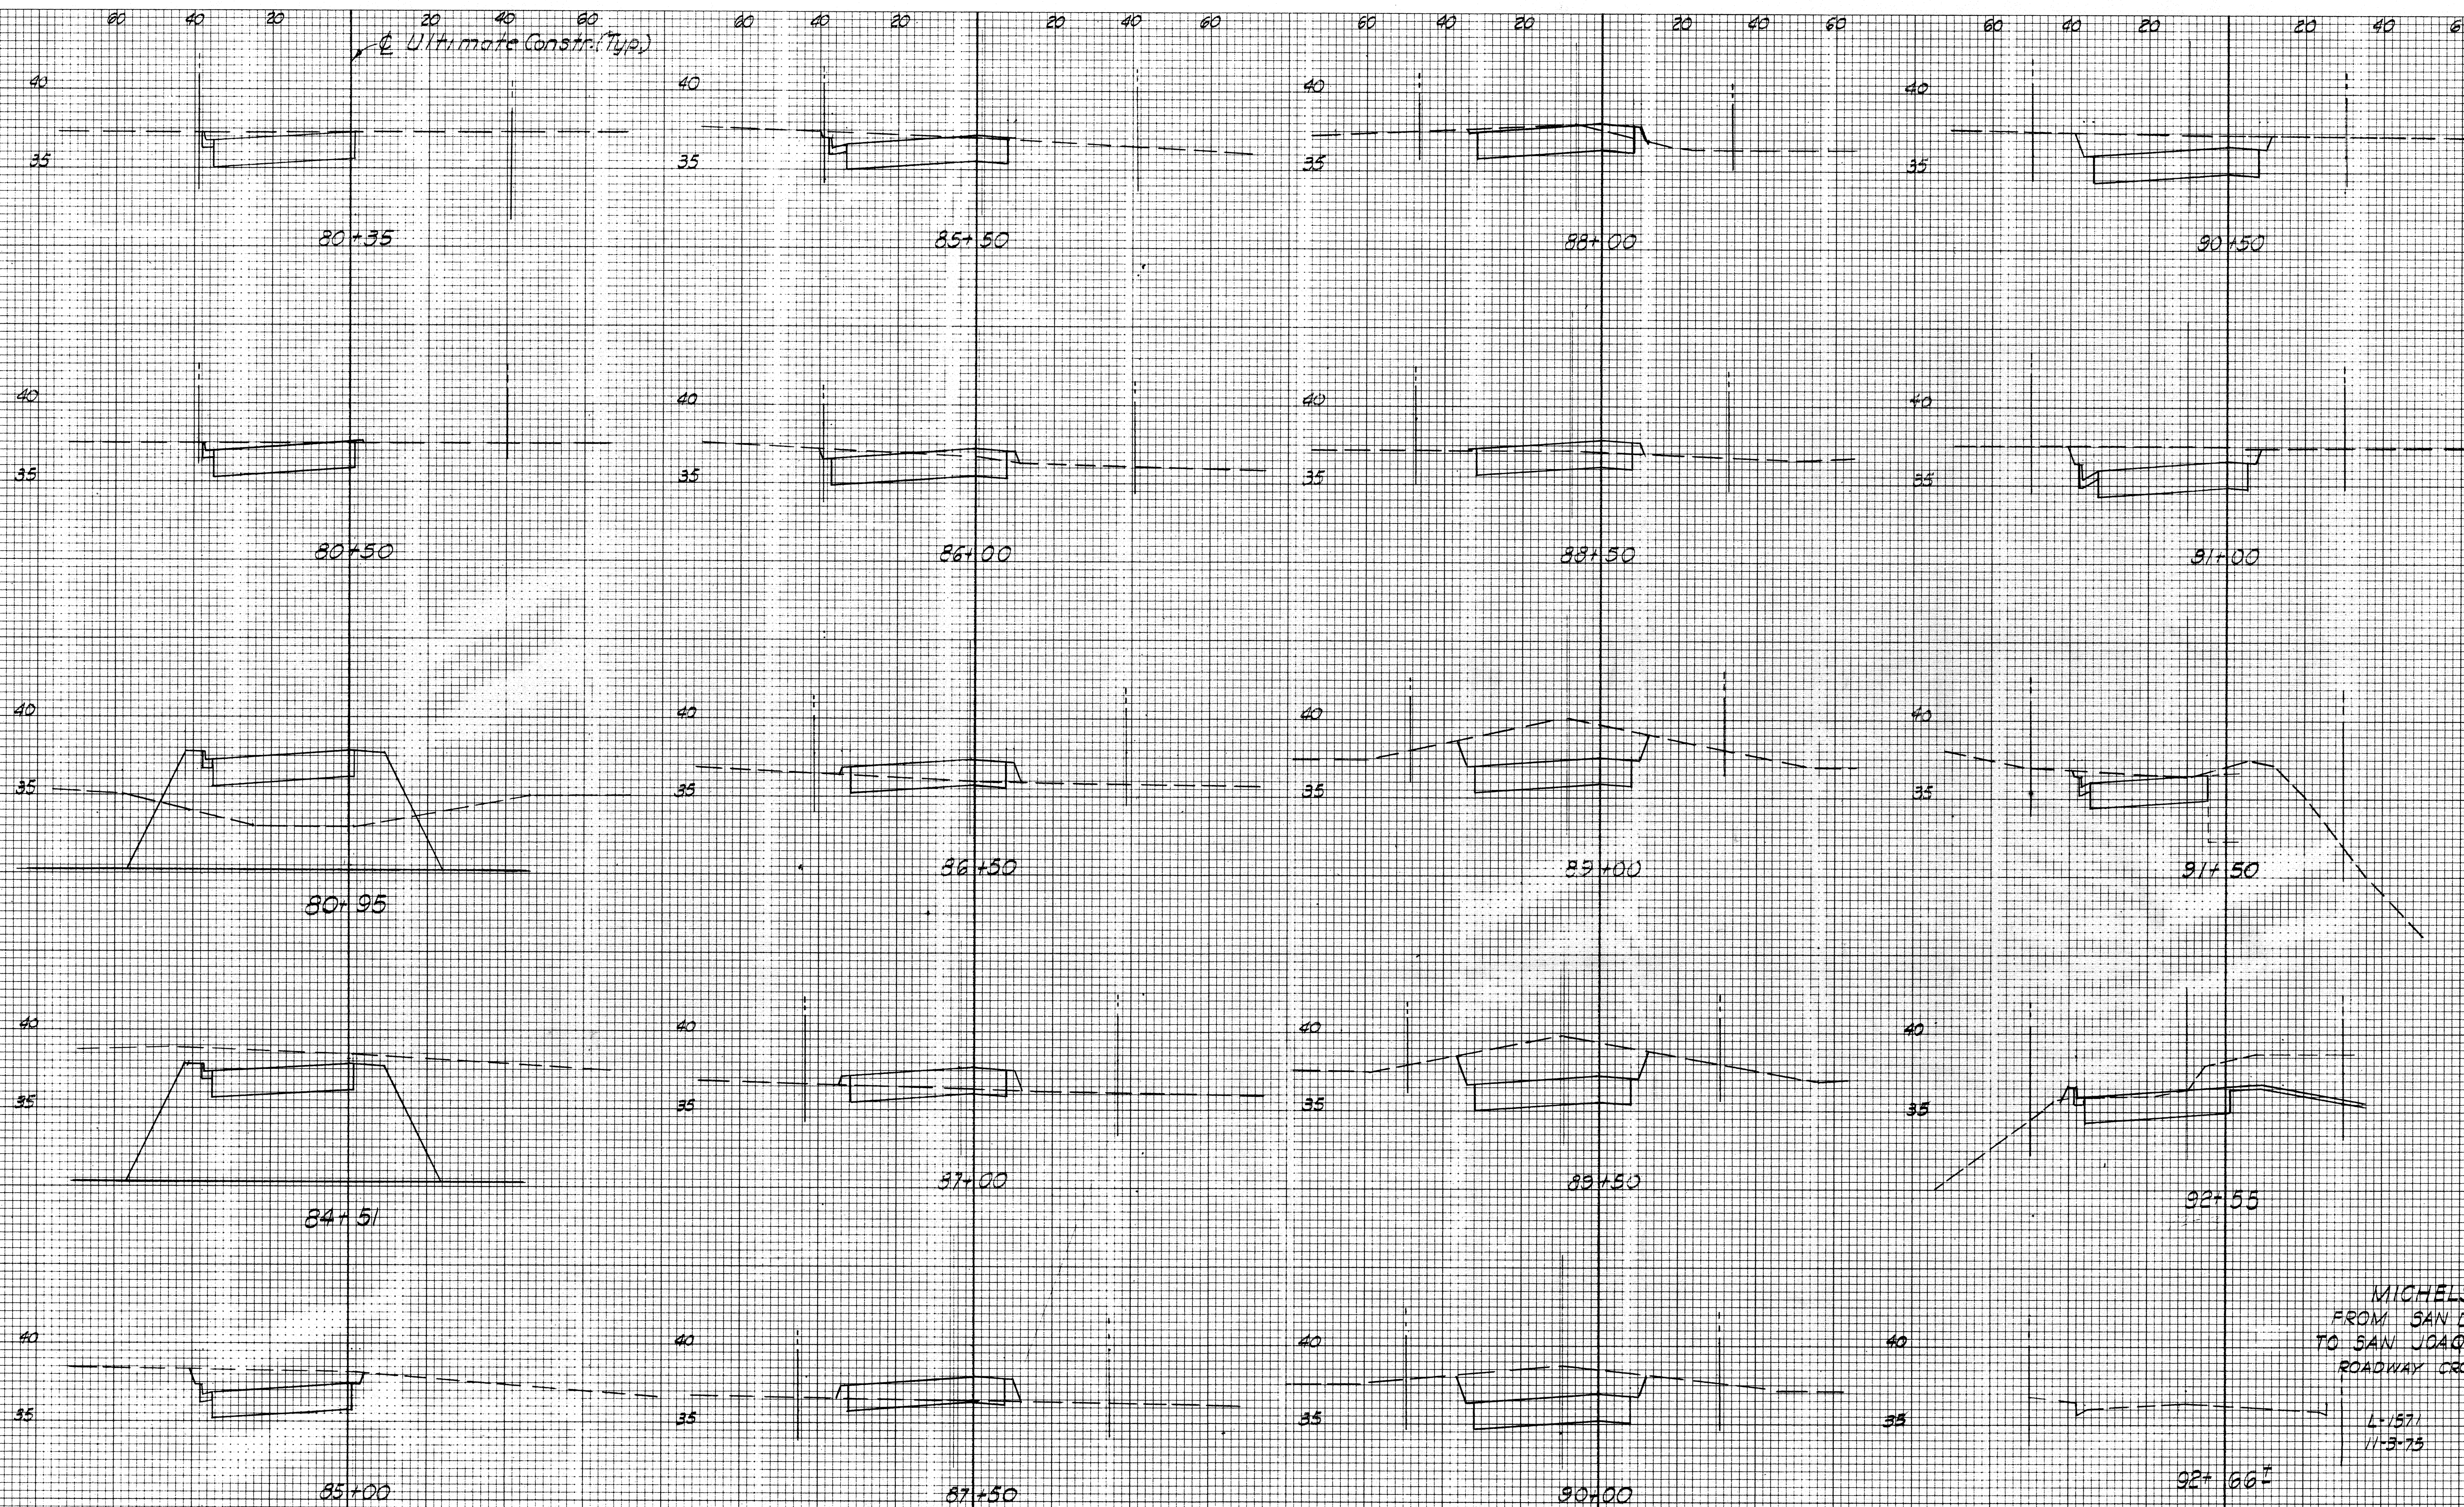

MICHELSON DRIVE
FROM SAN DIEGO CREEK
TO SAN JOAQUIN CHANNEL
ROADWAY CROSS SECTIONS

L-1571
11-3-75
VERT. 1"=5'
HORIZ. 1"=20'