
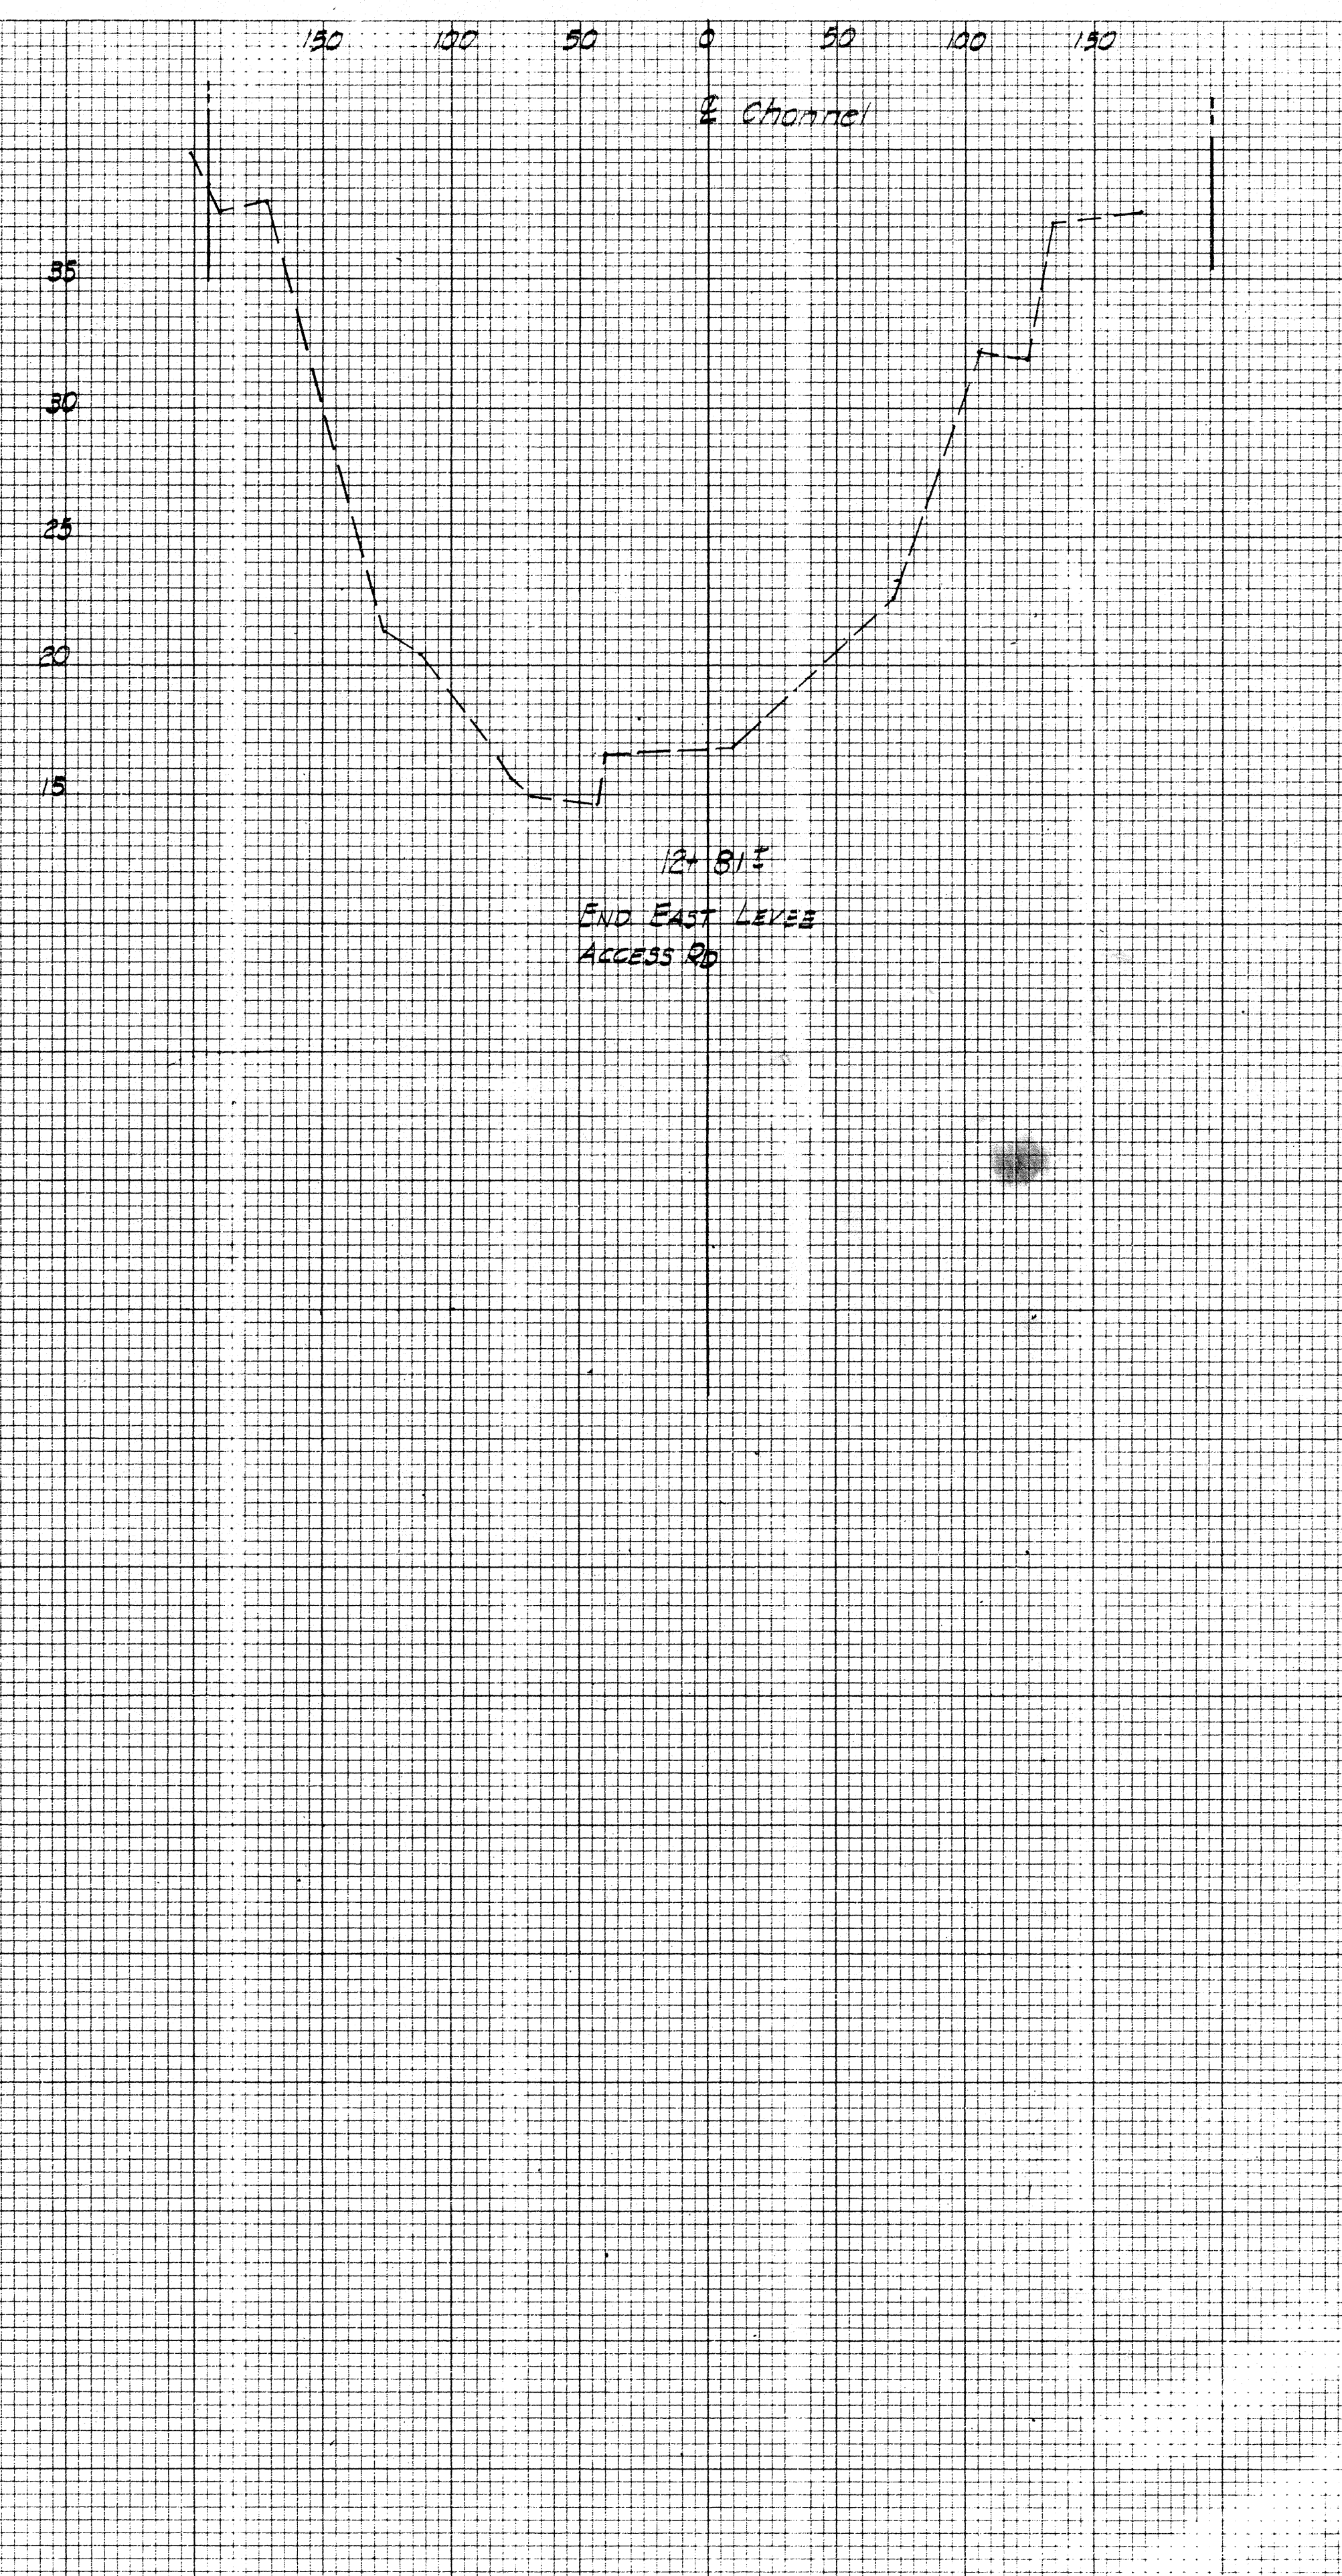


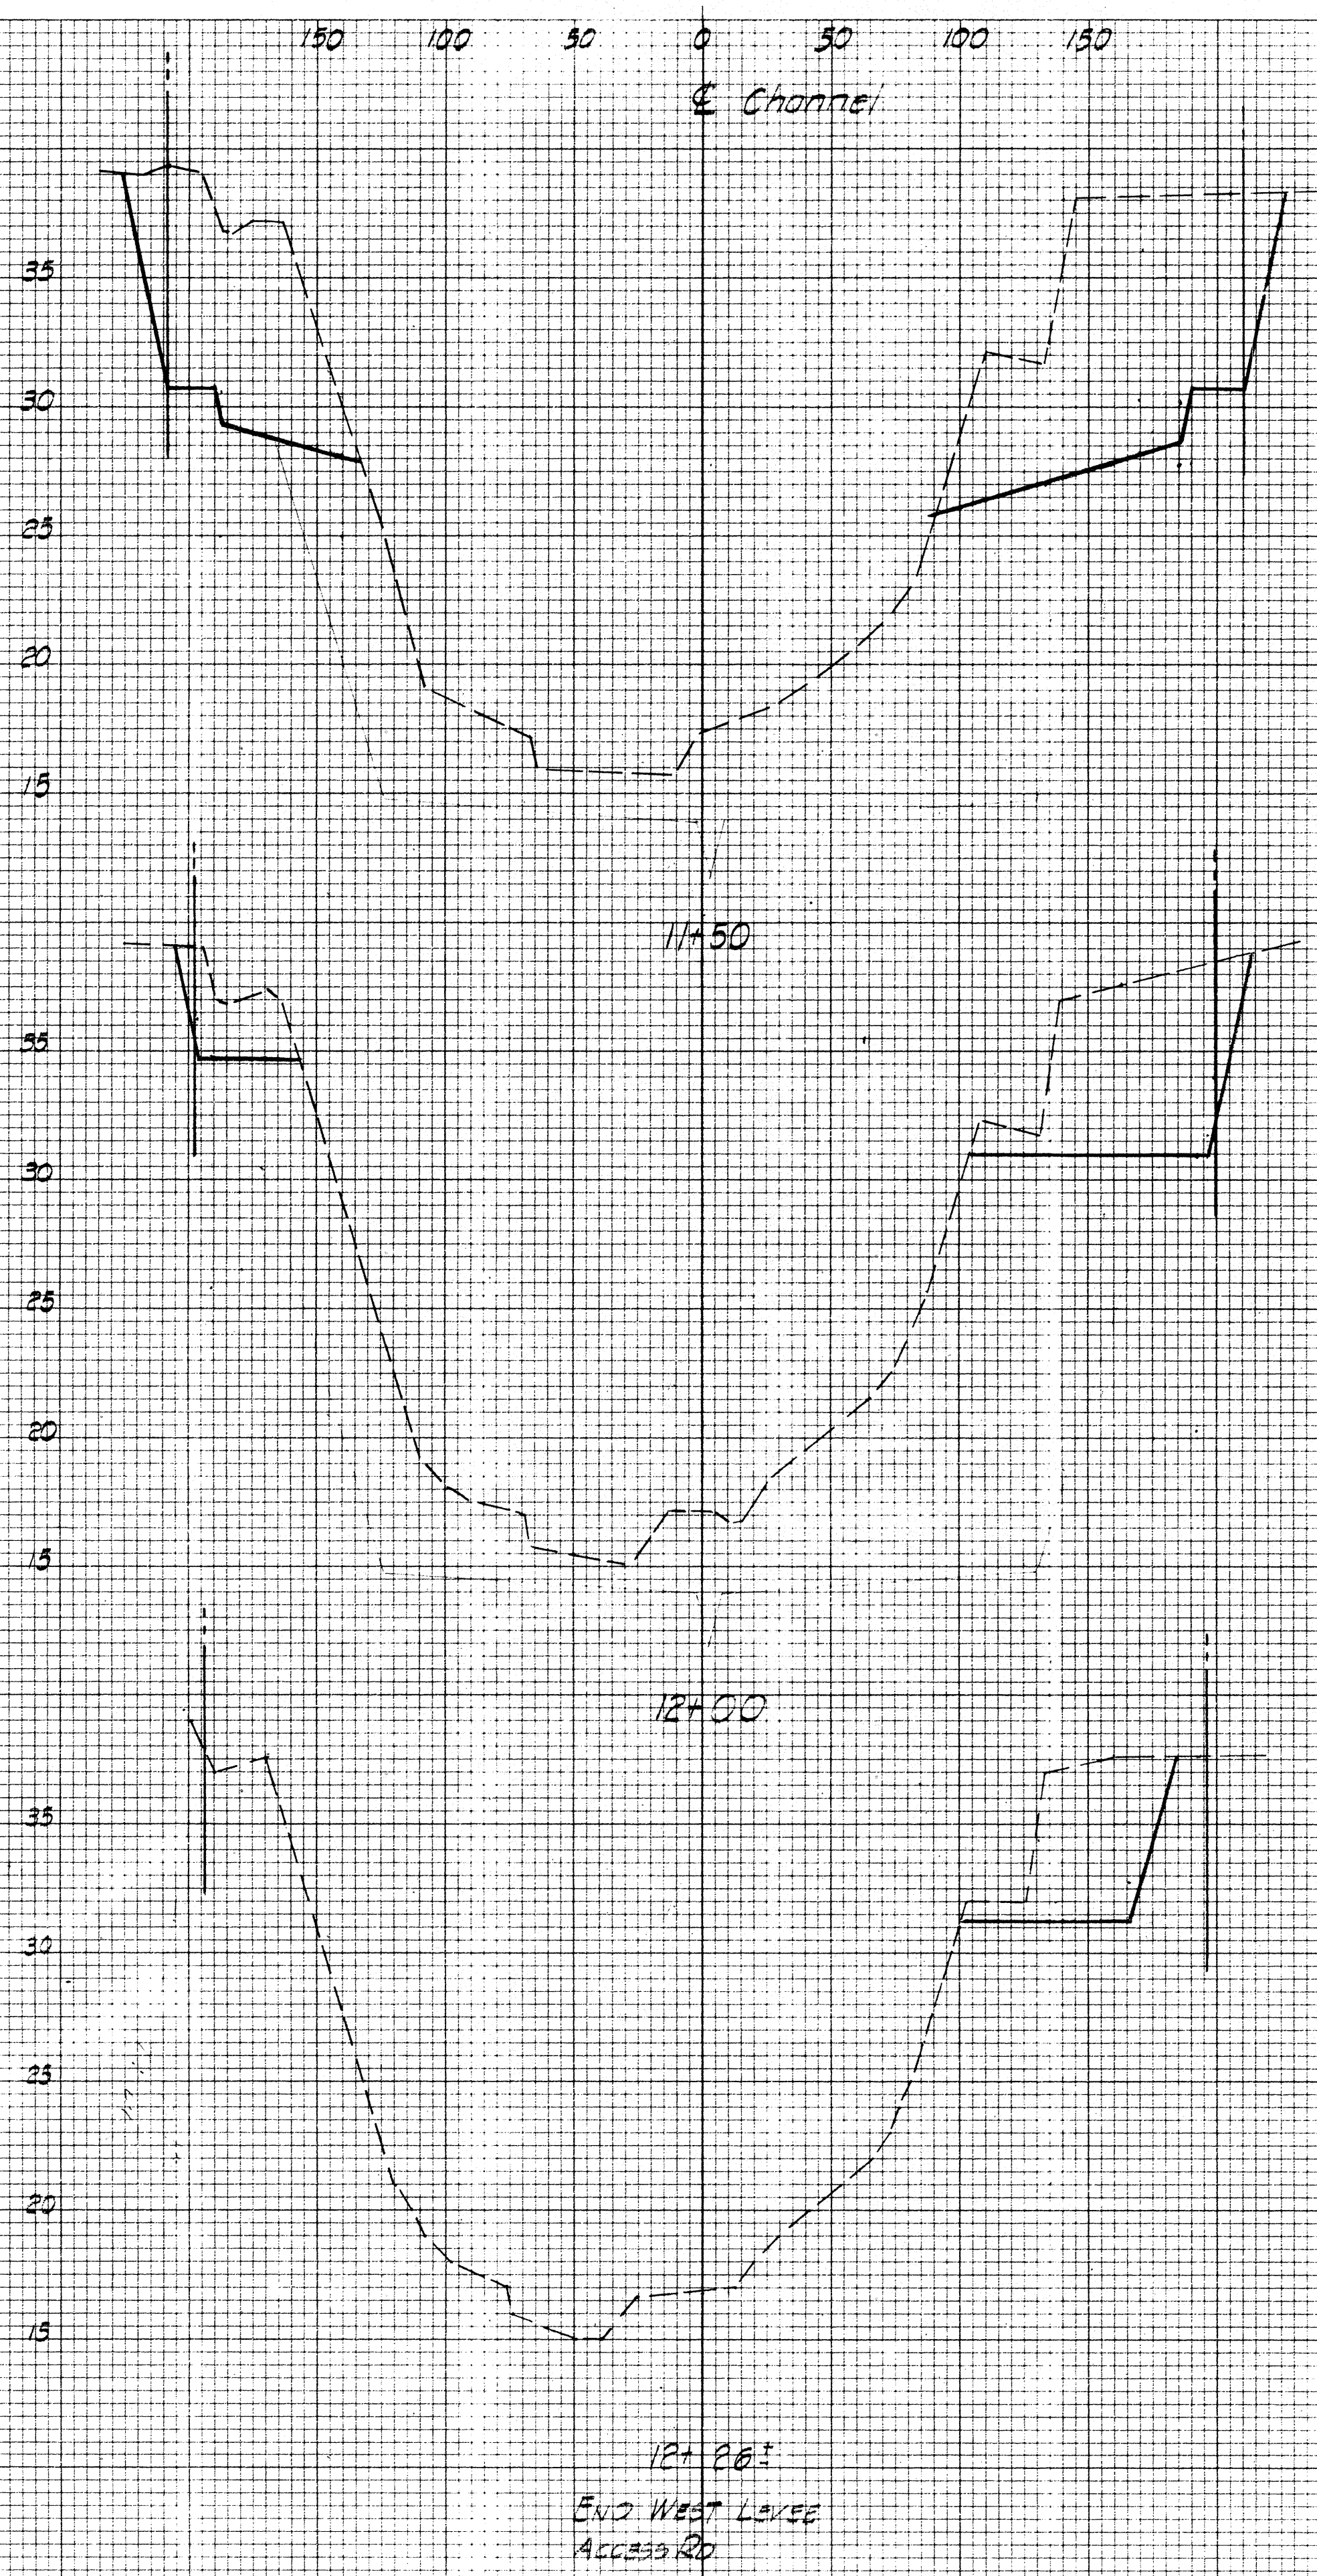

MICHELSON DRIVE BRIDGE
ACROSS SAN DIEGO CREEK
CHANNEL CROSS SECTIONS

L1571
11-3-75

VERT. 1"=3'
HORIZ 1"=50'