
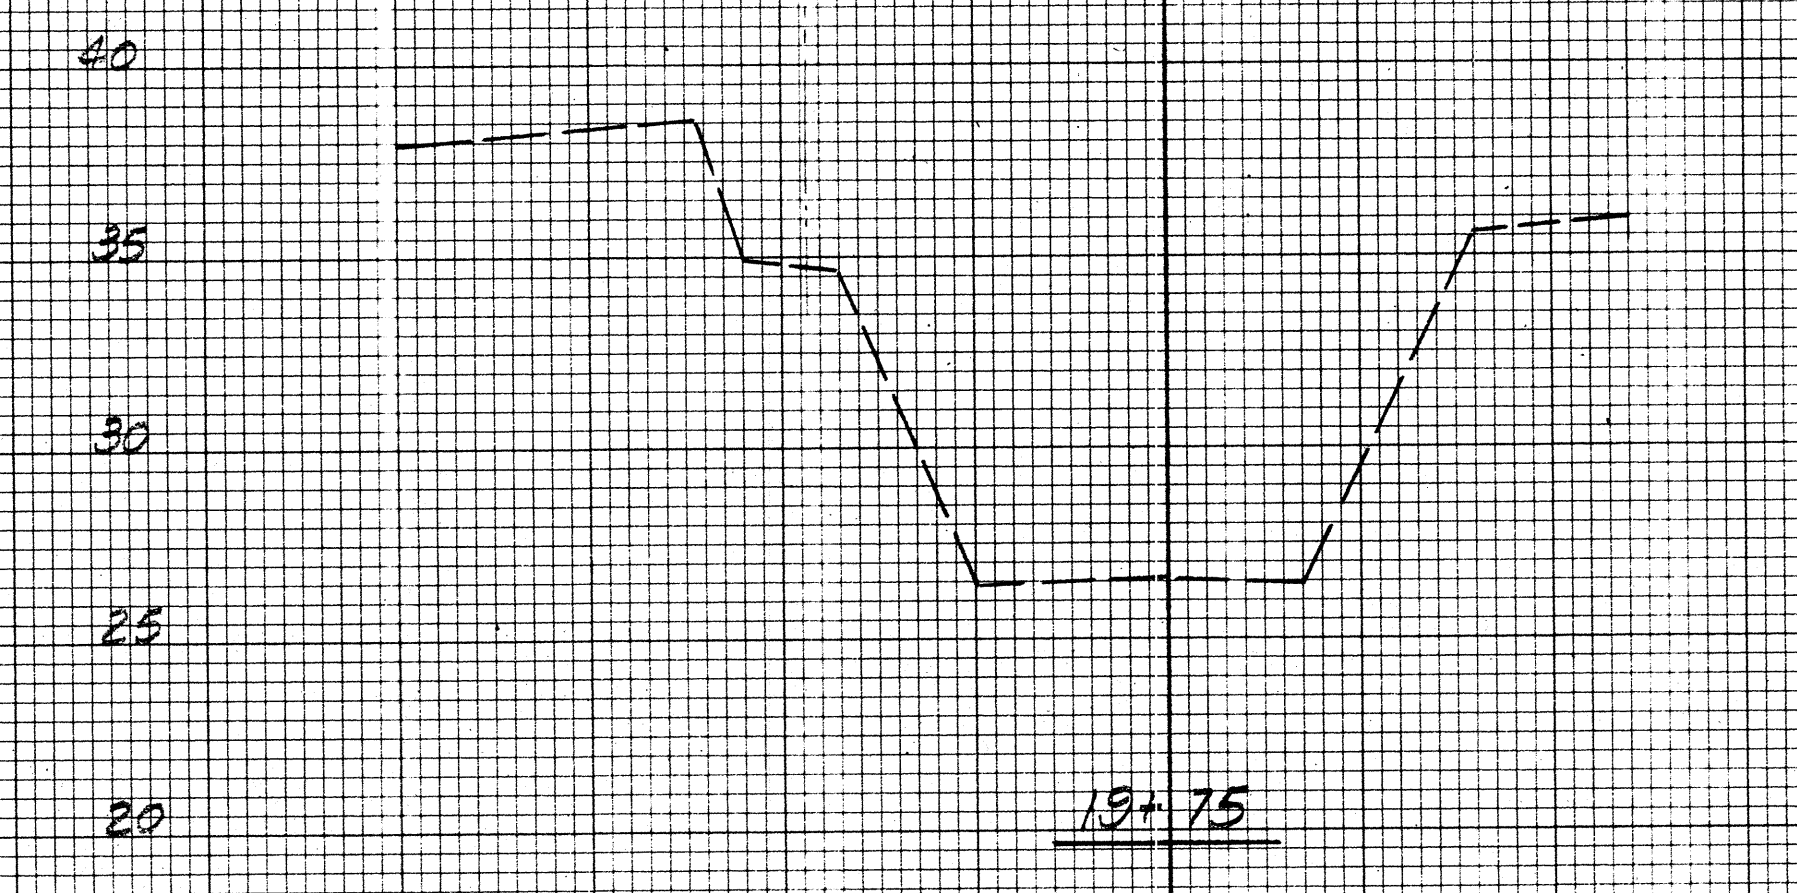
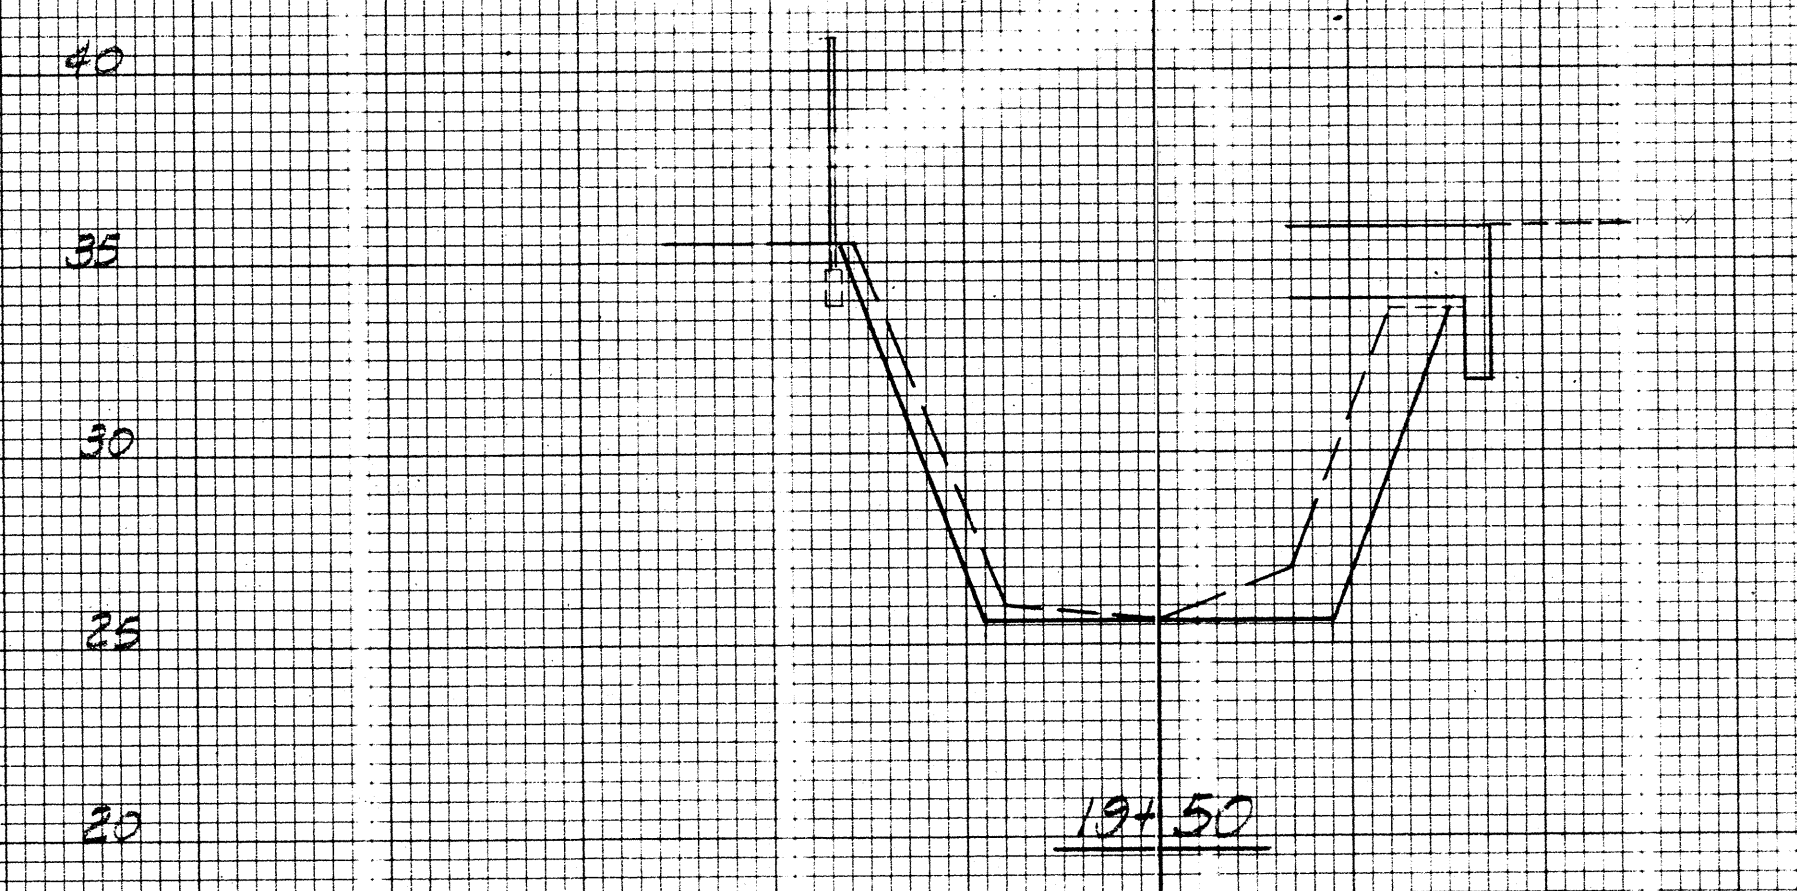
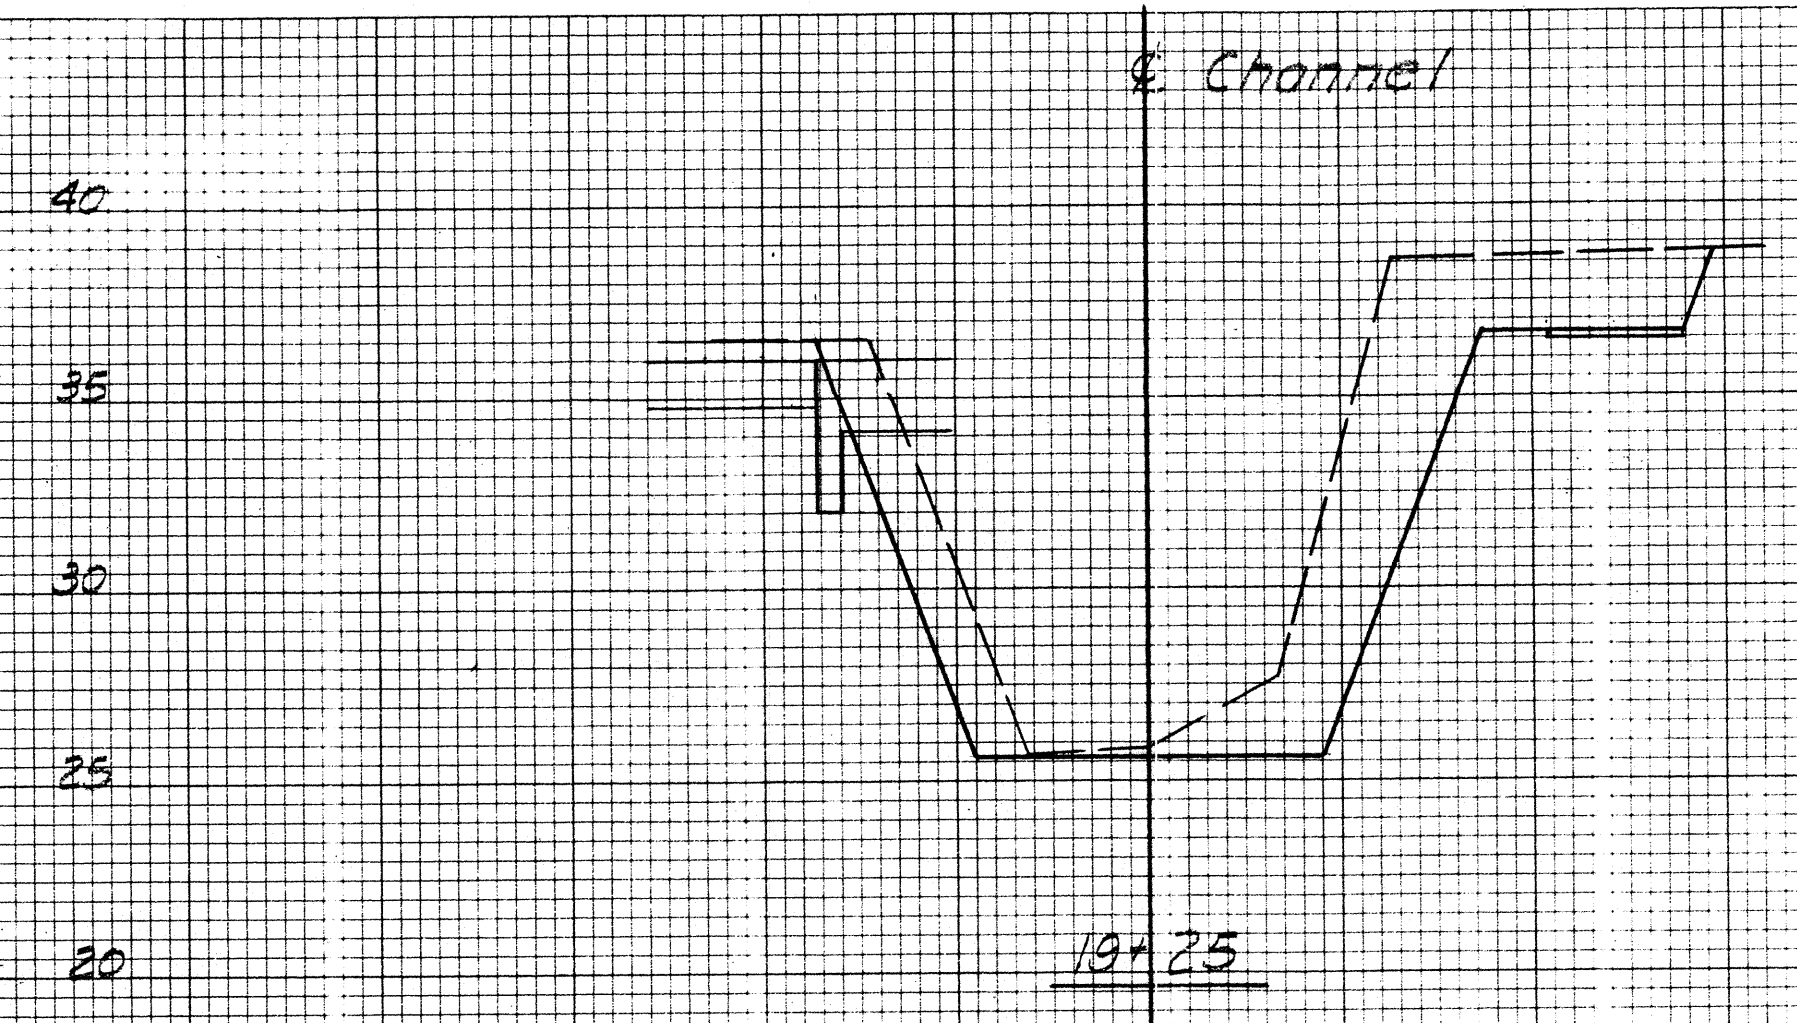
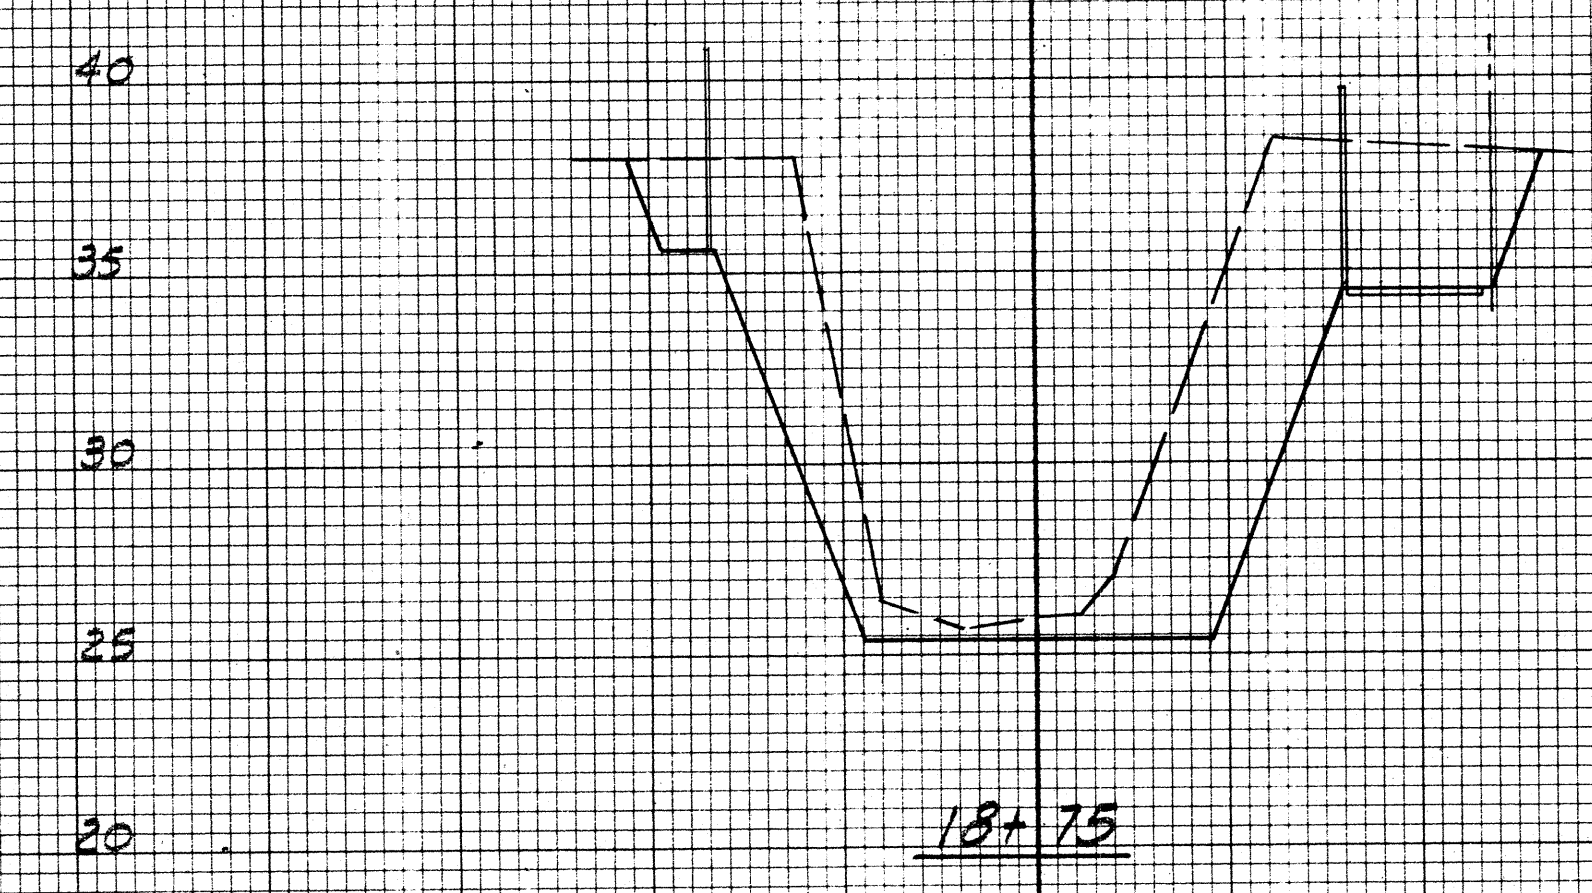


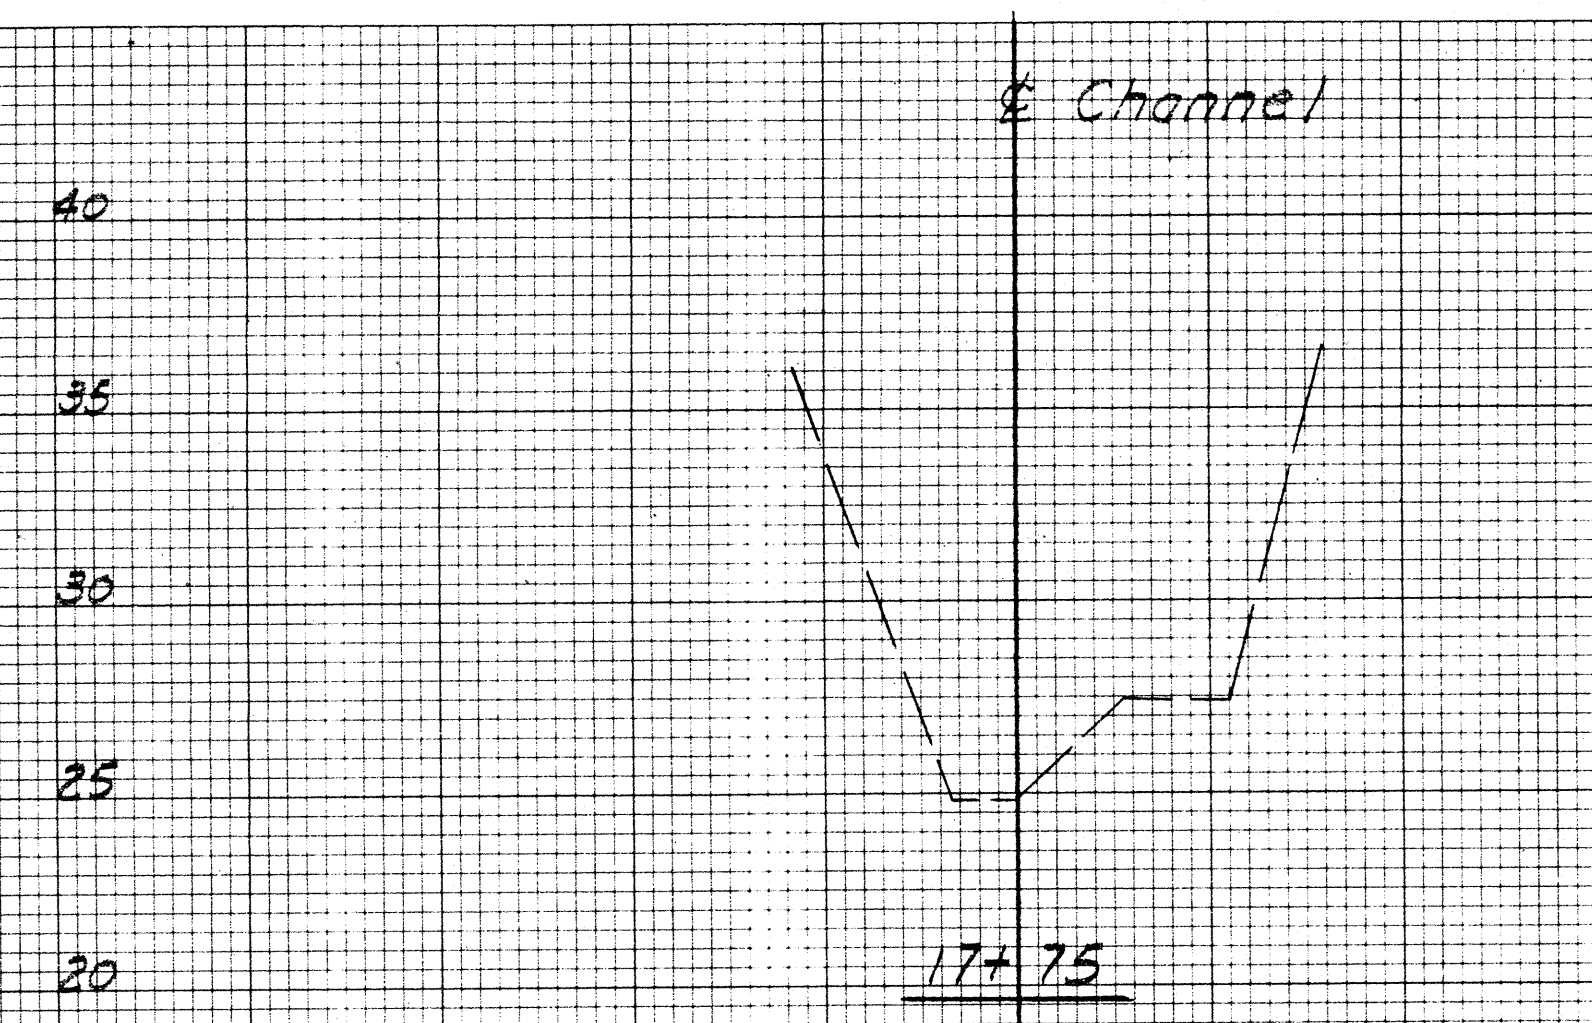

MICHELSON DRIVE BRIDGE
ACROSS SAN JOAQUIN CHANNEL
CHANNEL CROSS SECTIONS

6-15-71 Vert. 1"=5'
11-3-75 Horiz. 1"=20'