
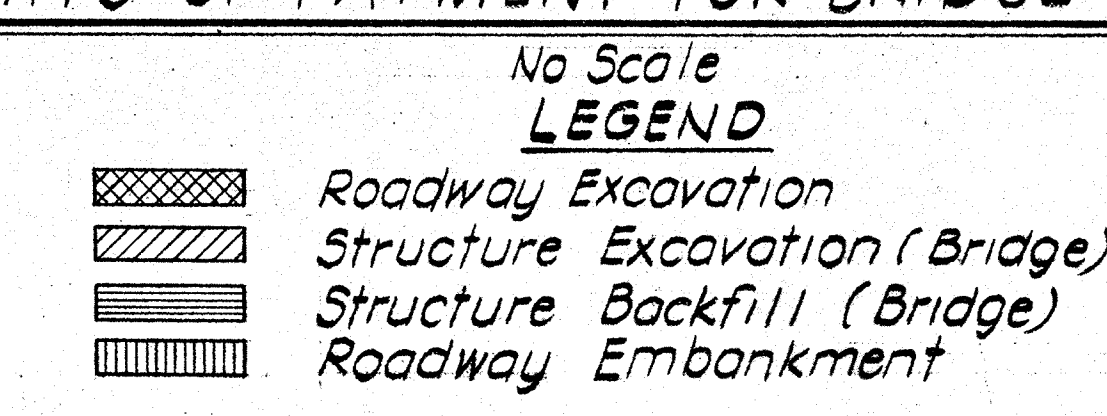
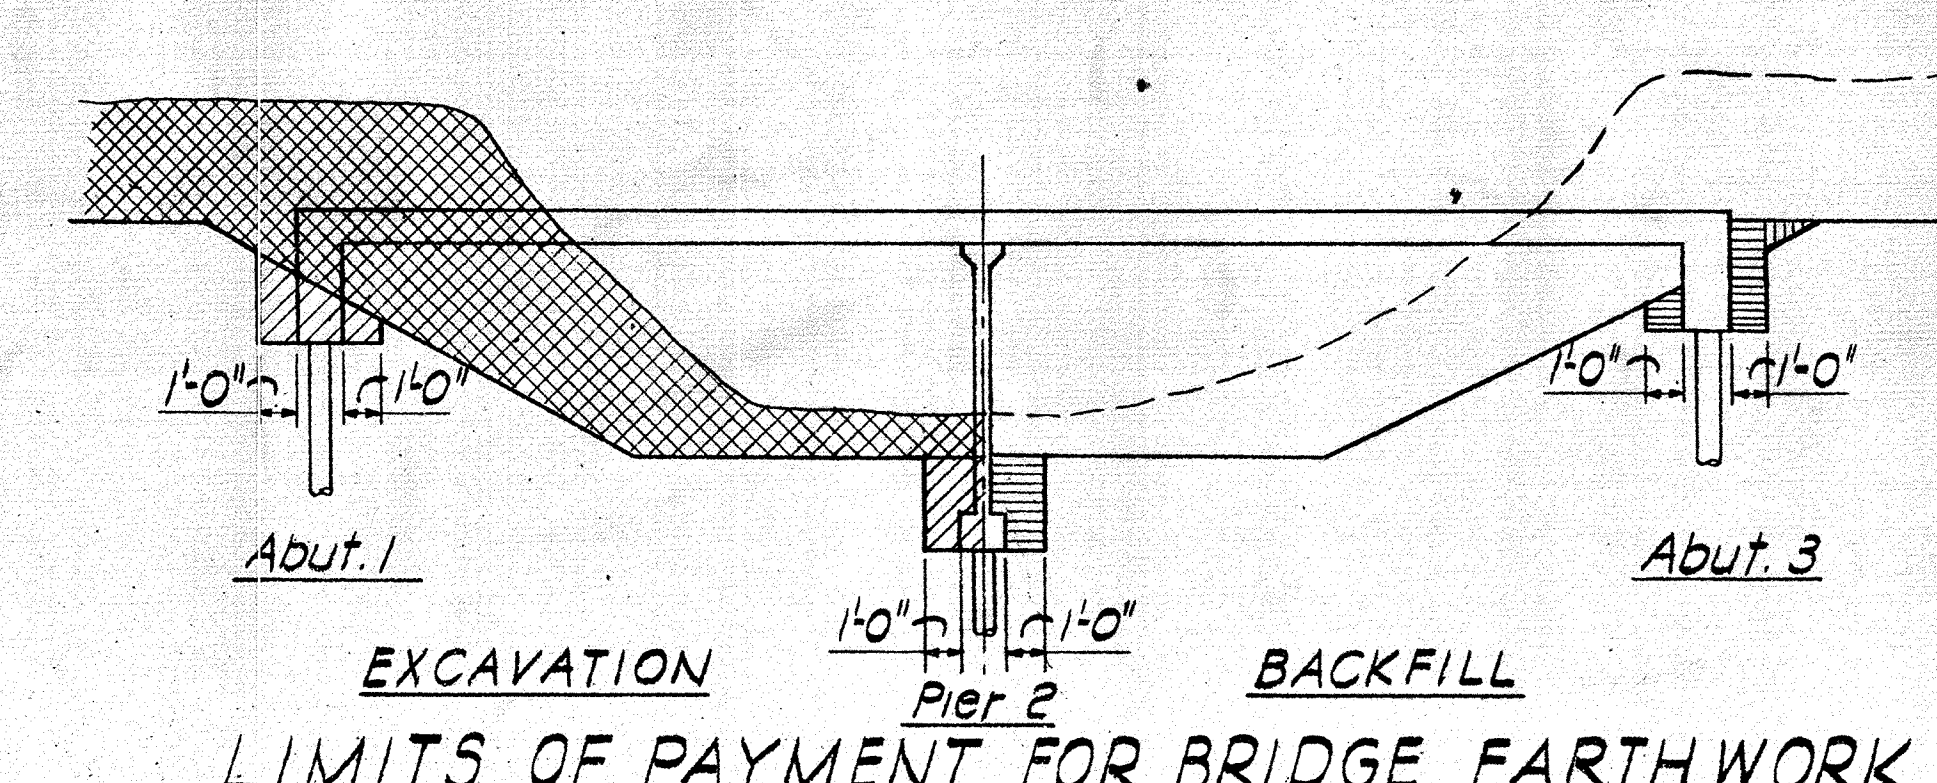
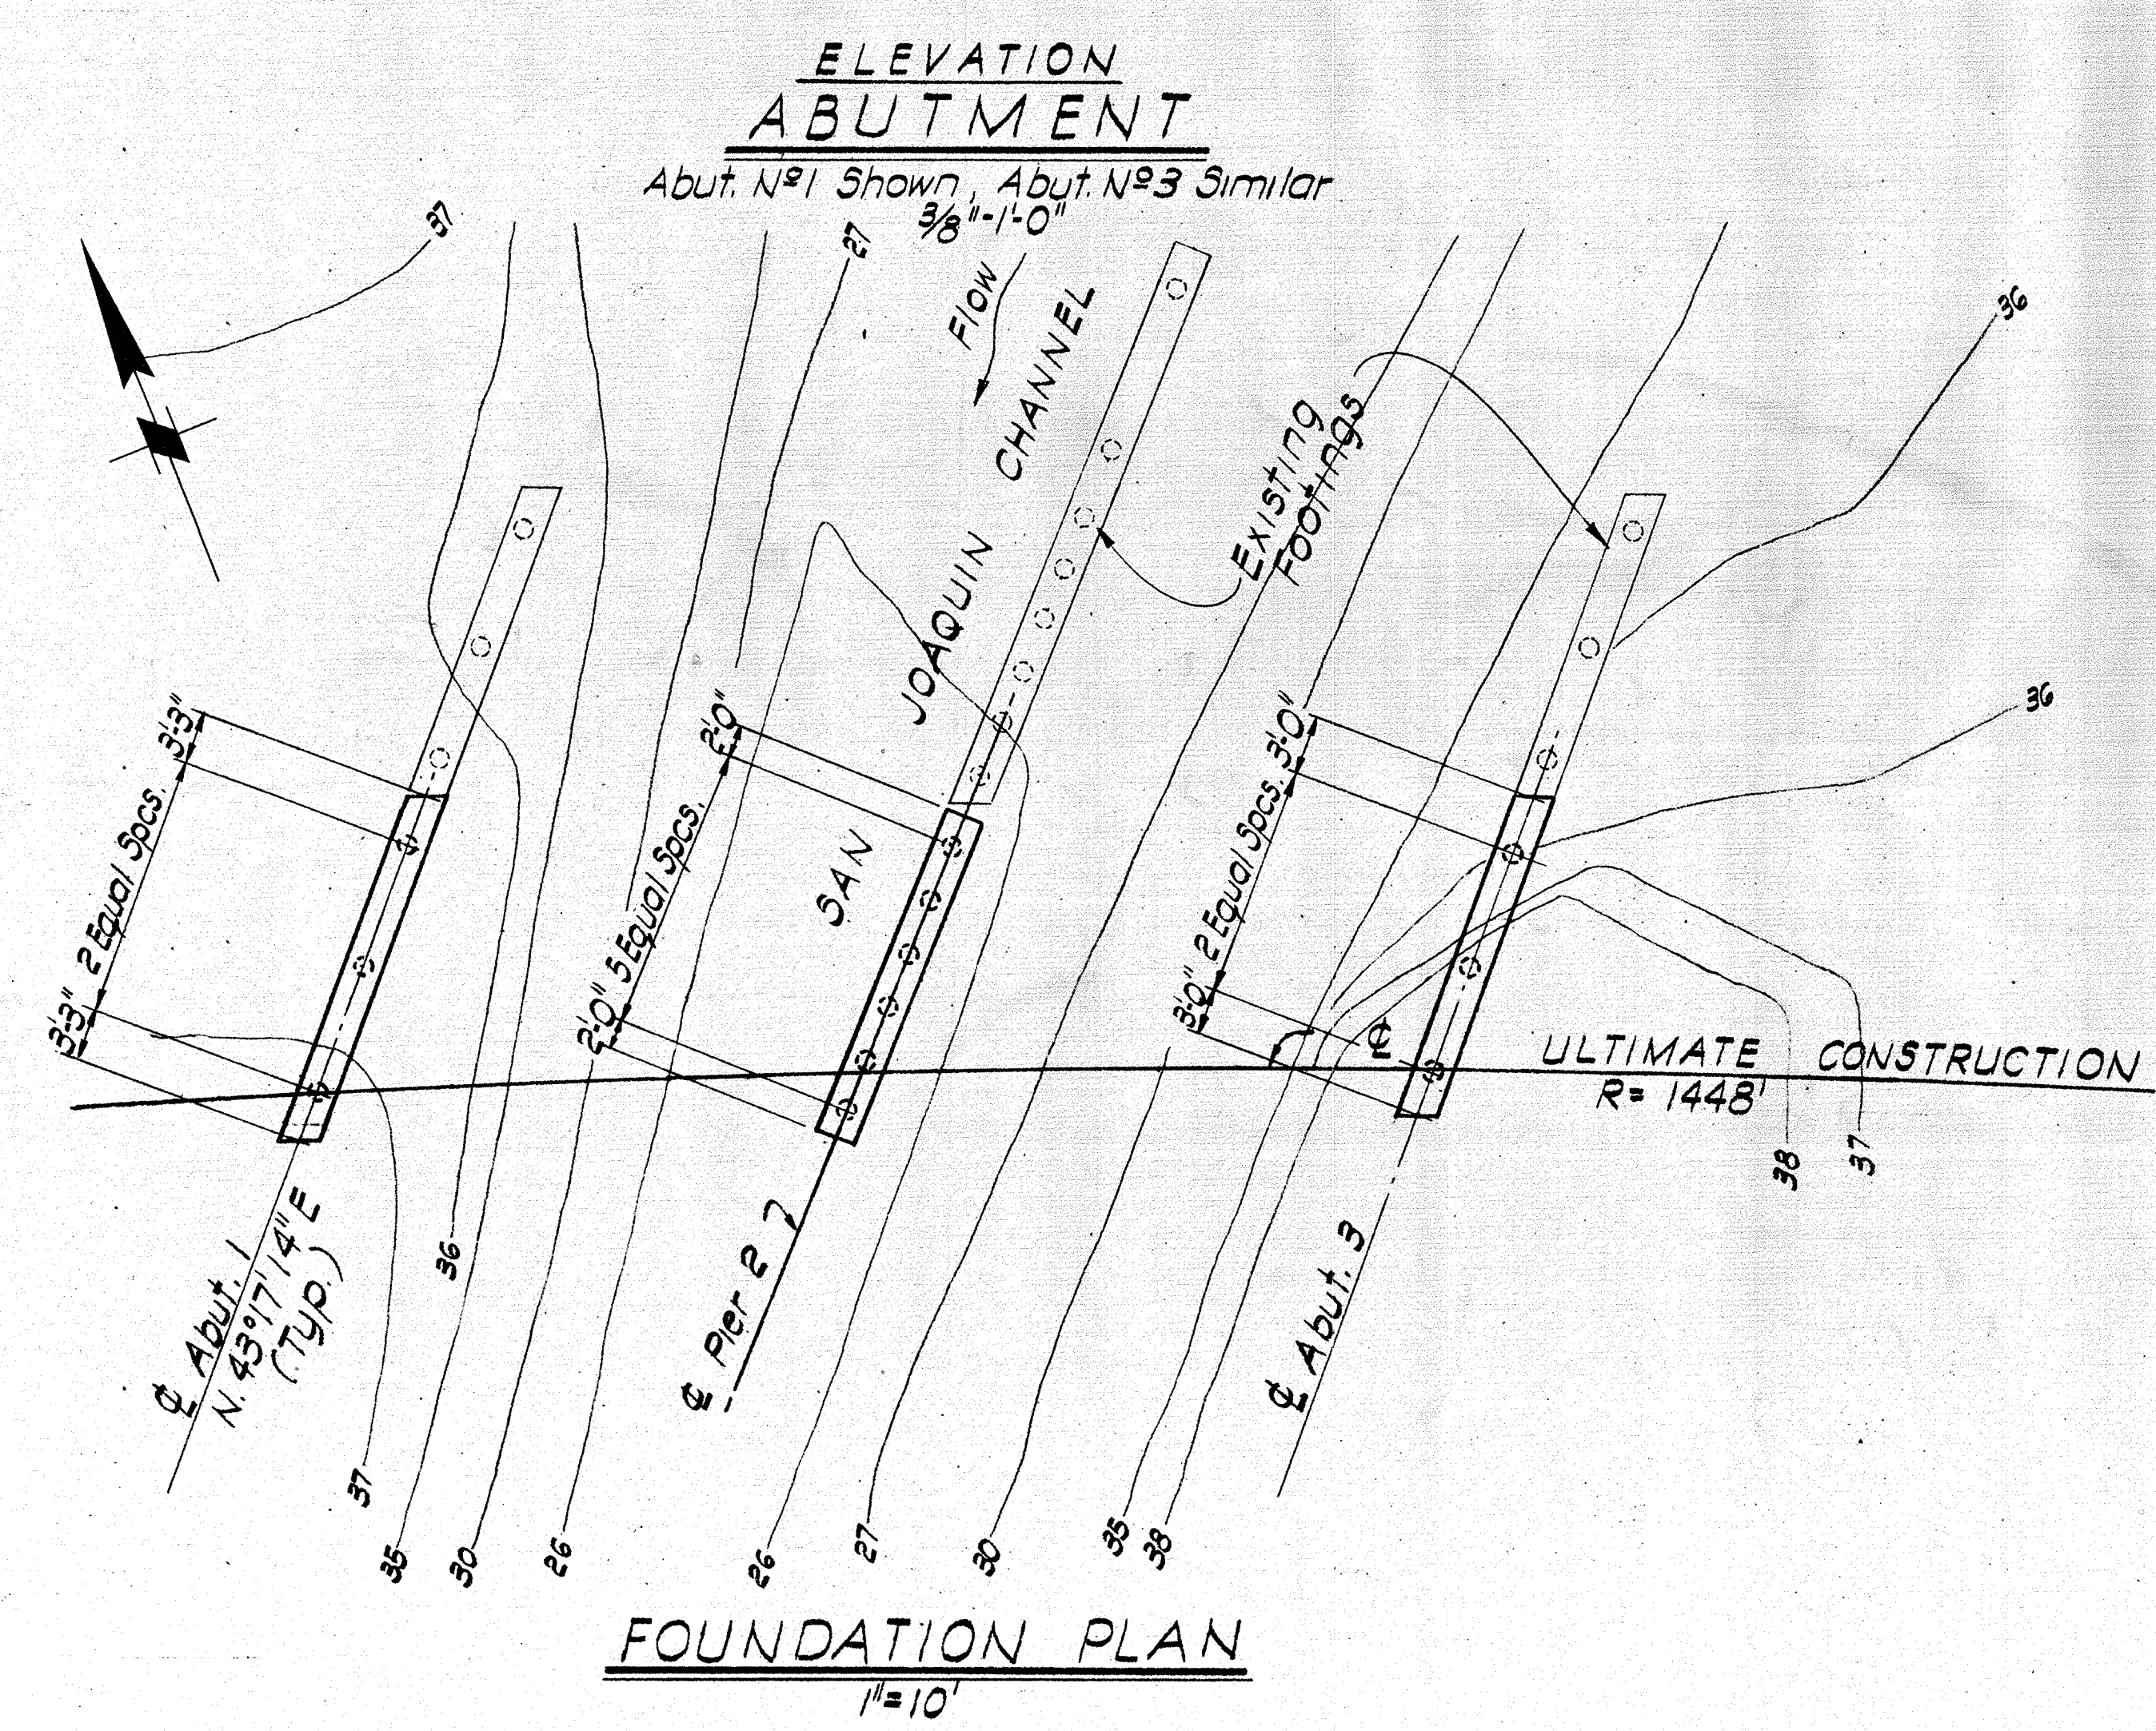
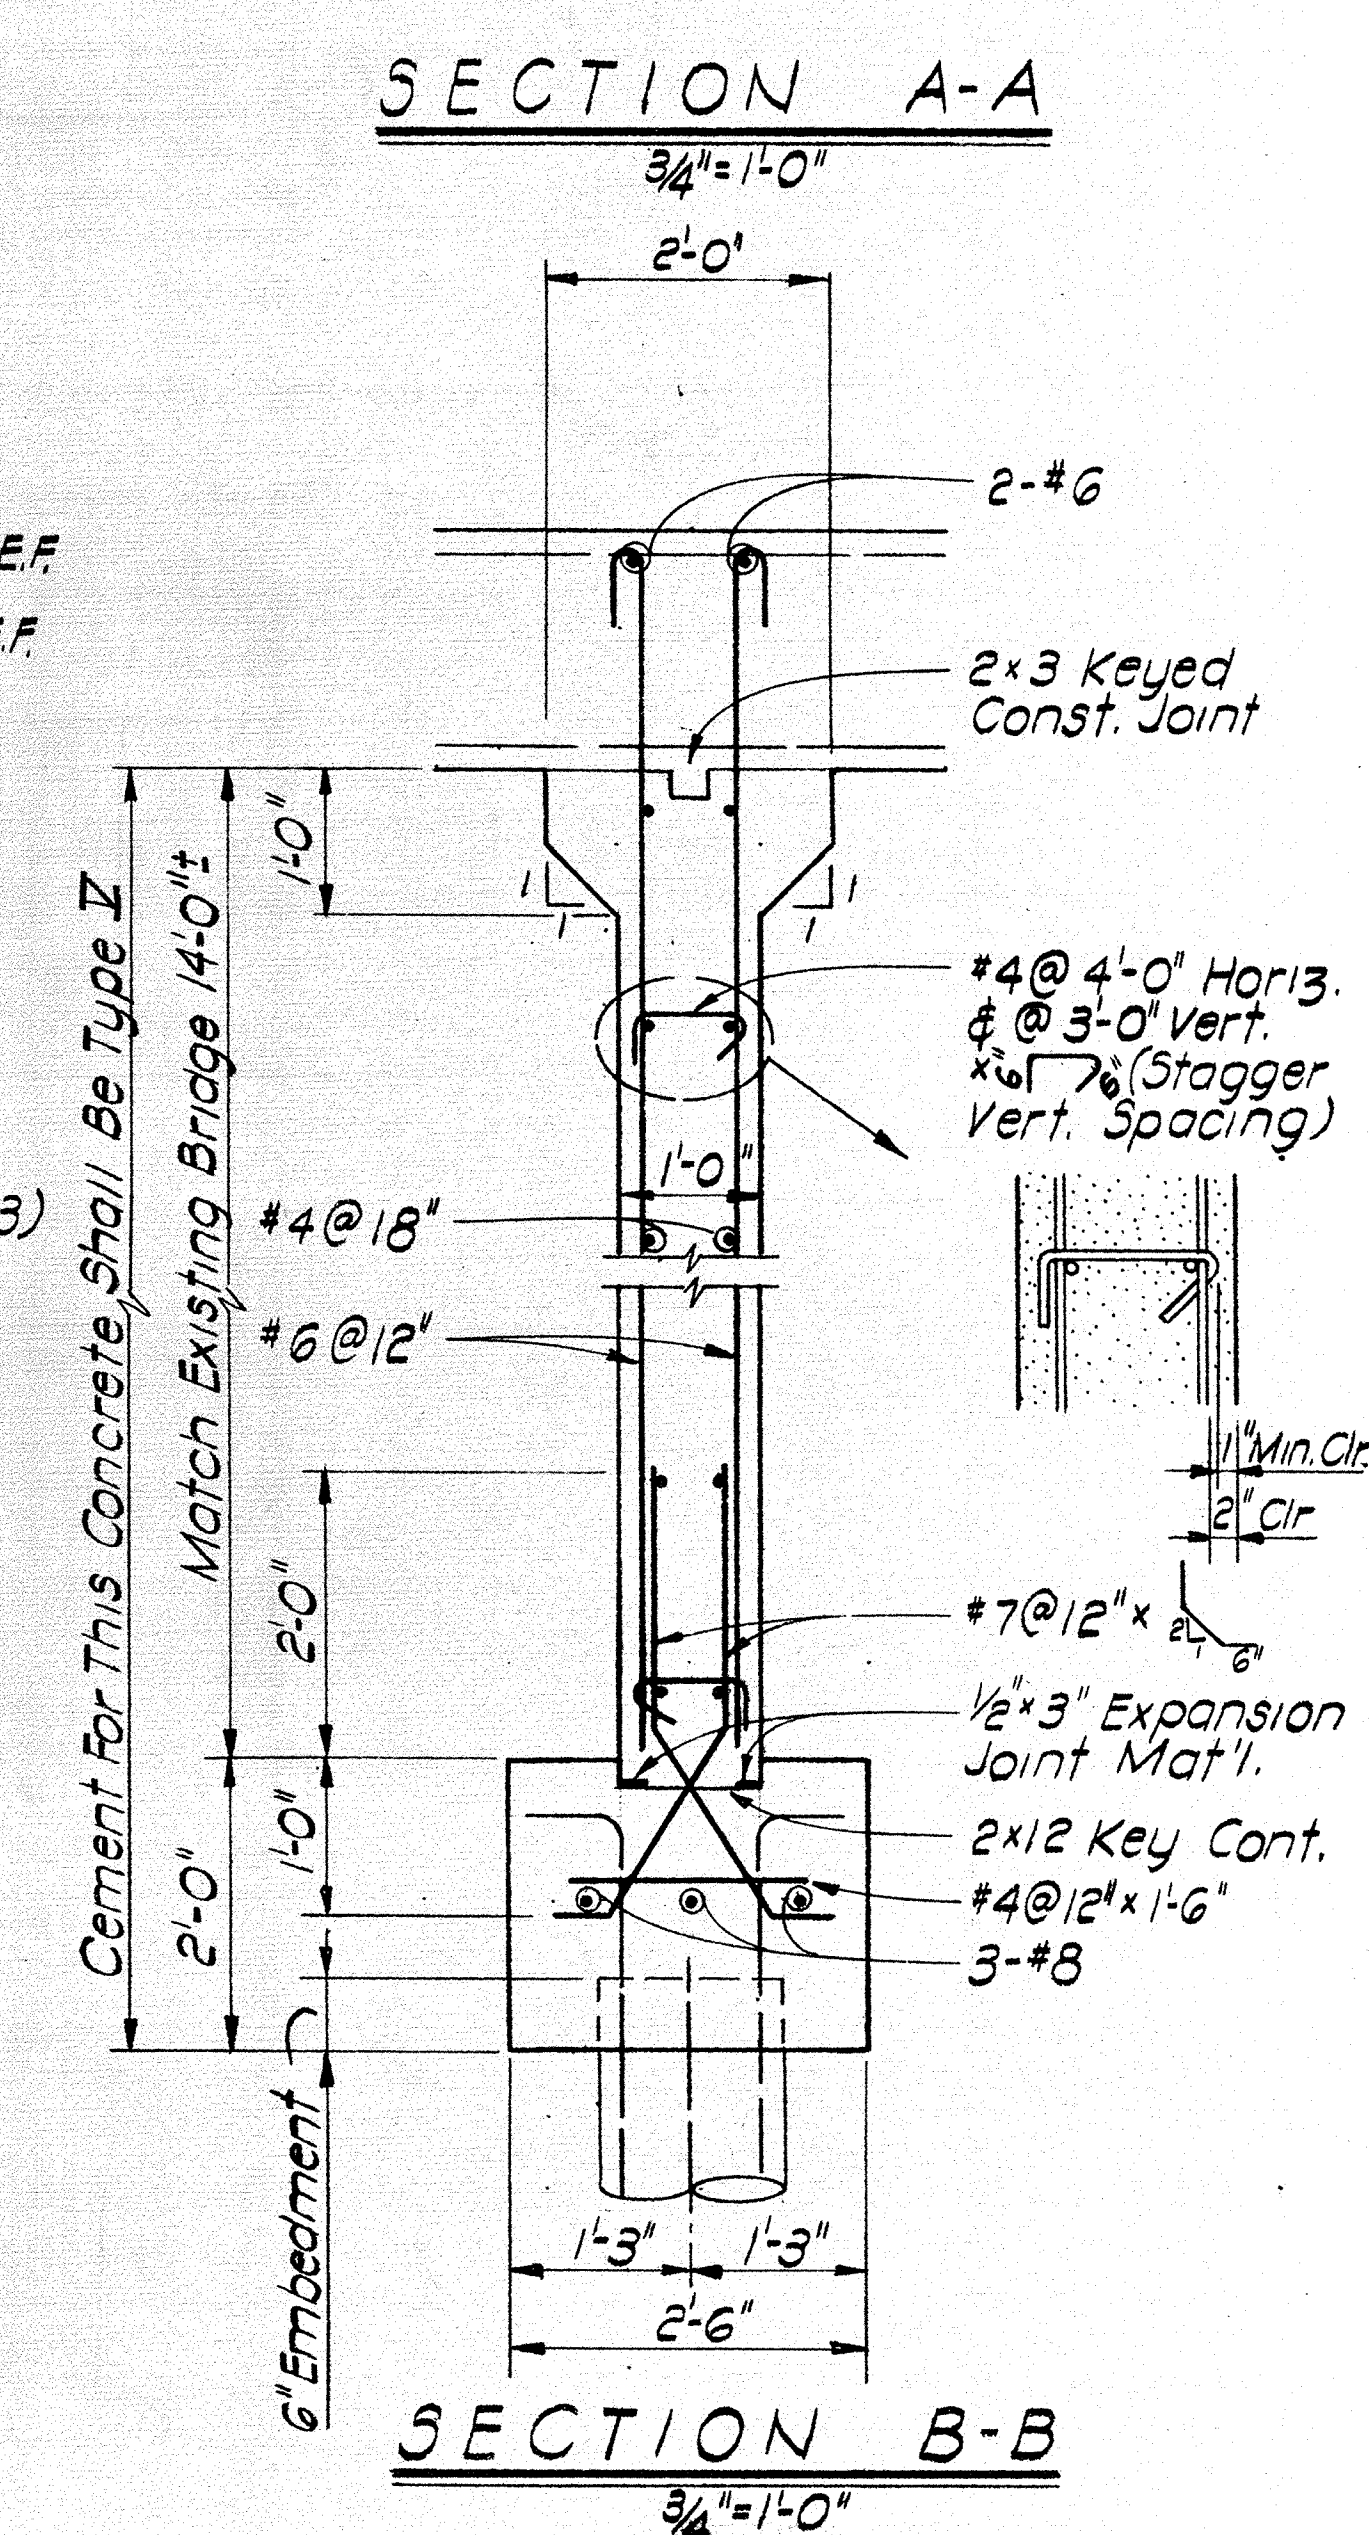
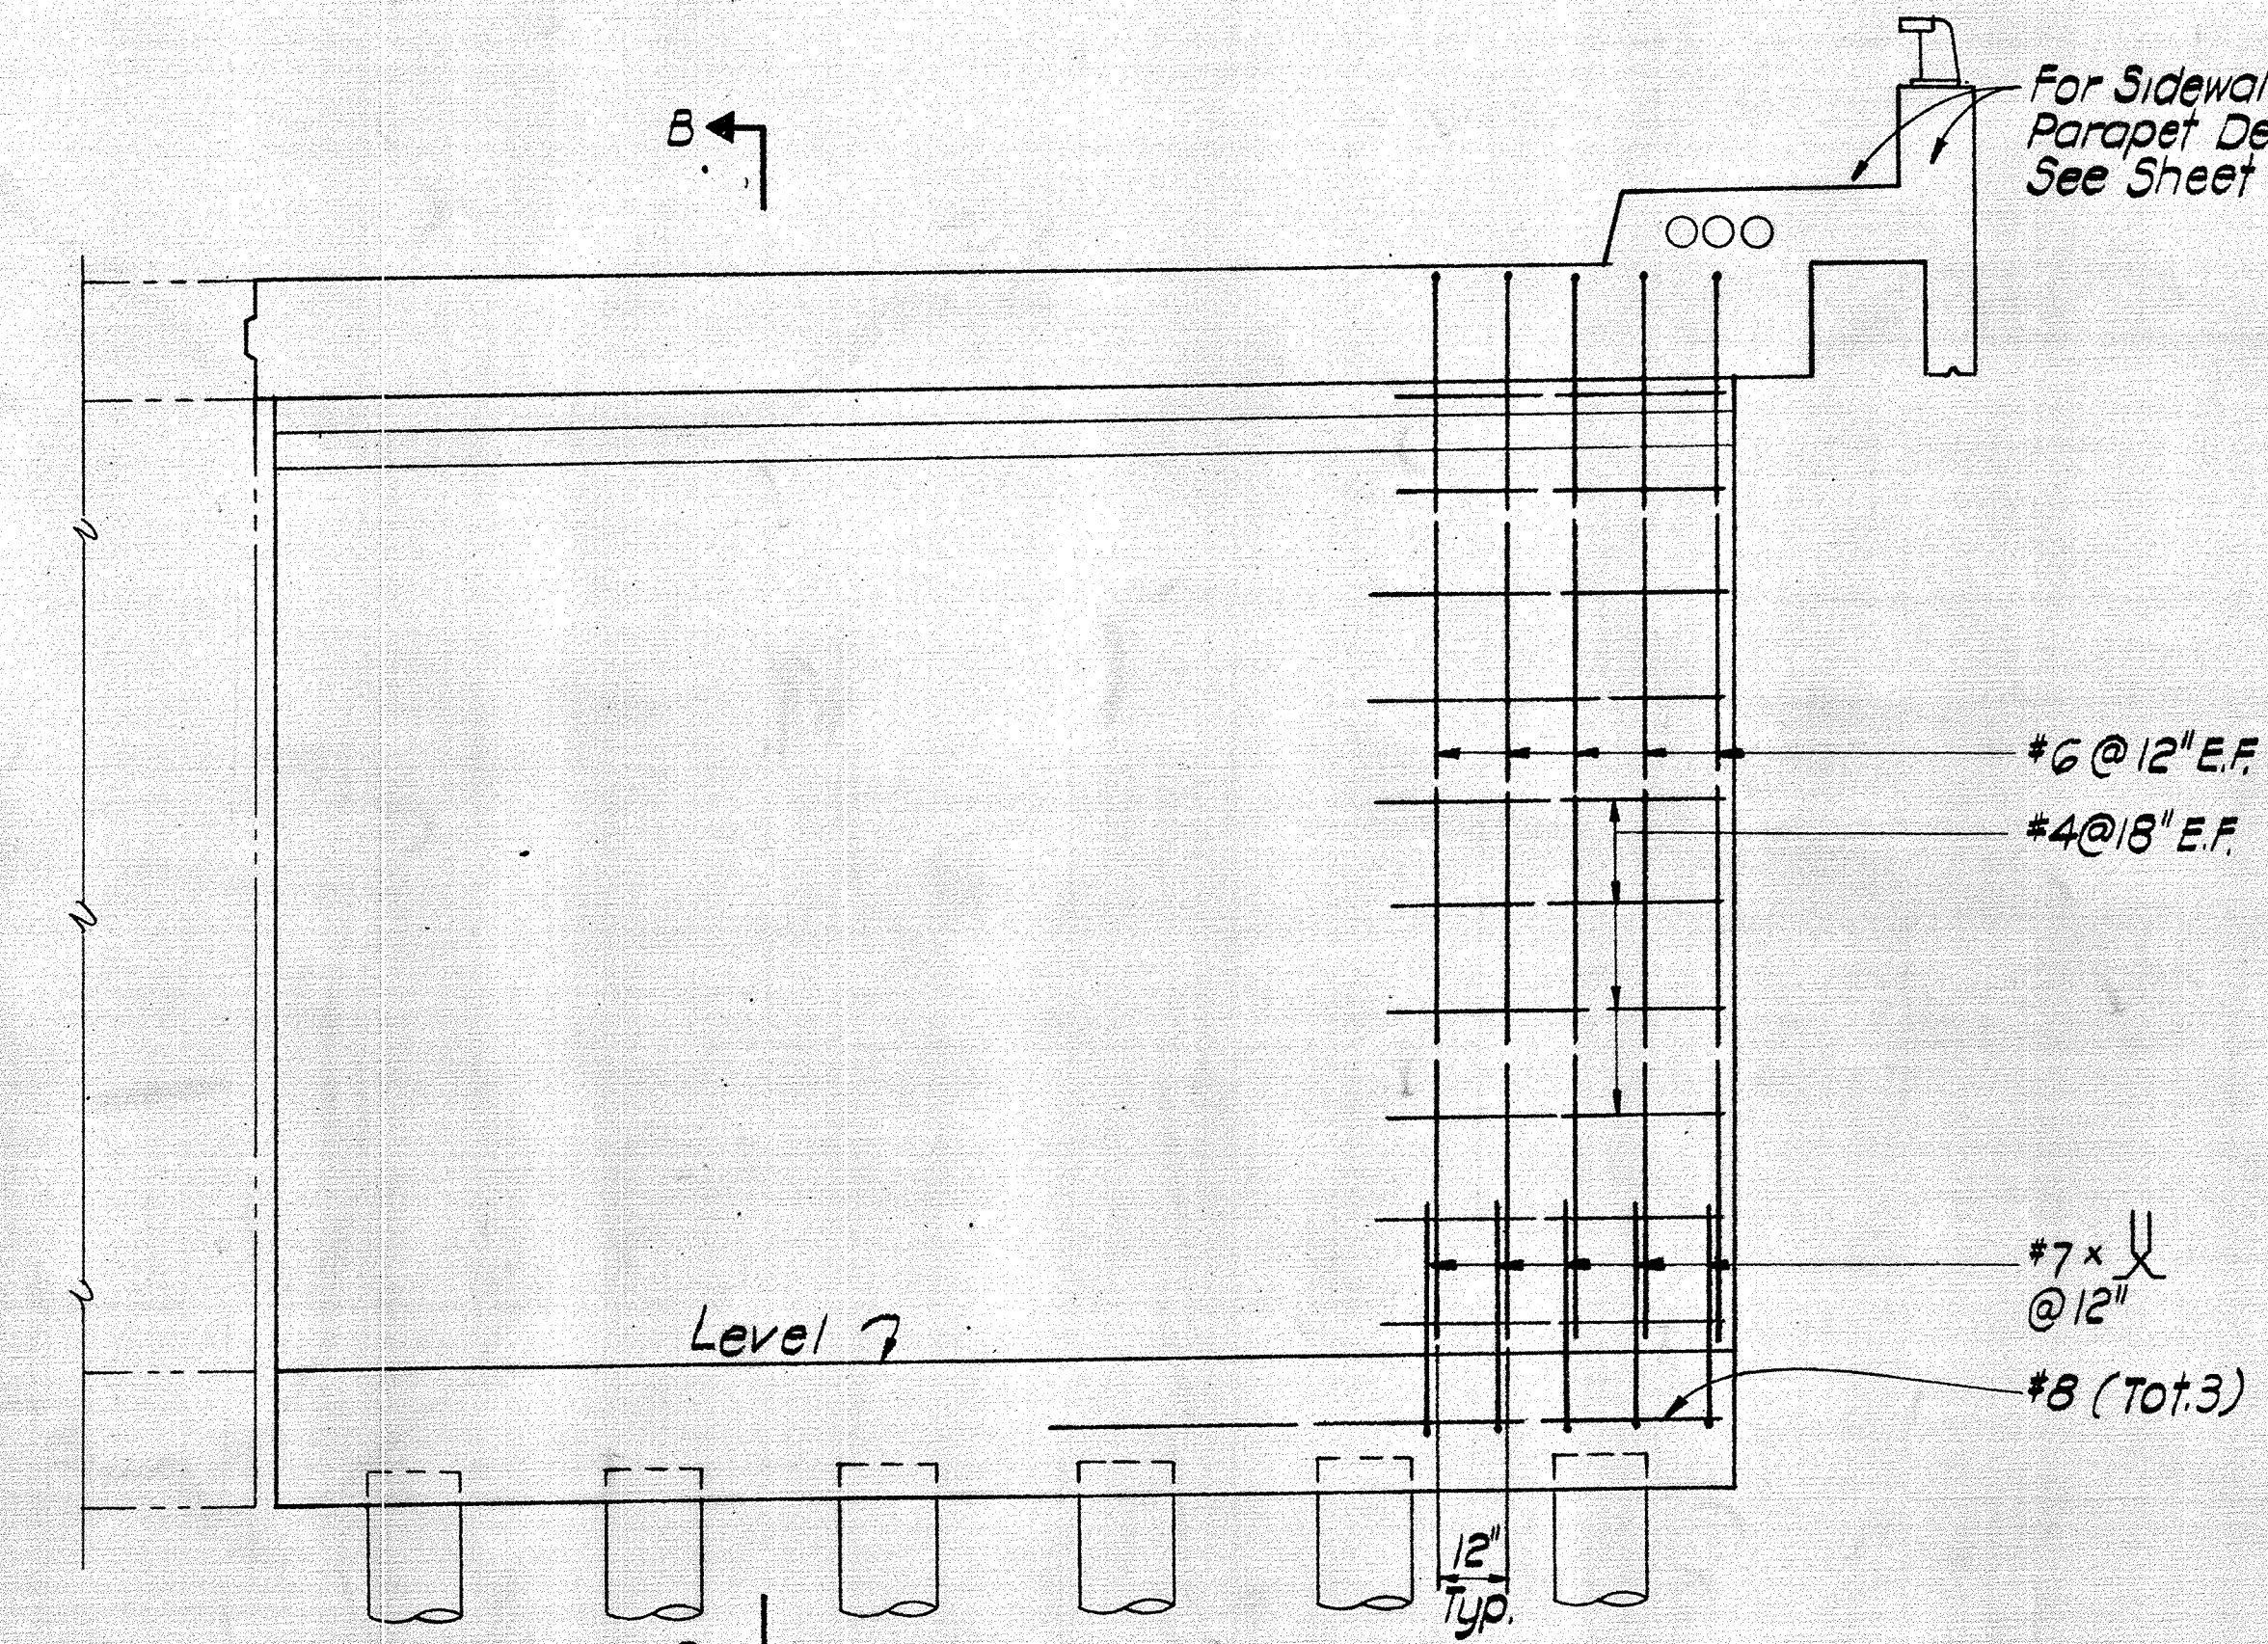
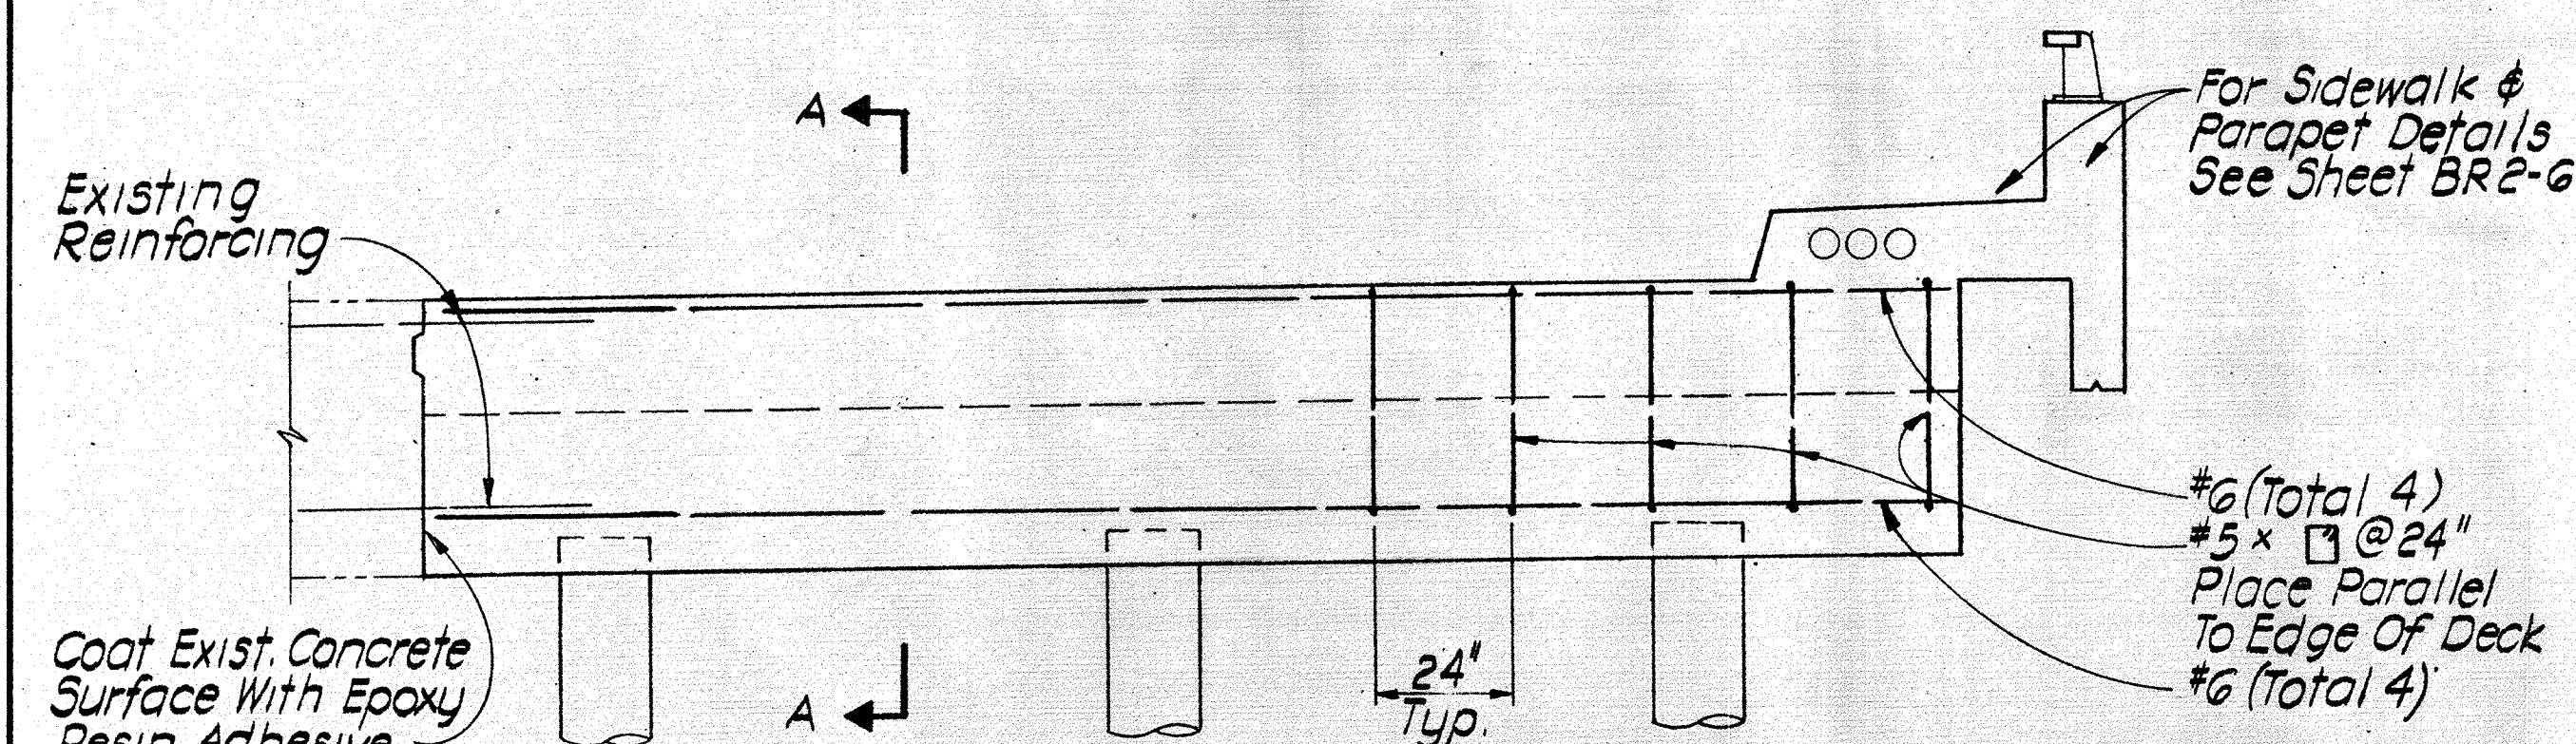
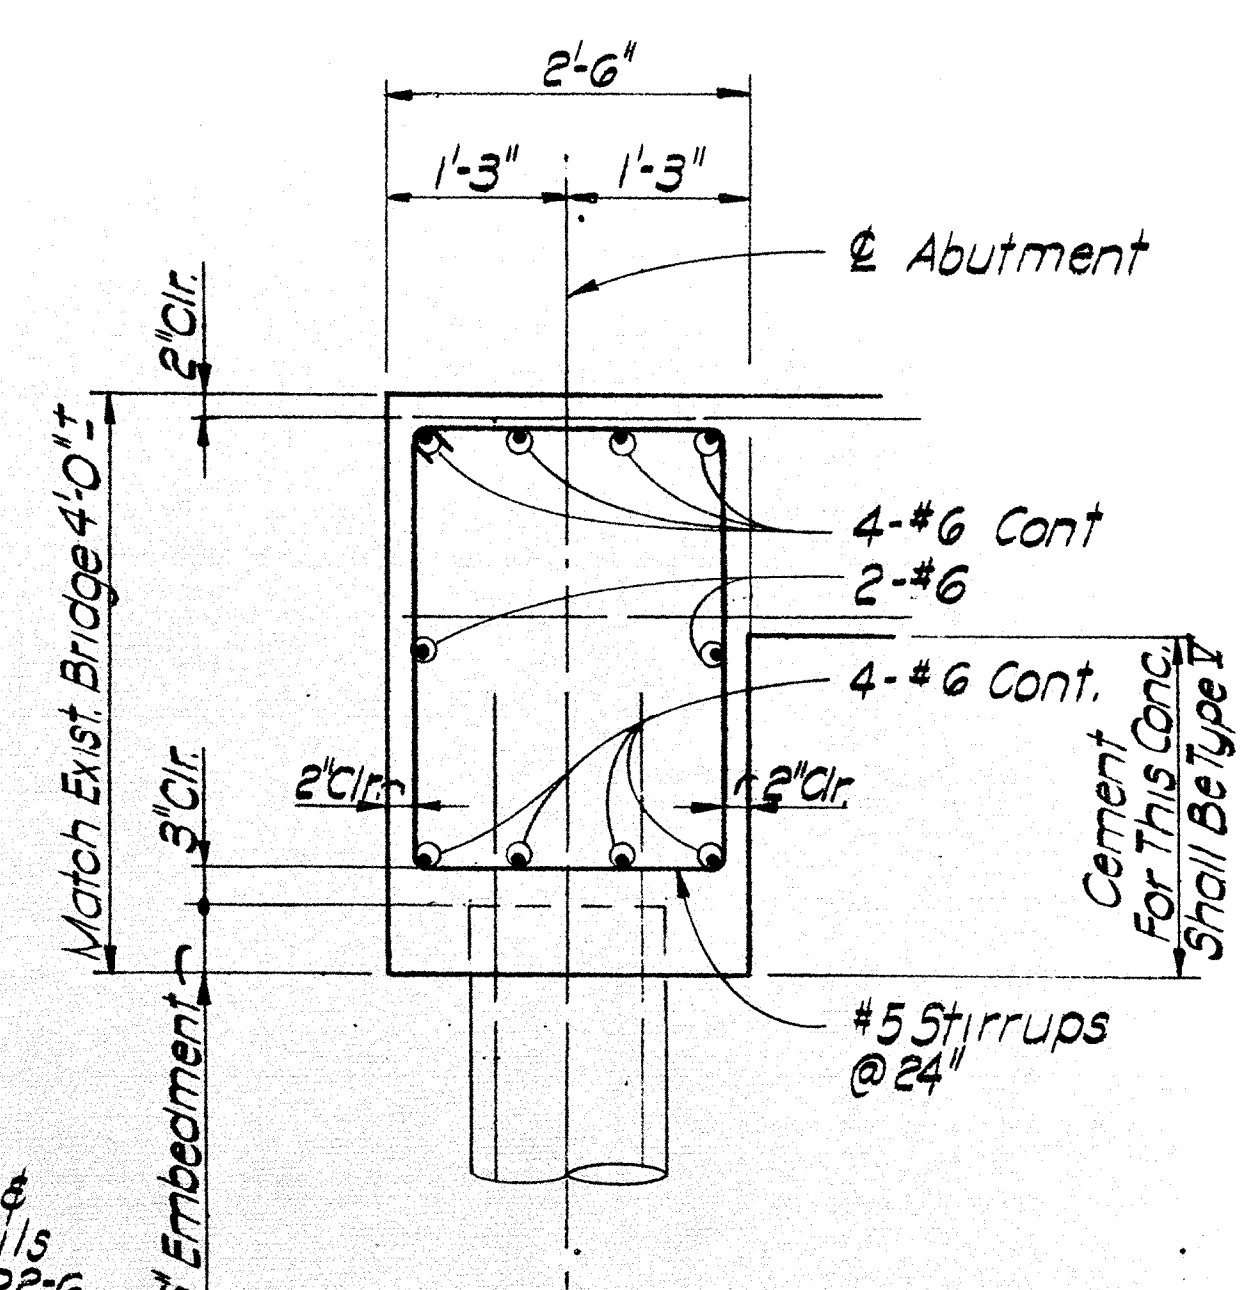
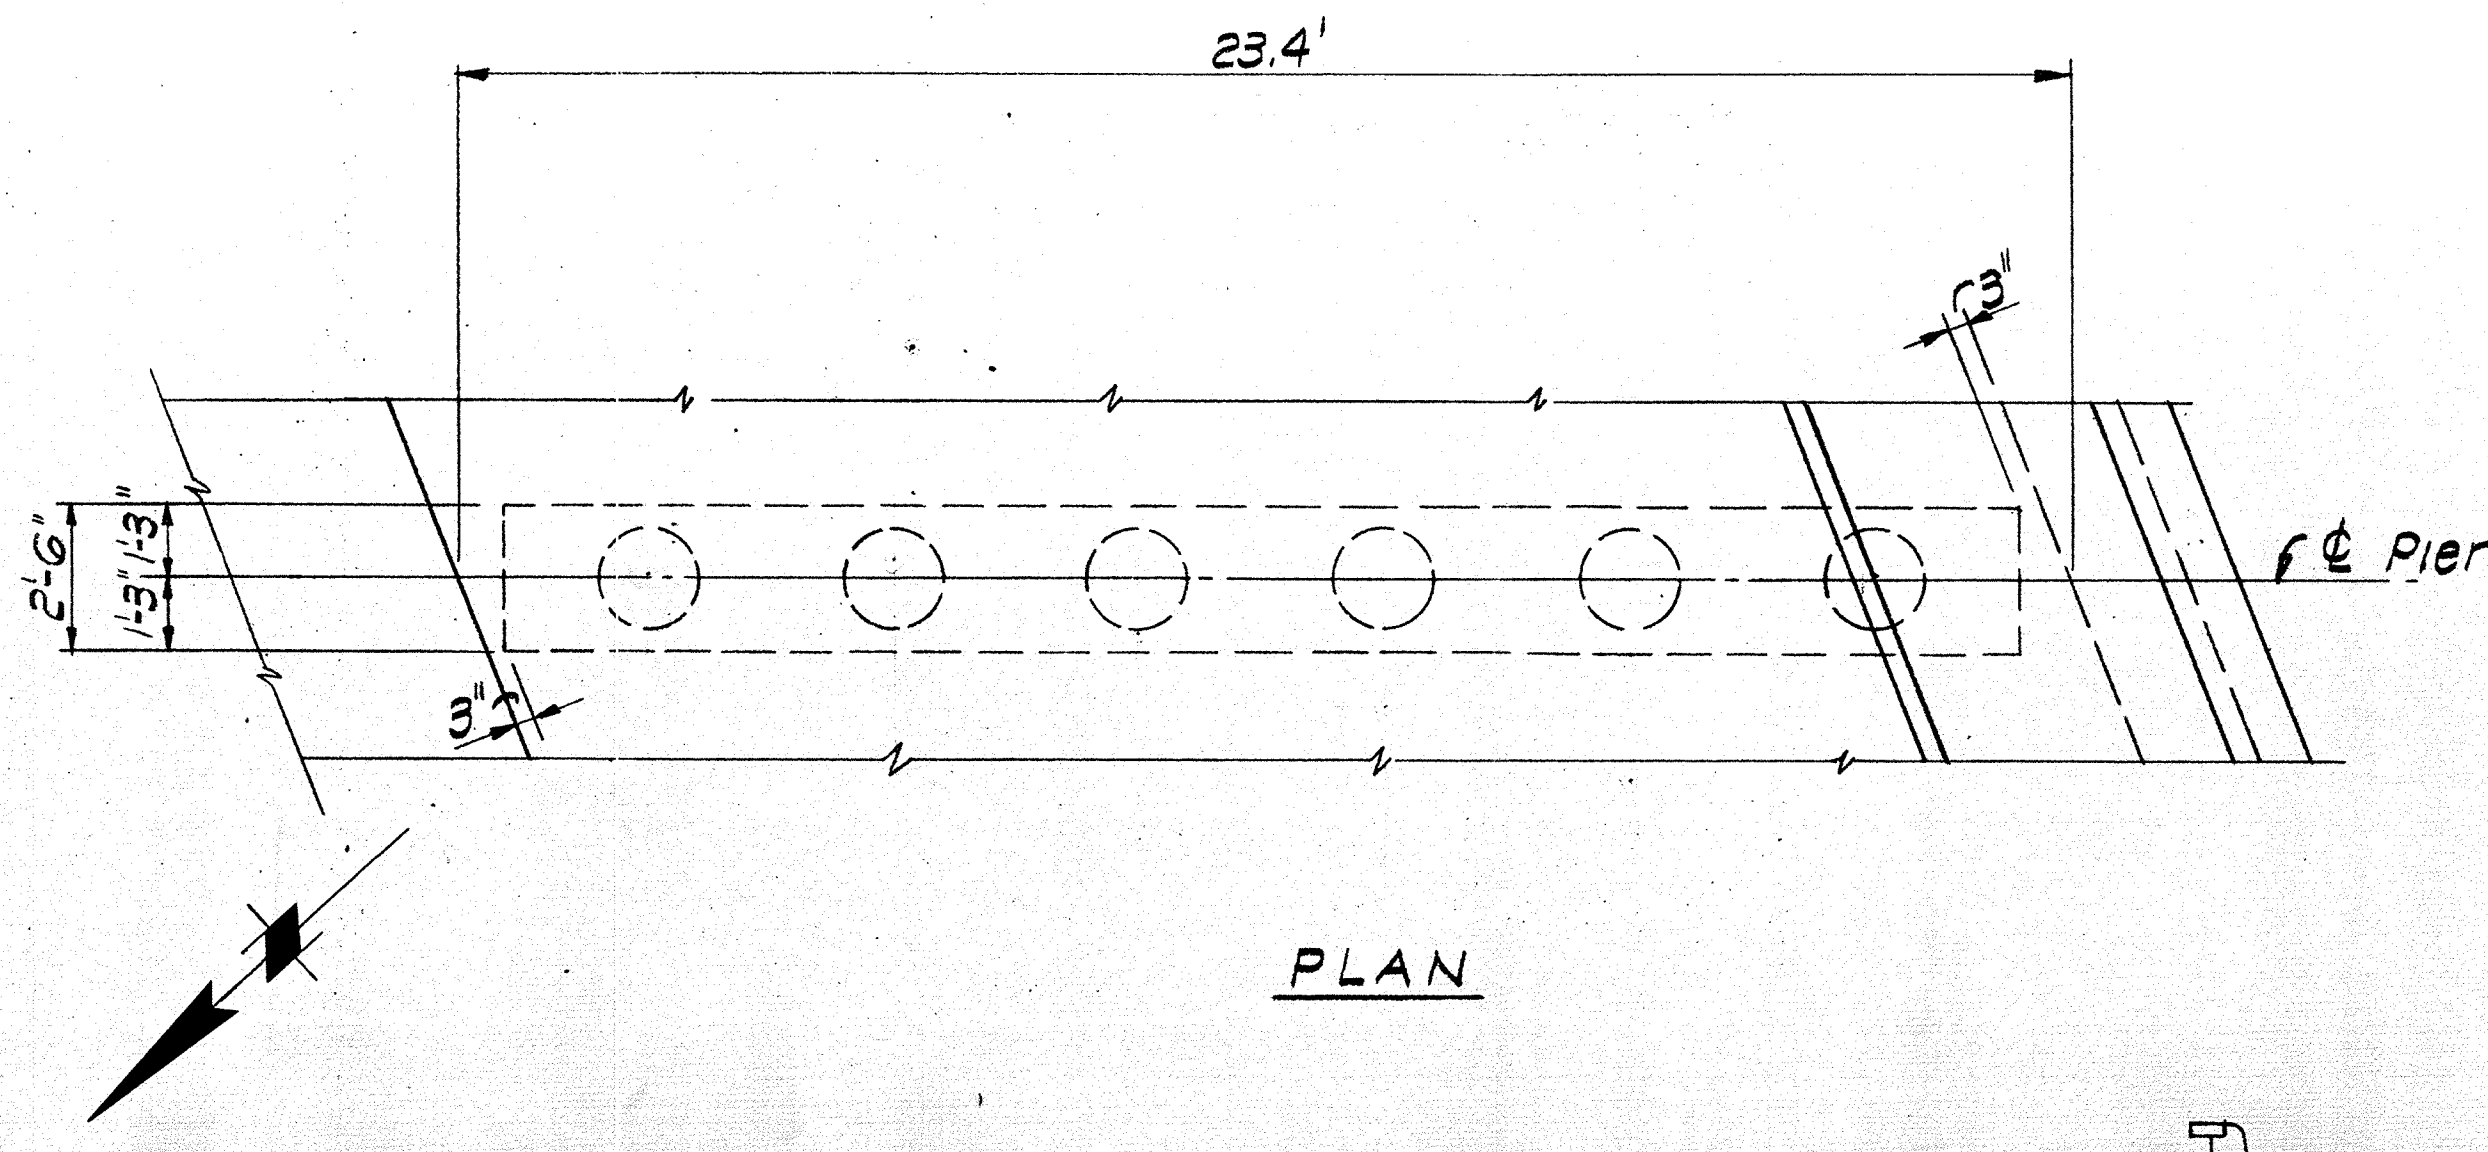


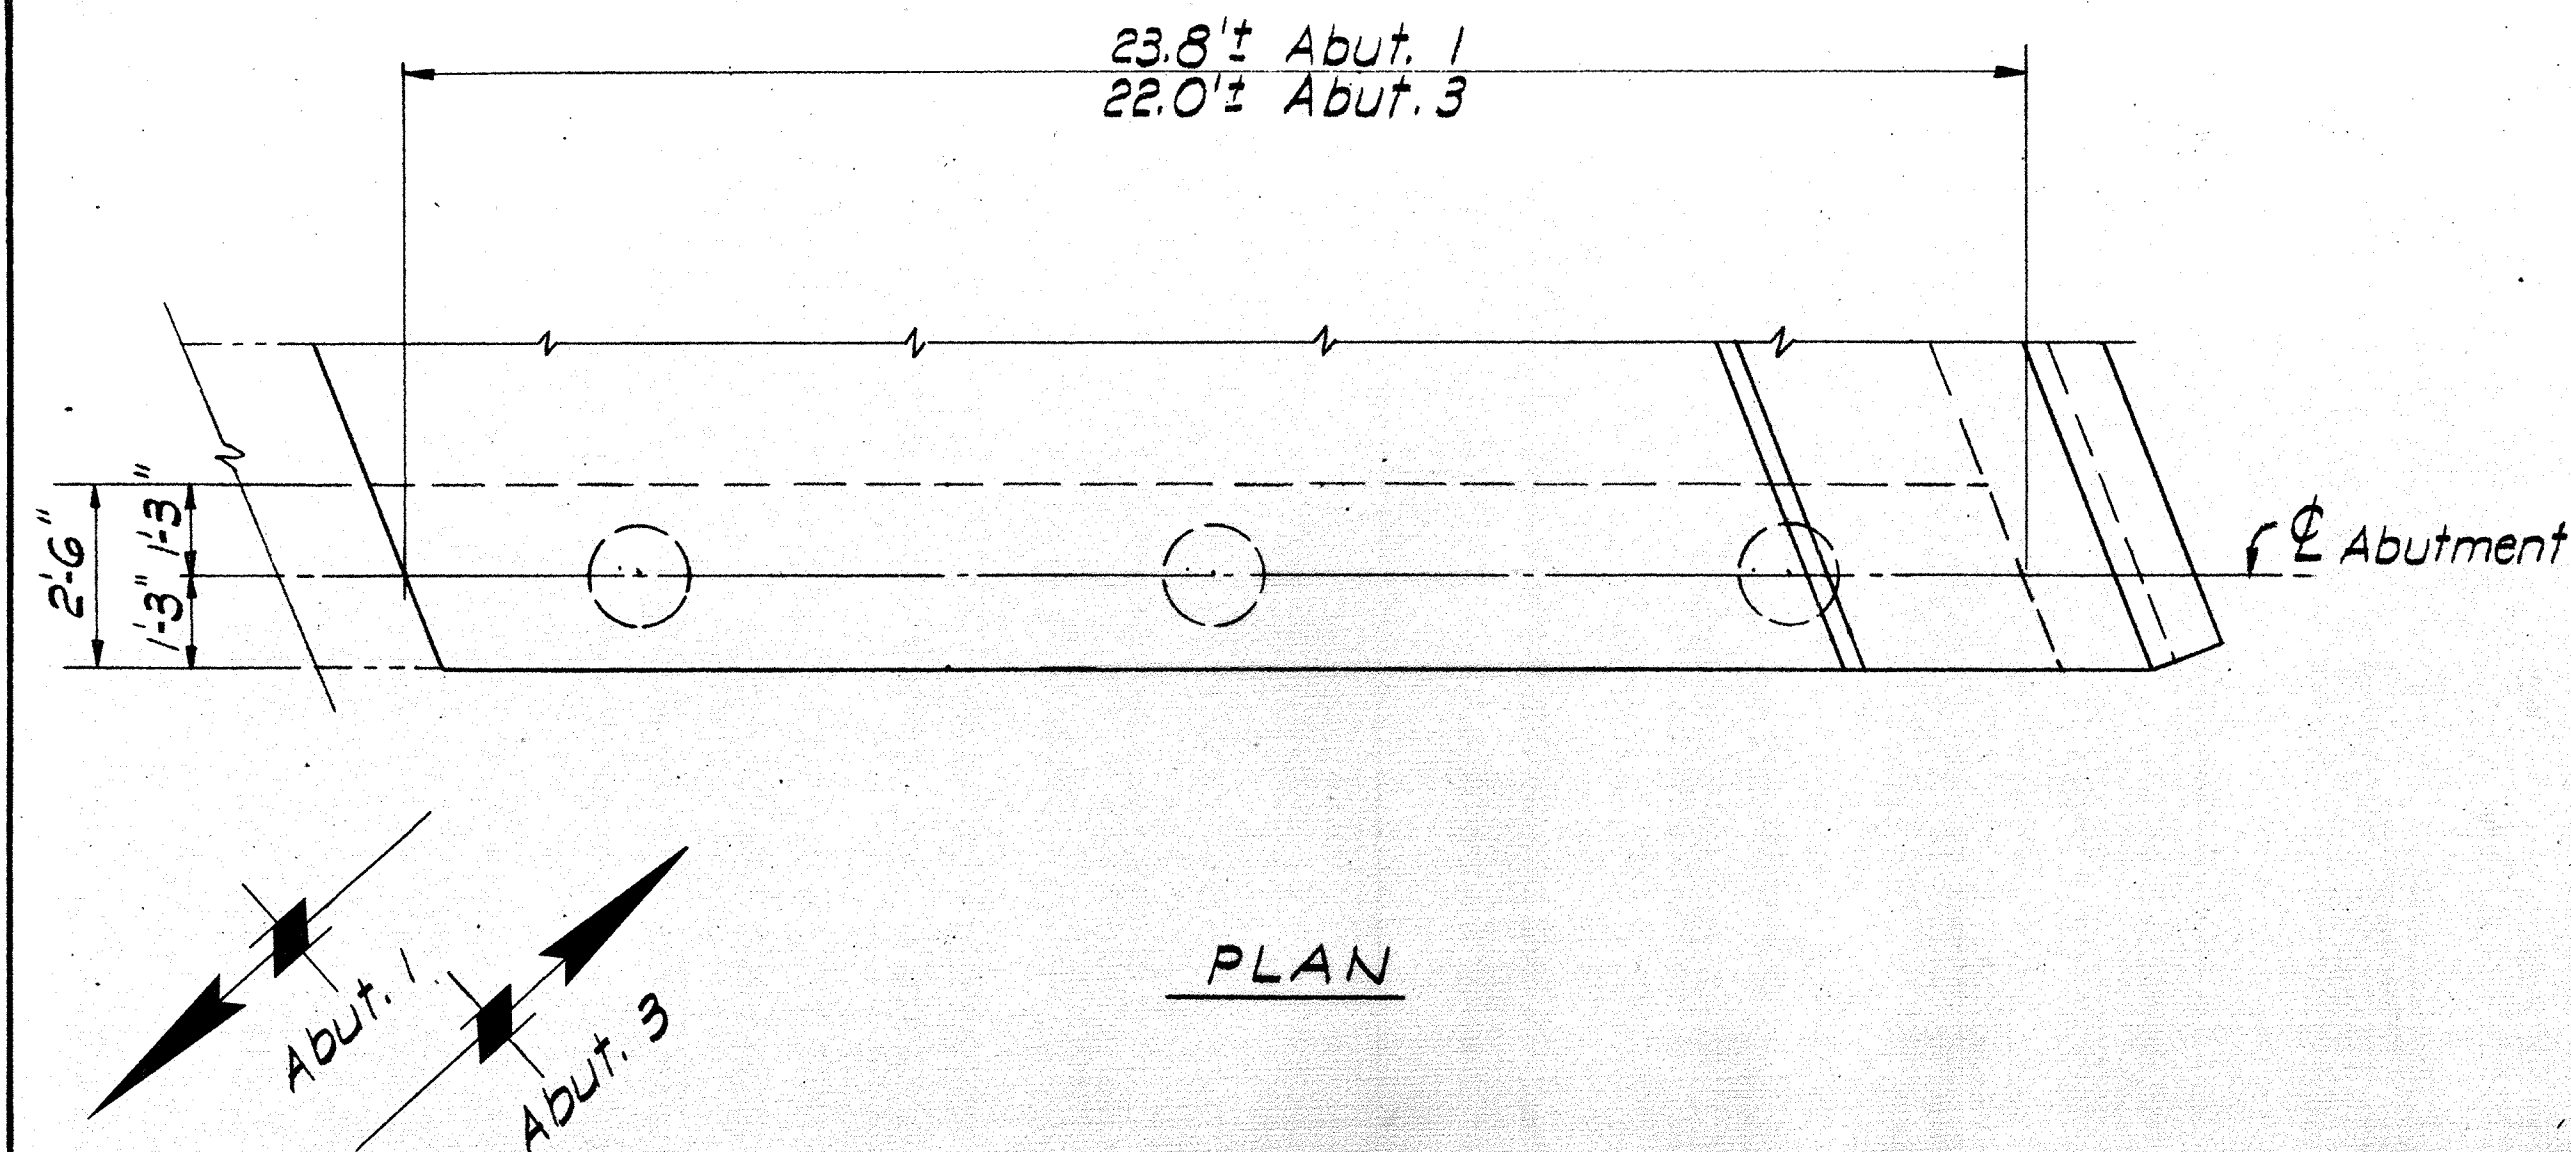

ORANGE COUNTY ROAD DEPARTMENT

MICHELSON DRIVE BRIDGE
(SD-25)
ACROSS
SAN JOAQUIN CHANNEL

ABUTMENTS AND PIERS

SCALE Noted

SHEET BR2-2 OF 7