



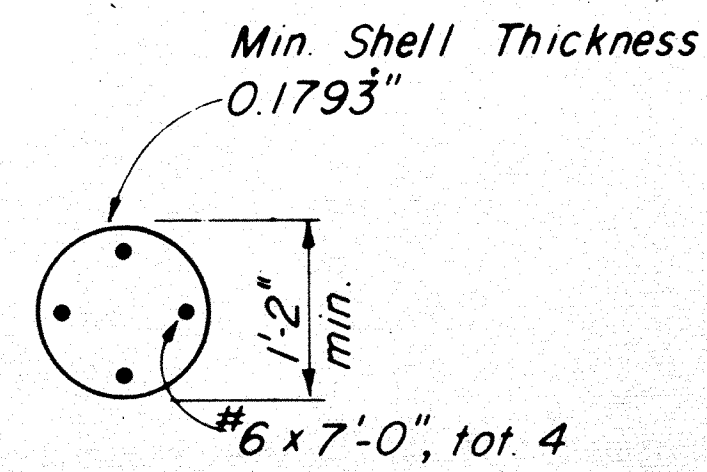


U-U


NOTE:
When "ALTERNATIVE U" is driven with mandrel, shell thickness may be reduced to 0.134"

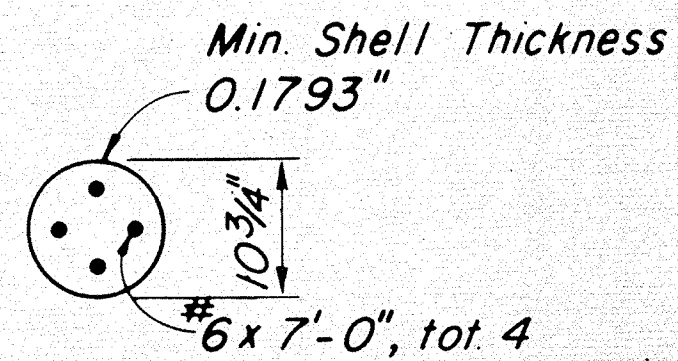

U-U

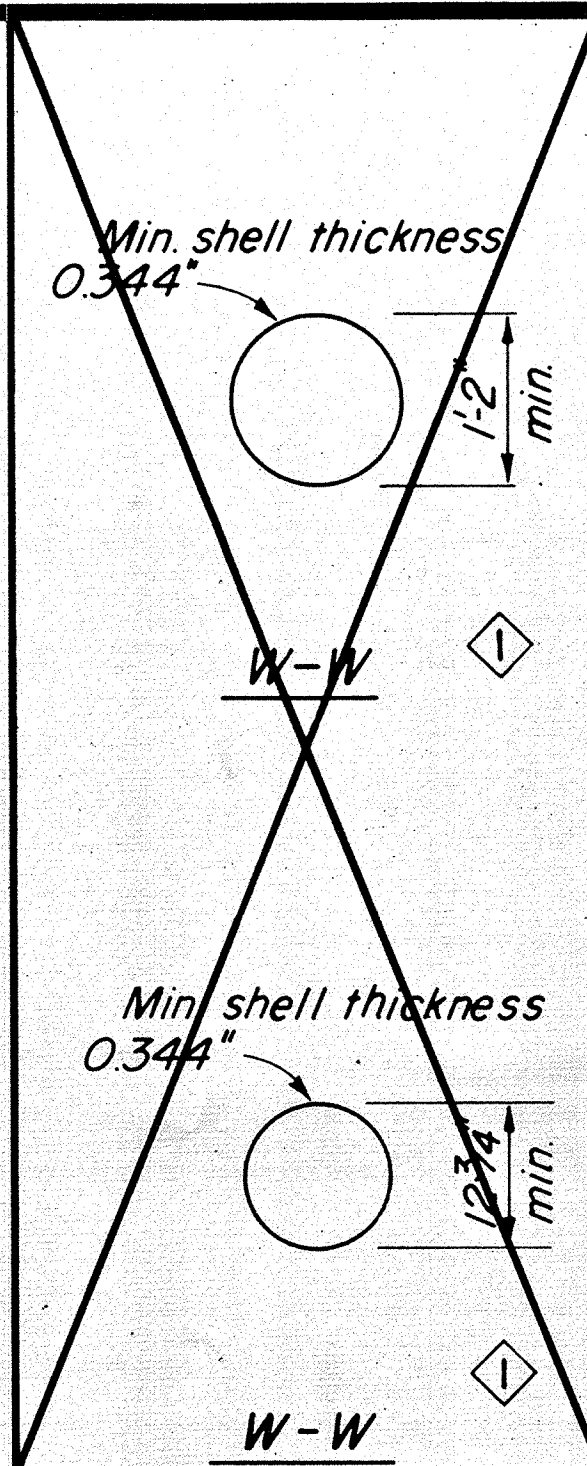


W-W

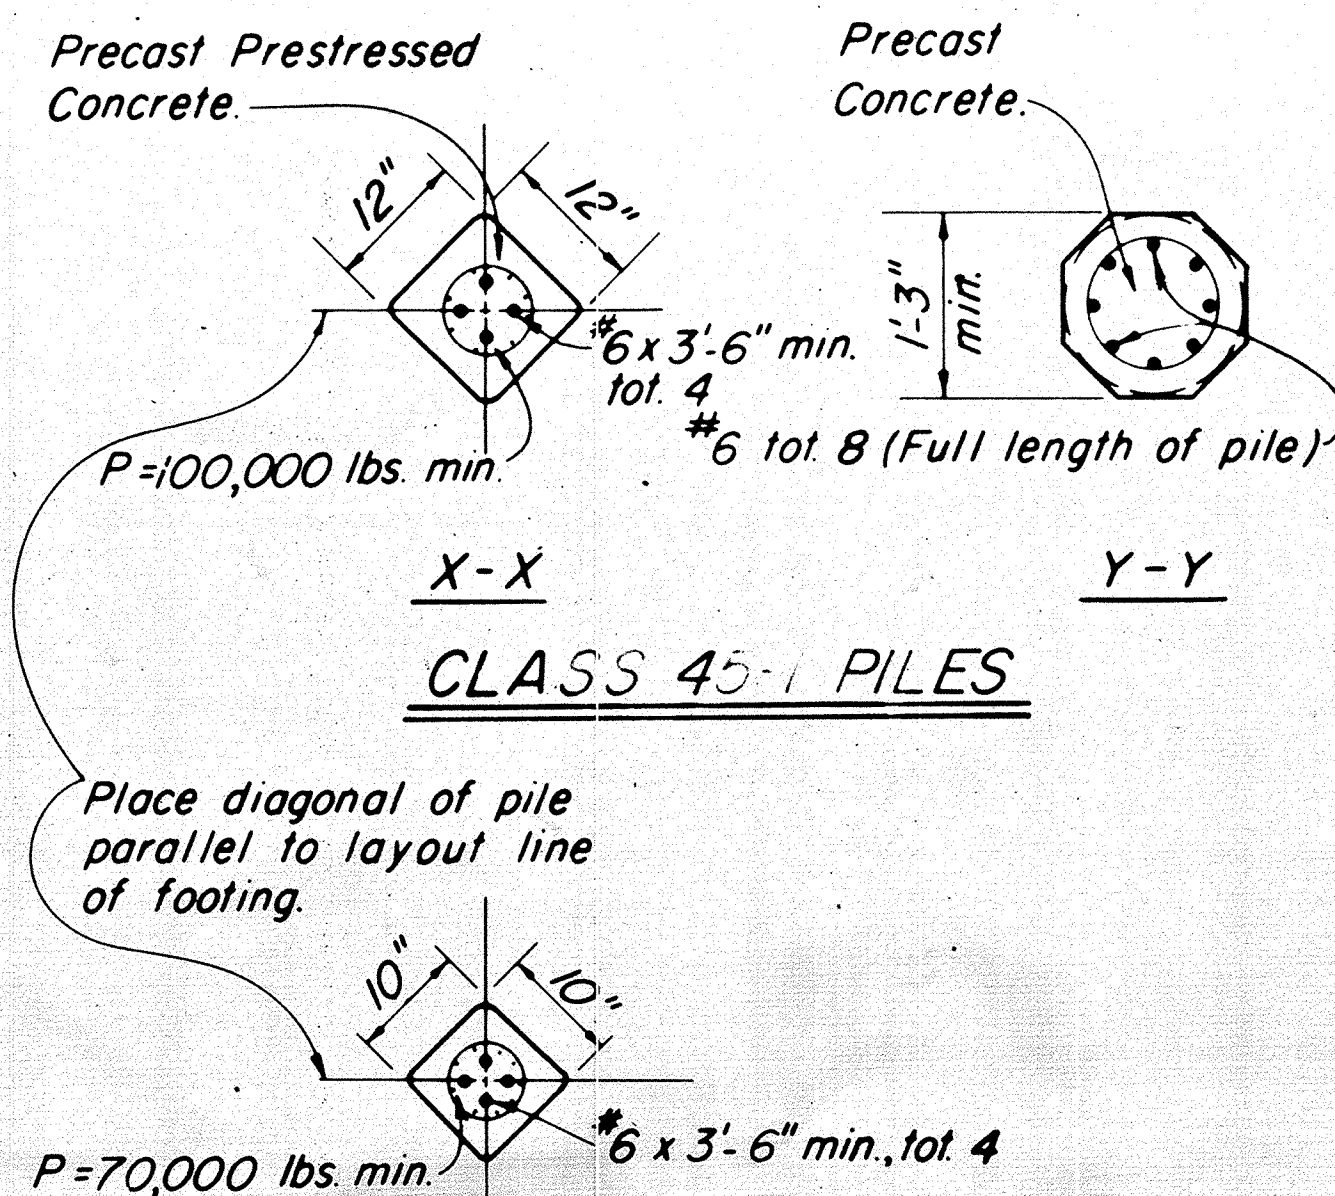


X-X

CLASS 45-1 PILES

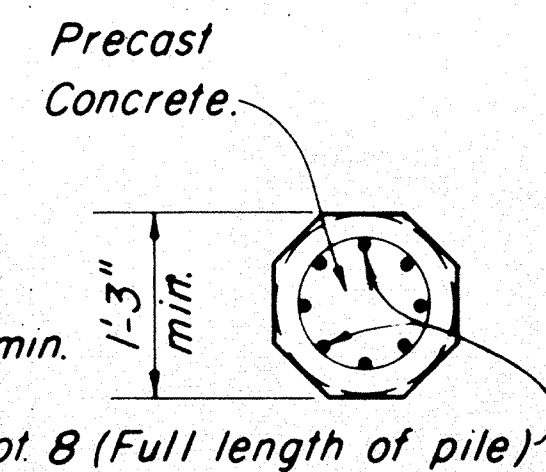


Y-Y

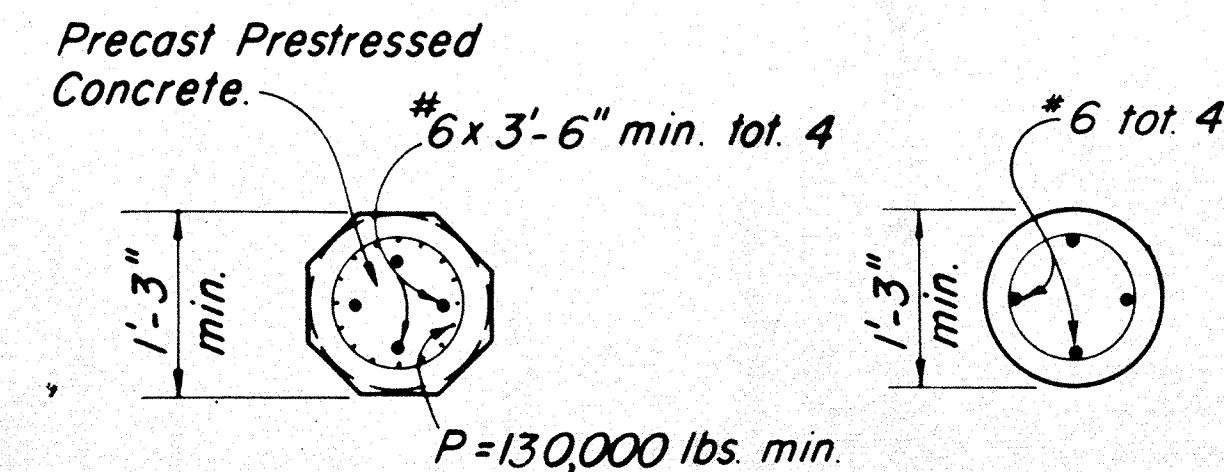


Y-Y

Z-Z

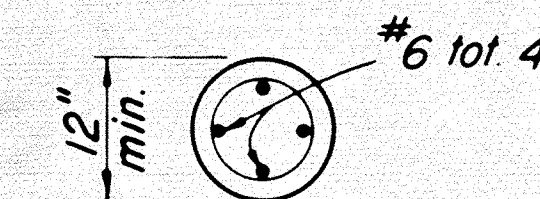


Z-Z


CLASS 45-2 PILES

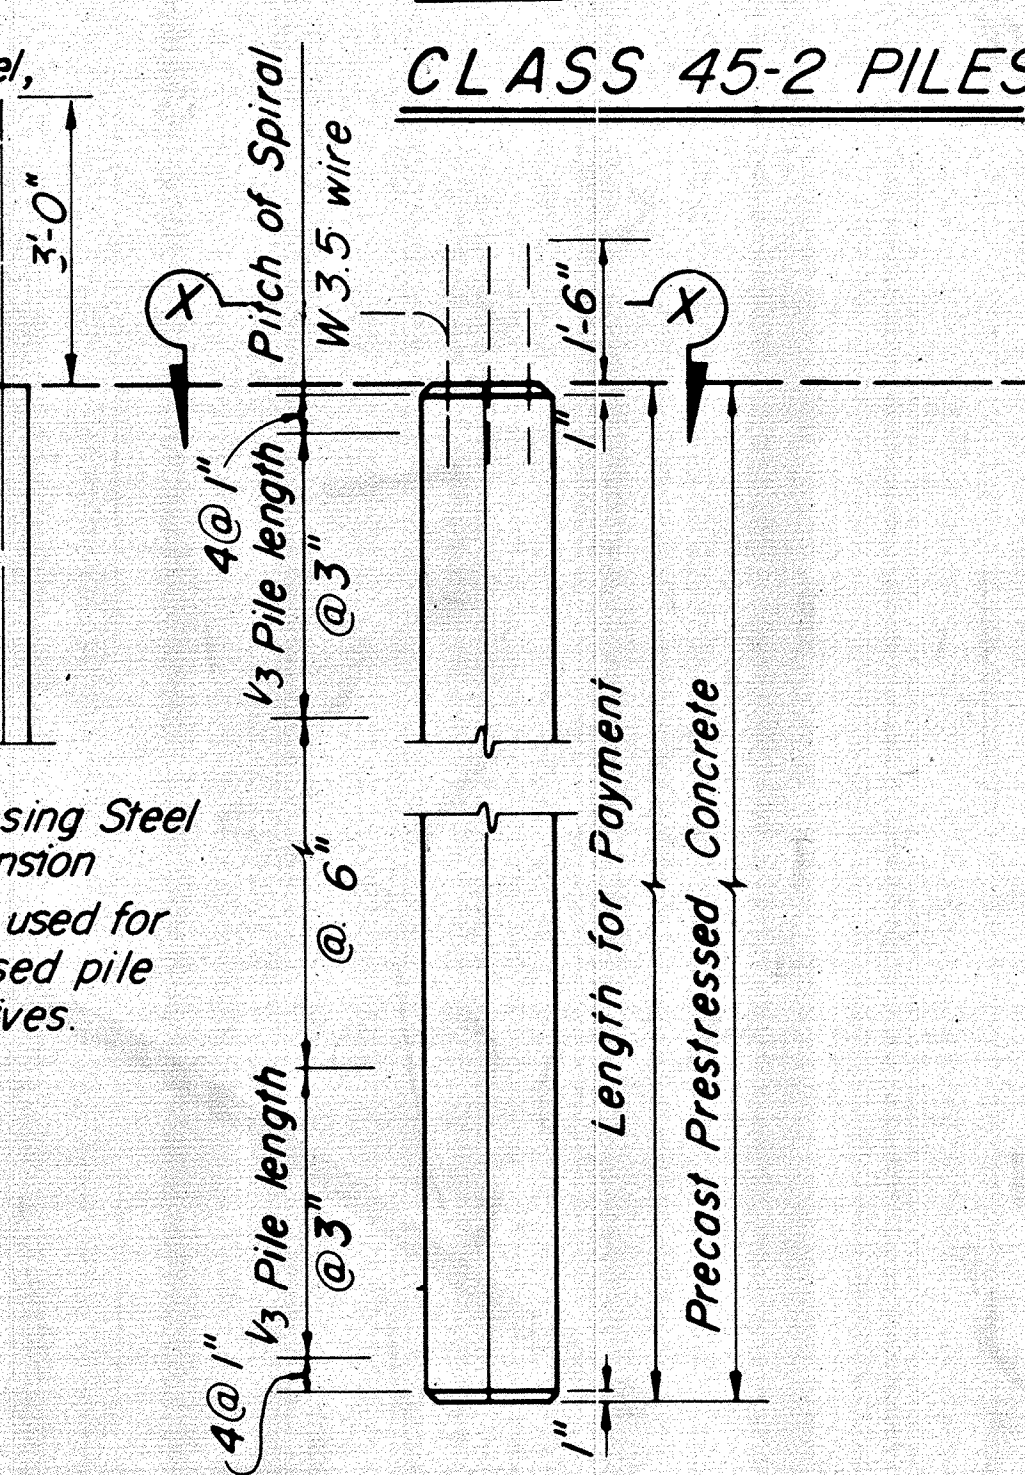

ALTERNATIVE "X"

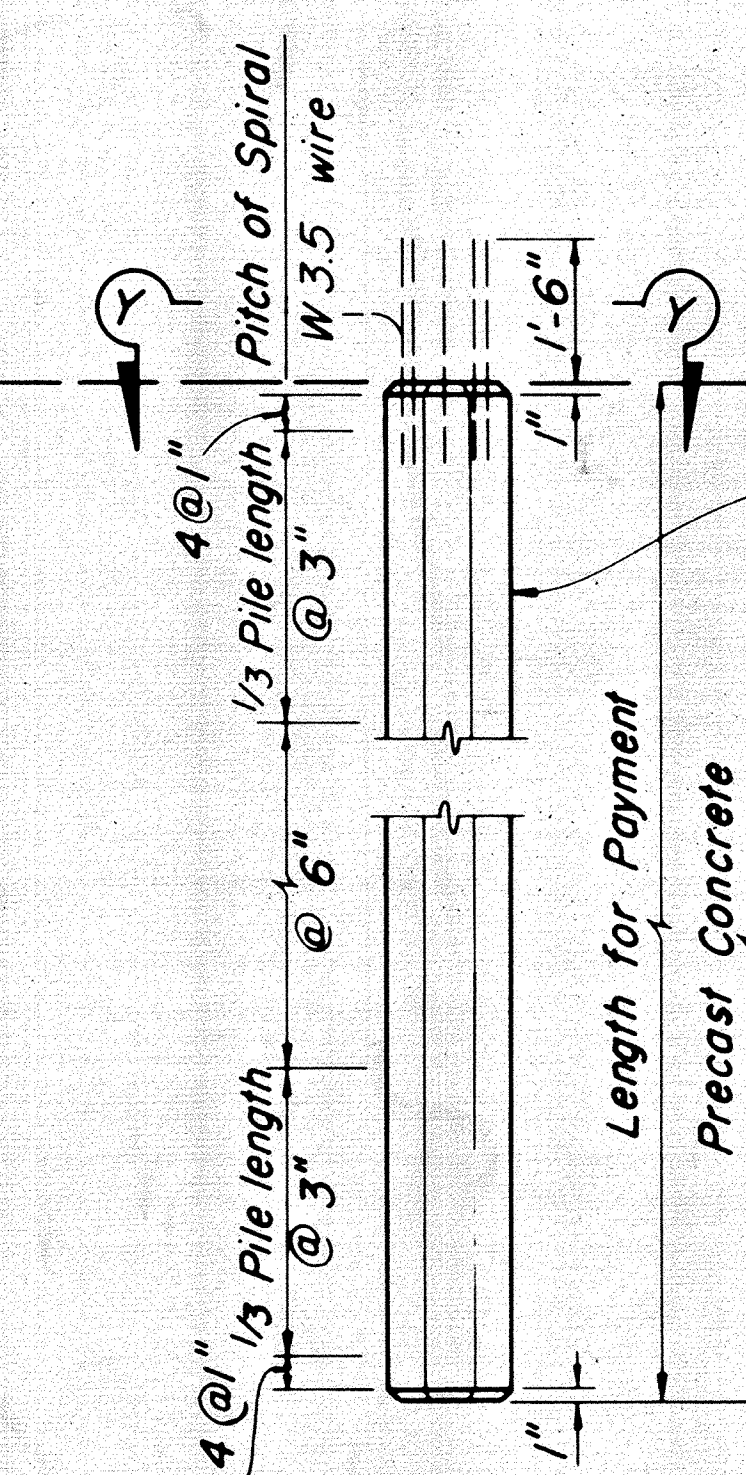


ALTERNATIVE "Y"

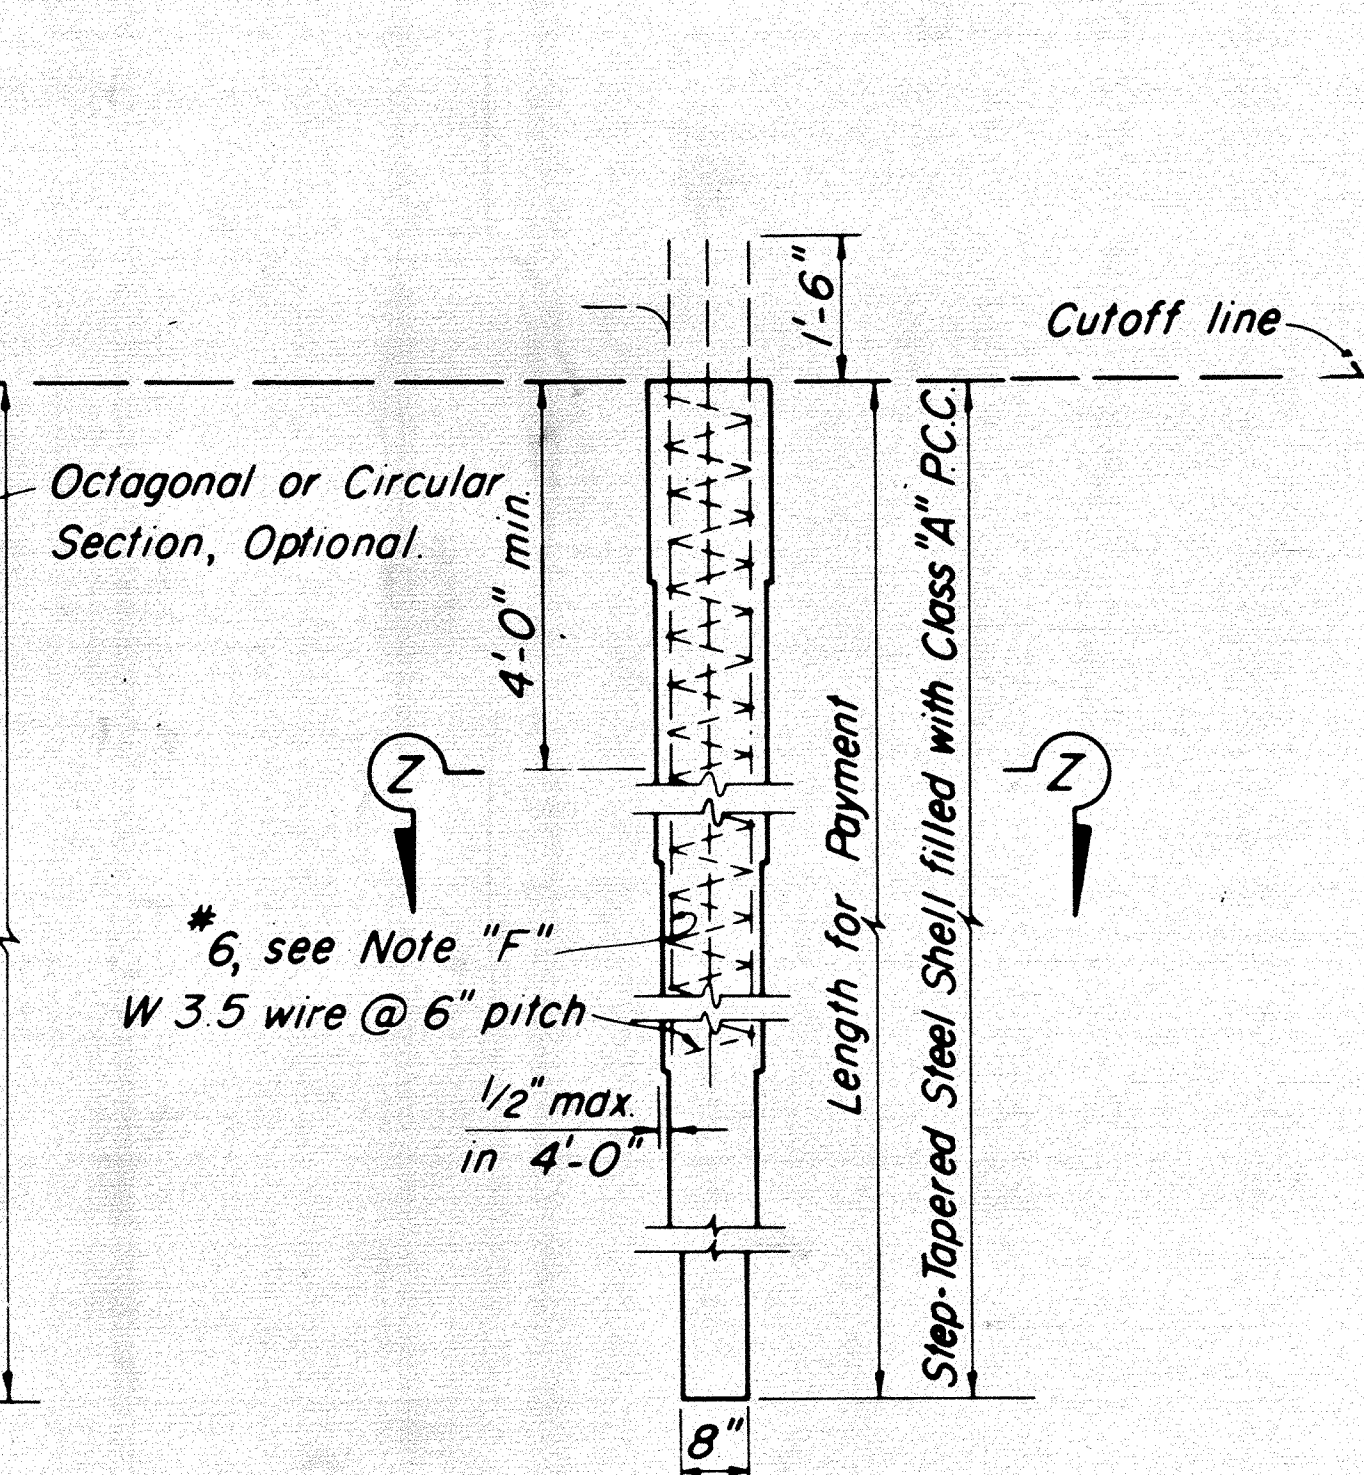


ALTERNATIVE "Z"

CORRUGATED ALTERNATIVE "Z"

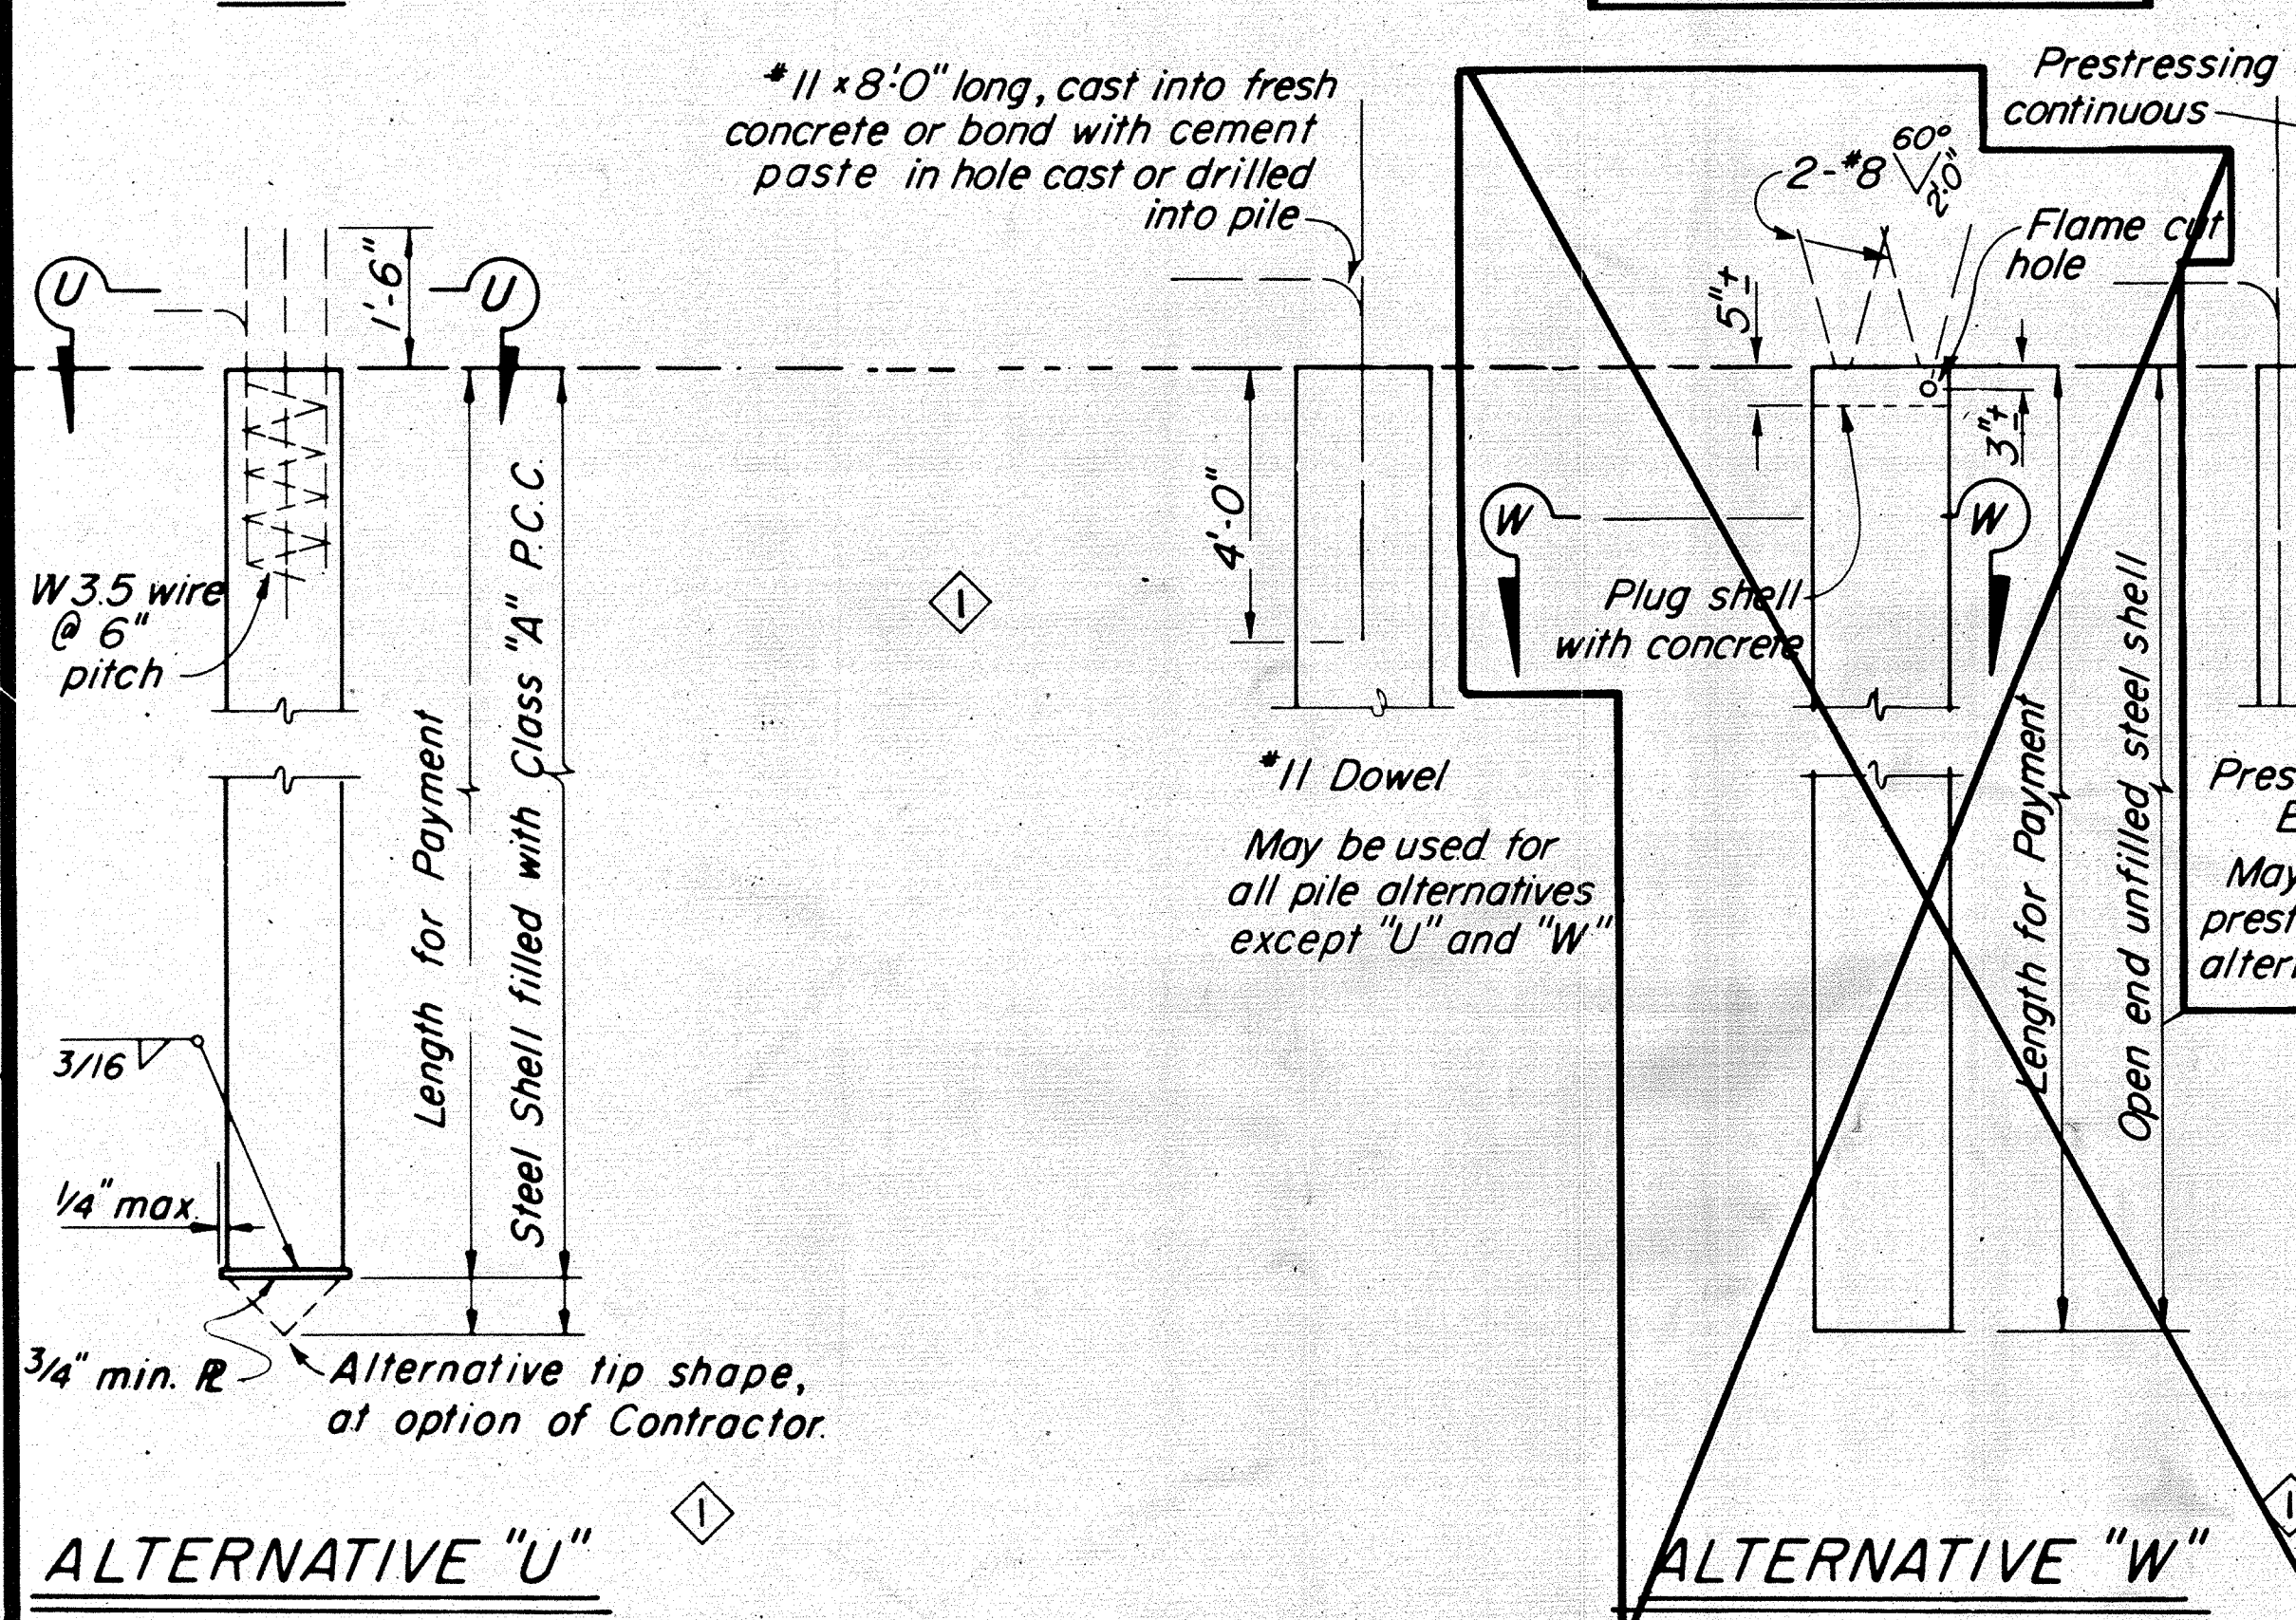

ALTERNATIVE "U"

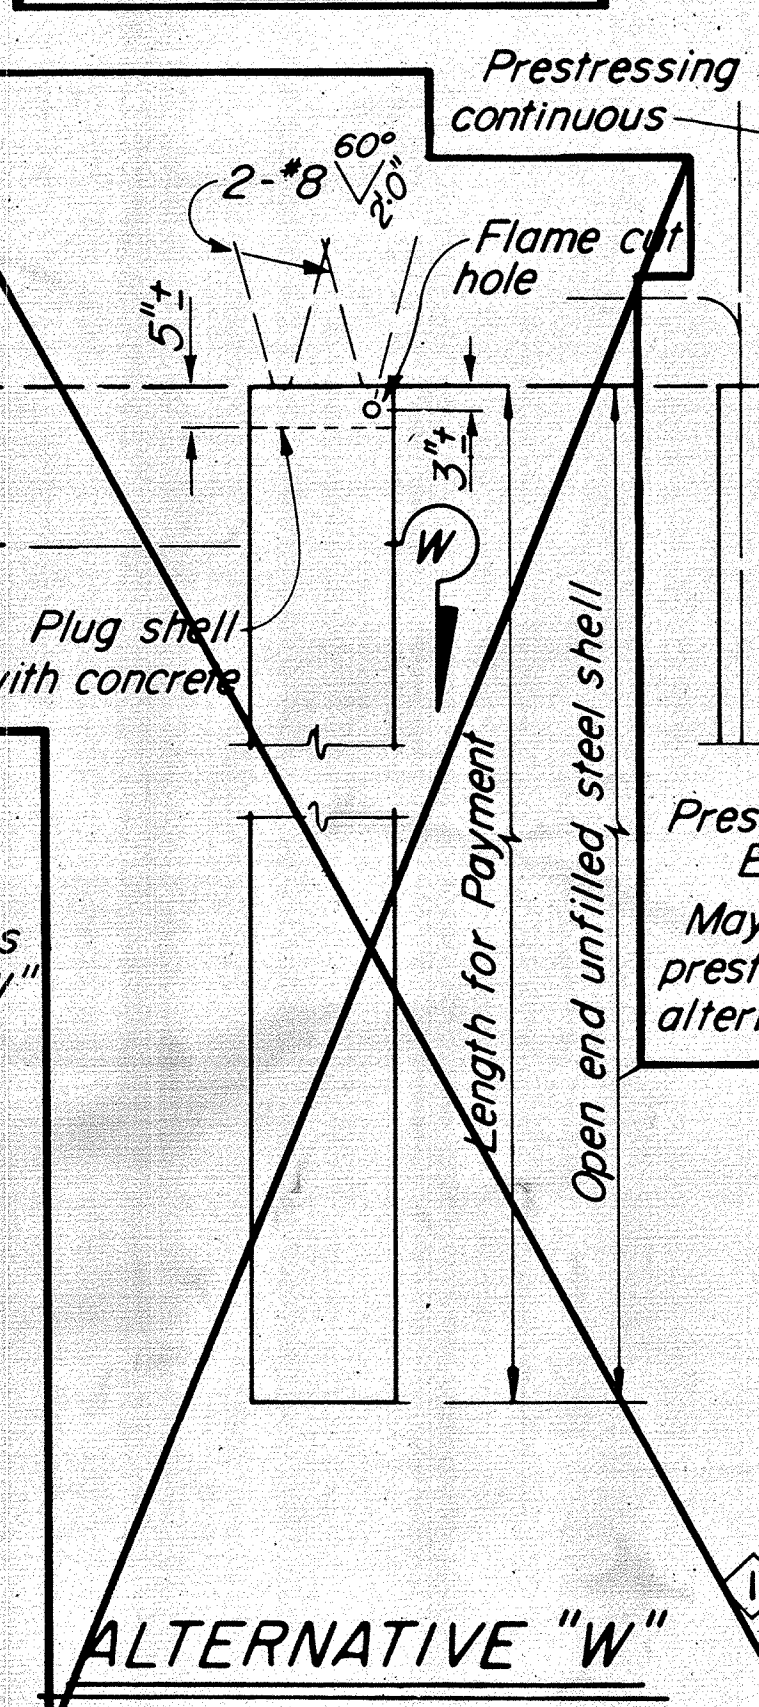

ALTERNATIVE "W"

NOTE F: In Alternative "Z" the No. 6 bars shall extend to:
1. Bottom of pile for bridges over water courses.
2. 12'-0" below the lowest of the following for bridges not over water course.

- Bottom of footing
- Top of final ground surface.
- Top of original ground surface when holes are drilled through embankment constructed by Contractor.
- Bottom of pre-drilled holes greater than pile diameter.

NOTES: Class 45-1 piles may be substituted for Class 45-2.
A 10" minimum diameter pipe extension (thickness = 0.1793" min.) may be used at the tip of Alternative "Z" when taper is 30' or more in length.

All dowels or bars extending into pier footing shall be hooked.

NOTES: (Cont.)

Cement for concrete piling shall be Type IV
Alternative "W" piles shall not be considered applicable to the project.

PRECAST PRESTRESSED PILES:

If section used is larger than the min. section shown, then "P" shall provide 700 psi min.
Concrete Strength: f'_c @ 28 days = 6,000 p.s.i. (Alternative "X")
4,500 p.s.i. (Alternative "Y")

DESIGN LOADING = 45 TONS

ORANGE COUNTY ROAD DEPARTMENT	
MICHELSON DRIVE BRIDGE (SD-25)	
ACROSS SAN JOAQUIN CHANNEL	
PILE DETAILS	
SCALE None	SHEET BR2-4 OF 7