




B-1 6-19-68.

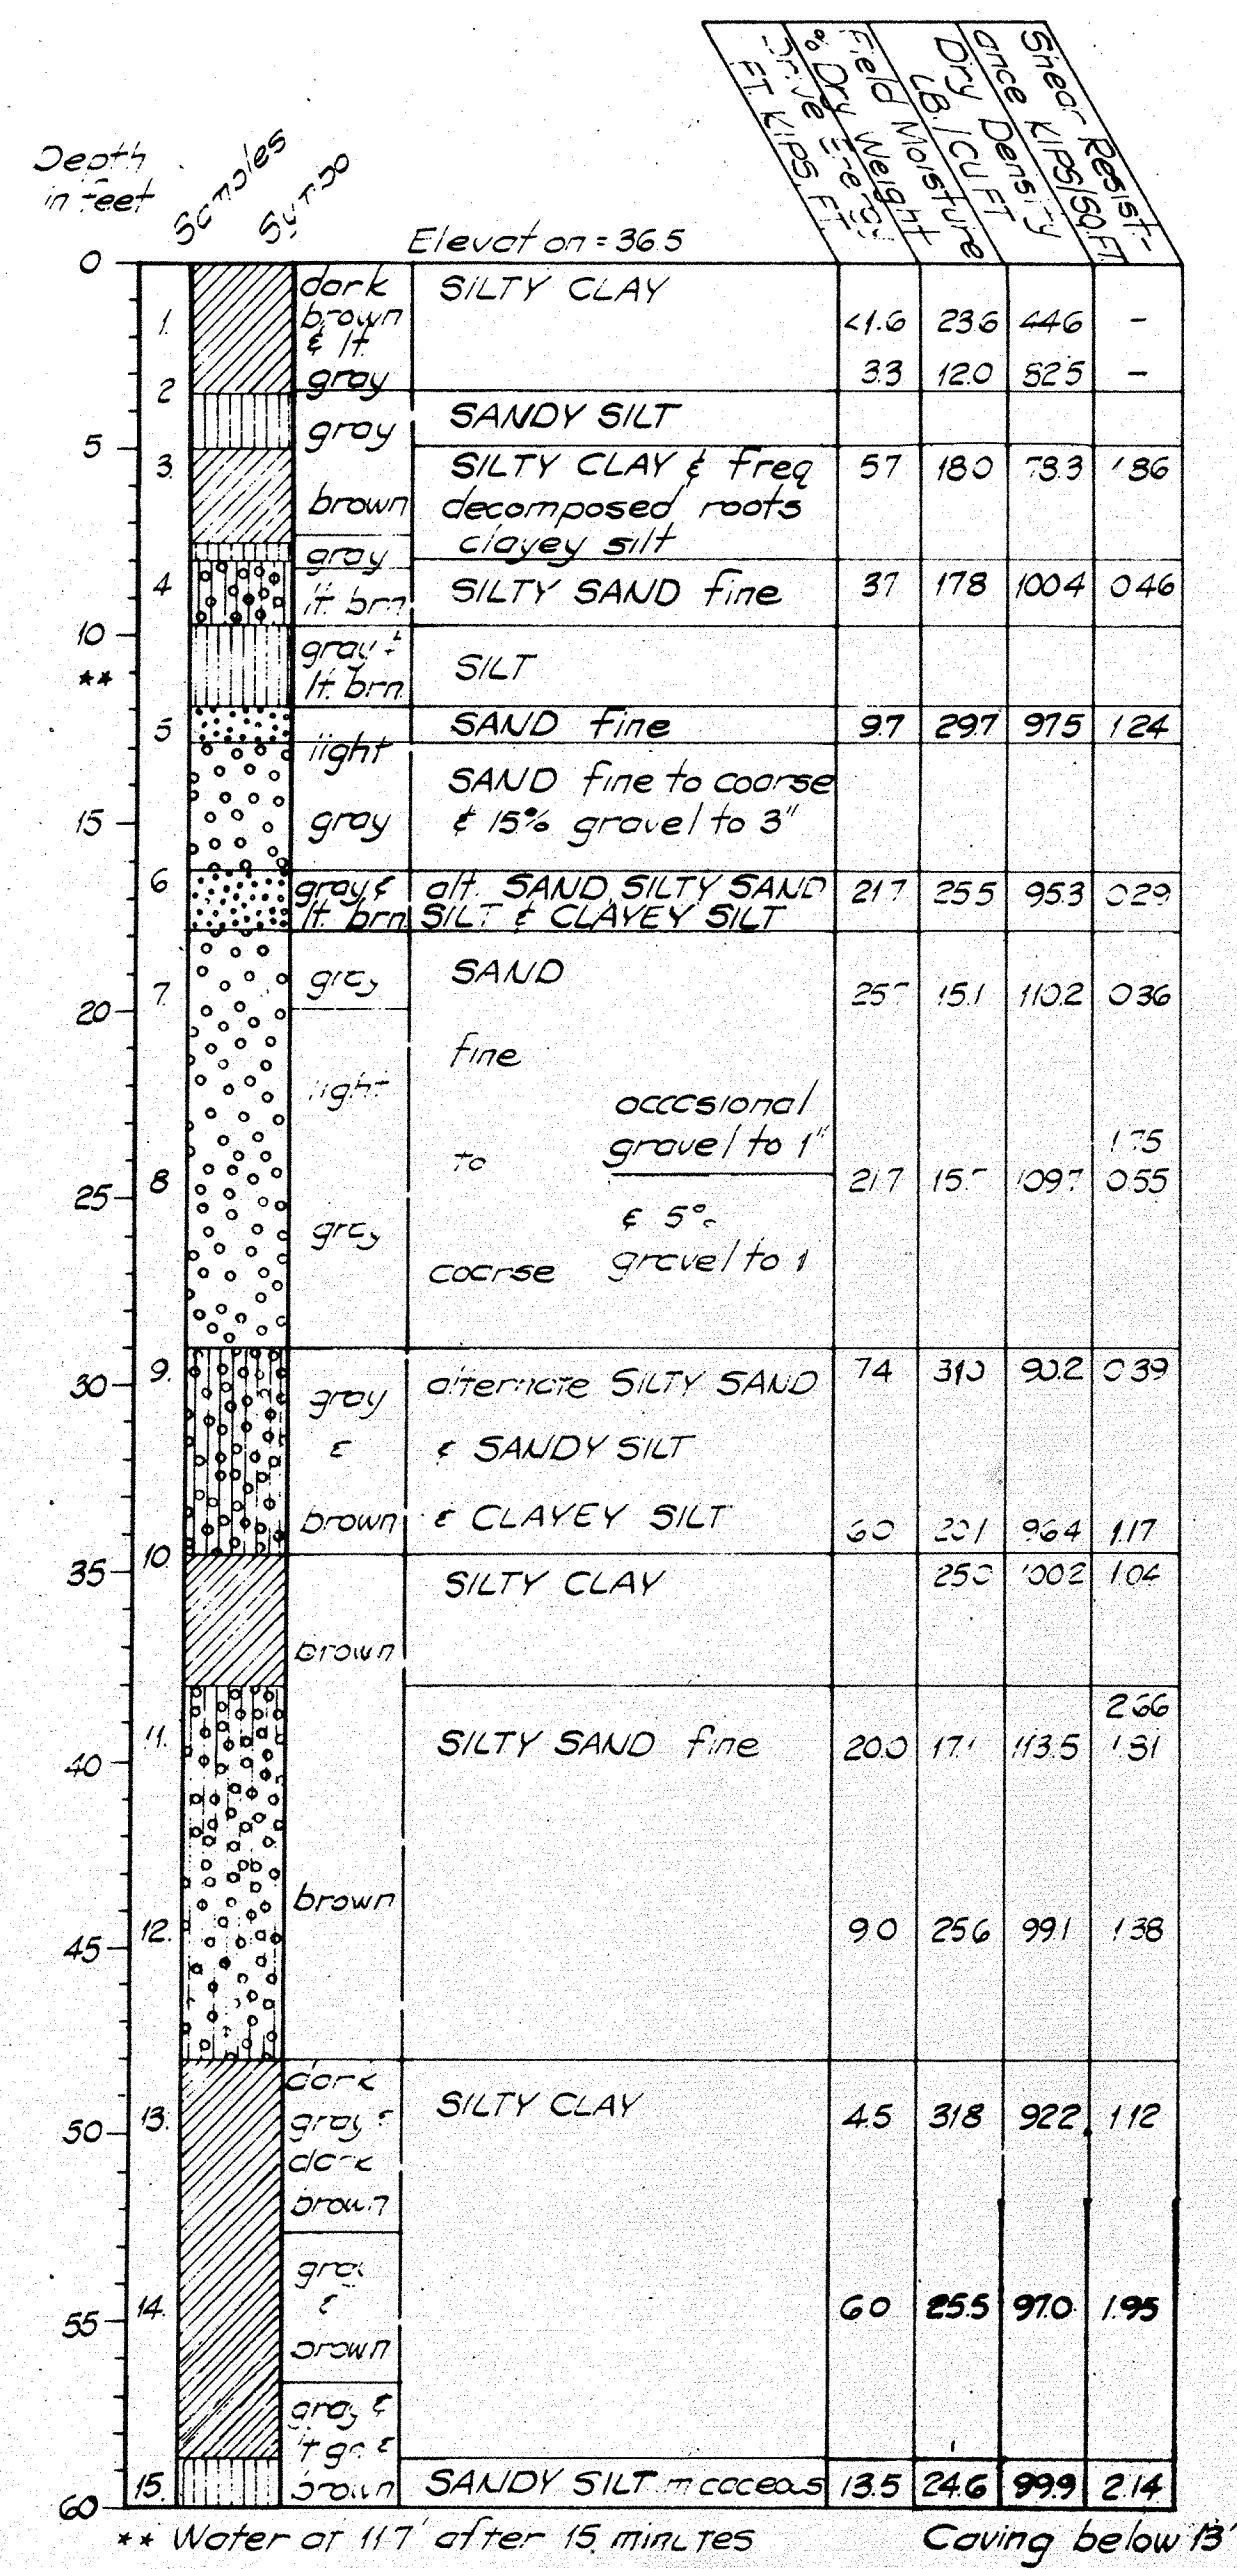

B-2 6-19, 20-68

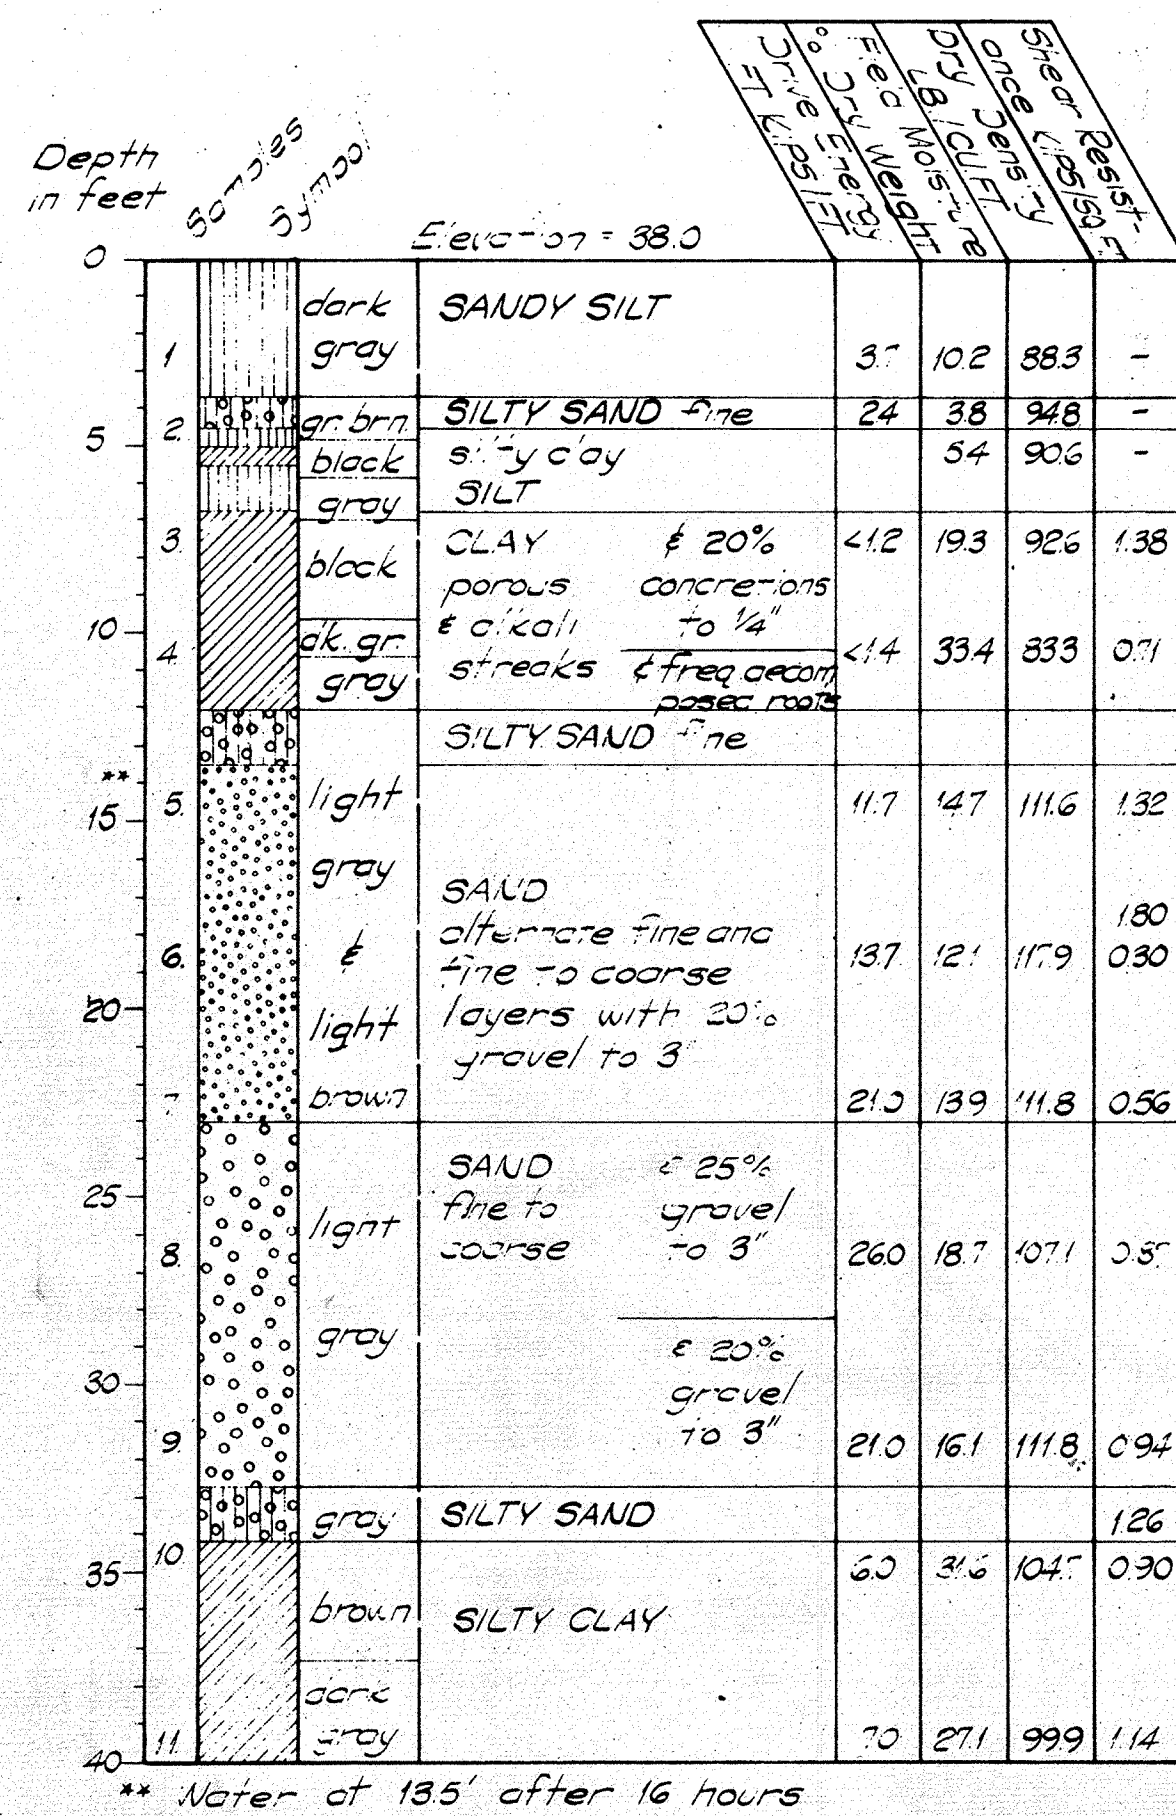

P-1 8-25-75

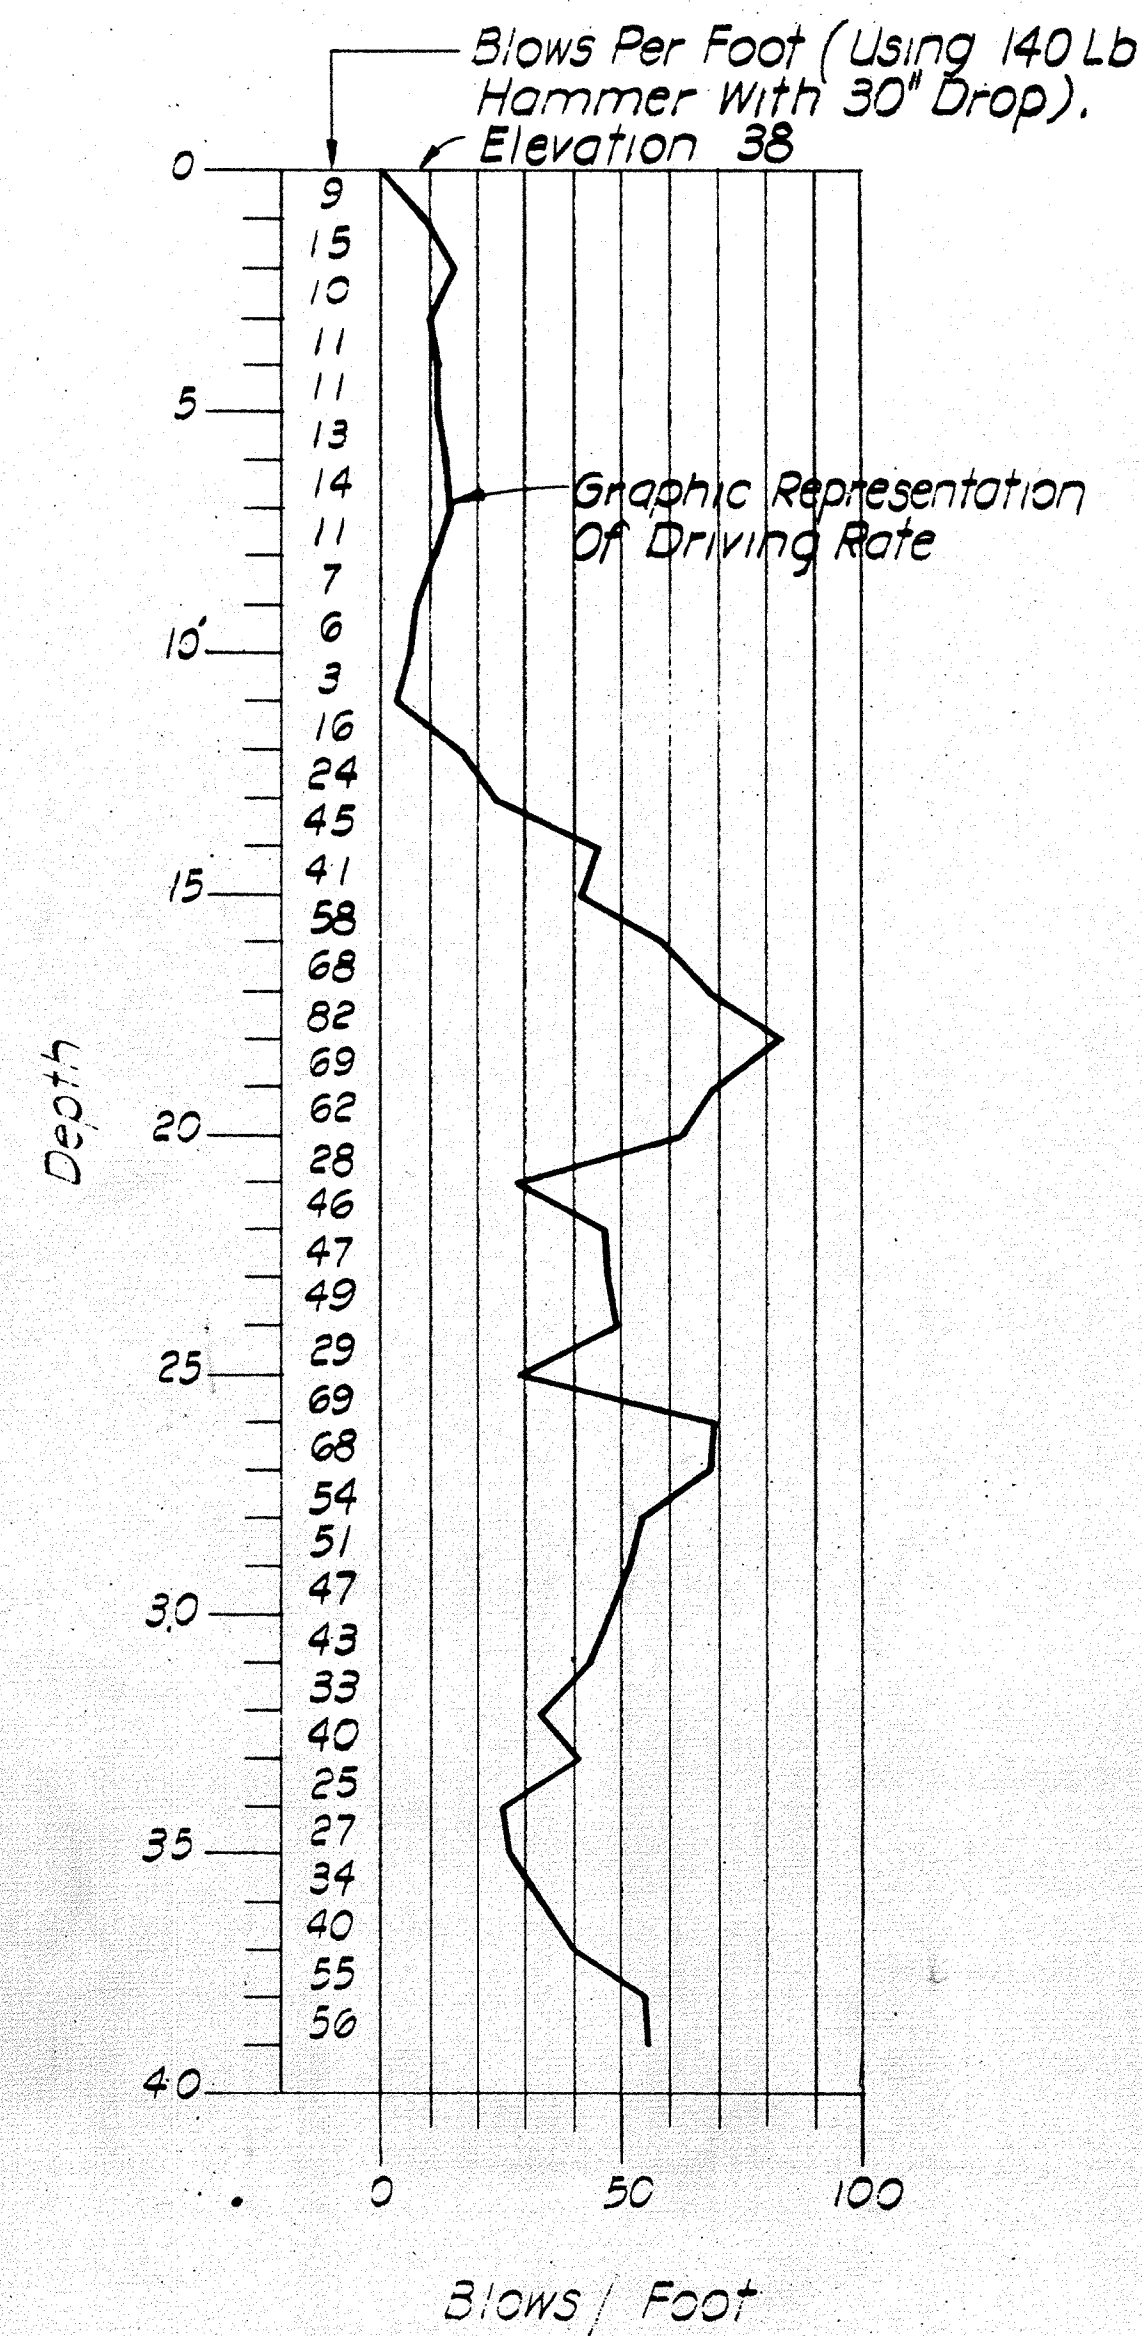

P-2 8-25-75

