

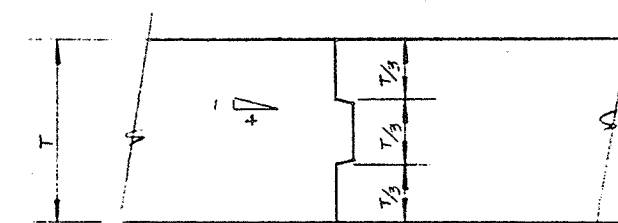
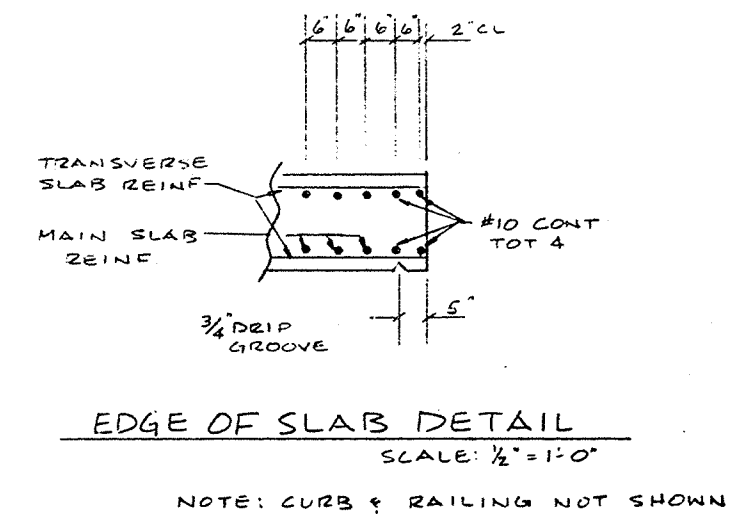
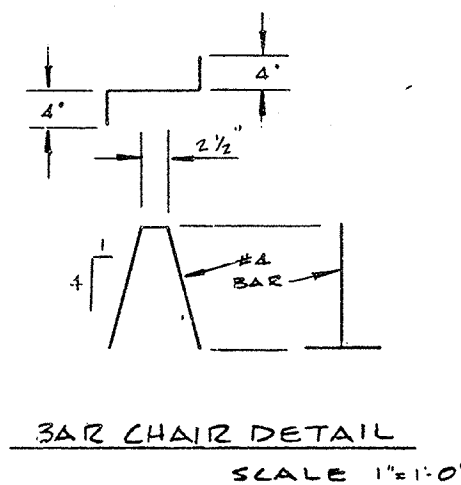
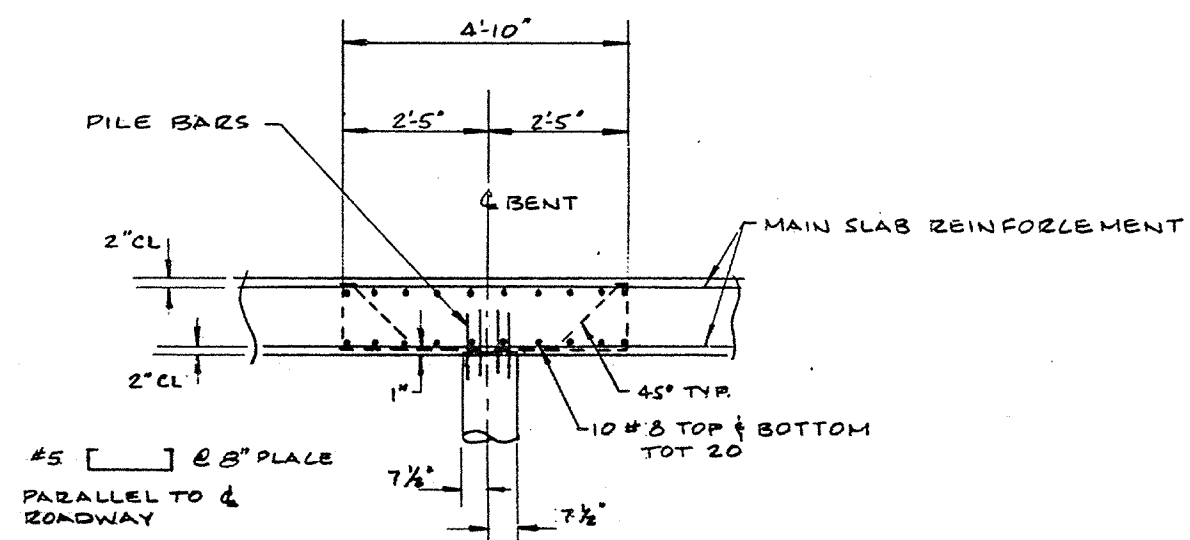
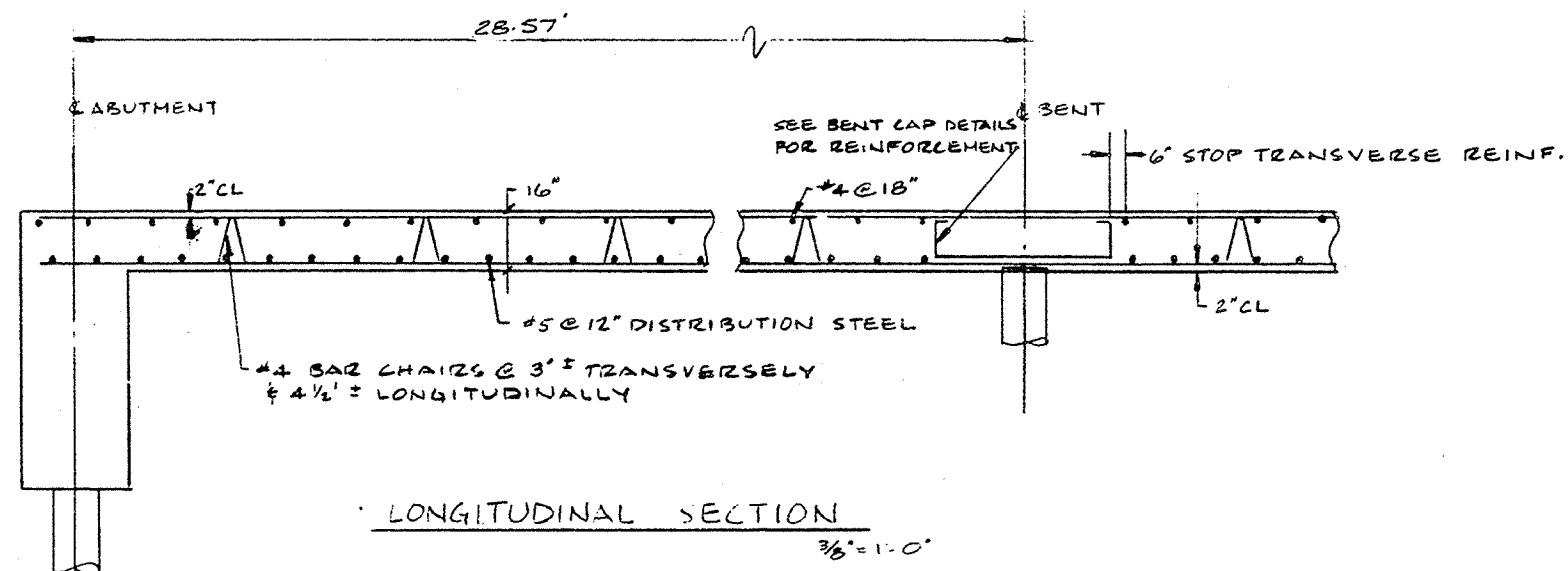


NOTE:
SEE SHEET 1 FOR
STATIONS

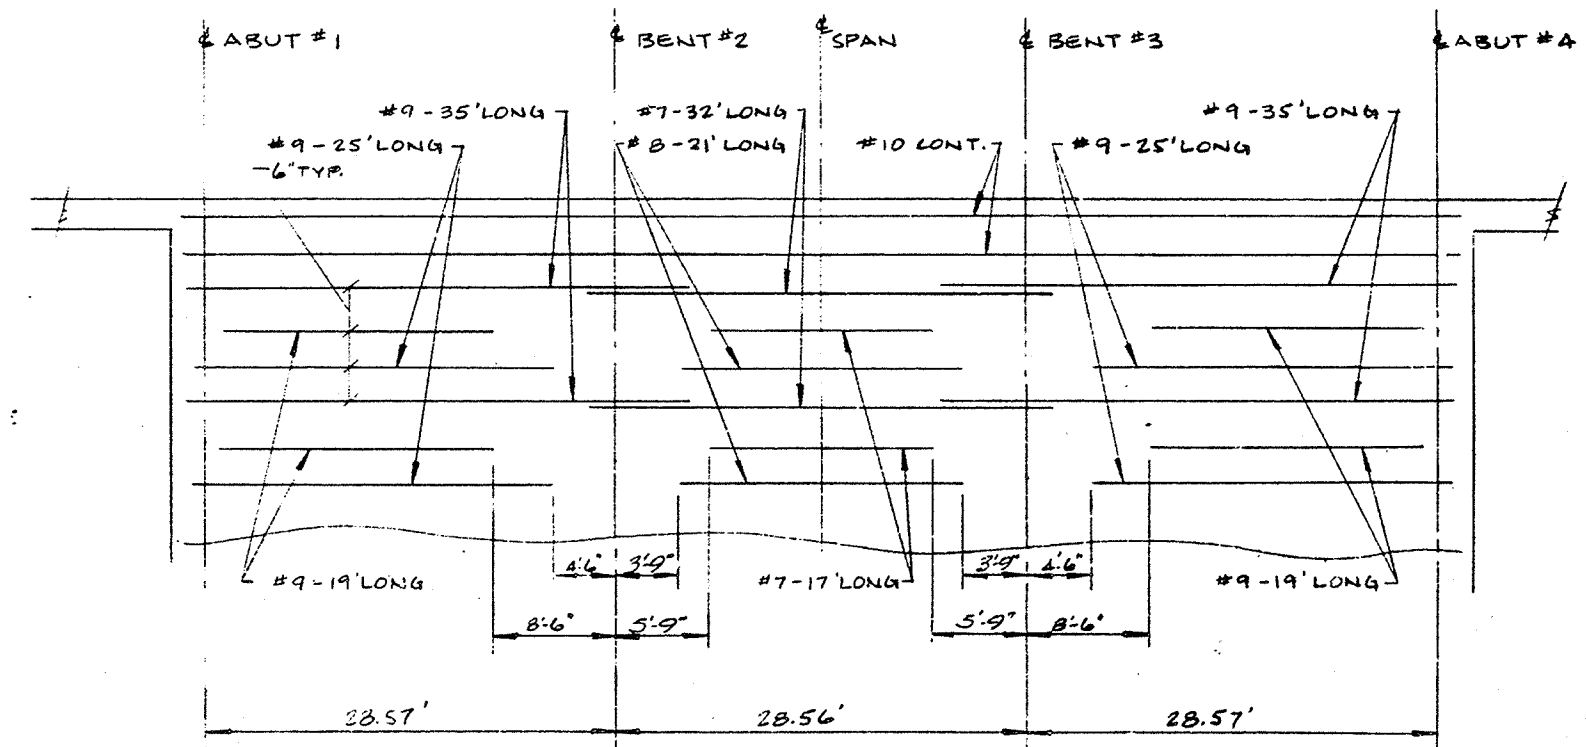

NOTE: TRANSVERSE JOINTS,
IF USED, TO BE LOCATED AT
1/4 POINTS OF SPAN AND
LONGITUDINAL JOINT TO BE
LOCATED AT EDGE OF TRAFFIC
LANES UNLESS OTHERWISE
PERMITTED BY THE ENGINEER.

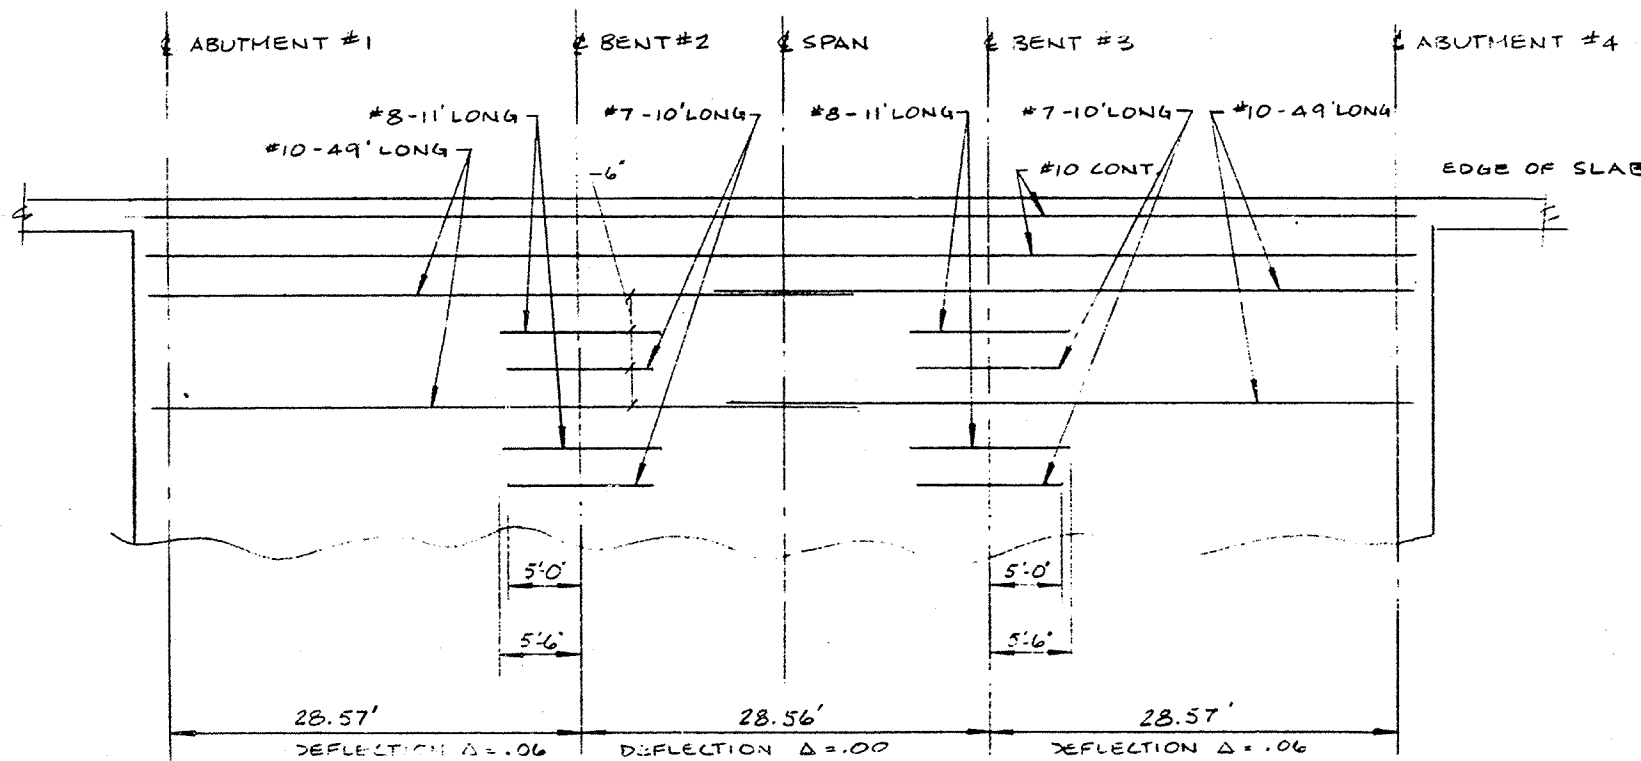

Dr. 7 13150
Street Improvements
Sheet 11 of 13
Red 24:1
Cronaflex

CANADA CHANNEL BRIDGE	
SLAB REINFORCEMENT & DETAILS	

SHEET 11/13

DR. 7.13150