

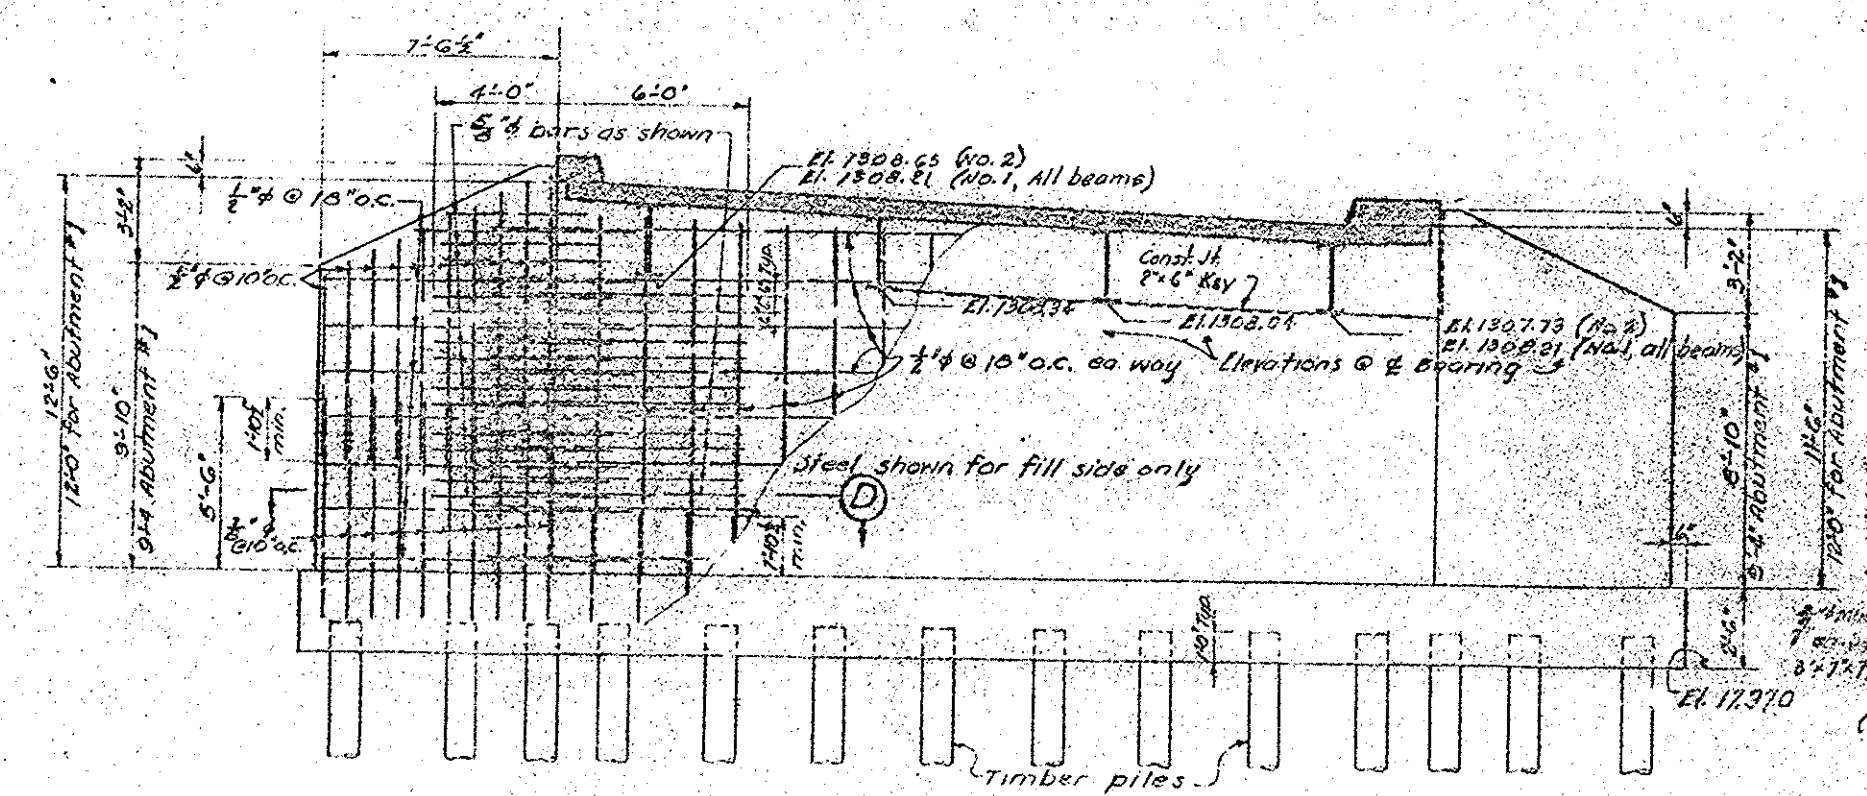
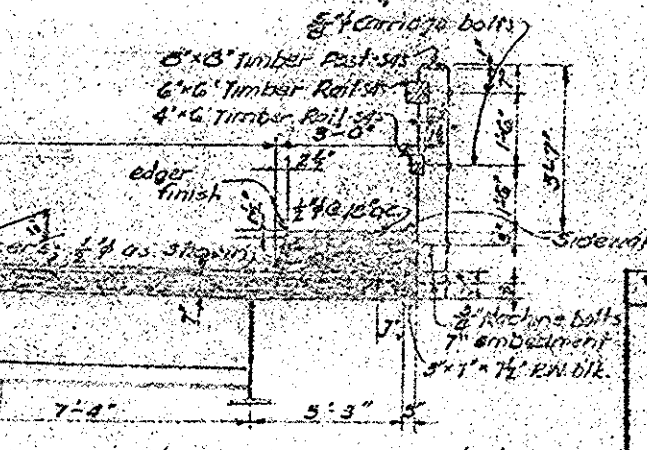
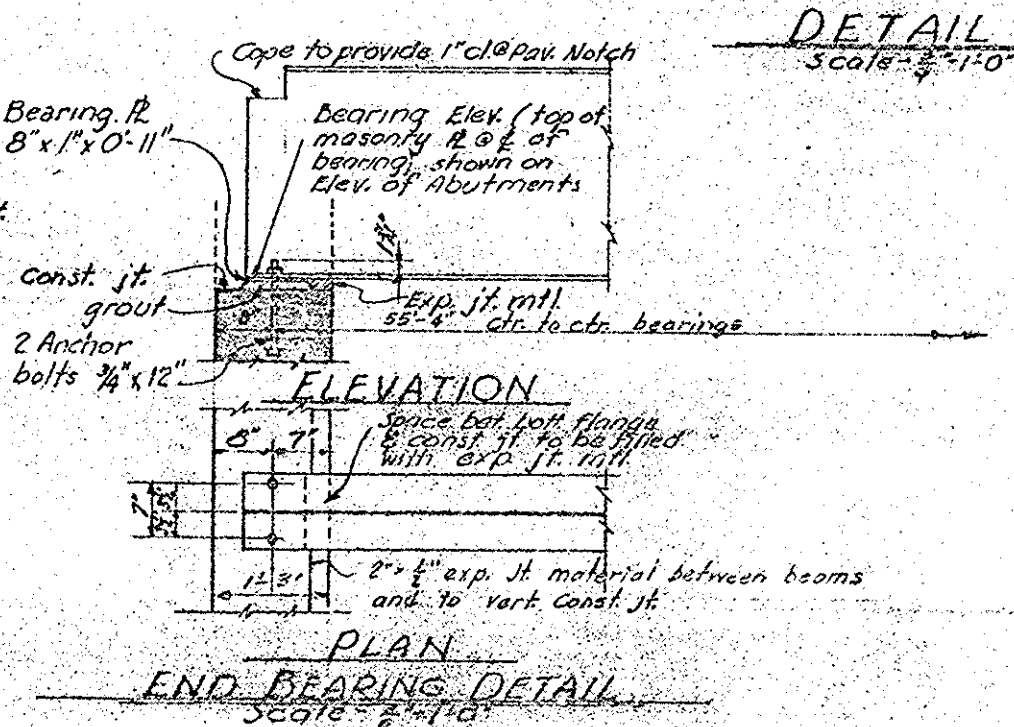
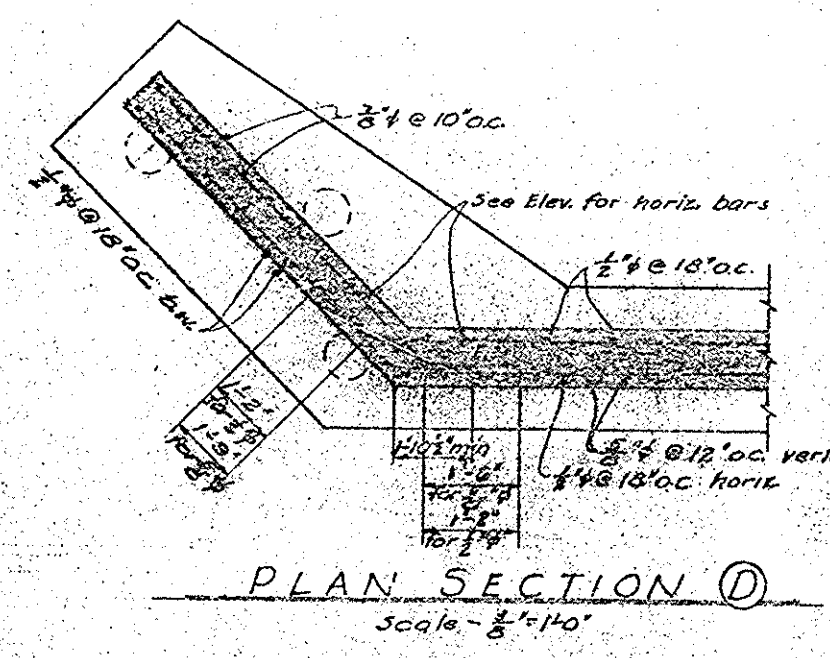
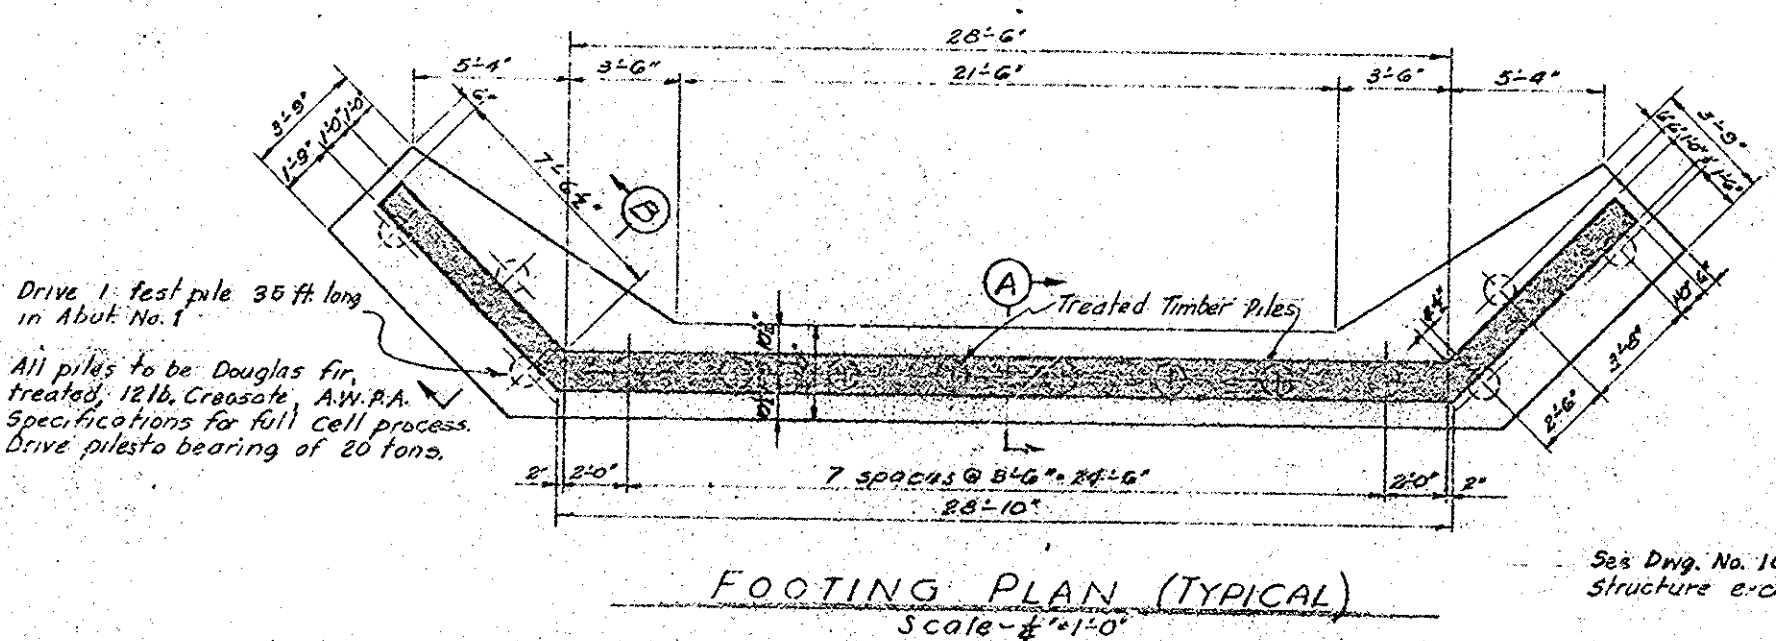
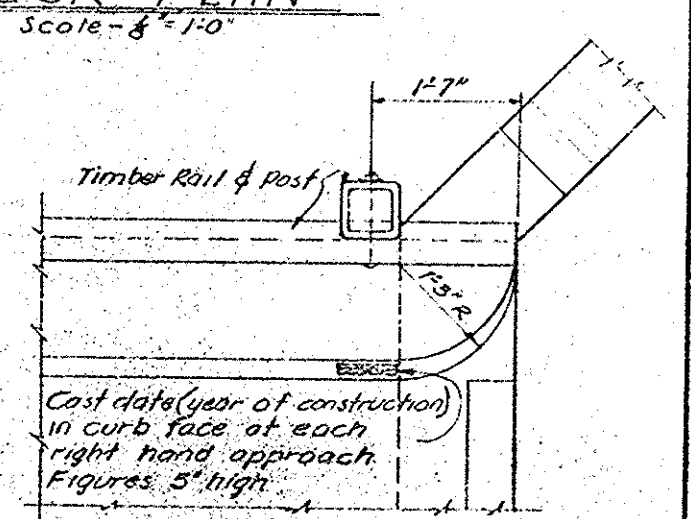
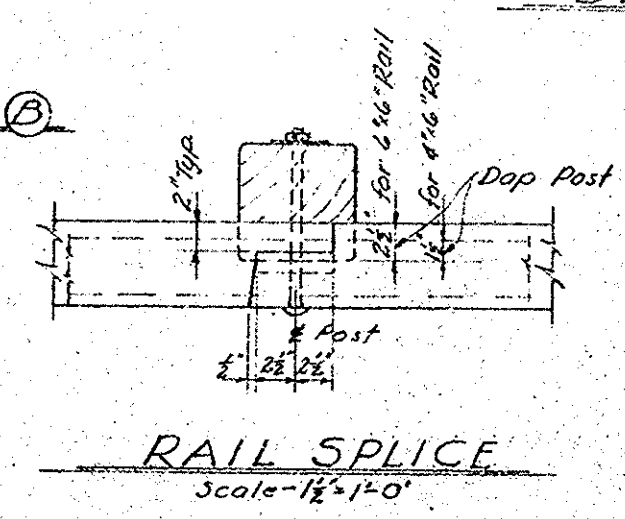
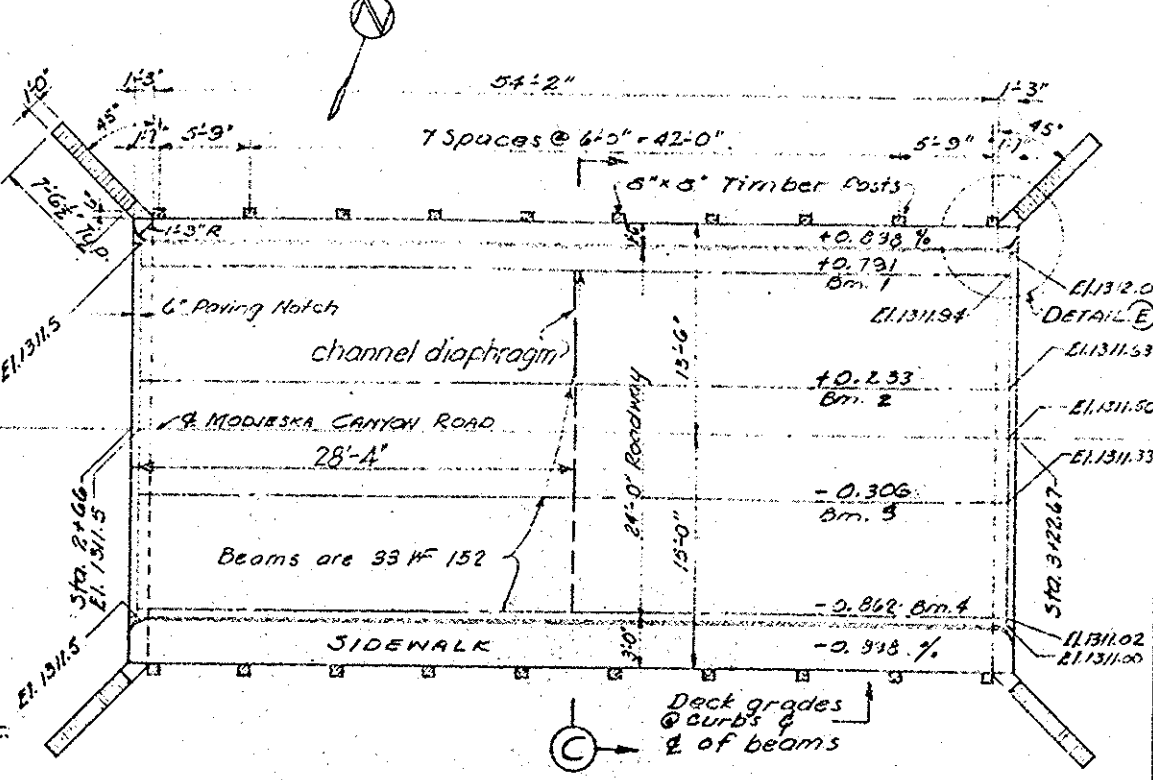
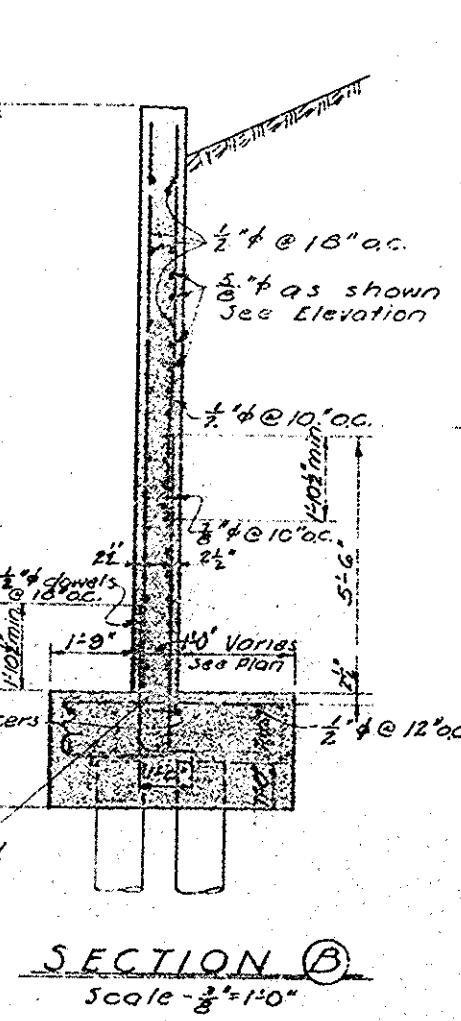
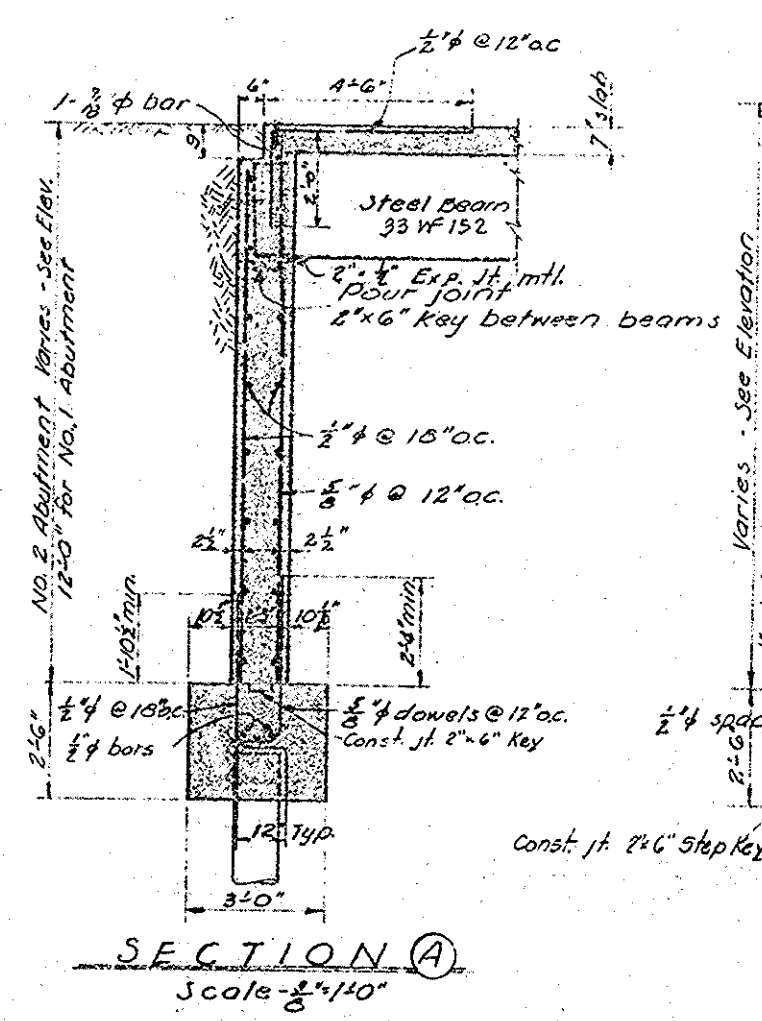


Note: Approach fills not to be placed against abutments until after steel stringers have been erected.

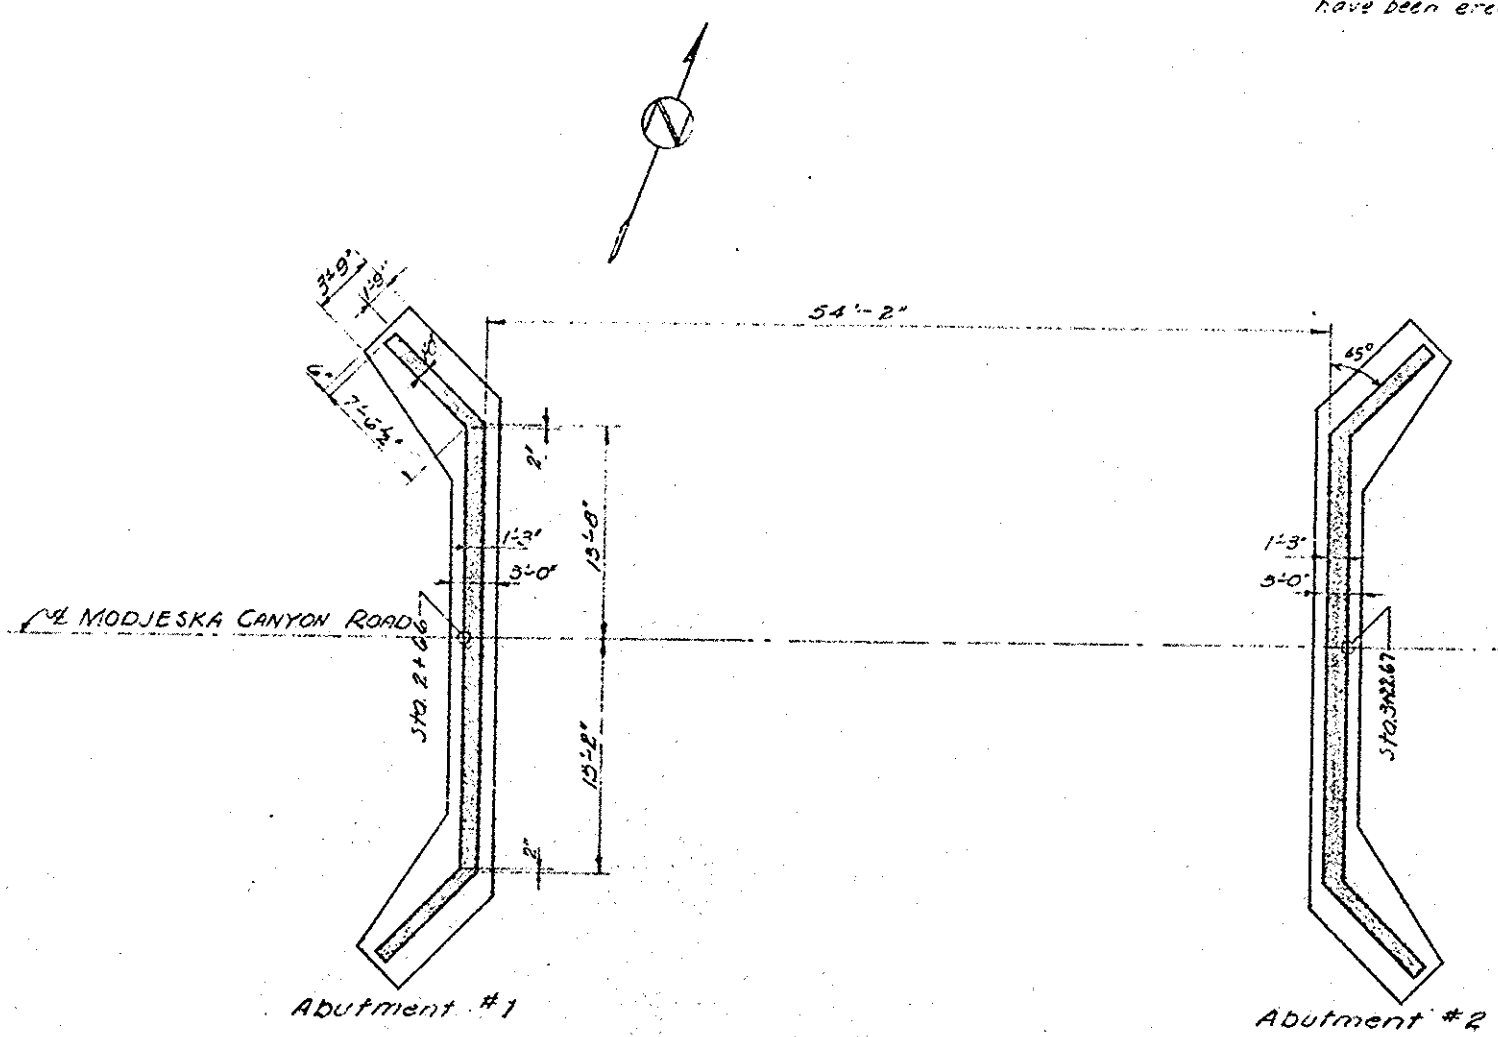

Note: Posts & Rails to be select all heart structural redwood

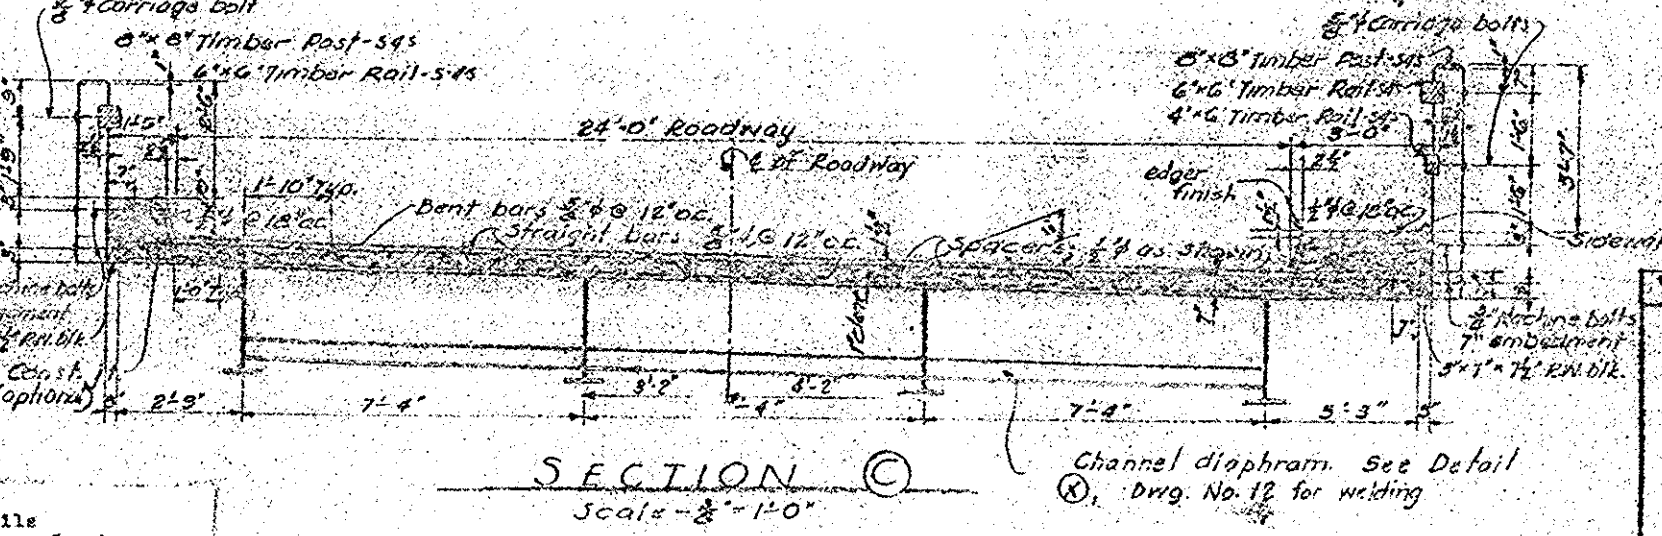

APPROVED: A.A. BEARD
SUPERINTENDENT OF HIGHWAYS
DATE: 8-8-46
By: H. Spranger, Actg. Supt.

REV.	DATE	REVISION	BY	APP'D
1	8-8-46	As shown	DAVID R. WARREN CO.	LA 46-17
2	8-8-46	As shown	DAVID R. WARREN CO.	LA 46-17
3	8-8-46	As shown	DAVID R. WARREN CO.	LA 46-17
4	8-8-46	As shown	DAVID R. WARREN CO.	LA 46-17
5	8-8-46	As shown	DAVID R. WARREN CO.	LA 46-17

ORANGE COUNTY, CALIFORNIA
BRIDGES ACROSS SILVERADO, LADD,
& SANTIAGO CREEKS
PLANS & DETAILS
SANTIAGO CREEK (SC5)

DAVID R. WARREN CO.
LOS ANGELES
SAN FRANCISCO
5

Bridge 30-5
Plans & Details
Across Santiago Creek
Sheet 6 of 13
Scale as noted
Vellum-Pencil Sketch

MICROFILMED
JUL 6 1960