
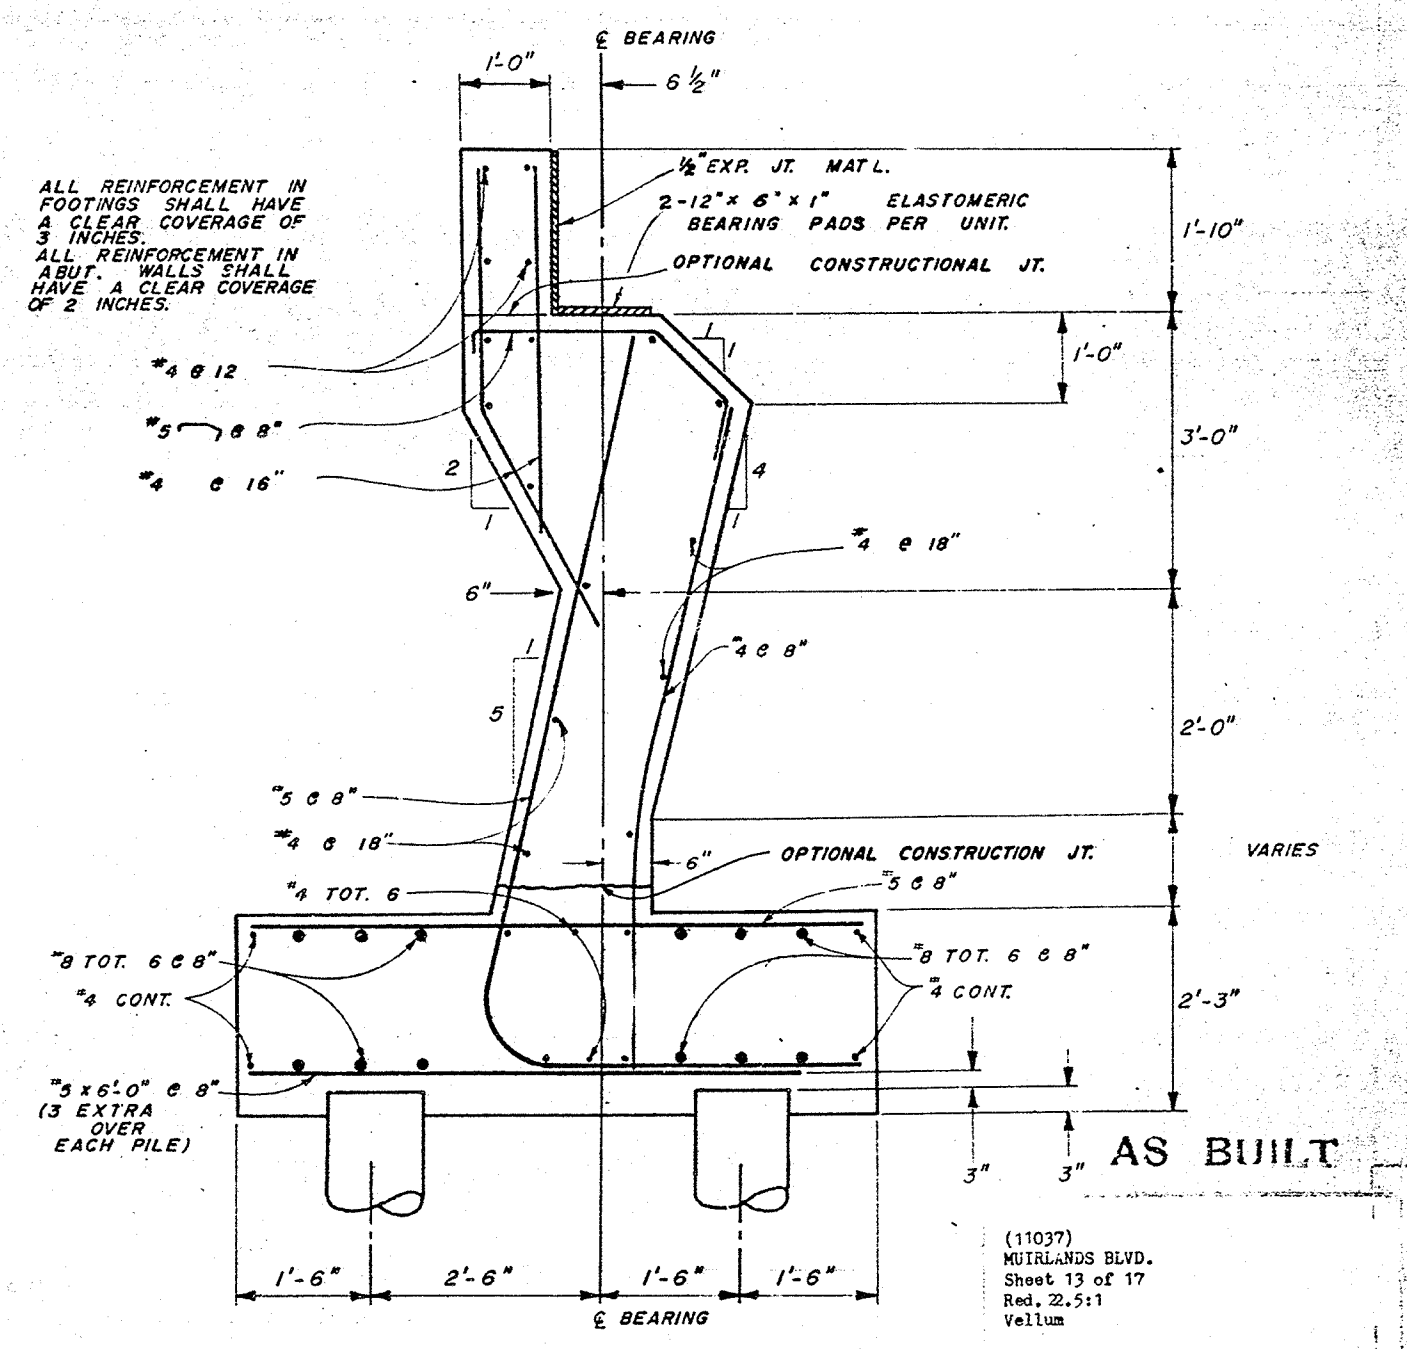
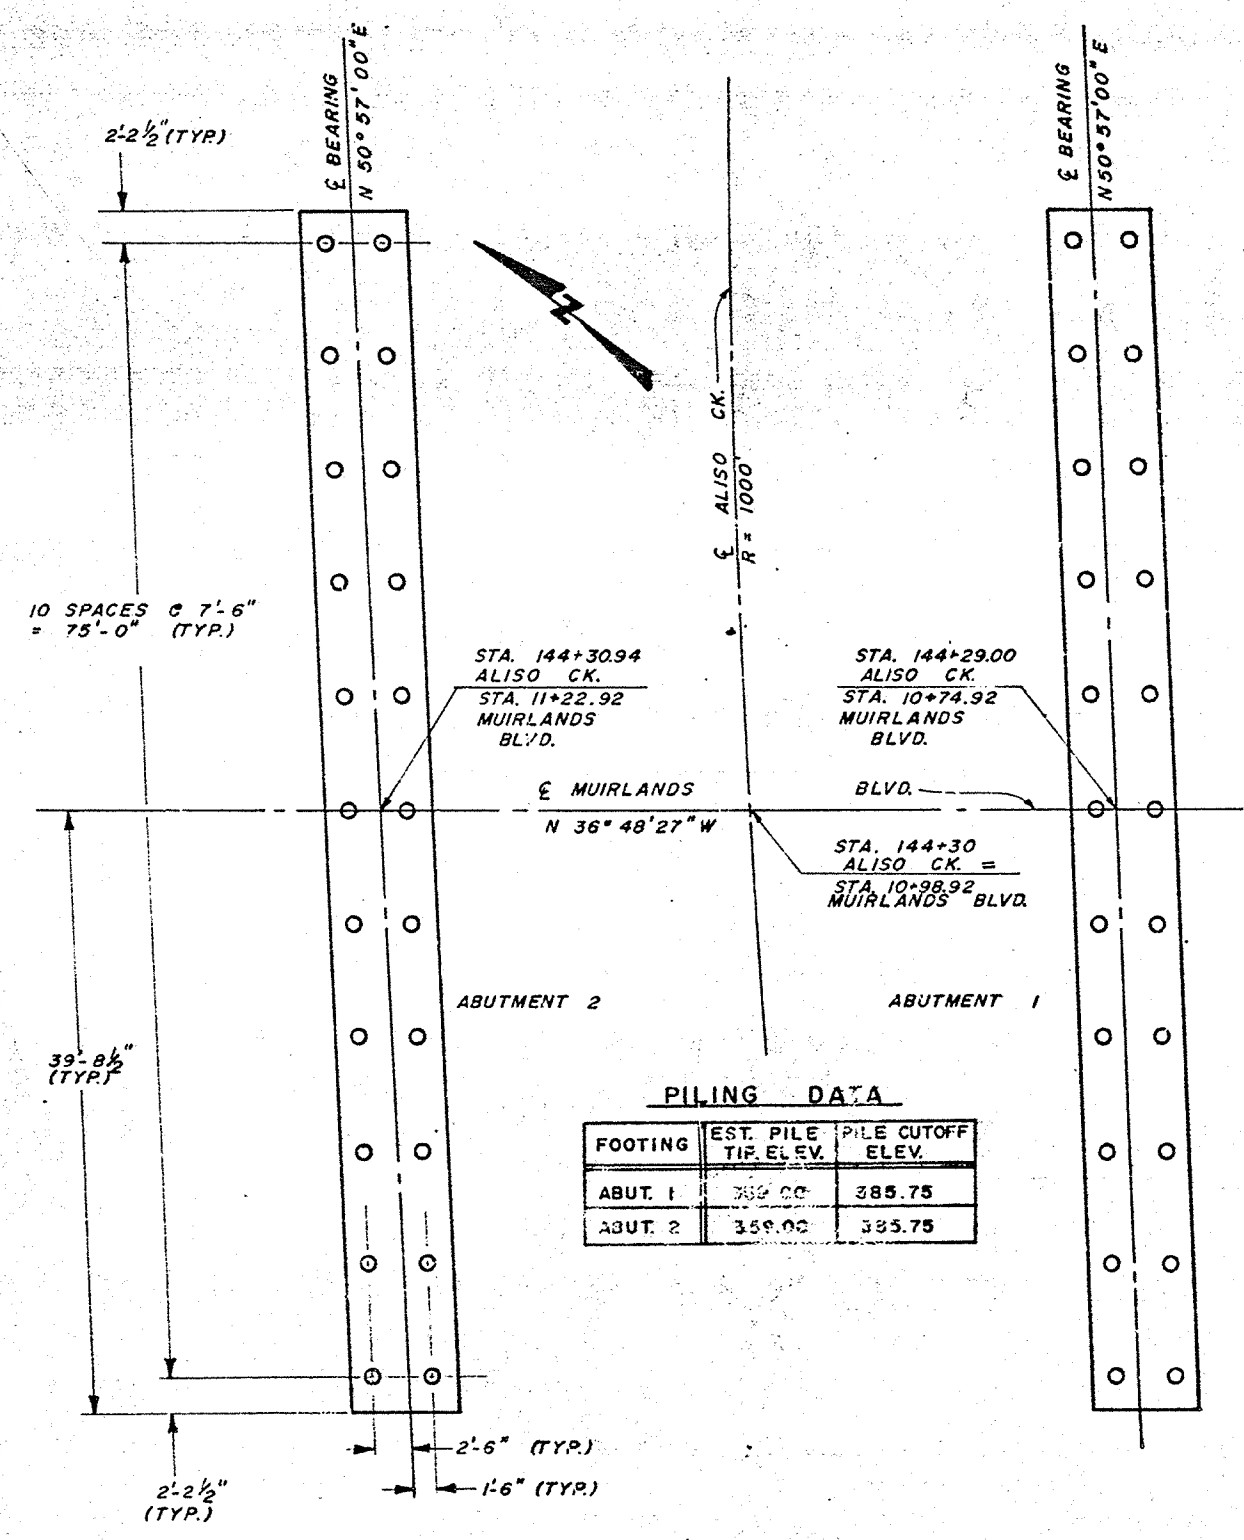
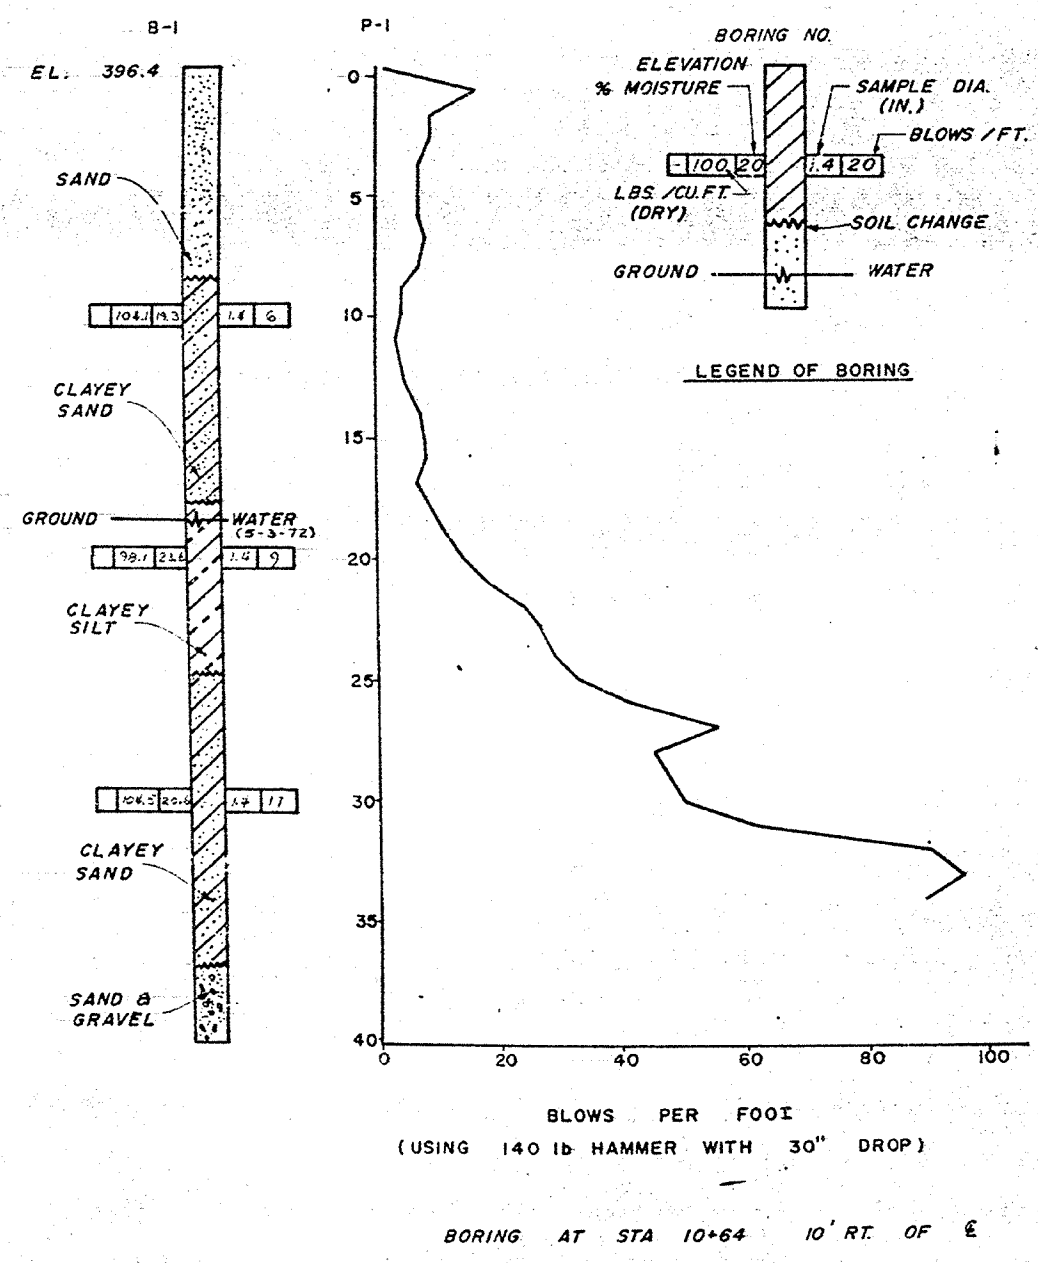


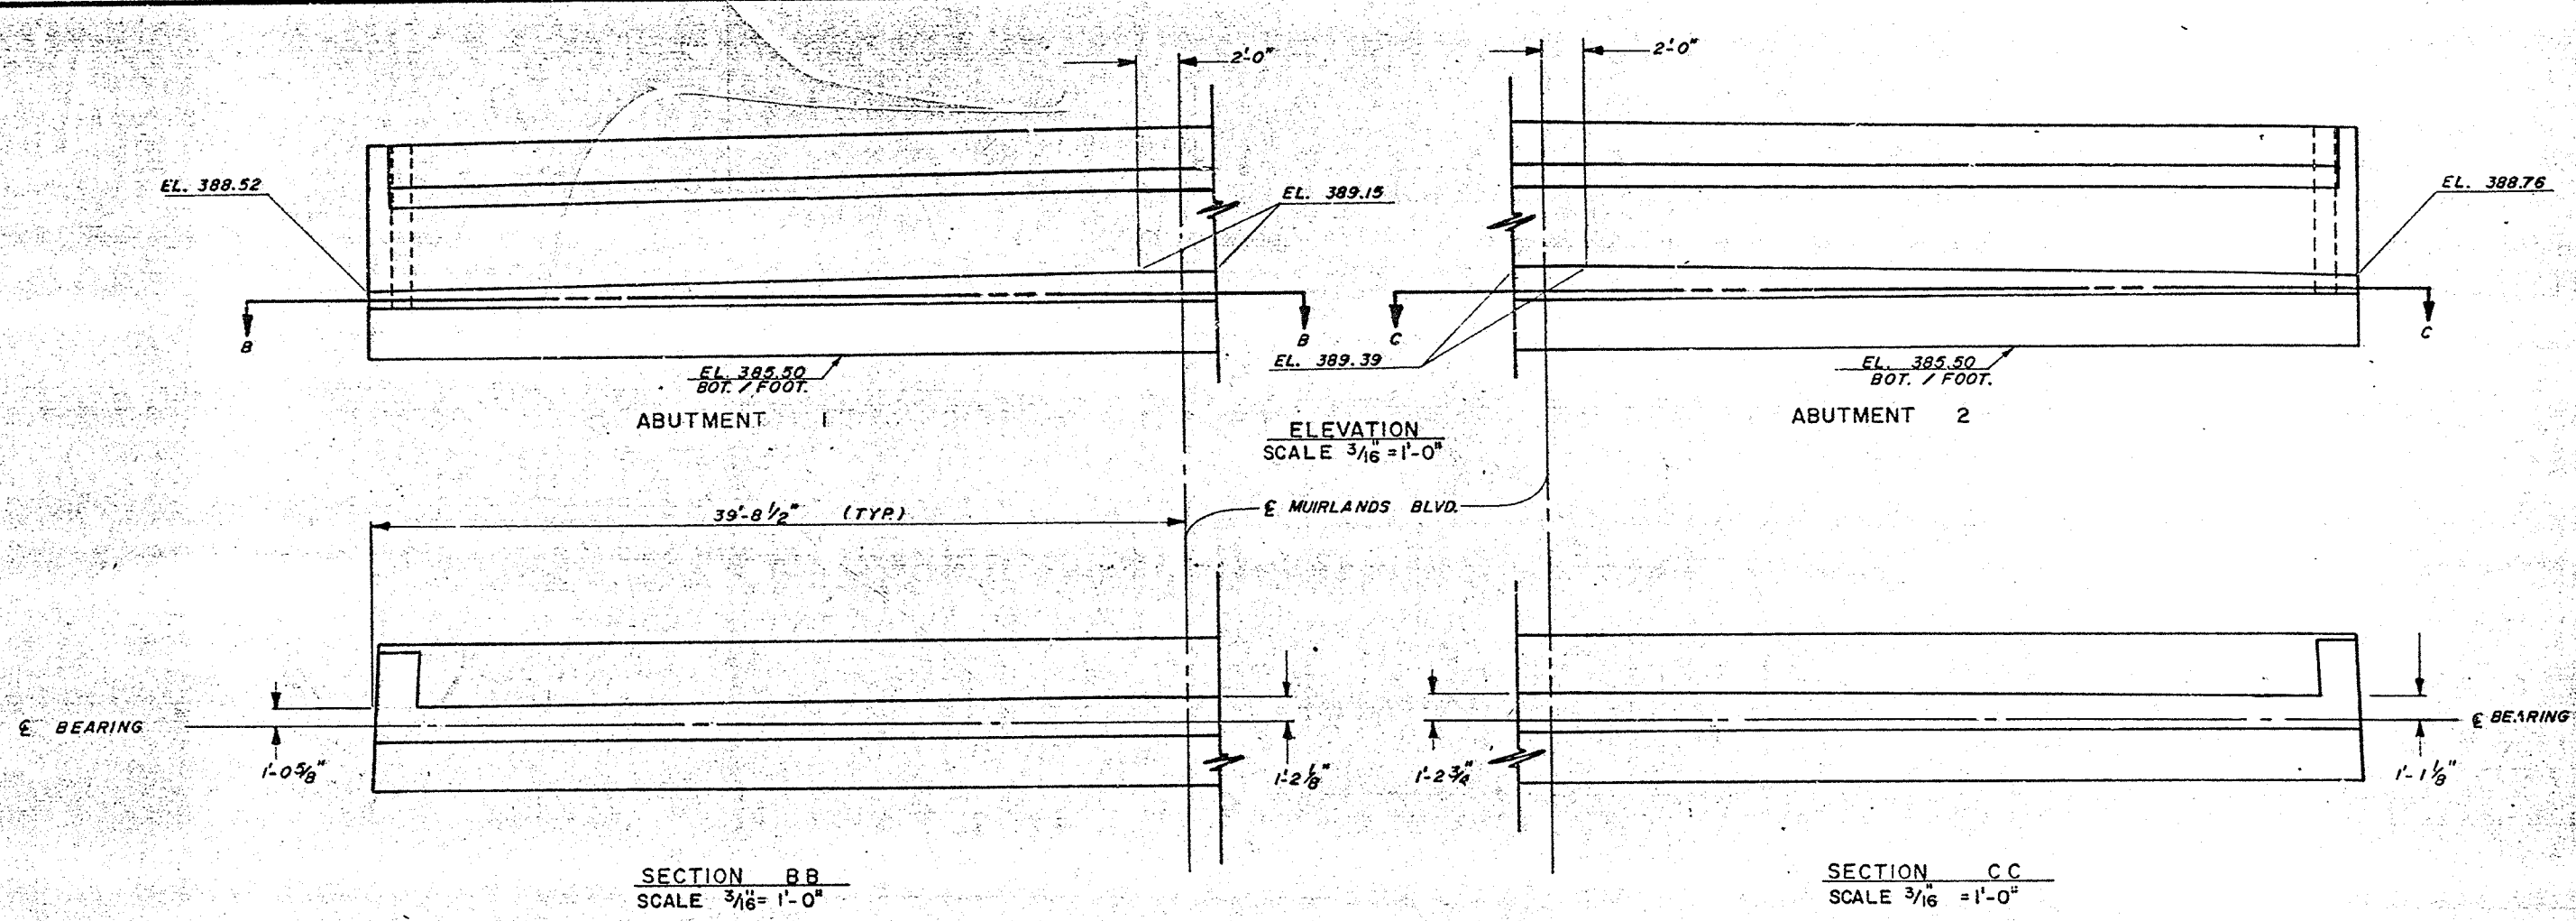

PILING DATA		
FOOTING	EST. PILE TIP ELEV.	PILE CUTOFF ELEV.
ABUT. 1	385.00	385.75
ABUT. 2	385.00	385.75

ORANGE COUNTY ROAD DEPARTMENT

MUIRLANDS BLVD.
BRIDGE AL-11
OVER
ALISO CREEK.

ABUTMENT & FOUNDATION
PLAN

AS NOTED

SHEET 13 OF 17

11037
MUIRLANDS BLVD.
Sheet 13 of 17
Rev. 2.5.1
Vellum

14 (11037)