
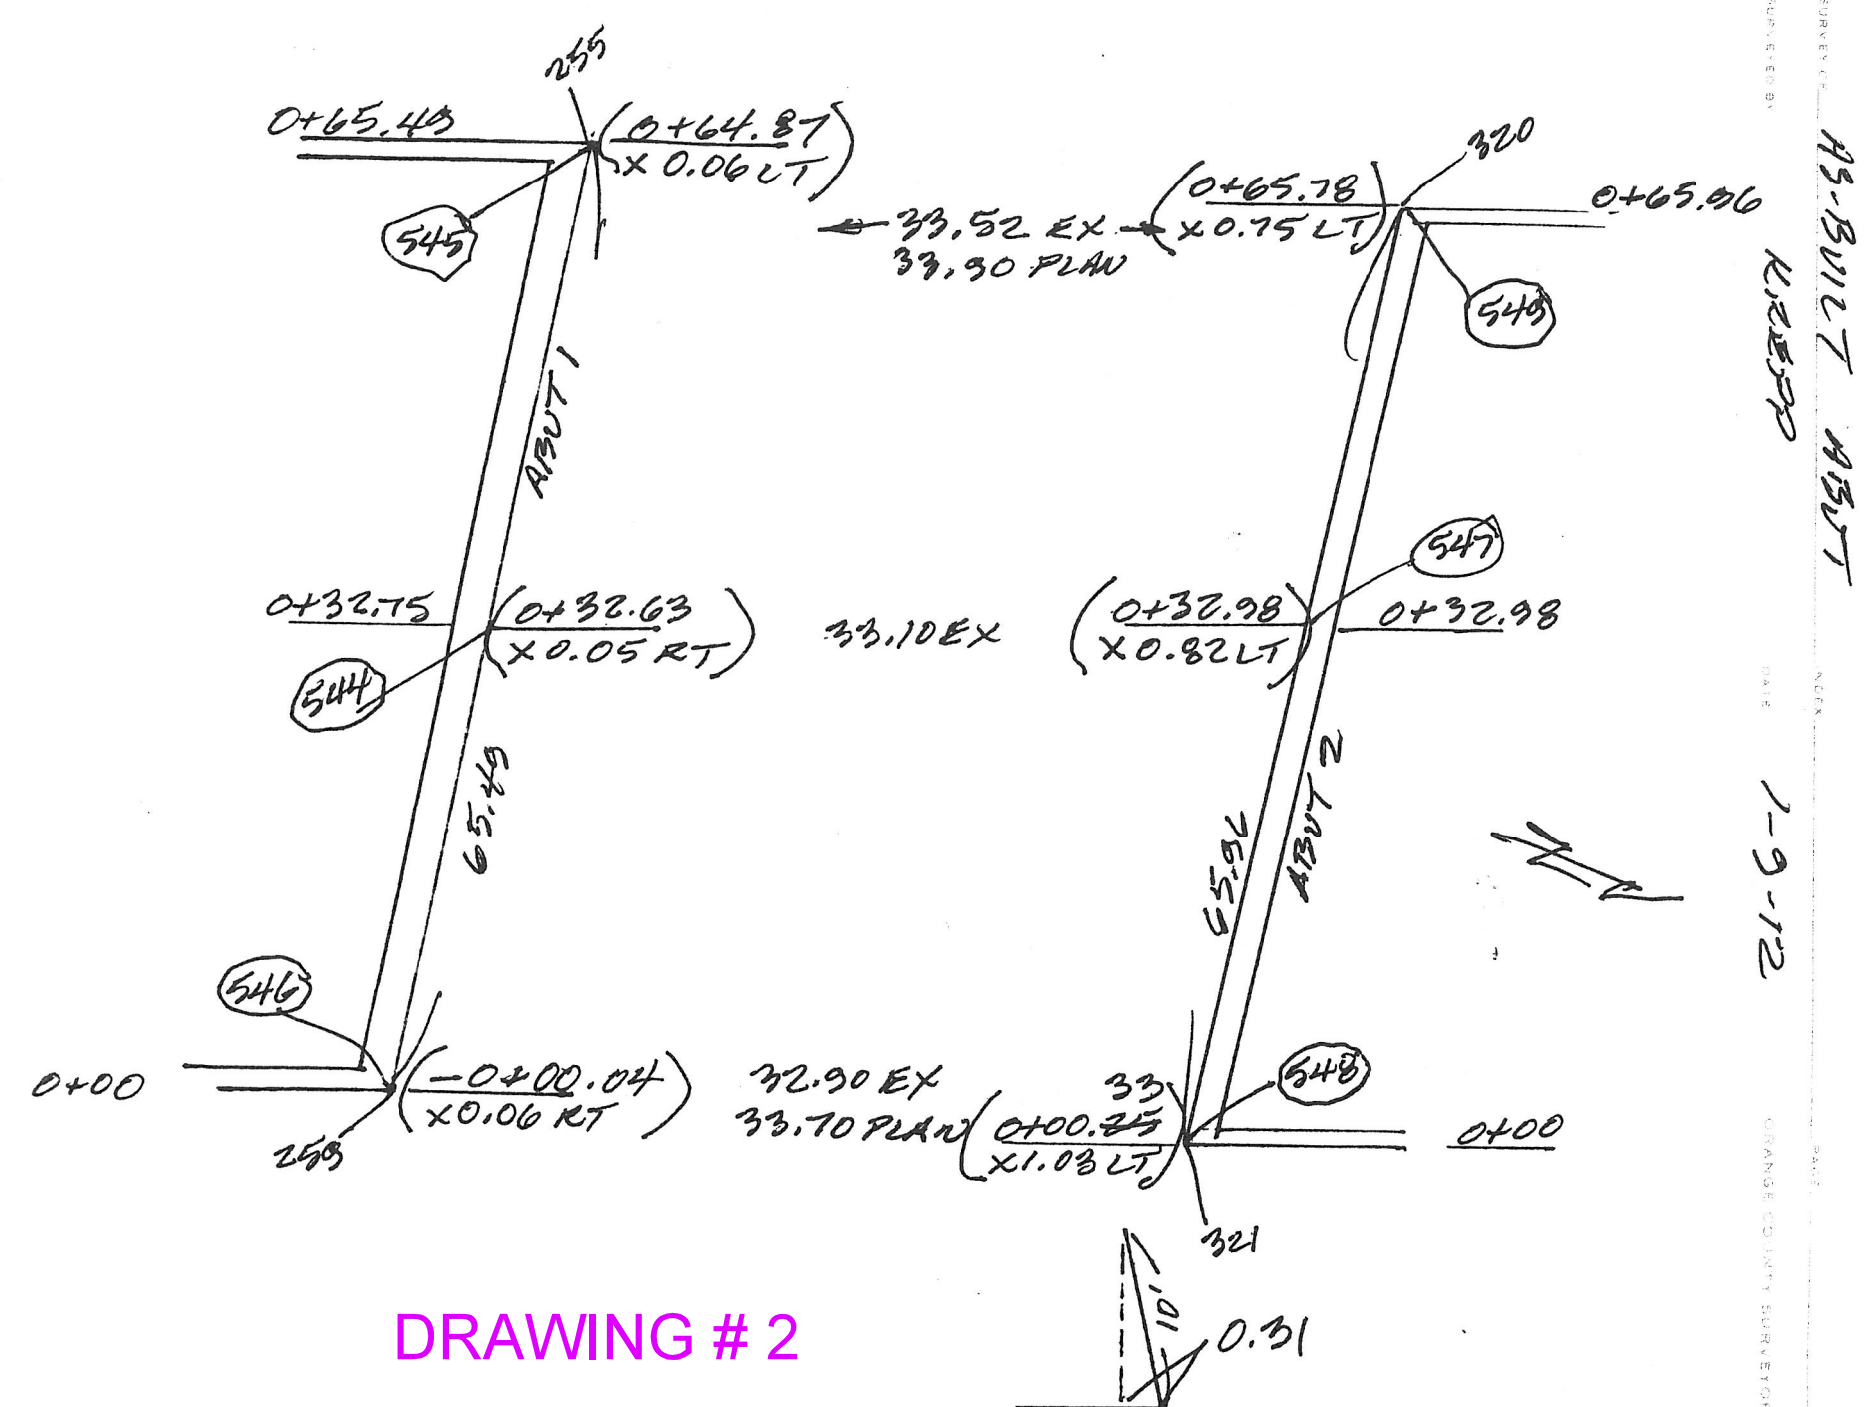
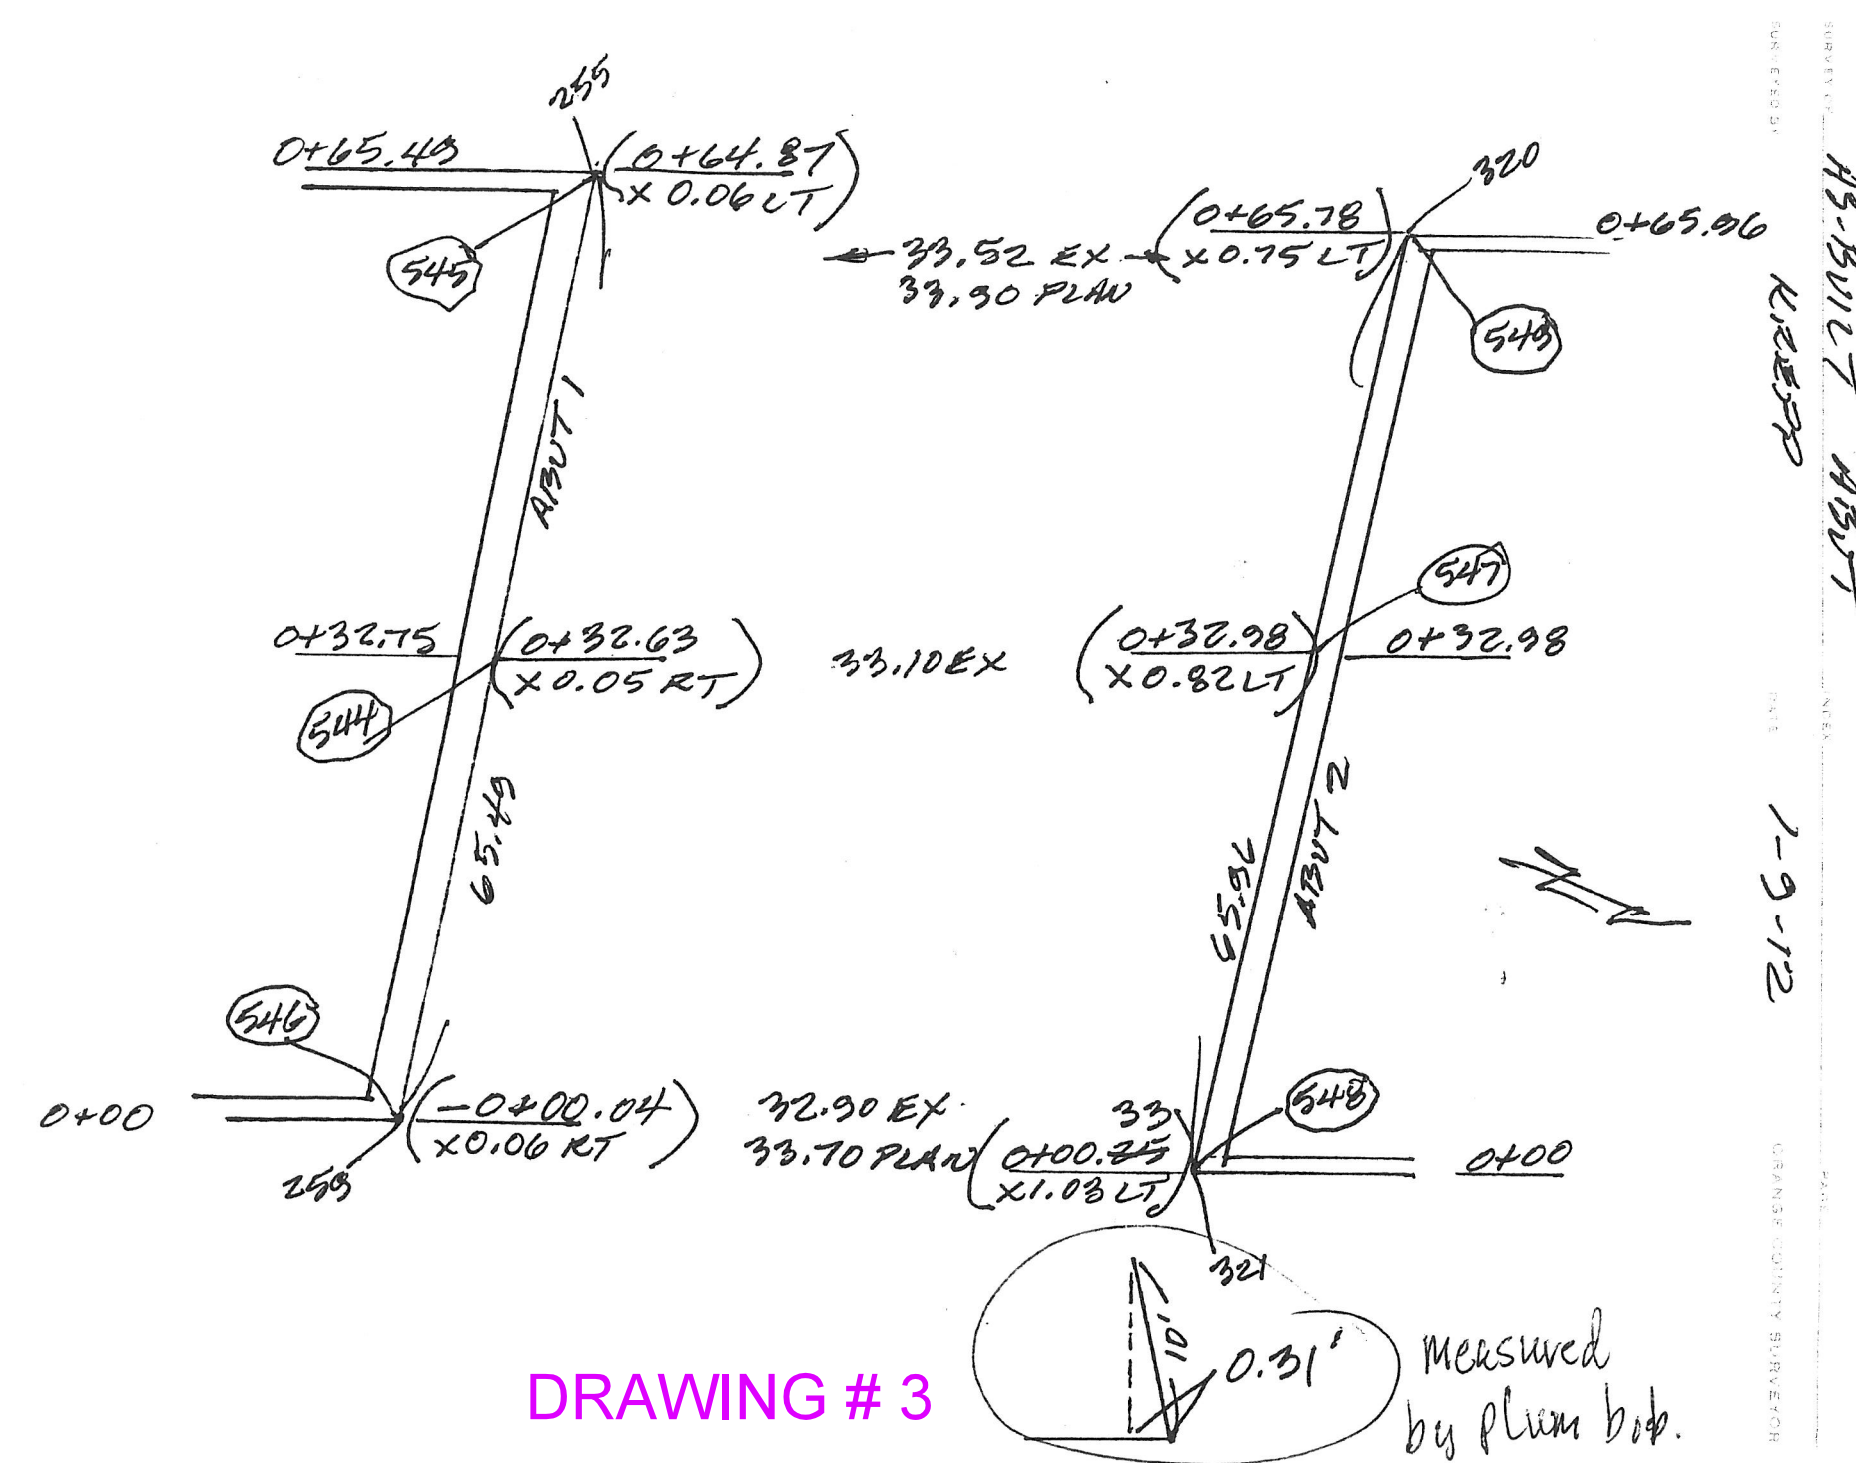


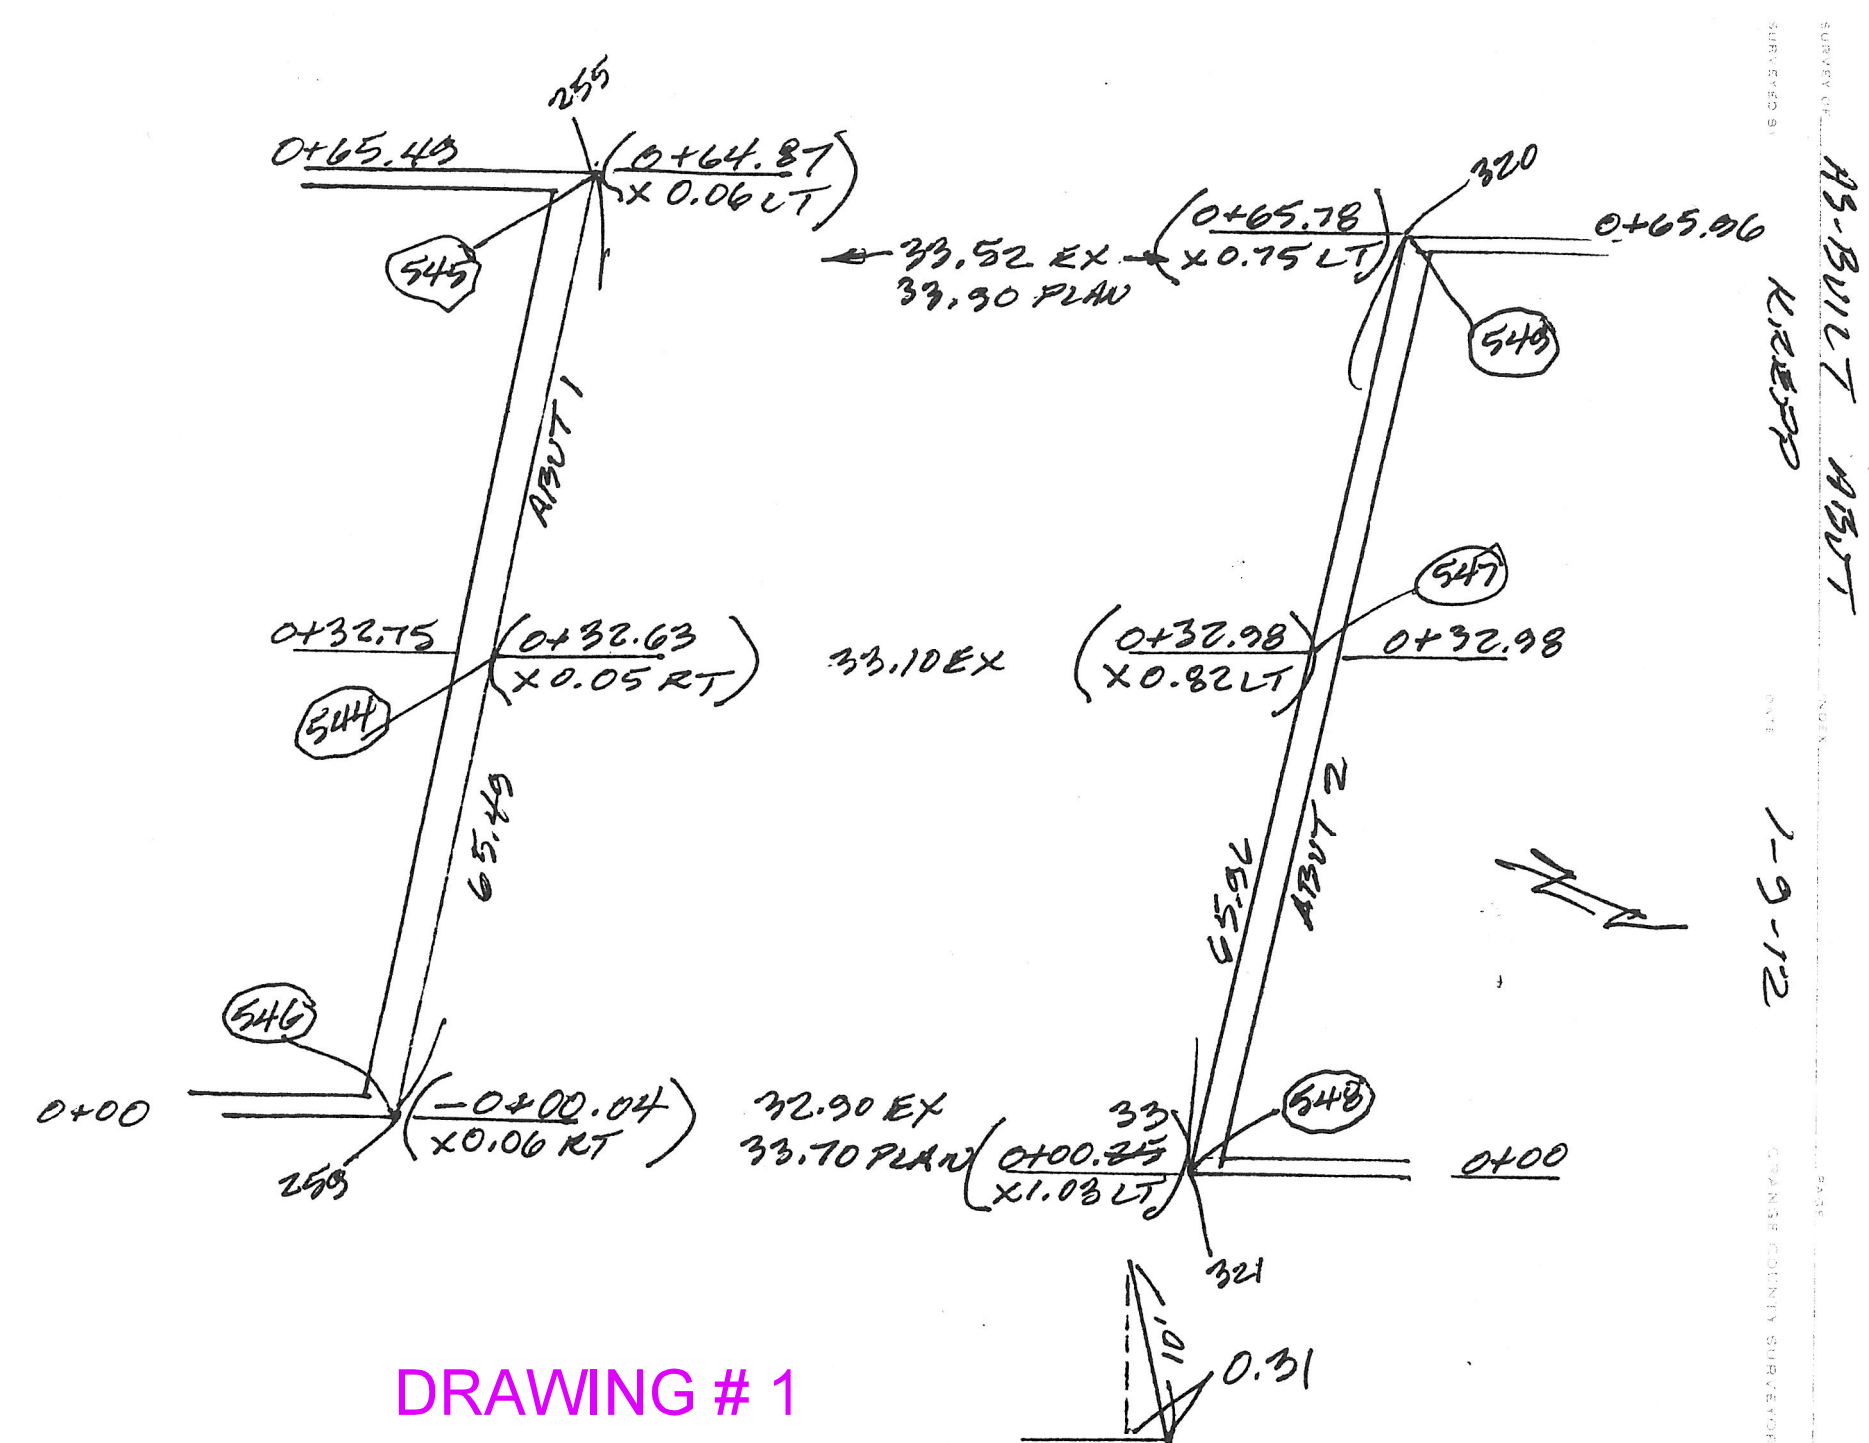

BY Tarek DATE 7 Jan 12 SUBJECT OC PUBLIC WORKS SHEET NO. 1 OF 1
CHKD. BY Saturday DATE Distance between the JOB NO. Apartment Walls #2

[illegible]

PREPARED UNDER THE RESPONSIBLE CHARGE OF:

DATE _____

COUNTY OF ORANGE OC PUBLIC WORKS	DESIGNED BY:	
	DRAWN BY:	CHECKED BY:
PREPARED BY: ROAD / CAPITAL PROJECTS	DRAWING CODE:	
	FILE NAME:	
	PLOT DATE:	SCALE: AS SHOWN

REPLACEMENT OF ORANGE PARK
BOULEVARD BRIDGE
AT HANDY CREEK

AS-BUILT

Sheet
Reference
Number

AB-01

Sheet 01 of 04