


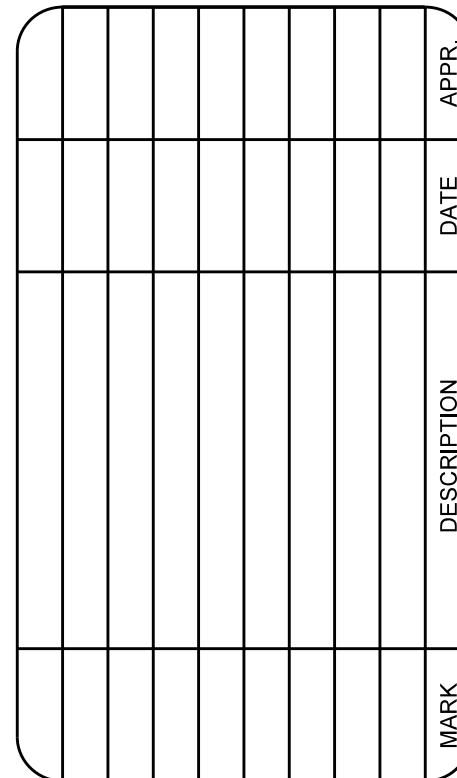

ATF

COUNTY OF ORANGE OC PUBLIC WORKS	DESIGNED BY:			
	DRAWN BY:	CHECKED BY:		
	DRAWING CODE			
	FILE NAME:			
PREPARED BY: ROAD / CAPITAL PROJECTS	PILOT DATE:	SCALE:	AS SHOWN	

AS-BUILT

Sheet 02 of 04

