


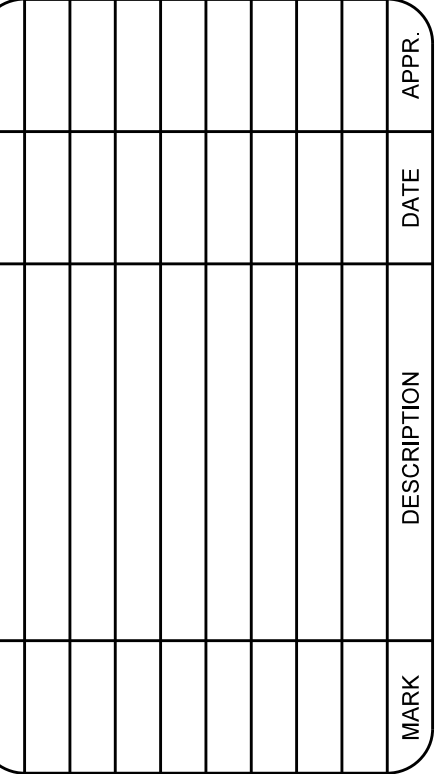

DATE _____

PLOT DATE:	SCALE: AS SHOWN
------------	--------------------

ROAD / CAPITAL PROJECTS

AS-BUILT

Sheet 03 of 04

SURVEY OF

INDEX

PAGE

SURVEYED BY

DATE

ORANGE COUNTY SURVEYOR

11-9-11
ABOUT 2 FILES

PLAN

EXIST

PLAN = 0.00

TOT FILE
116.55

N13 290	0+63.33	(0+62.71)	LT 0.13 = 1.6"	416.49
N12 289	0+56.66	(0+56.78)	LTO.02	416.56
N11 288	0+51.00	(0+51.44)	RT0.02	416.54
N10 287	0+45.33	(0+45.62)	LTO.12	416.73
N9 286	0+39.66	(0+39.53)	LTO.23 = 2.3"	416.66
N8 285	0+34.00	(0+33.98)	RT0.06	416.55
N7 284	0+28.33	(0+28.21)	LTO.23	416.48
N6 283	0+22.67	(0+22.64)	LTO.47 = 5.5"	416.47
N5 282	0+17.00	(0+16.87)	LTO.10	416.60
N4 281	0+12.75	(0+12.19)	RT0.33 = 4.7"	416.58
N3 280	0+08.50	(0+08.62)	RT0.08	-1.40 417.73 (416.32)
N2 279	0+04.25	(0+04.31)	RT0.02	-1.30 417.51 (416.21)
N1 278	0+00	(0+0.57)	RT0.01	-0.80 417.30 (416.50)

DRAWING # 1

