


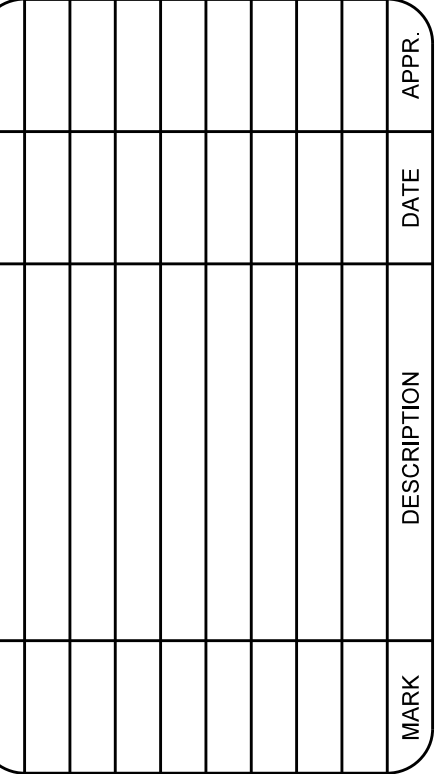


DATE _____

ROAD / CAPITAL PROJECTS

AS-BUILT

Sheet 04 of 04

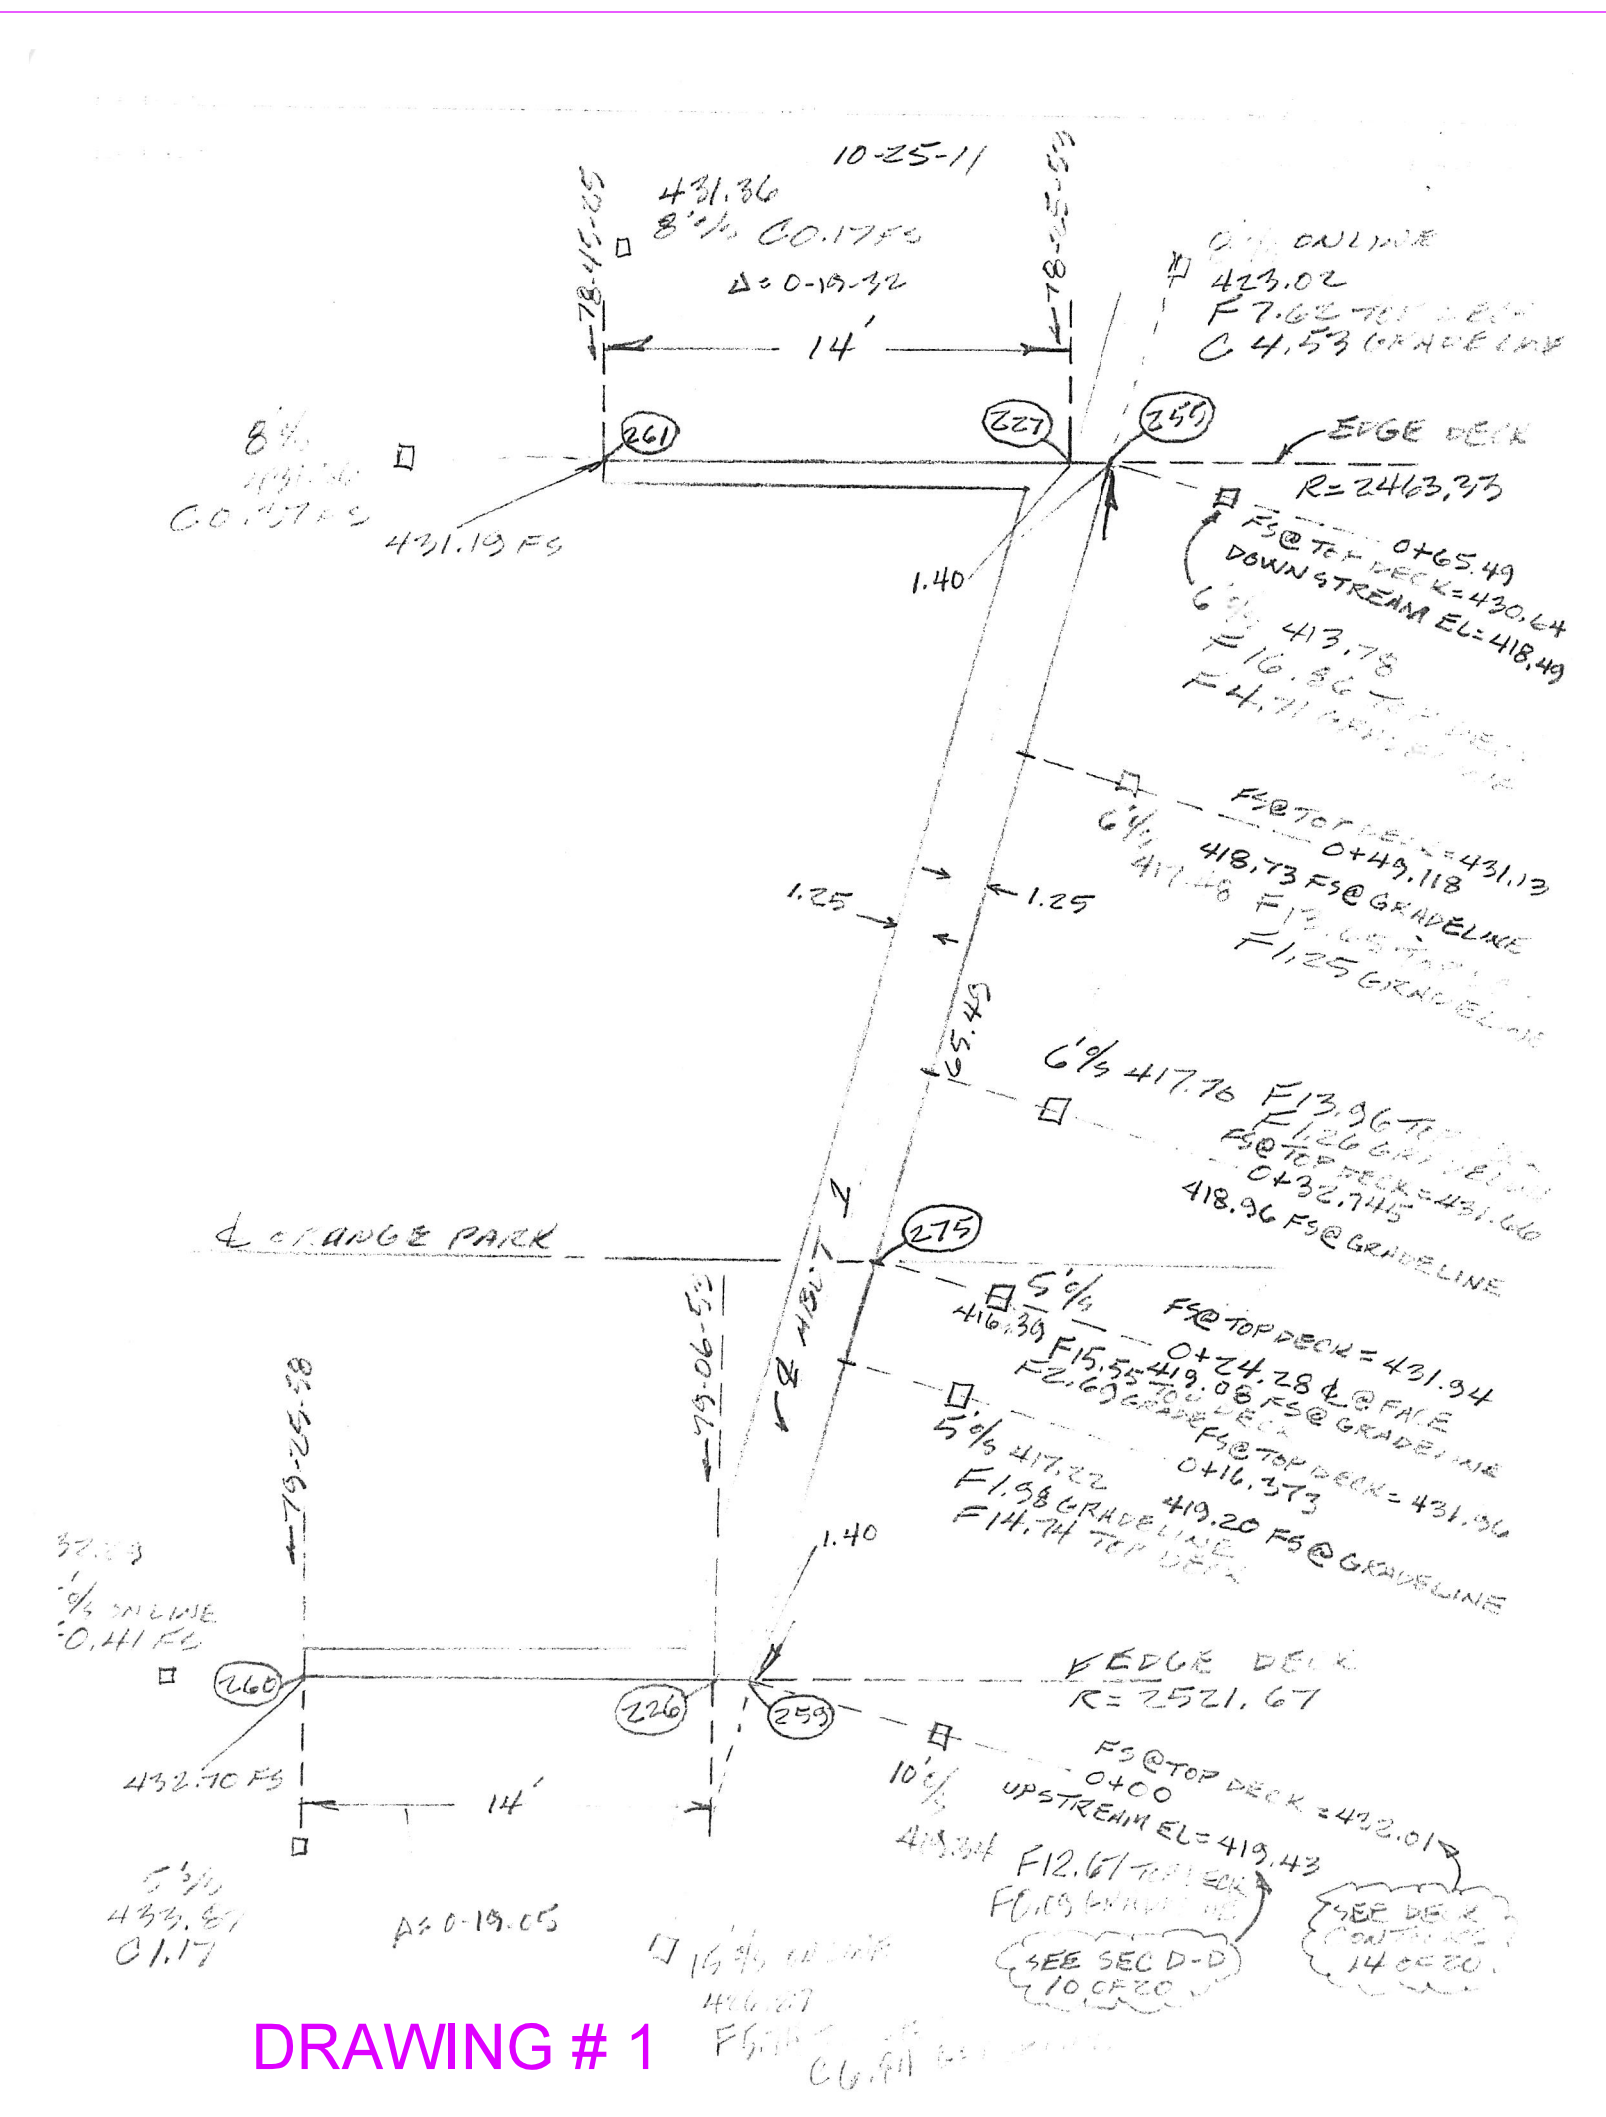

<u>PLAN</u>	<u>EXIST</u>	<u>PLAN</u> <u>0.00</u>	<u>TOP PL</u> <u>416.55</u>
913 = 0+62.33	(0+61.35)	LT 0.21	(416.72)
912 = 0+58.08	(0+57.47)	LT 0.15	(416.61)
911 = 0+53.83	(0+53.67)	LT 0.08	(416.74)
910 = 0+49.58	(0+49.44)	LT 0.36	(416.50)
99 = 0+45.33	(0+45.27)	LT 0.56	(416.19)
98 = 0+39.66	(0+39.97)	LT 0.23	(416.40)
97 = 0+34.00	(0+33.62)	LT 0.54	(416.39)
96 = 0+28.33	(0+28.39)	LT 0.37	(416.52)
95 = 0+22.66	(0+22.38)	LT 0.44	(416.27)
94 = 0+17.00	(0+17.27)	LT 0.22	(416.48)
93 = 0+11.33	(0+11.06)	LT 0.17	(416.59)
92 = 0+05.67	(0+05.67)	LT 0.14	(416.47)
91 = 0+00	(-0+00.63)	LT 0.02	(416.30)

DRAWING # 2