
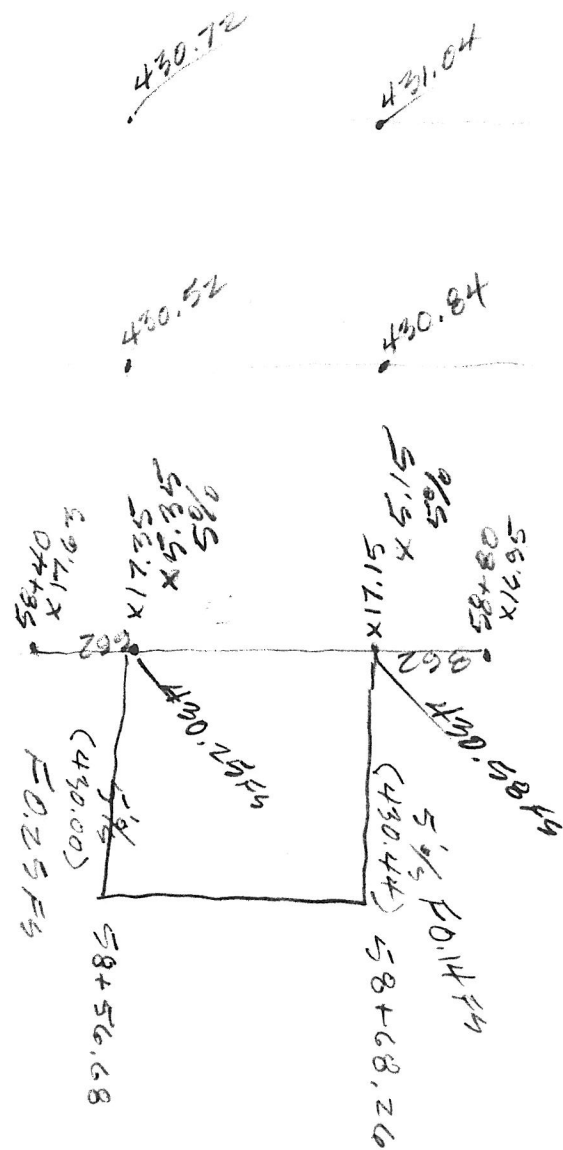
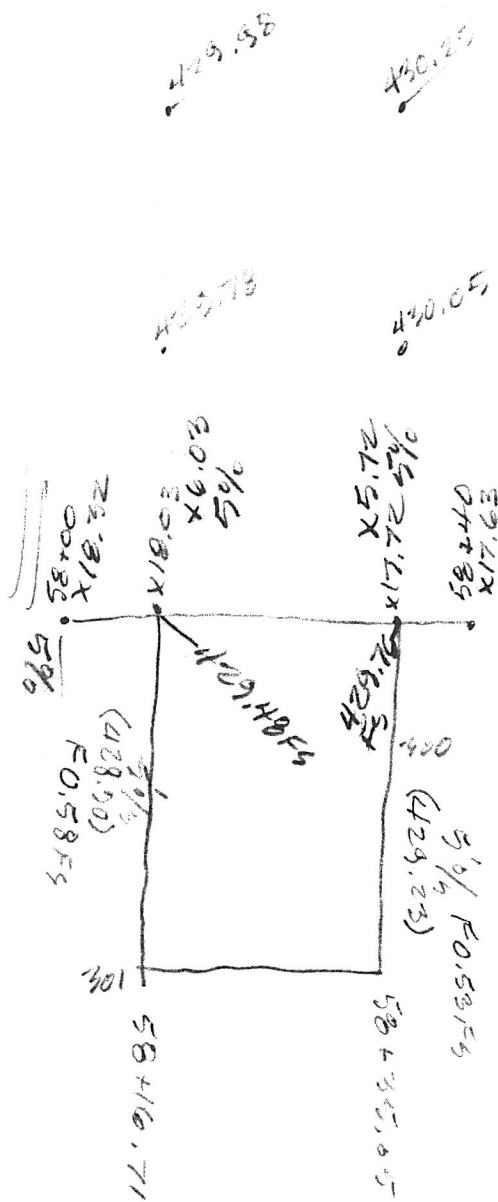
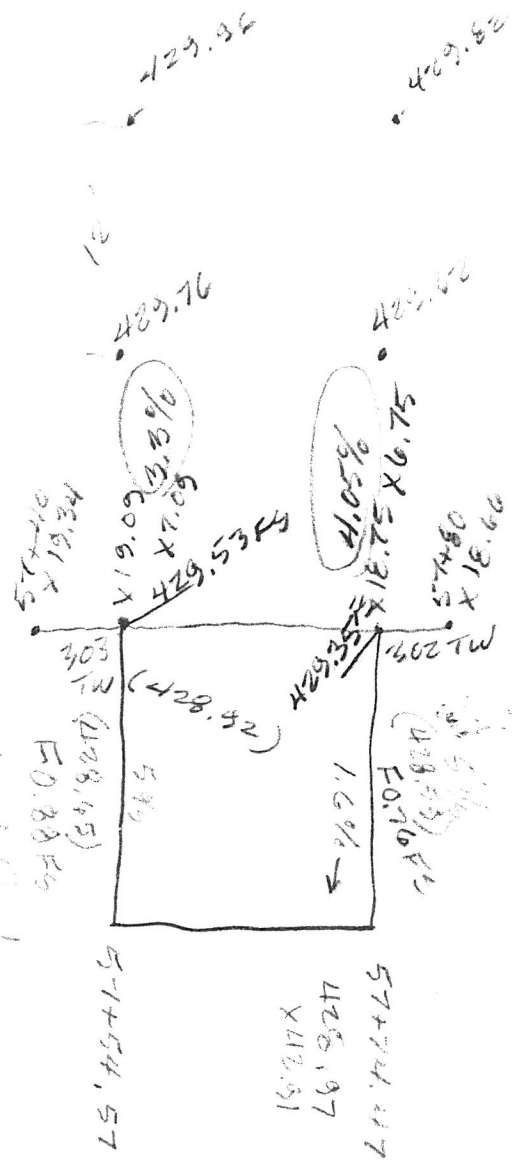


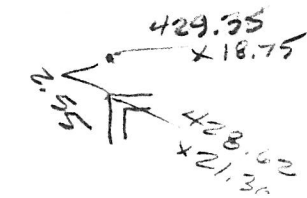

12-14-11