



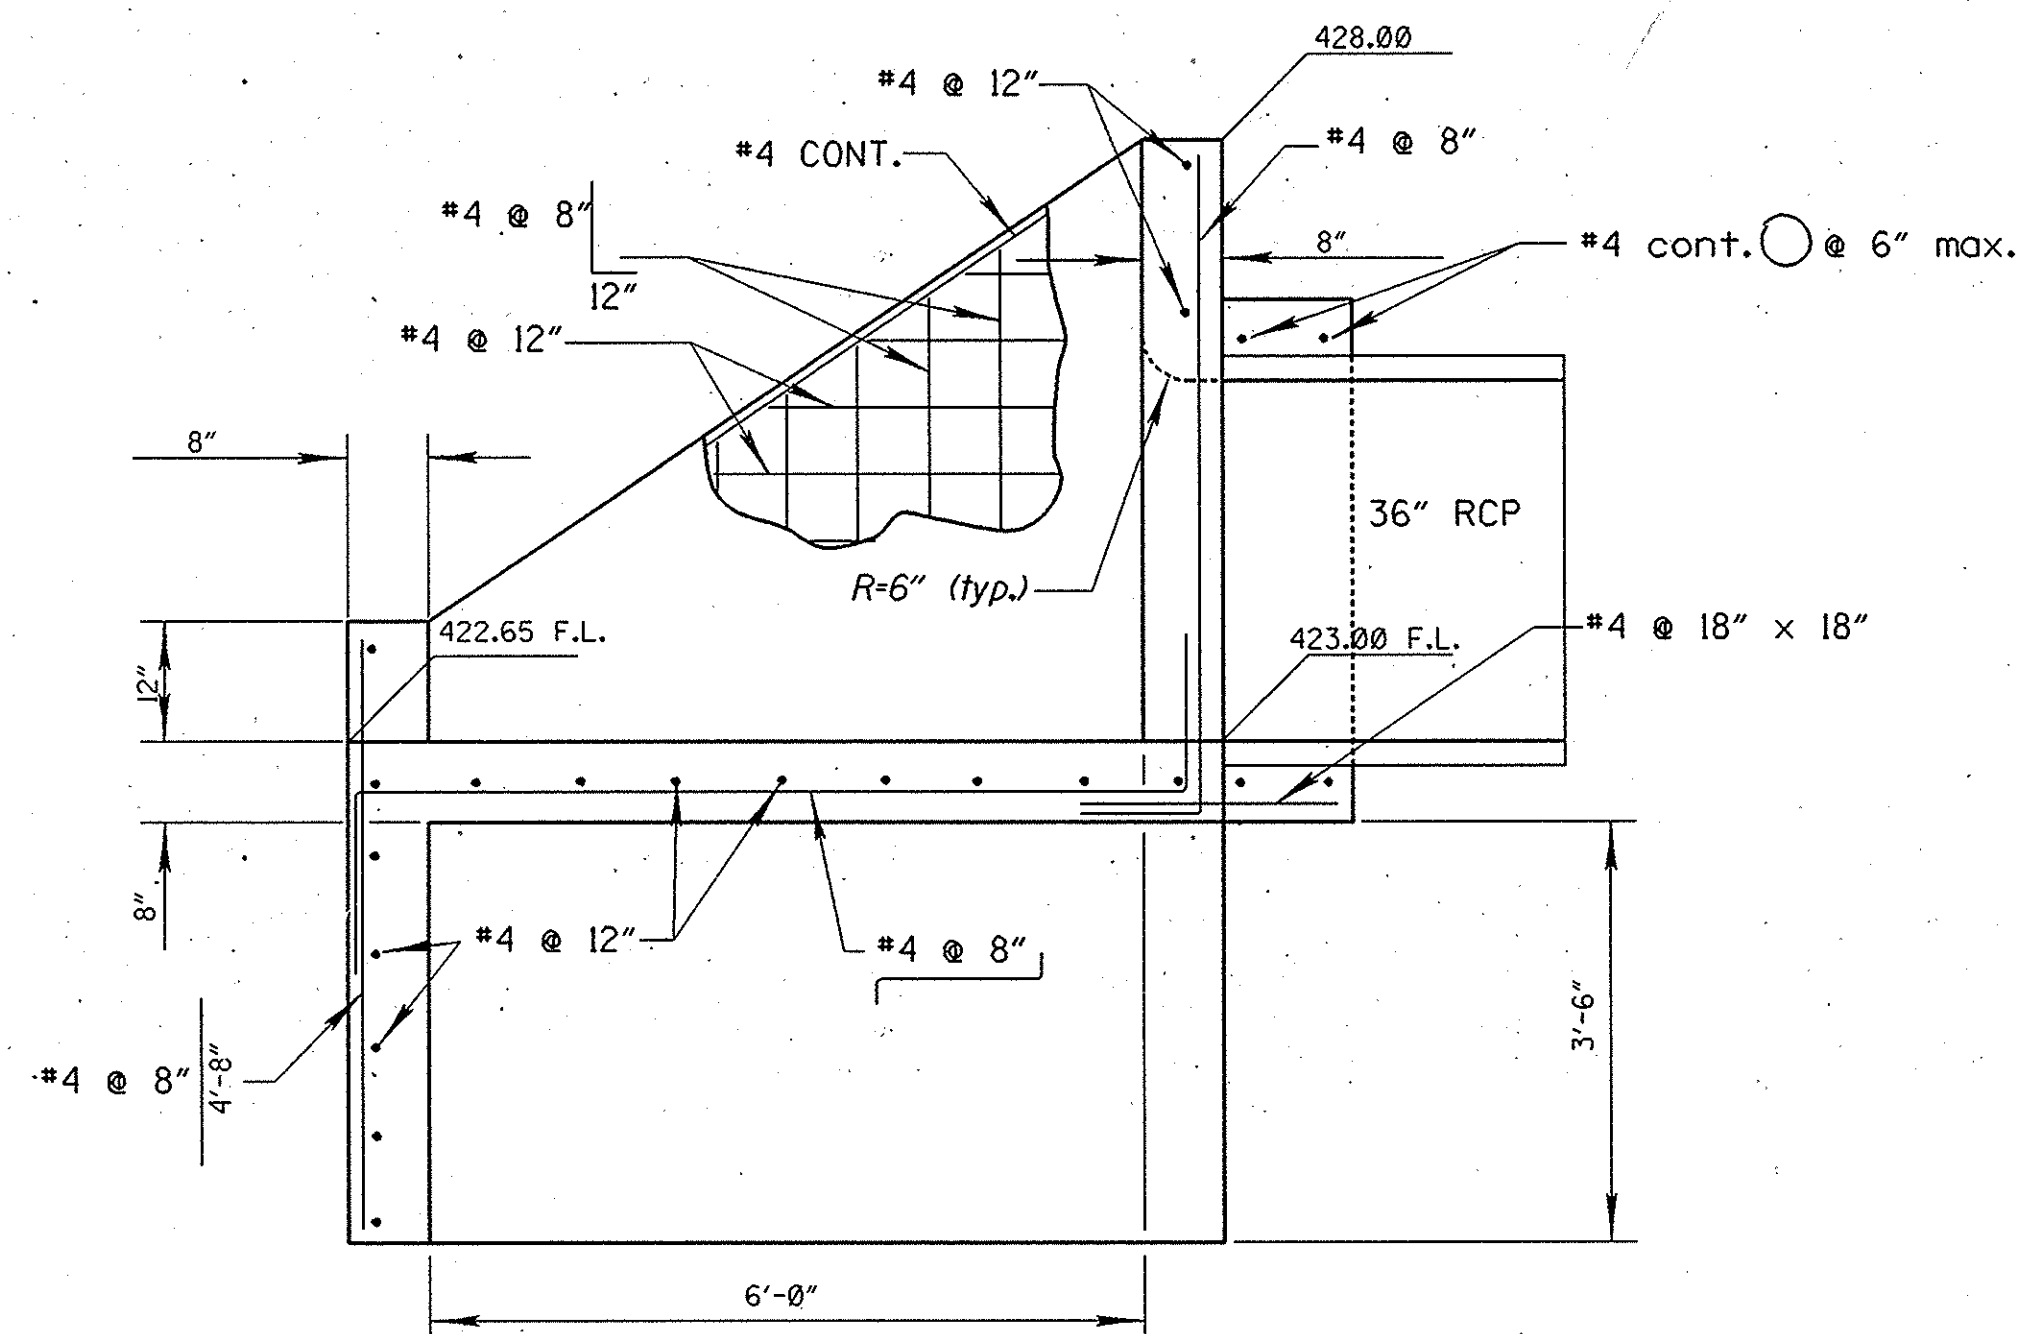


B - B

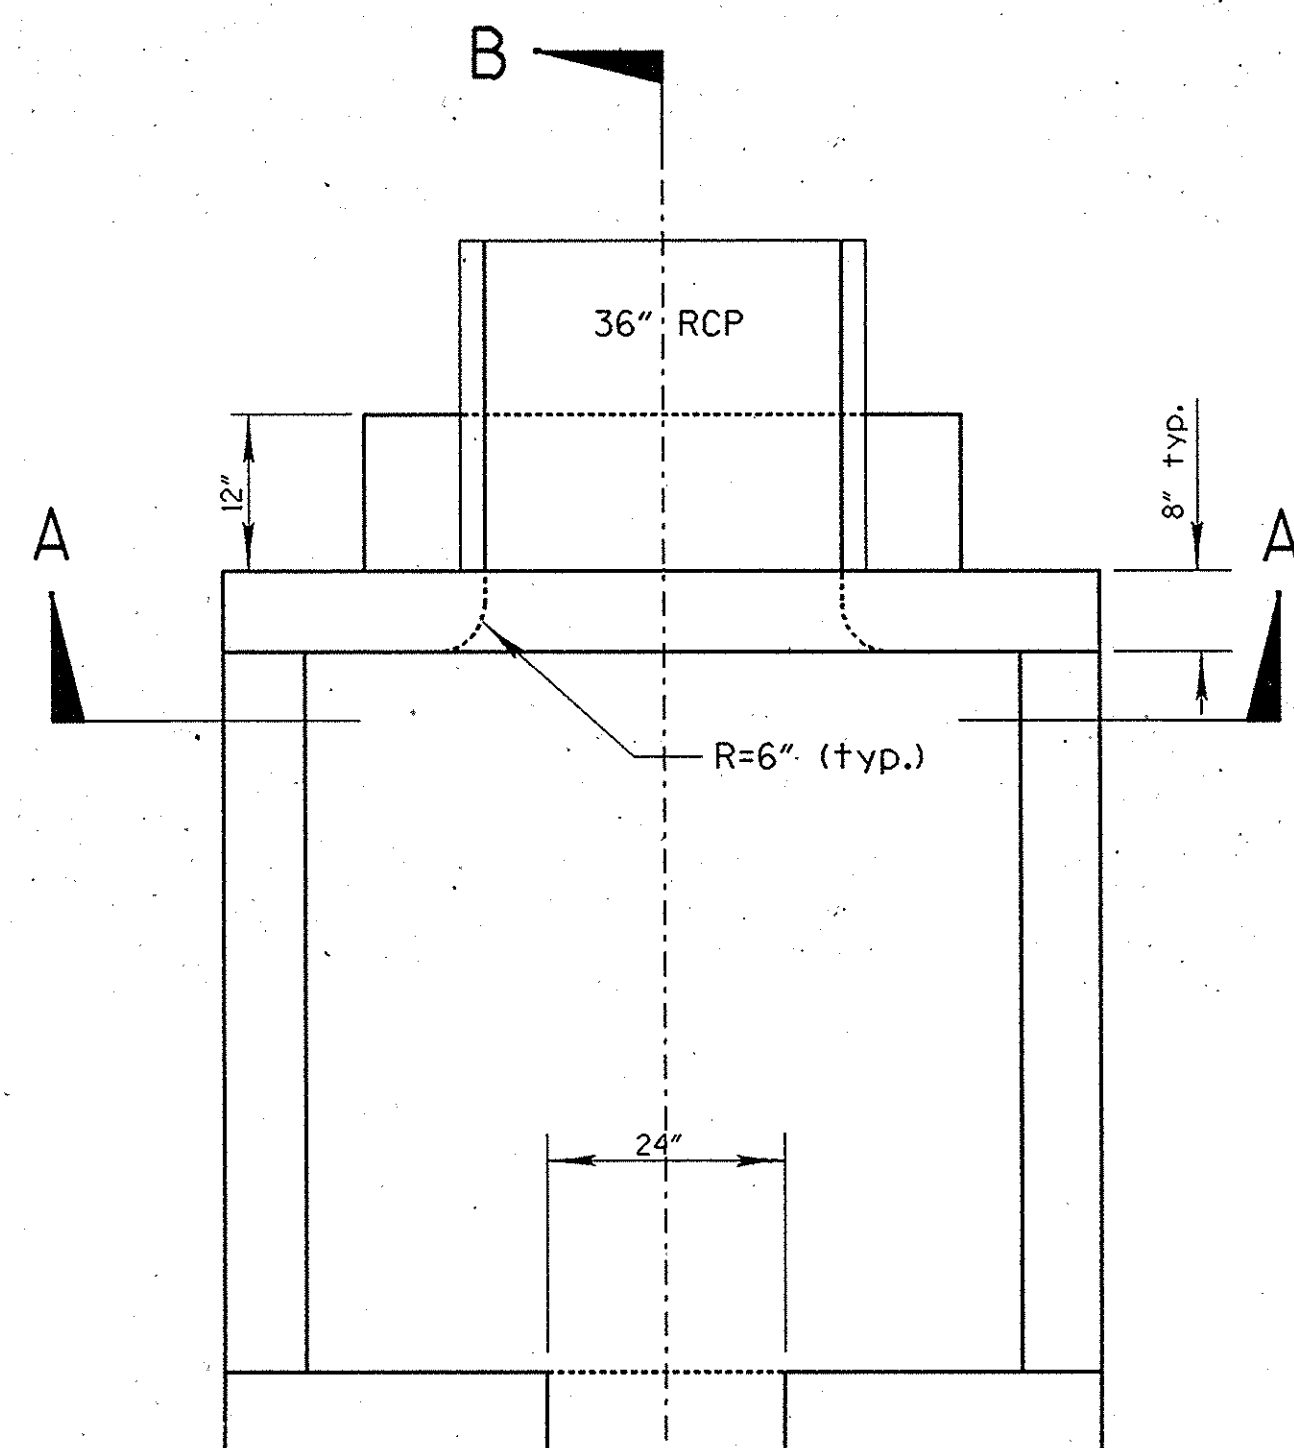


PLAN

OUTLET STRUCTURE


Not To Scale

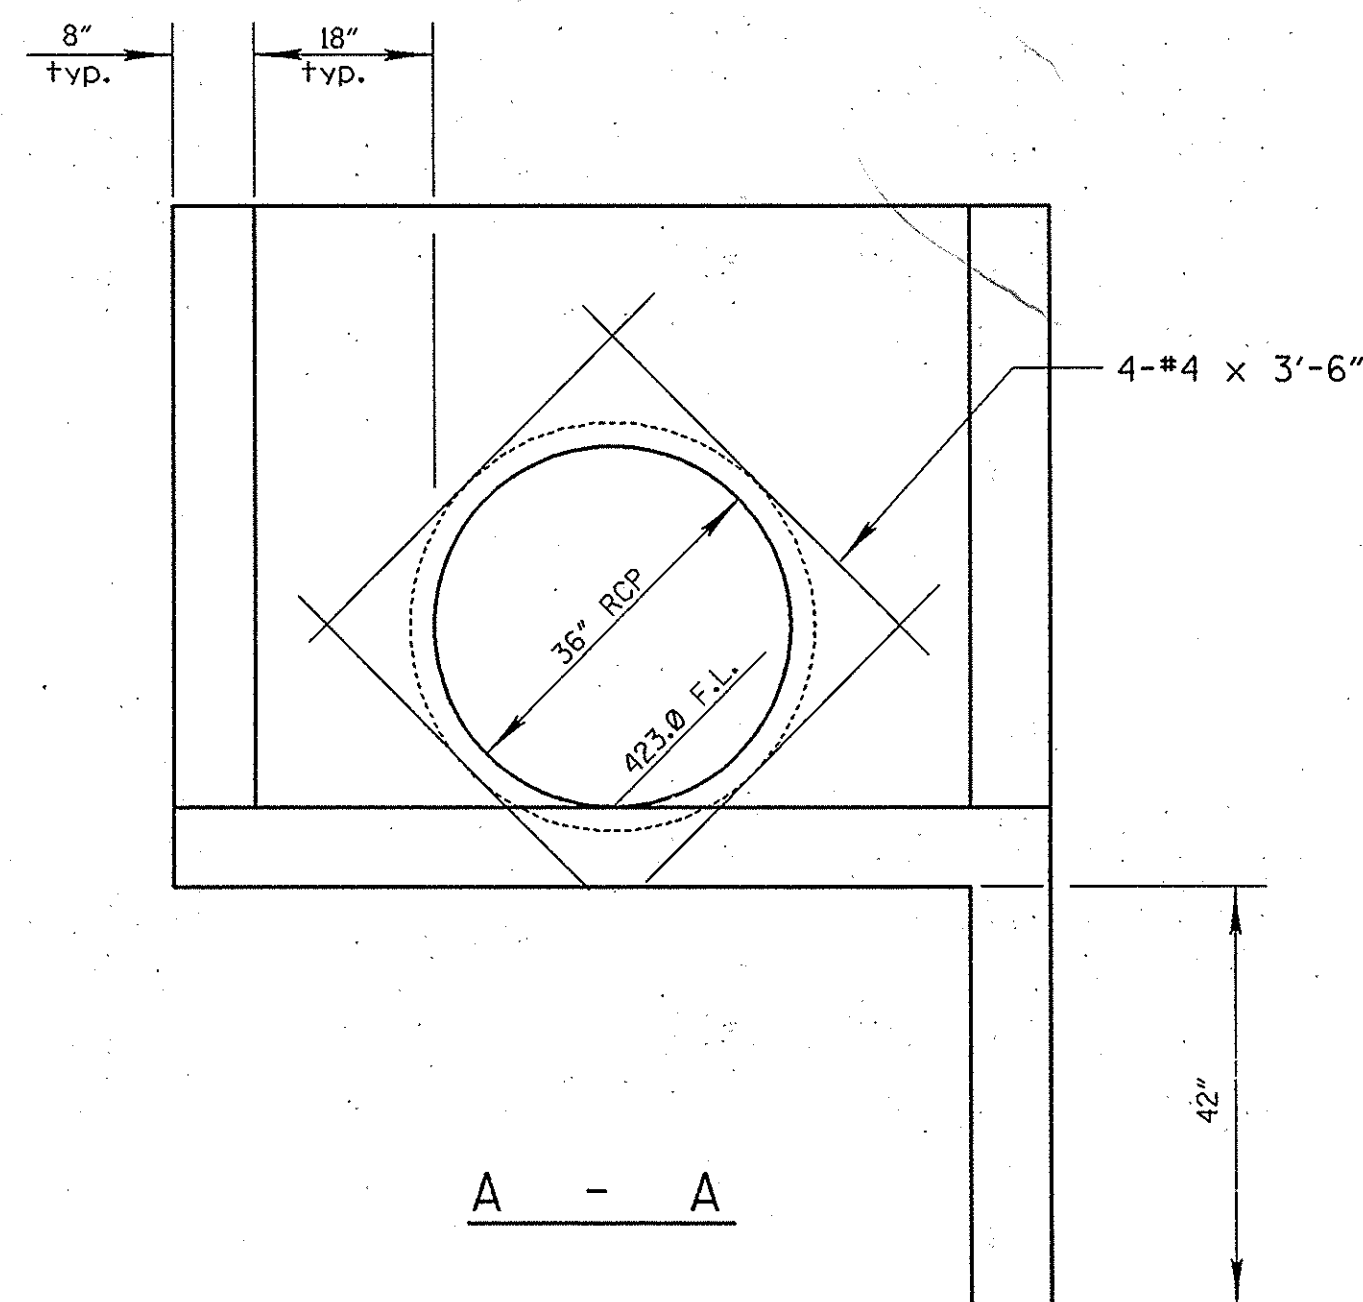

A - A

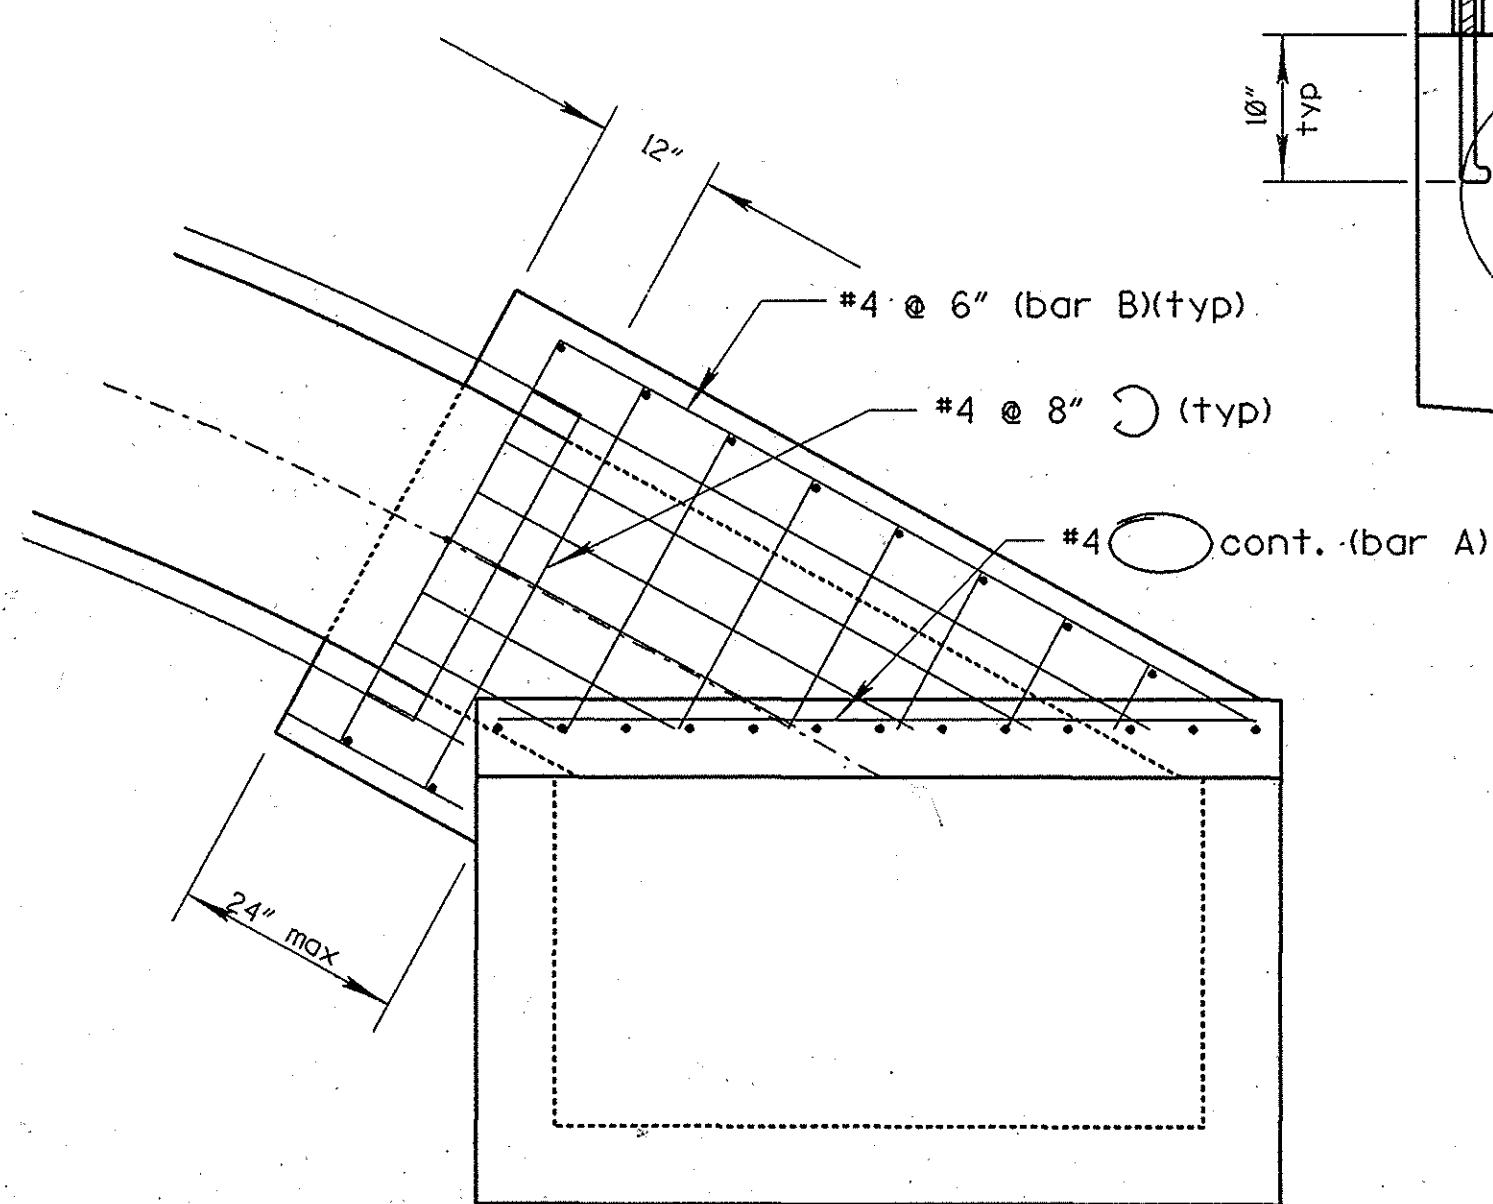


PLAN

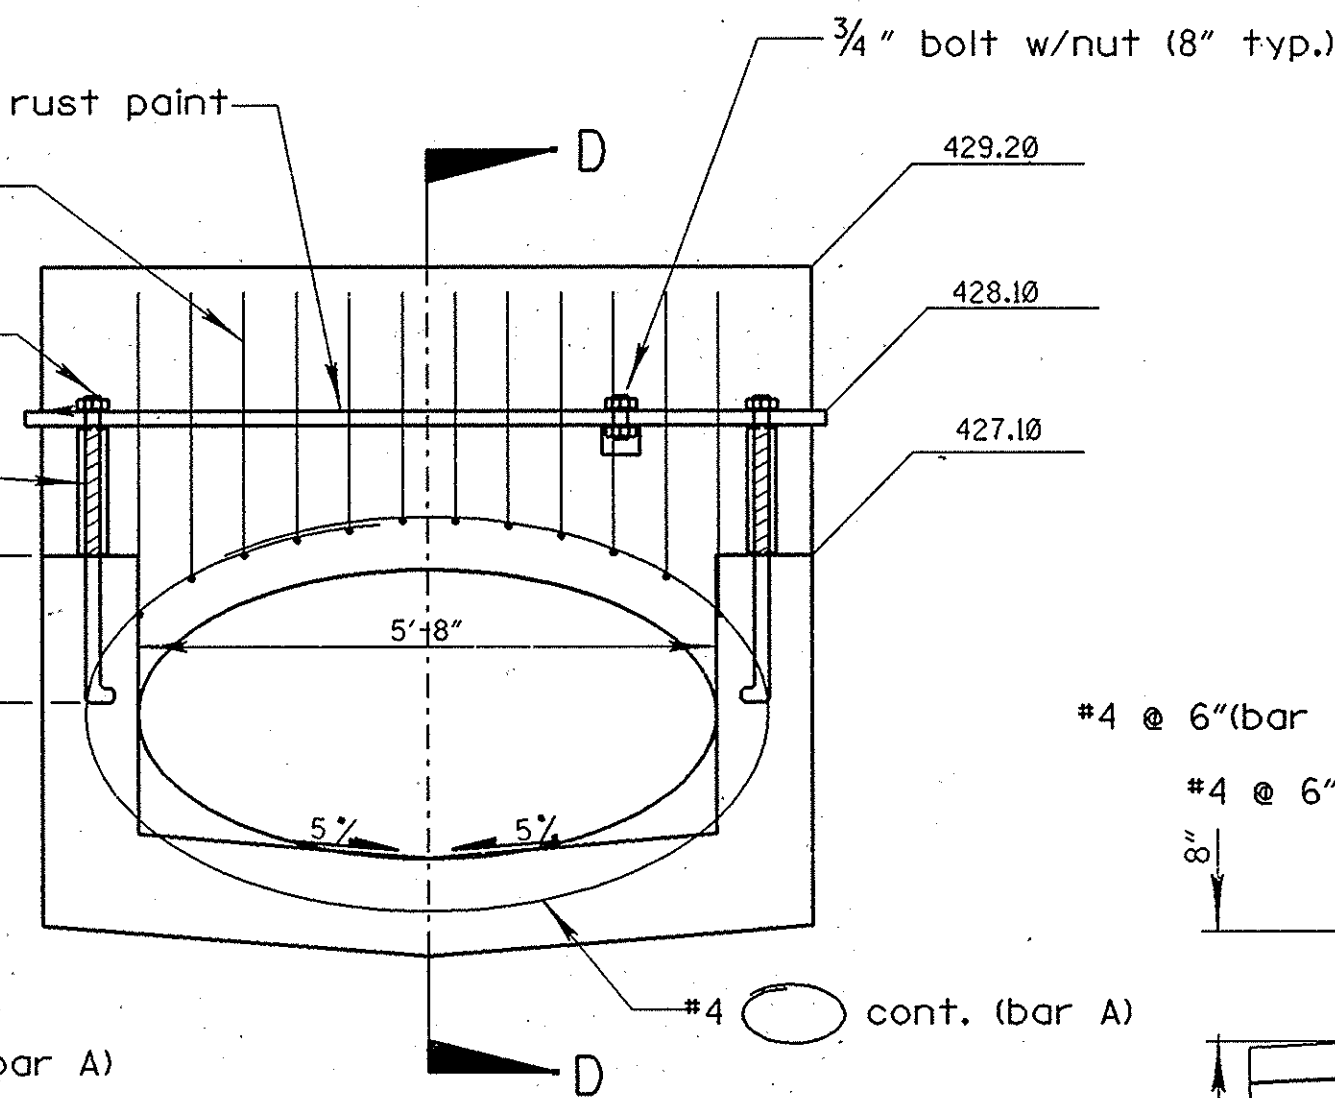

ELEVATION

UPSTREAM INLET


Not To Scale

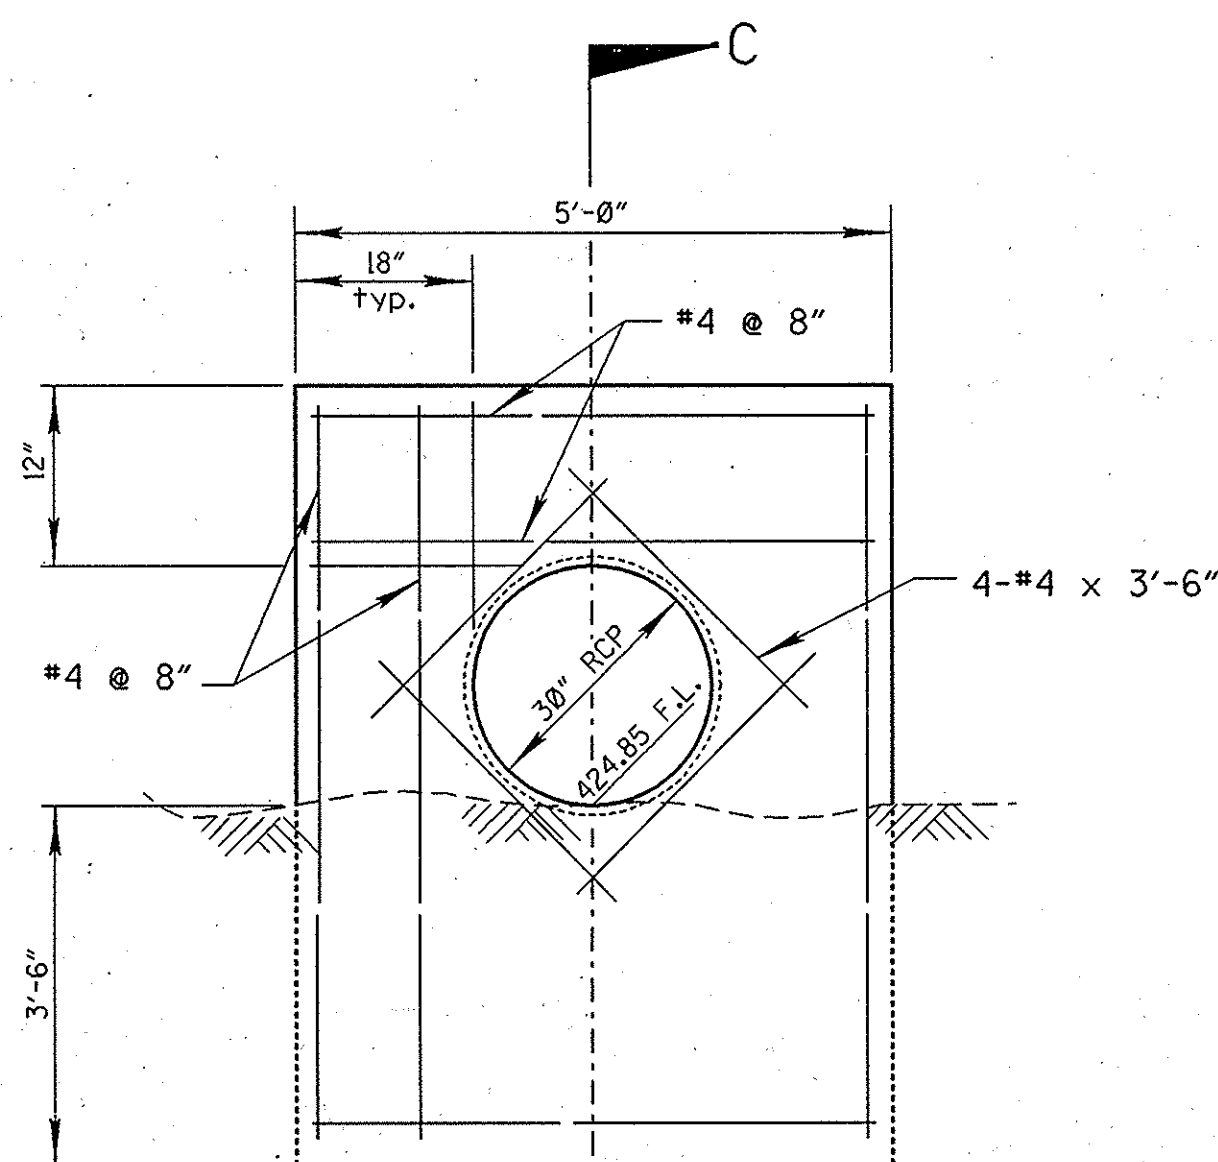


ELEVATION

HEADWALL INLET

Not To Scale

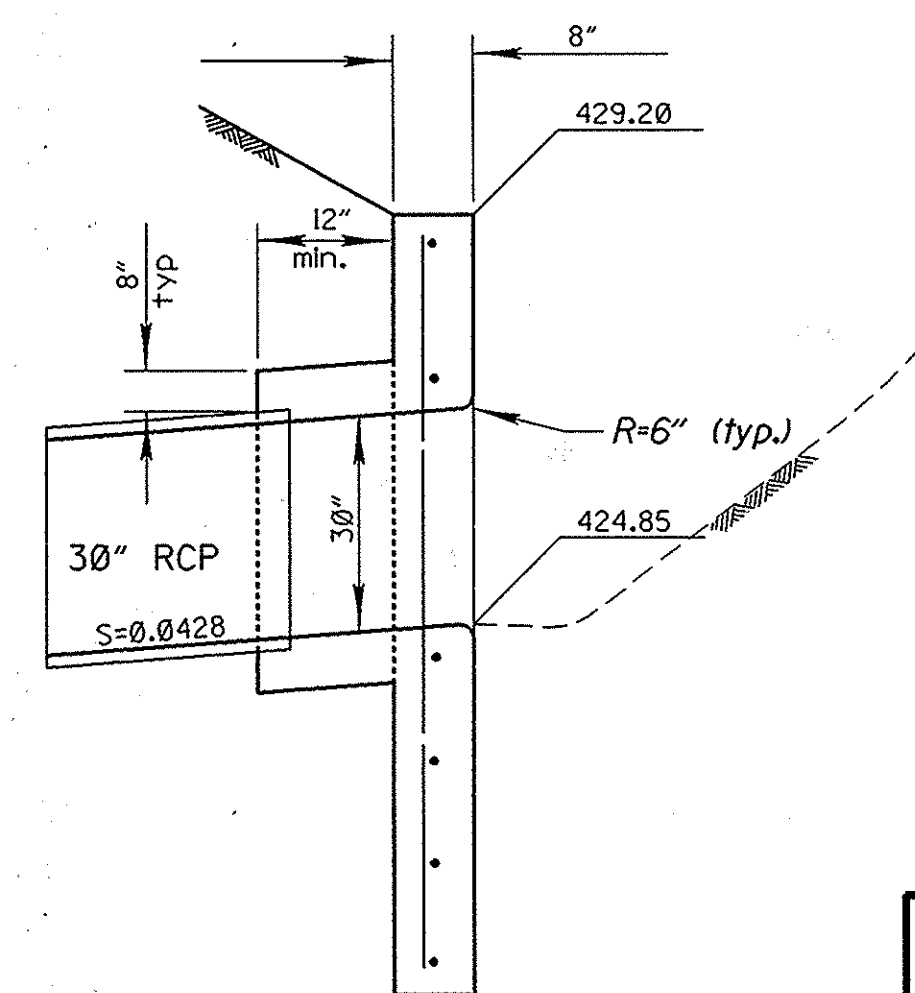

C - C

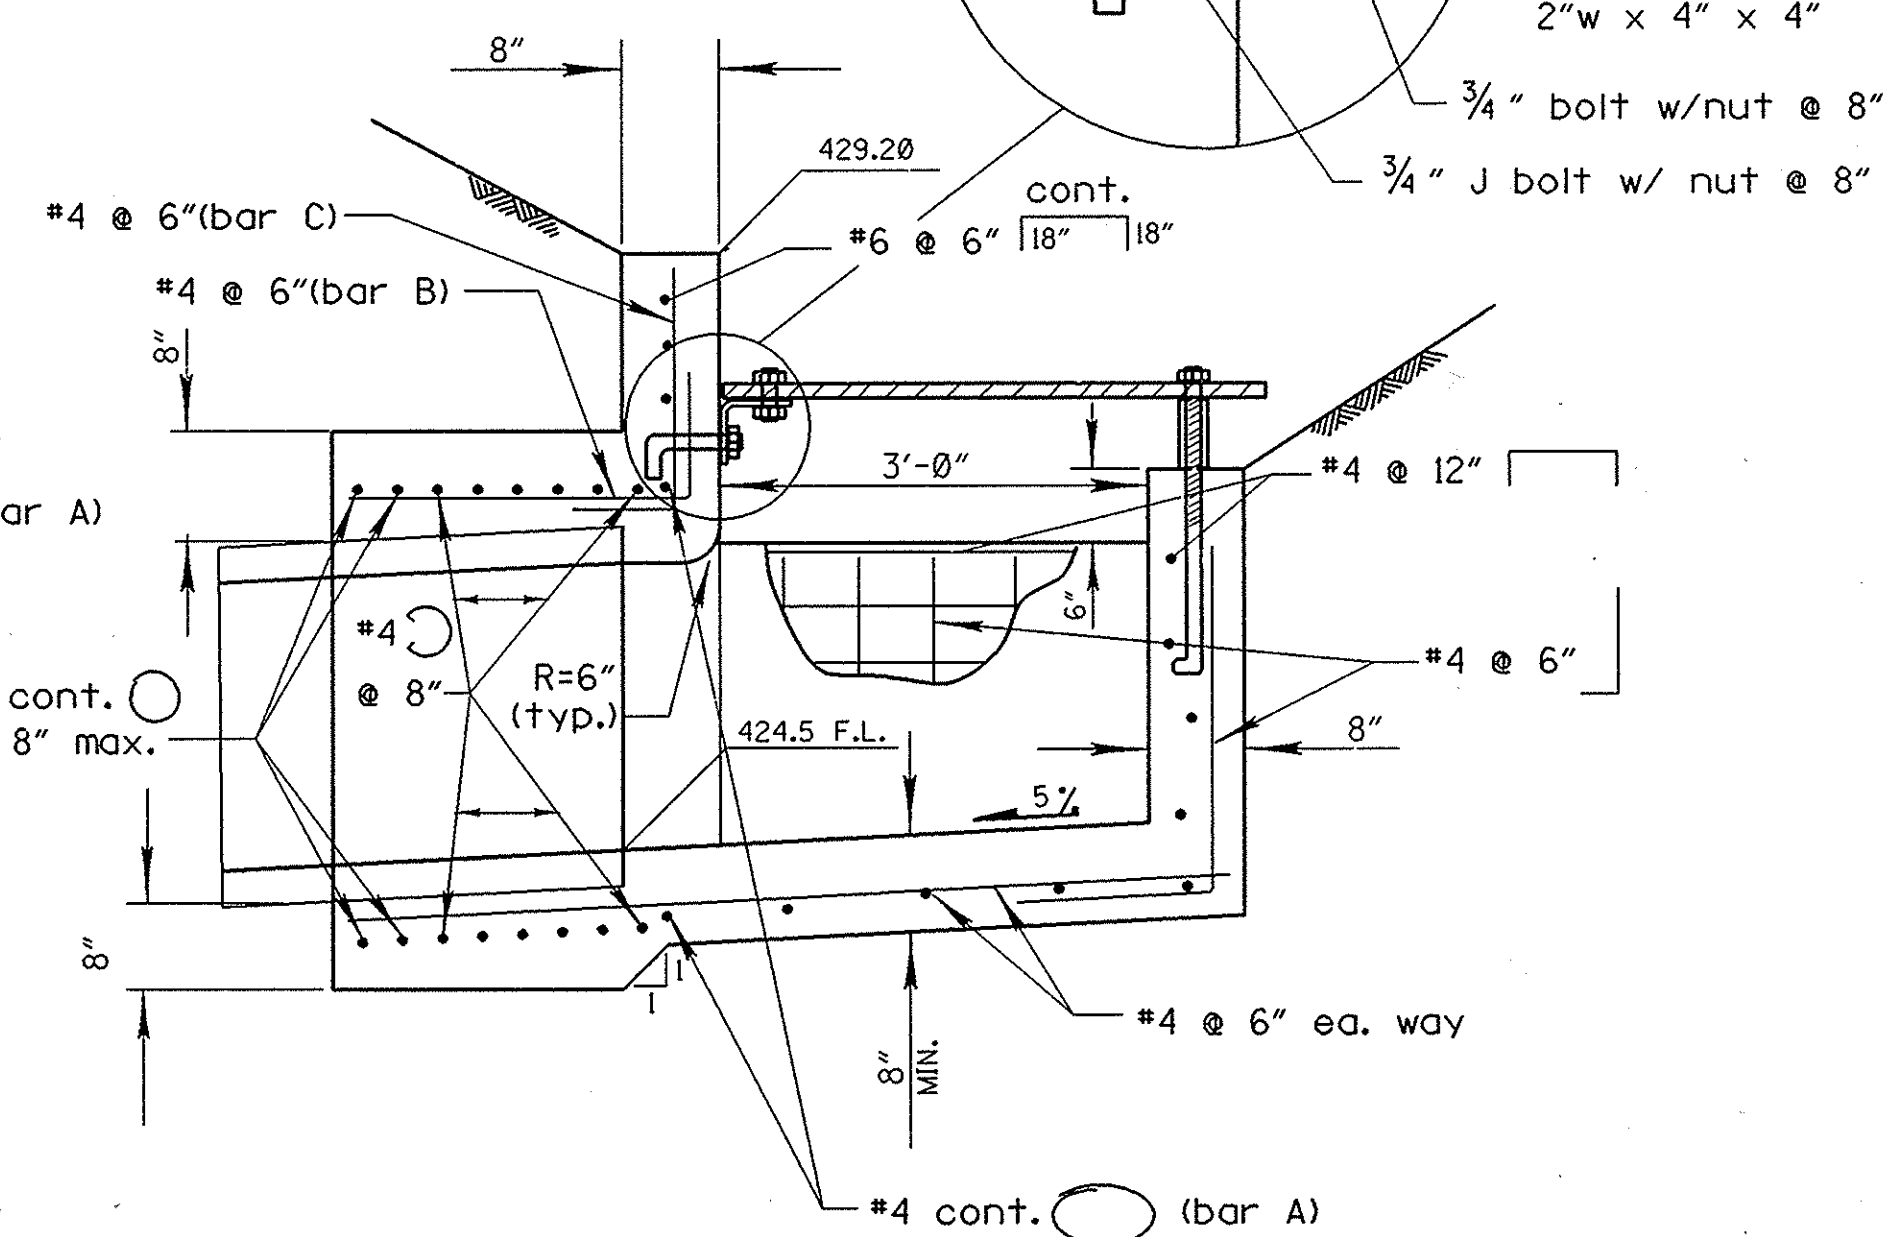

D - D

NOTE:

All nuts and bolts shall be Grade 5 or better.

1/2 0 1 2
3 inches on original drawing

ORANGE COUNTY ENVIRONMENTAL MANAGEMENT AGENCY		ORANGE PARK BLVD. STORM DRAIN	
DETAILS			
MARK	DATE	DESCRIPTION	
REVISIONS			
PREPARED UNDER SUPERVISION OF			
DESIGNED - RAH		CHECKED - MWC	
SCALE	DATE	DRAWING NO.	
AS SHOWN	APR. 1991		
SHEET			3
OF 3			