
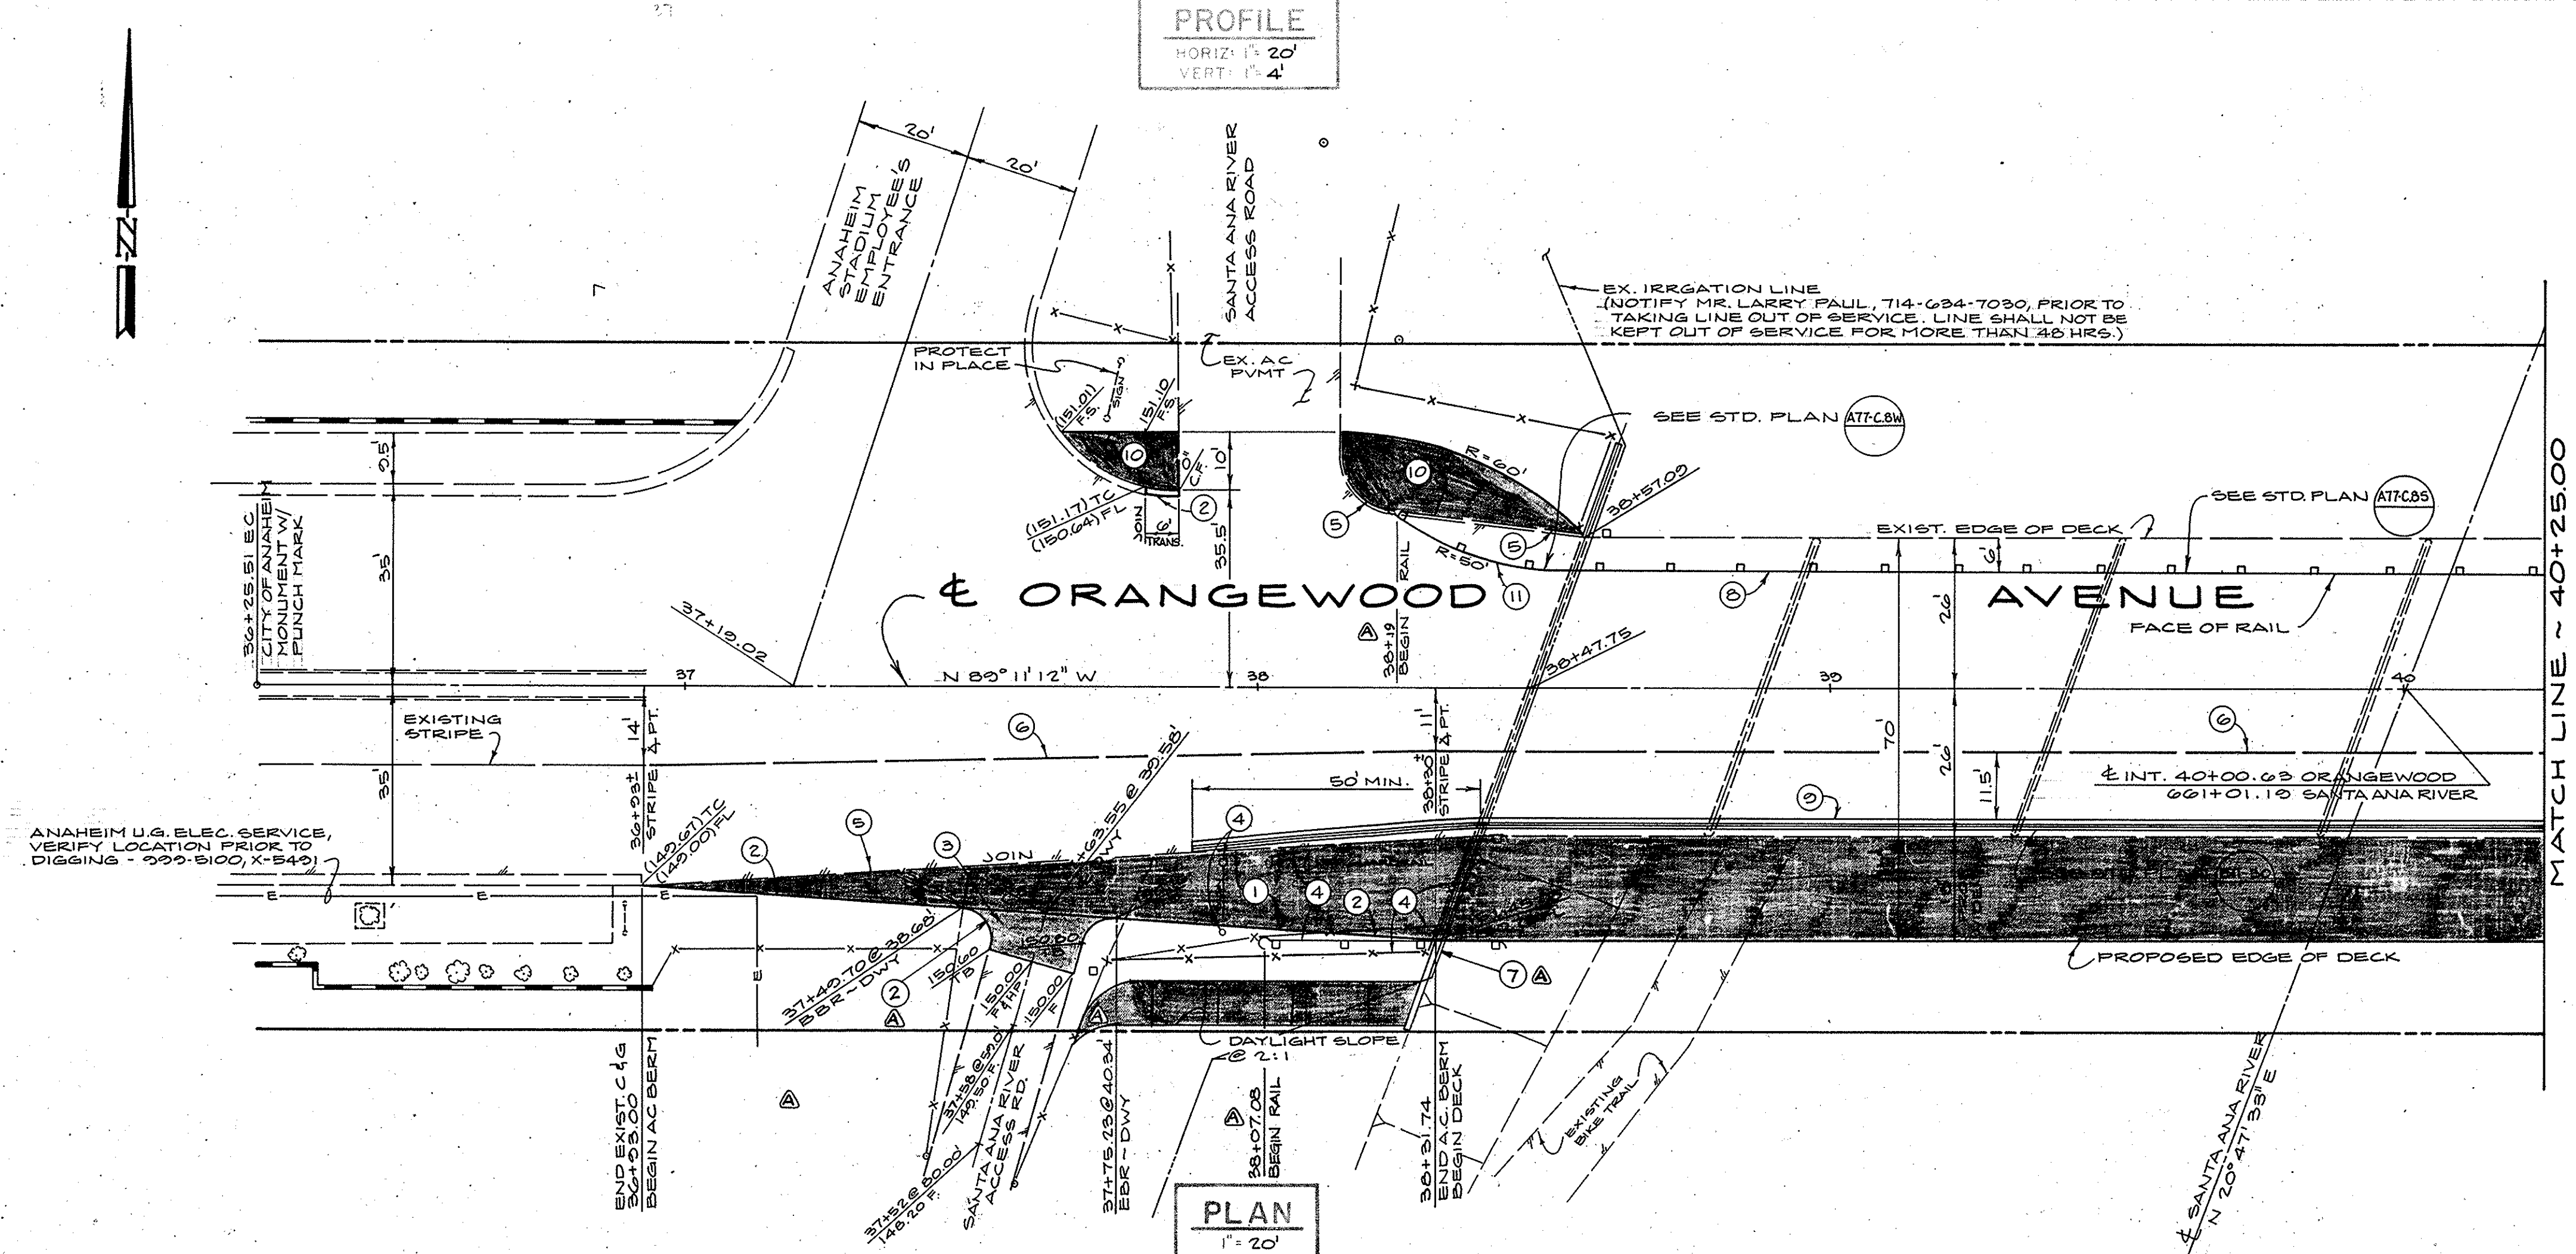


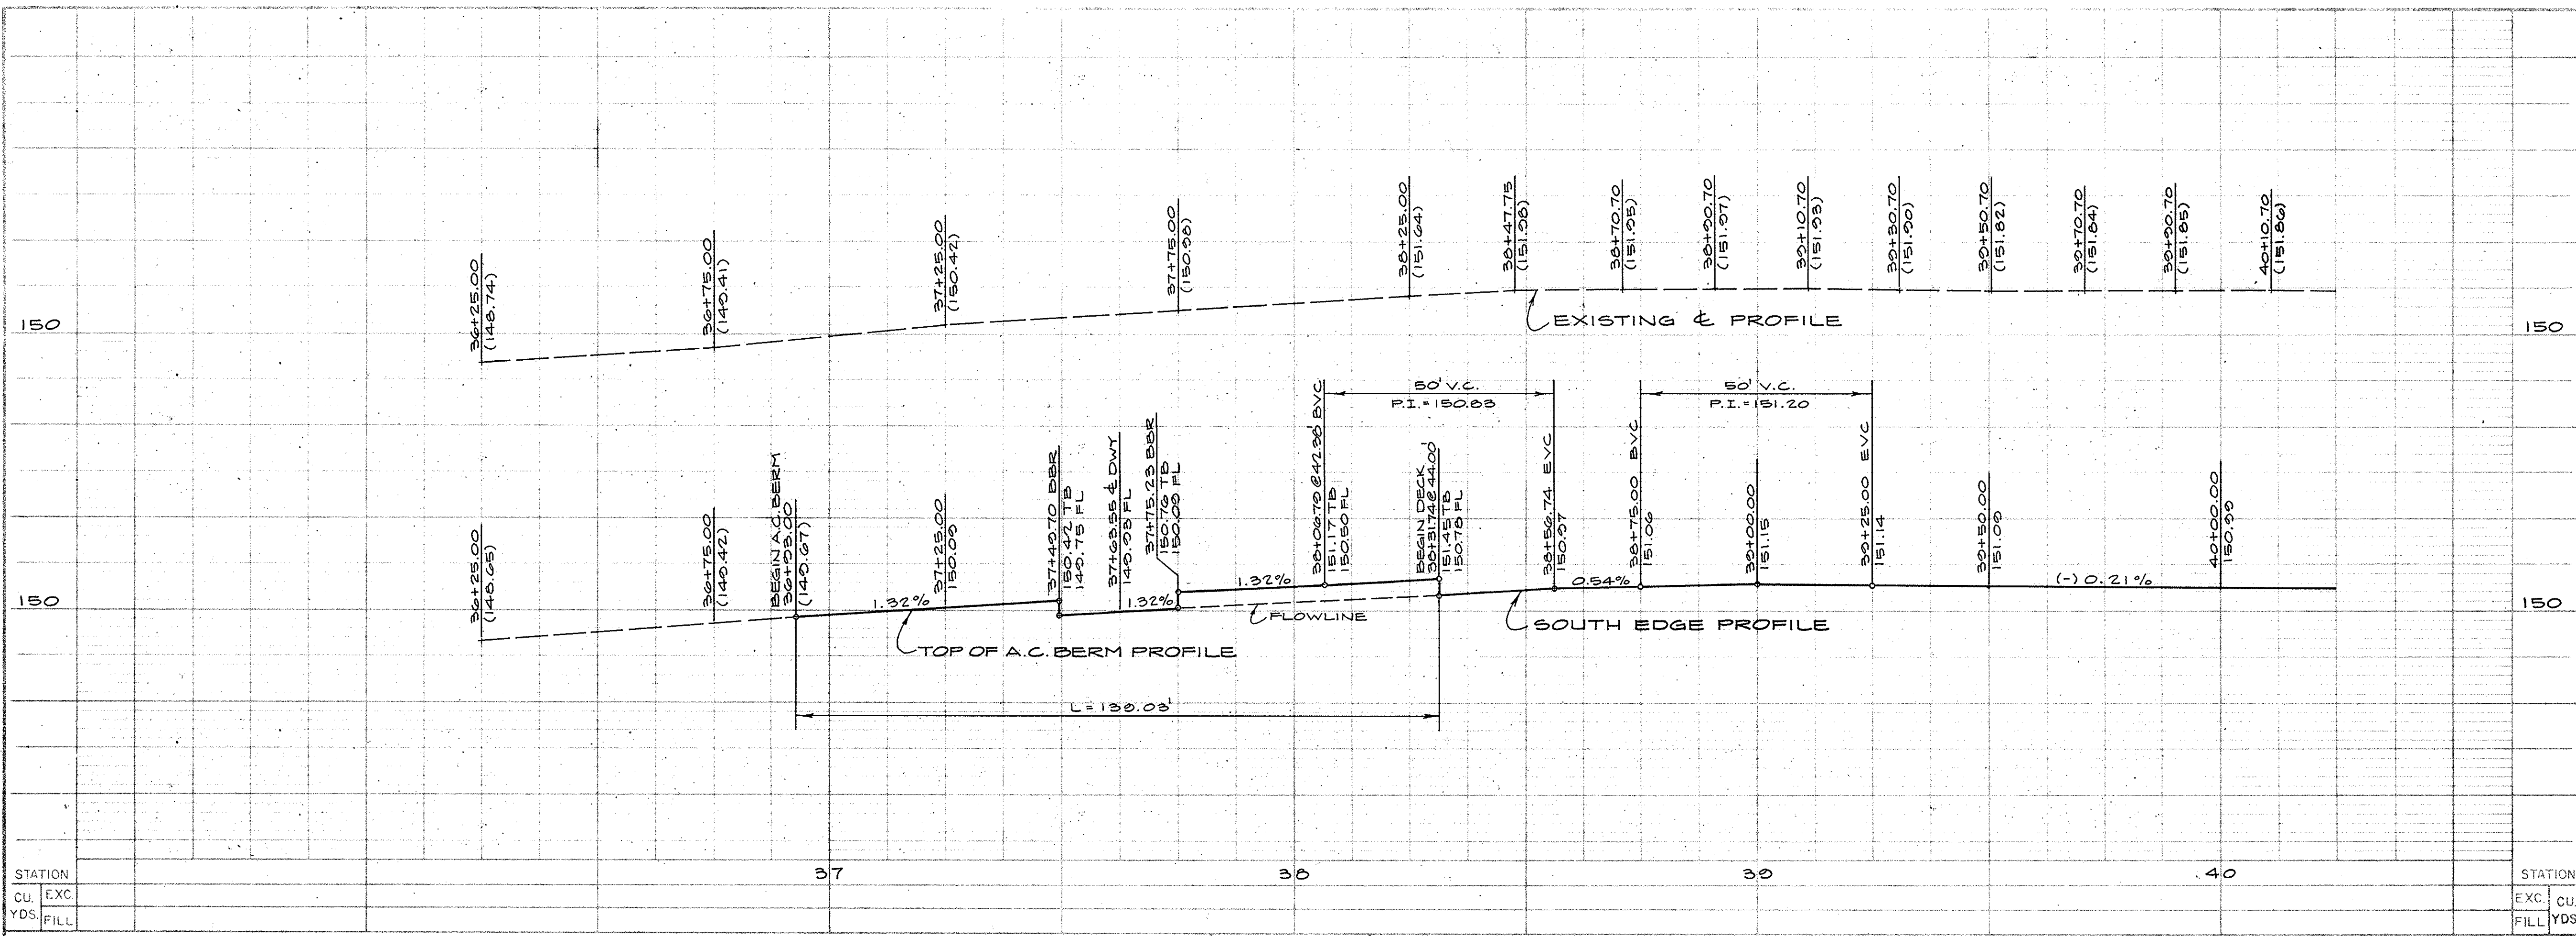

CONSTRUCTION NOTES

- ① CONSTRUCT 3" A.C. OVER 6" A.B. W/ PRIME COAT
- ② CONSTRUCT 3" A.C. DIKE PER EMA STD. PLAN 201
- ③ CONSTRUCT DRIVEWAY, 3" A.C. OVER NATIVE SOIL
- ④ TO BE RELOCATED TO NEW LOCATION AS SHOWN
- ⑤ TO BE SAWCUT AND REMOVED
- ⑥ PAINT TEMPORARY STRIPE
- ⑦ EXISTING IRRIGATION LINE TO PASS THROUGH WING WALL AS SHOWN IN DETAIL, SHEET No. 7
- ⑧ CONSTRUCT STEEL POST, METAL BEAM GUARD RAIL PER STD. PLAN AS SHOWN, PER TYPICAL SECTION ON SHT. 5, AND PER DETAILS ON SHT. 12
- ⑨ INSTALL TEMPORARY RAILING DURING CONSTRUCTION OPERATIONS PER STD. PLAN AS SHOWN
- ⑩ CLEAR AND GRADE EXIST. SOIL AND CONSTRUCT 3" A.C. SIDEWALK OVER COMPACTED EARTH TO LIMITS SHOWN. JOIN PAVEMENT FLUSH WITH EXIST. IMPROVEMENTS.
- ⑪ CONSTRUCT WOOD POST, METAL BEAM GUARD RAIL OUTSIDE LIMITS OF CONCRETE BRIDGE DECK AS SHOWN AND PER STD. PLAN AS SHOWN.

1 1/2 0 1 2
3 inches on original drawing

AS BUILT		ORANGE COUNTY ENVIRONMENTAL MANAGEMENT AGENCY	
		ORANGEWOOD AVE. BRIDGE	
		STREET PLAN & PROFILE	
MARK	DATE	DESCRIPTION	PREPARED UNDER SUPERVISION OF <i>[Signature]</i> SHEET
REVISIONS			DATE
DESIGNED	Z.P.	SCALE	DATE
DRAWN	D.C.H.	CHECKED	M.E.S.
		AS SHOWN	DWG. NO.
			2