



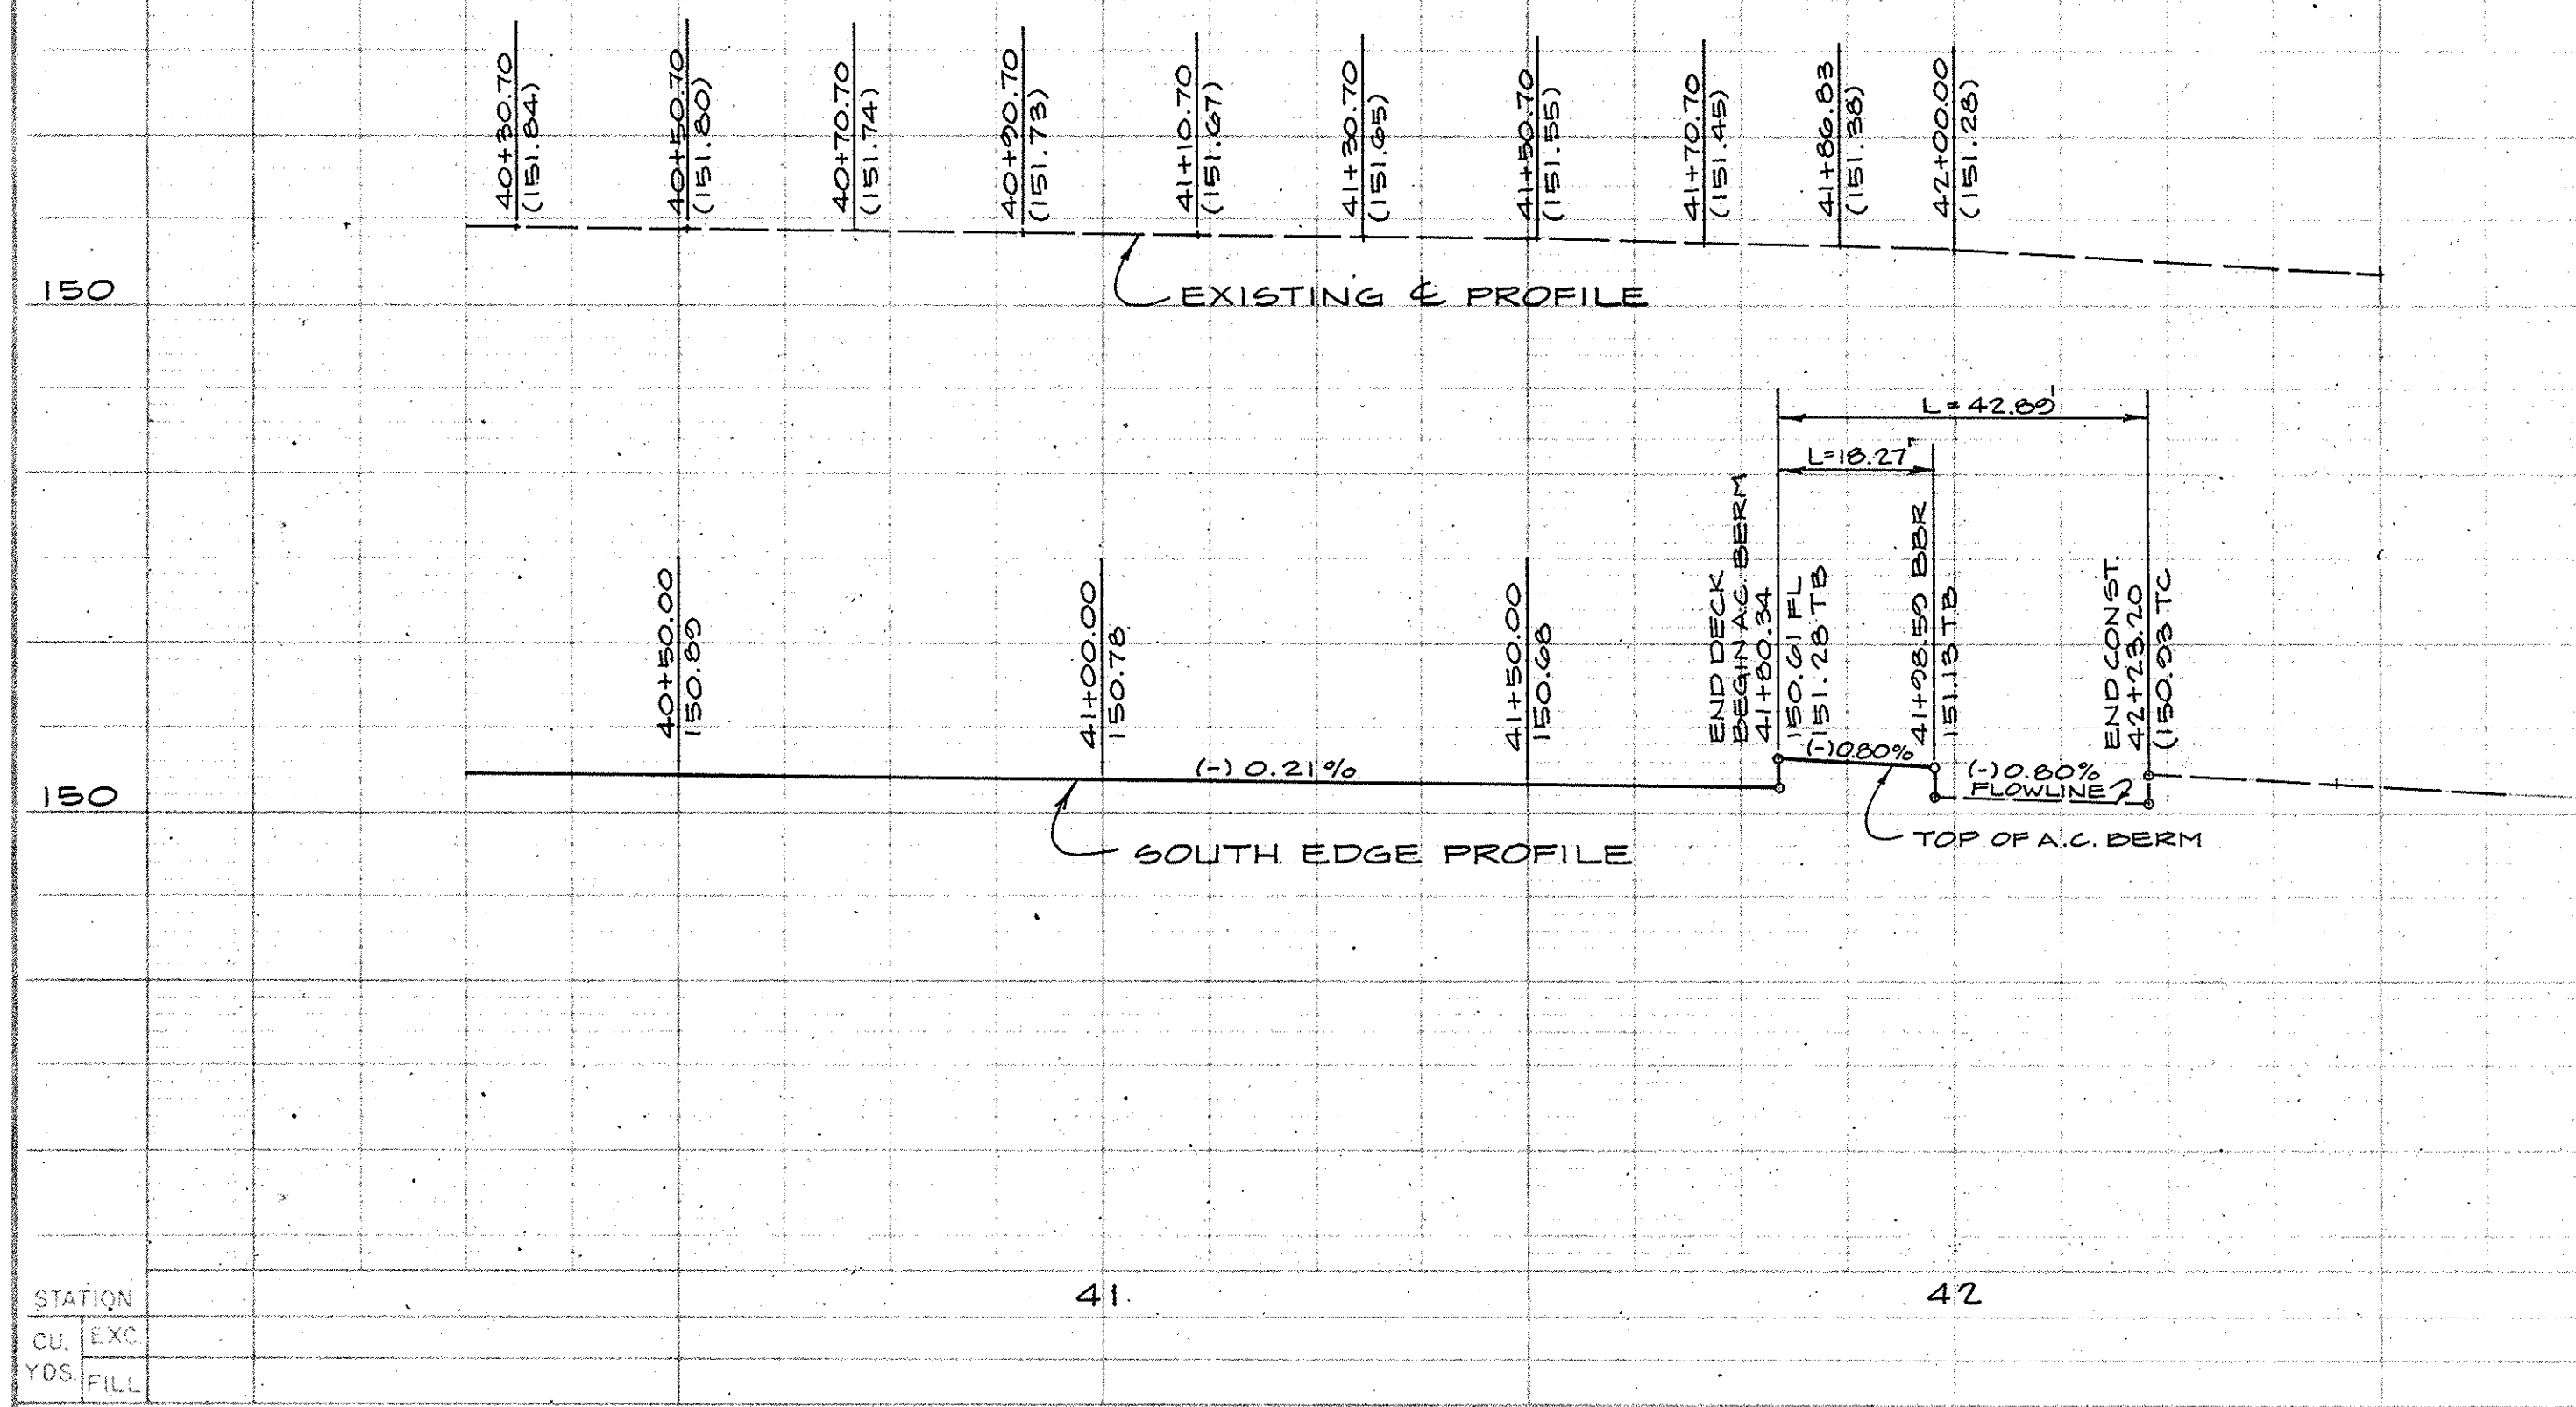


STATION	40	41	42
CU.			
EXC.			
YDS.			
FILL			

STATION	40	41	42
EXC.			
CU.			
FILL			
YDS.			

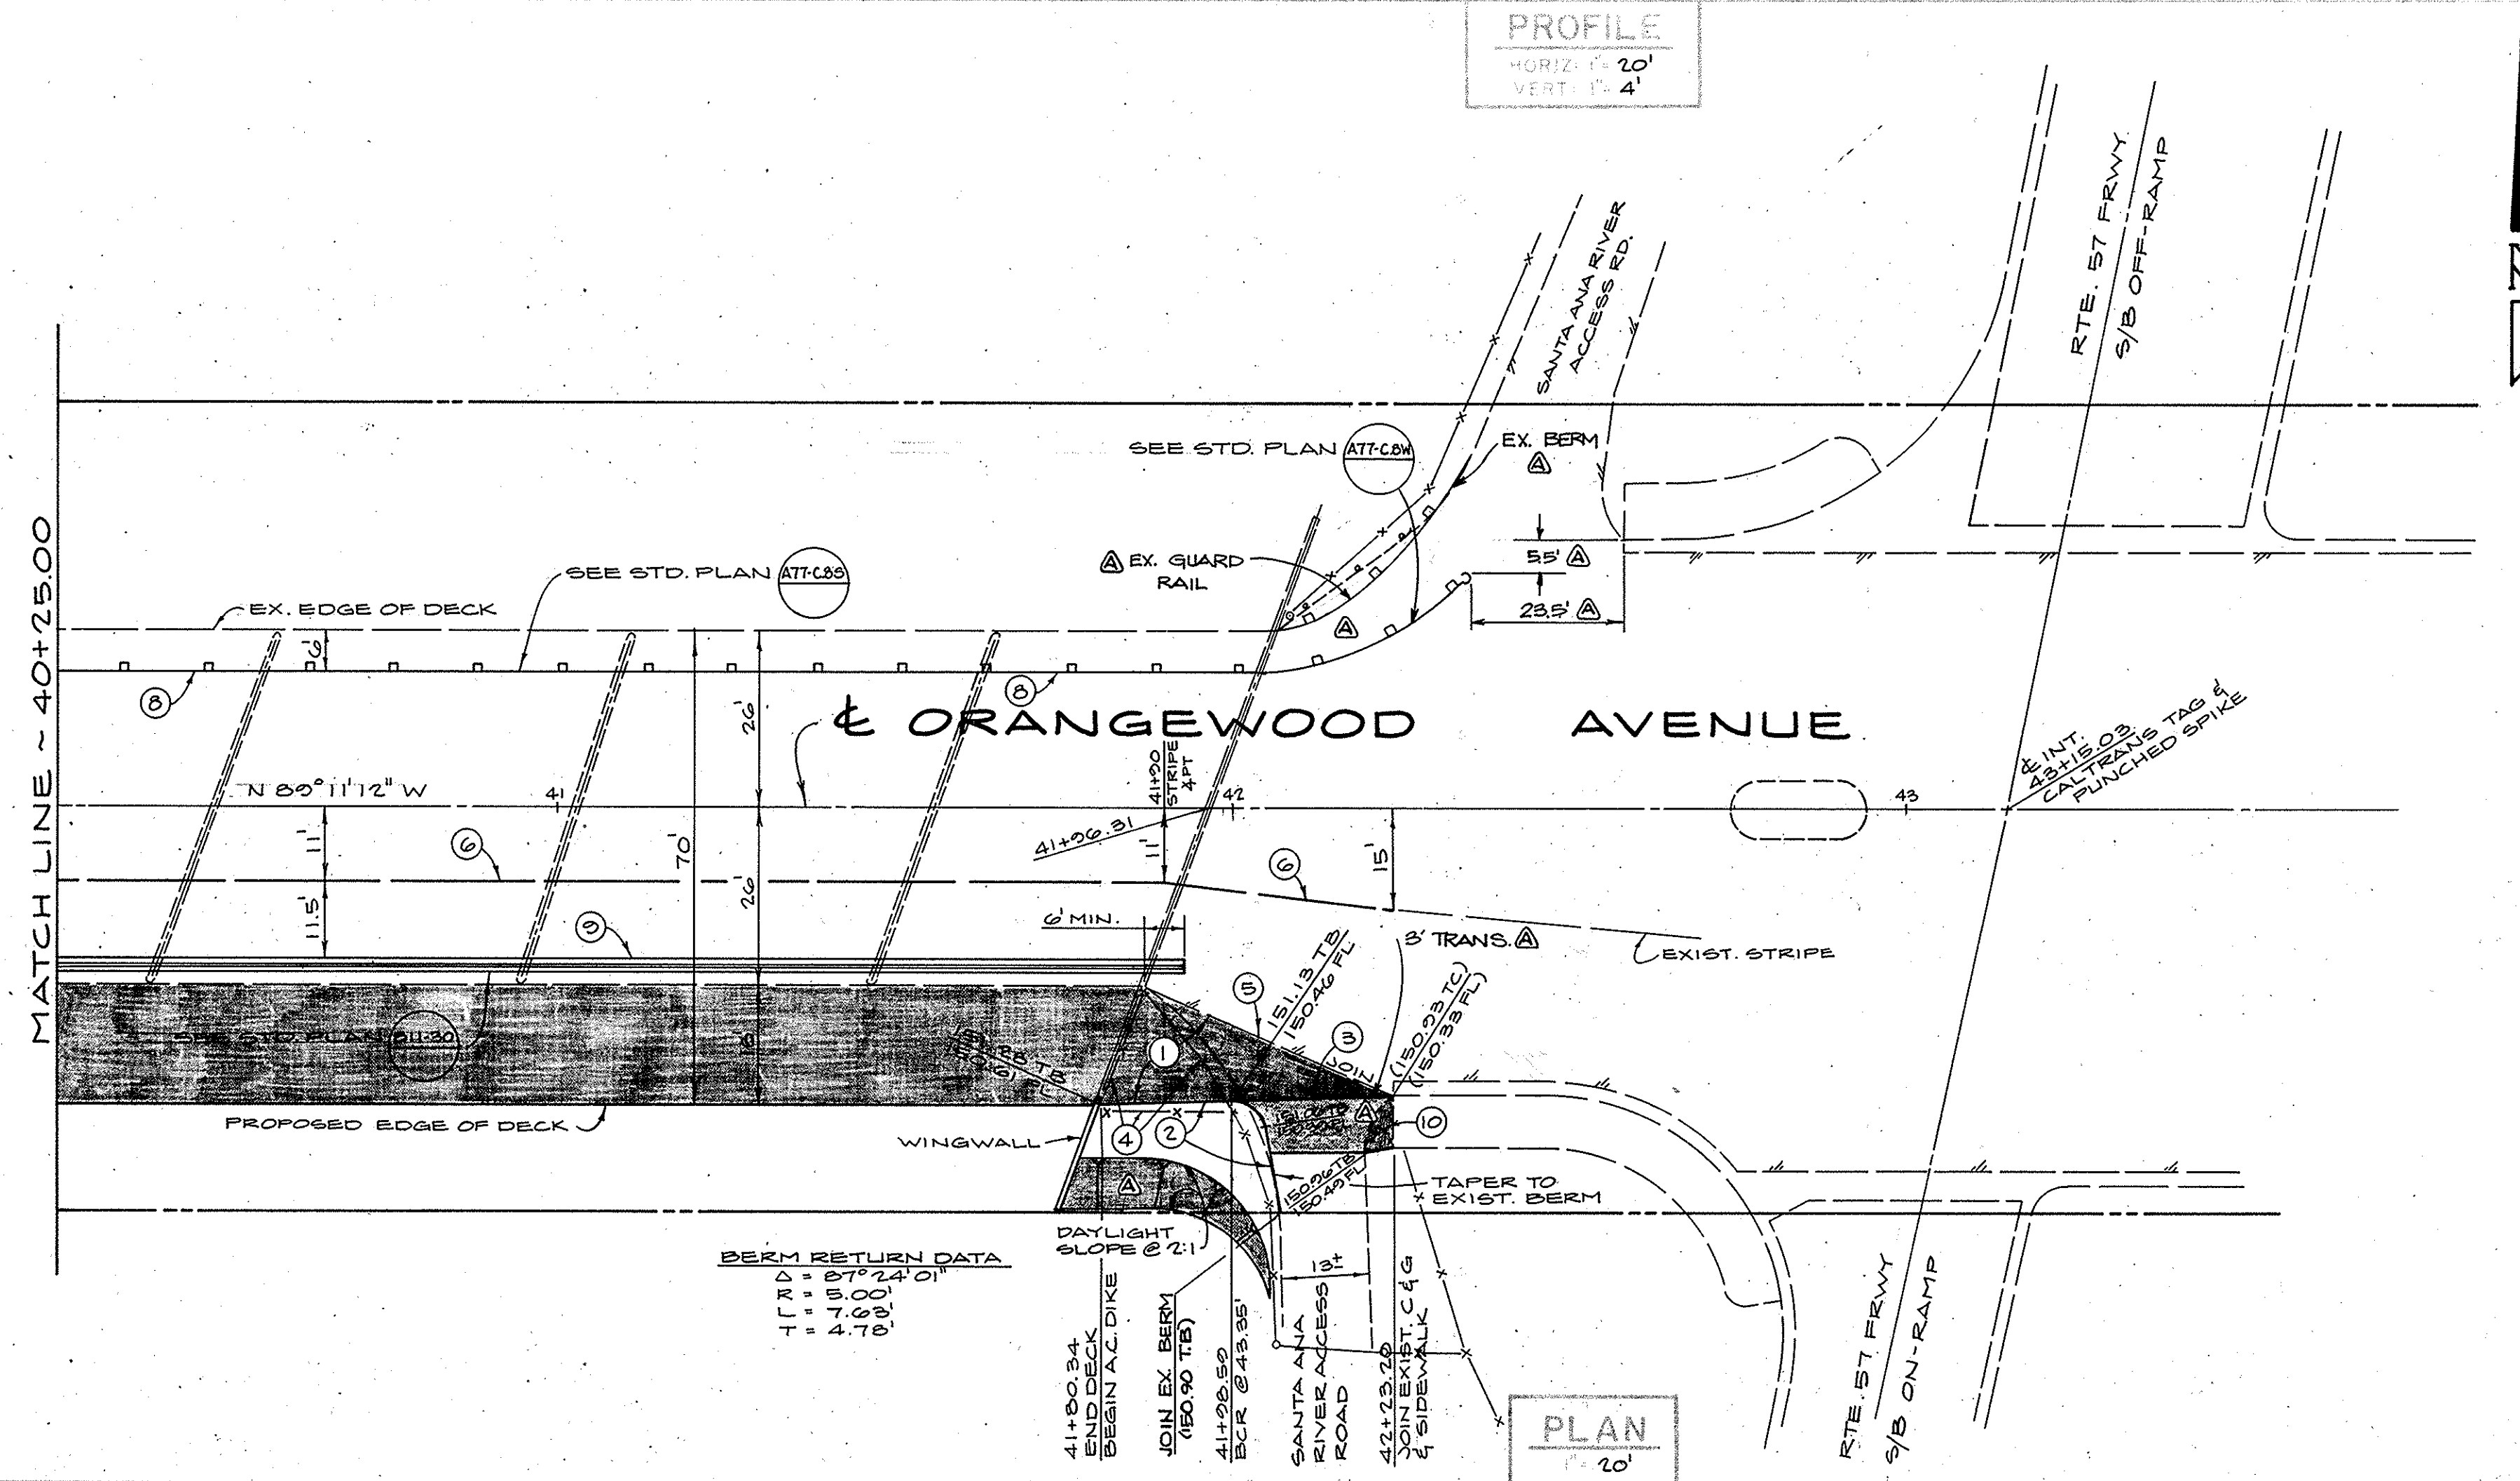

- CONSTRUCTION NOTES**
1. CONSTRUCT 3' A.C. OVER 6" A.B. W/ PRIME COAT
 2. CONSTRUCT 6' A.C. DIKE PER EMA STD. PLAN 201
 3. CONSTRUCT DRIVEWAY, 3' A.C. OVER NATIVE SOIL
 4. TO BE RELOCATED TO NEW LOCATION AS SHOWN
 5. TO BE SAWCUT AND REMOVED
 6. PAINT TEMPORARY STRIPE
 7. RELOCATE INTERFERING PORTIONS OF EXIST. IRRIGATION LINE TO NEW LOCATION AS SHOWN
 8. CONSTRUCT STEEL POST, METAL BEAM GUARD RAIL PER STD. PLAN AS SHOWN, PER TYPICAL SECTION ON SHT. 5, AND PER DETAILS ON SHT. 12
 9. INSTALL TEMPORARY RAILING DURING CONSTRUCTION OPERATIONS PER STD. PLAN AS SHOWN
 10. CLEAR AND GRADE EXIST. SOIL AND CONSTRUCT 3' A.C. SIDEWALK OVER COMPACTED EARTH TO LIMITS SHOWN. JOIN PAVEMENT FLUSH WITH EXIST. IMPROVEMENTS.
 11. CONSTRUCT WOOD POST METAL BEAM GUARD RAIL OUTSIDE LIMITS OF CONCRETE BRIDGE DECK AS SHOWN AND PER STD. PLAN AS SHOWN.

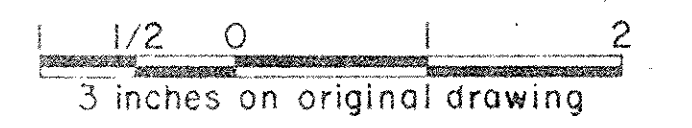

4-81 AS BUILT		ORANGE COUNTY ENVIRONMENTAL MANAGEMENT AGENCY	
		ORANGEWOOD AVE. BRIDGE	
		STREET PLAN & PROFILE	
MARK	DATE	DESCRIPTION	PREPARED UNDER SUPERVISION OF <i>John P. [Signature]</i> 6-18-80
REVISIONS		SCALE	DATE
DESIGNED	Z.P.	AS SHOWN	DWG. NO.
DRAWN	D.C.H.	CHECKED	M.B.S.
			SHEET 3