
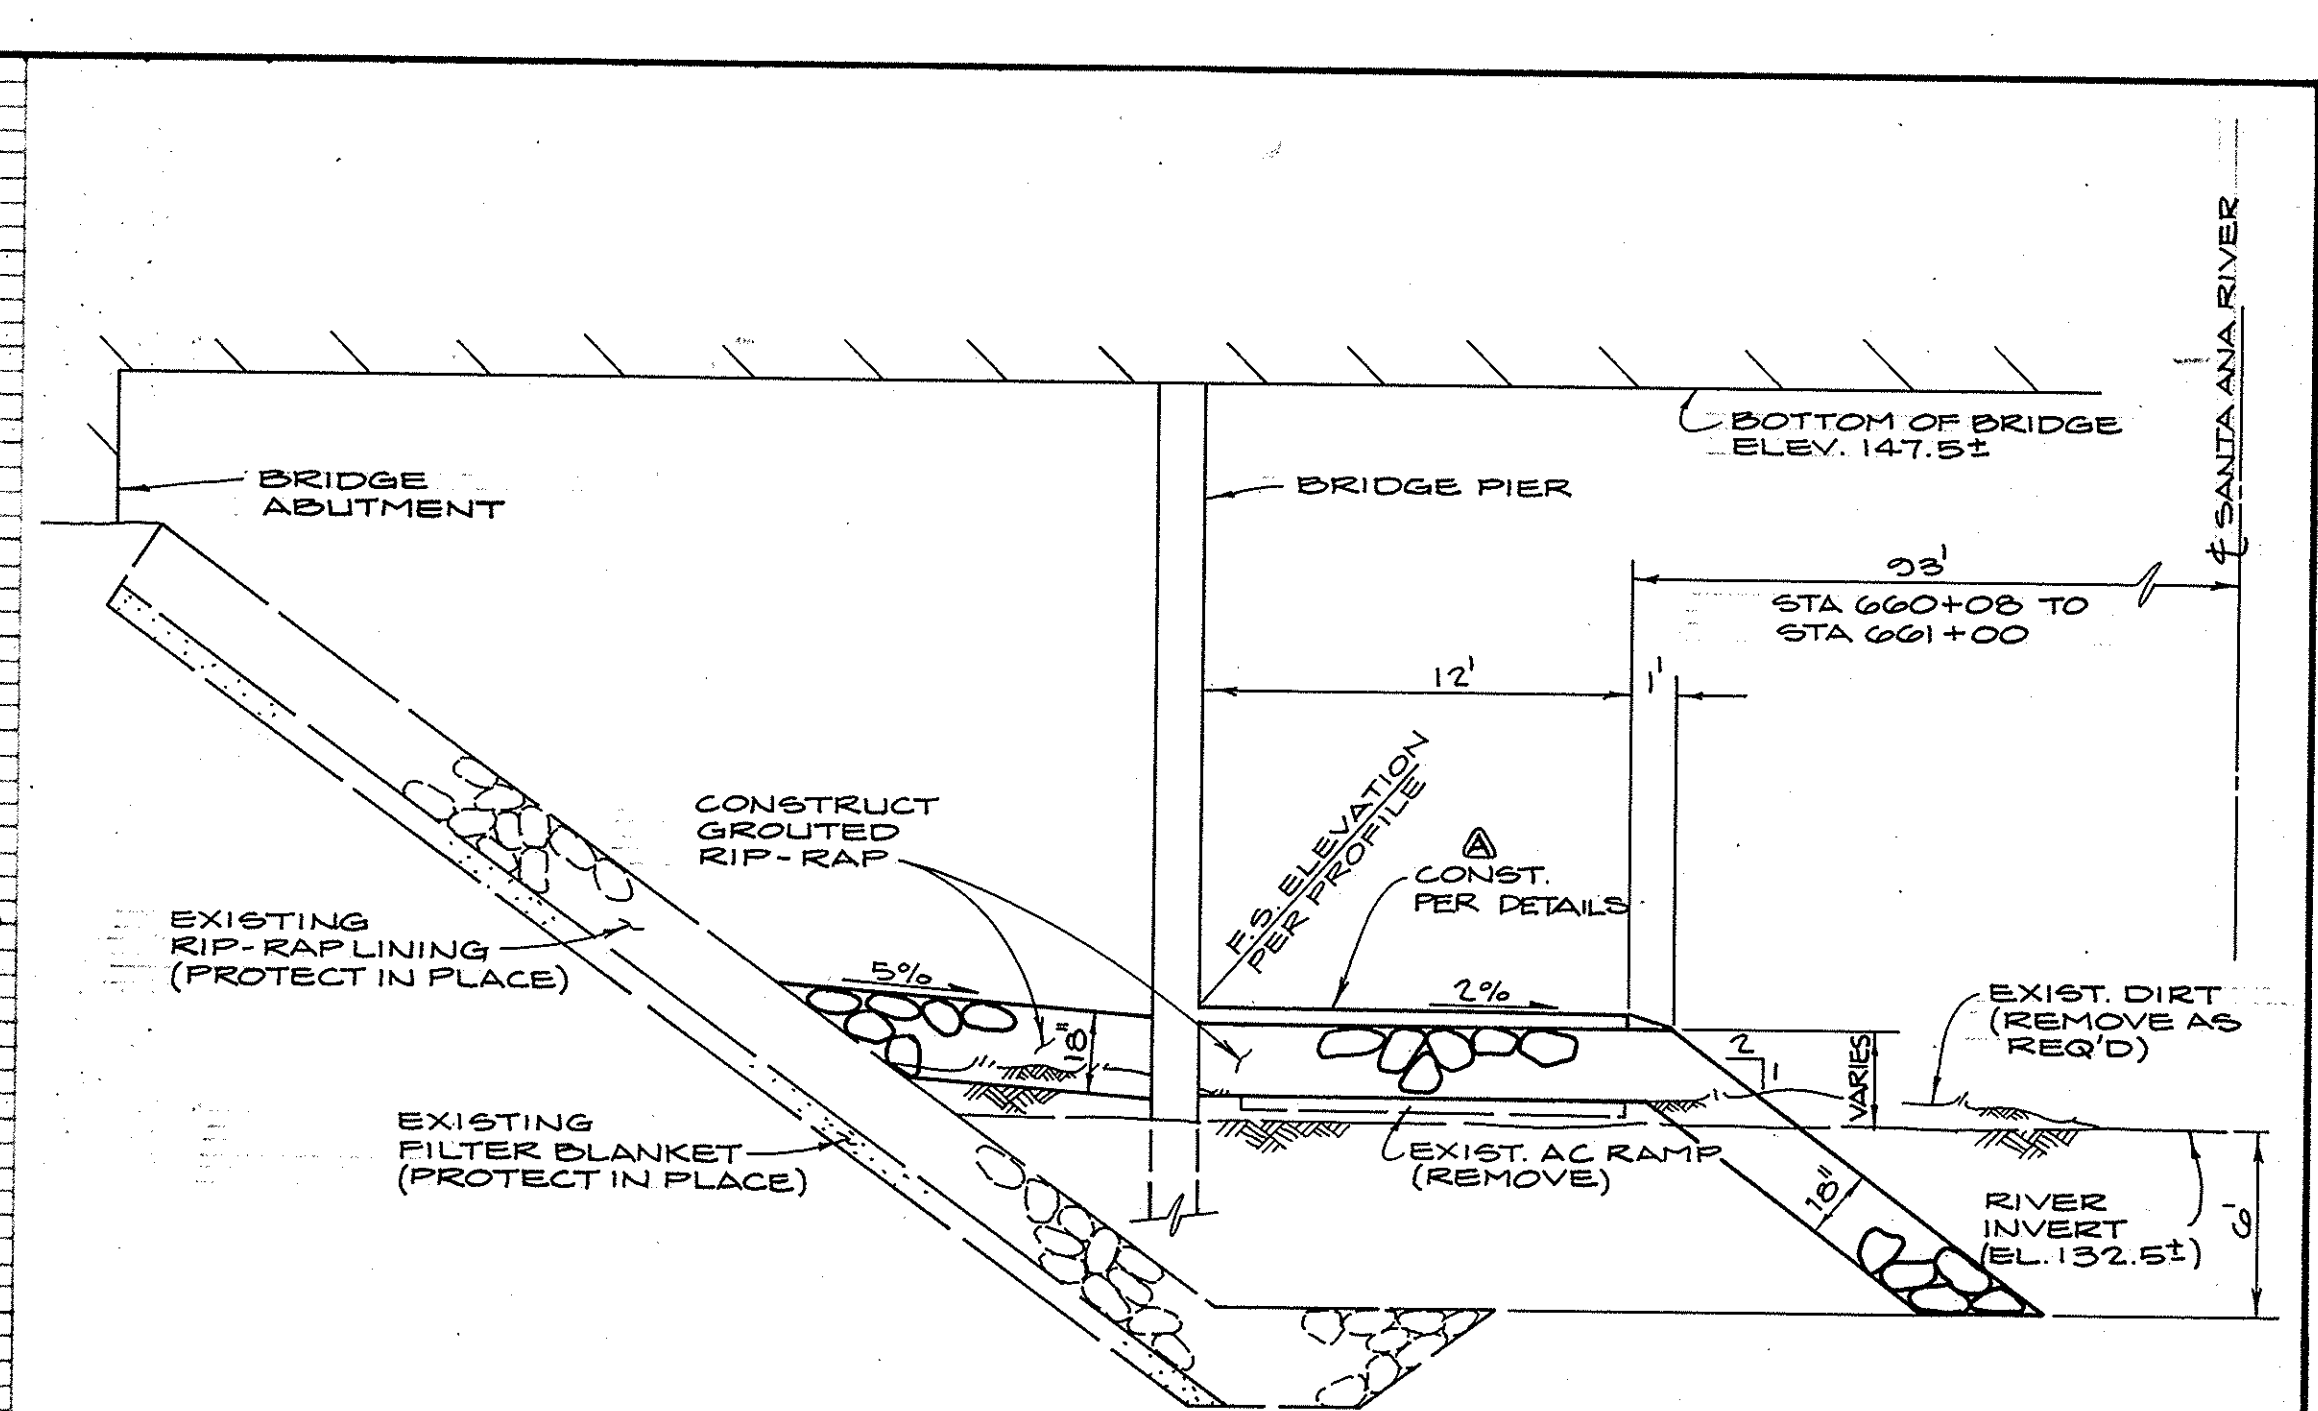



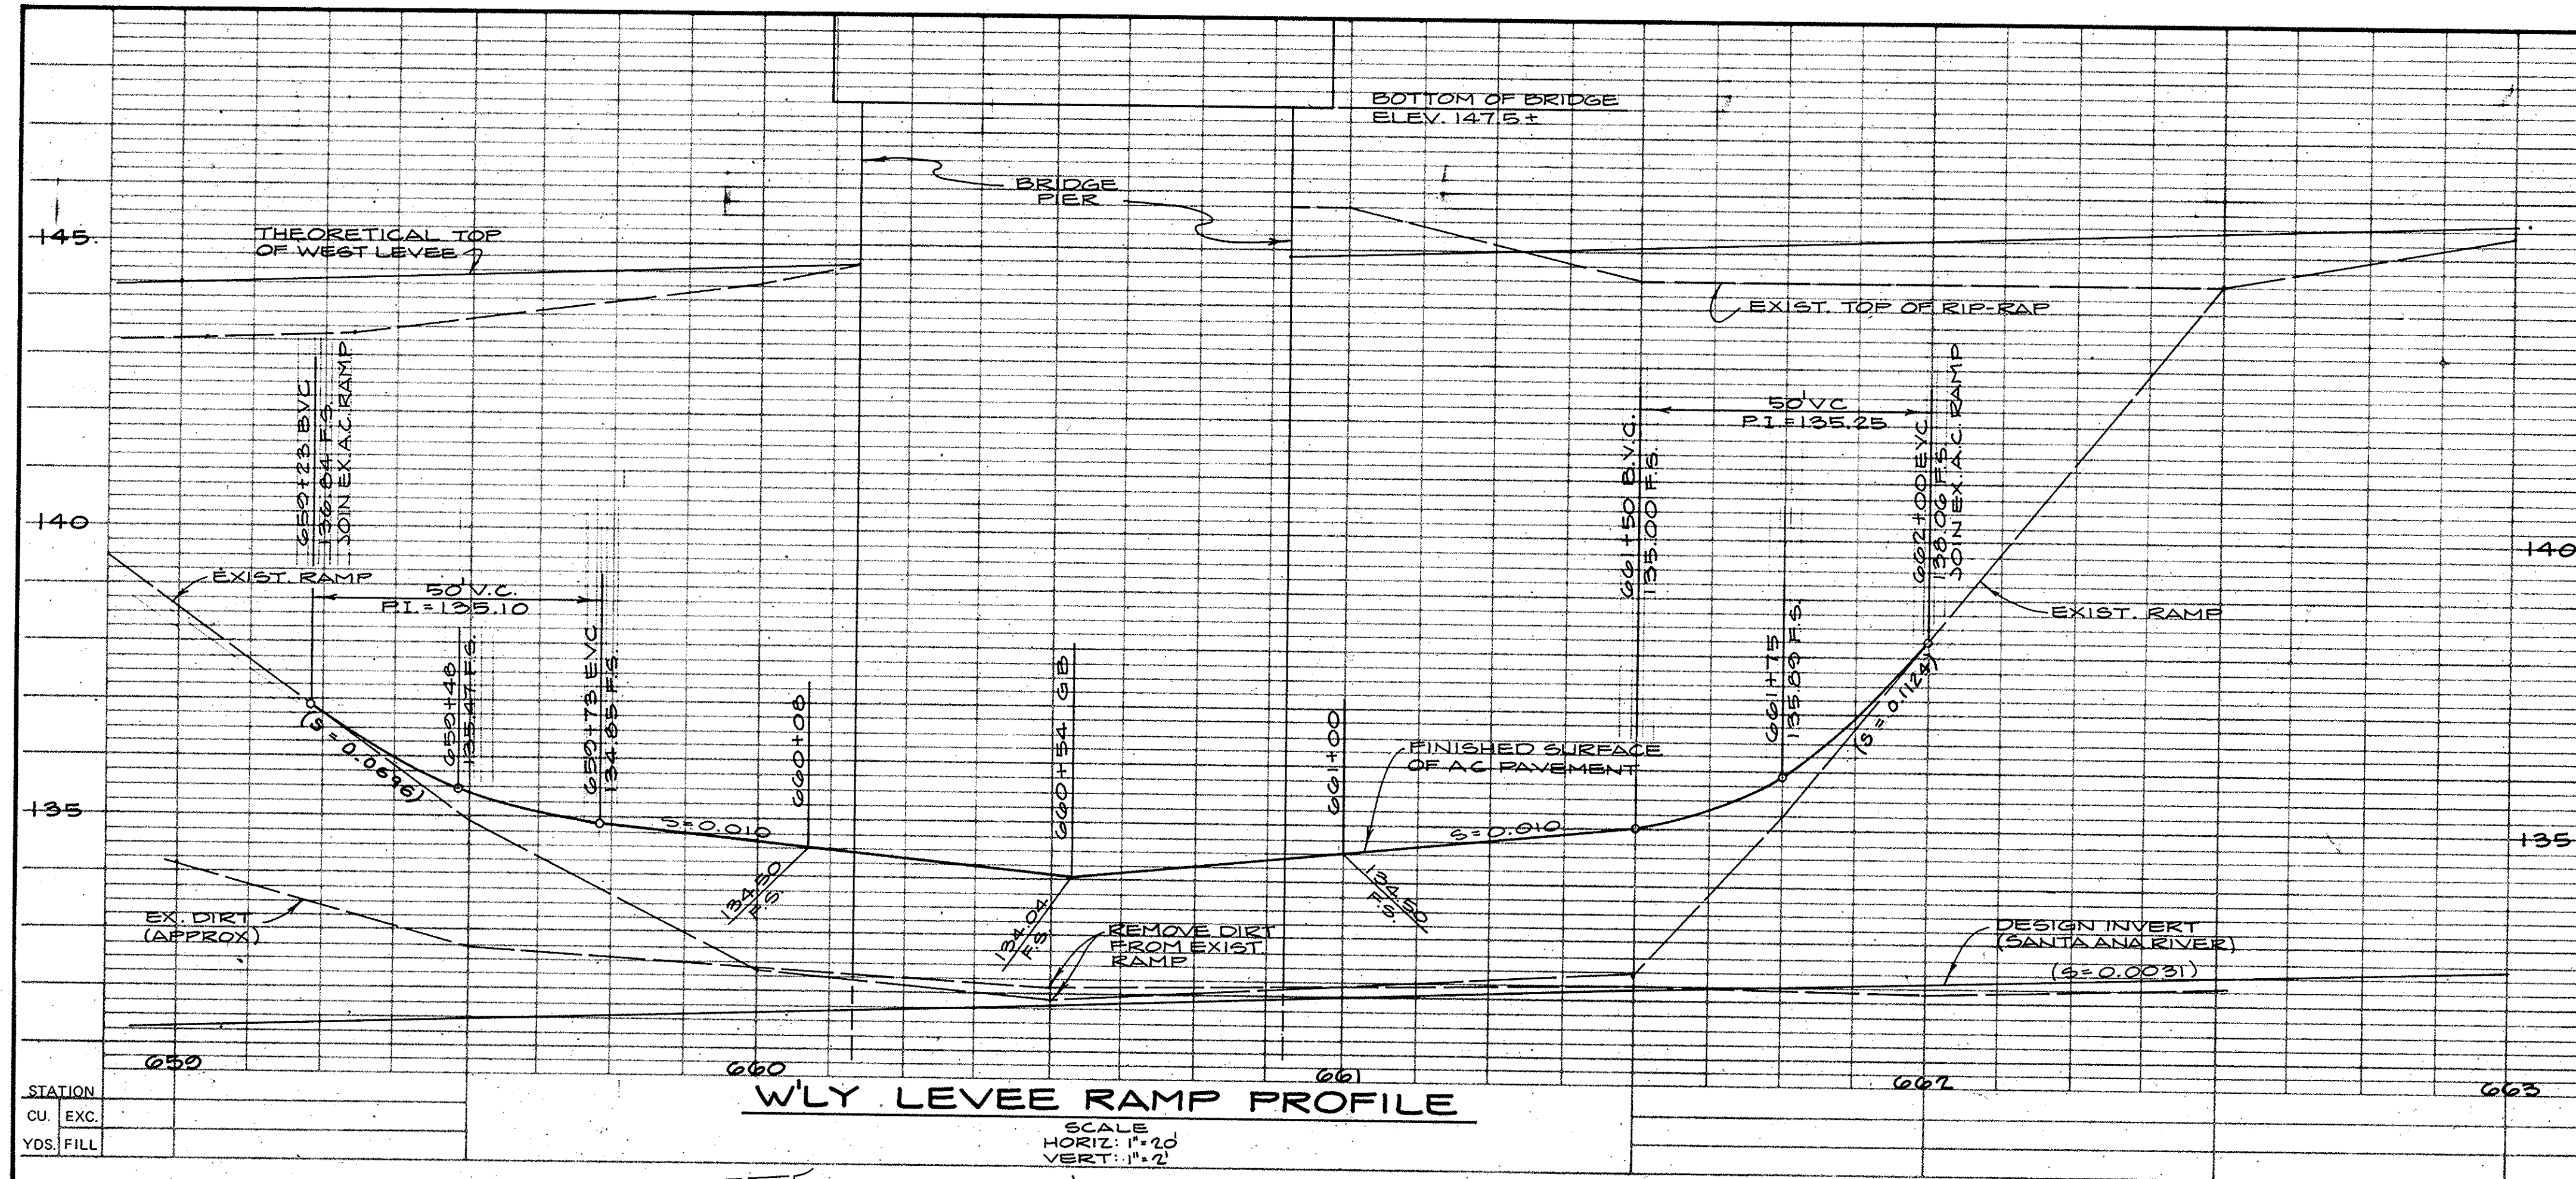


TYP. BIKE TRAIL RAMP SECTION
NOT TO SCALE

BIKE TRAIL RAMP QUANTITIES (APPROX.)

A.C. PAVEMENT - A.C. TO P.C. GROUT JOINS	7 TONS
CONCRETE ROCK SLOPE PROTECTION (RIP-RAP)	705 C.Y.
4' X 4' X No. 6 STEEL WIRE MESH	3795 S.F.

- CONSTRUCTION NOTES**
- REMOVE EXISTING A.C. PAVEMENT AS REQUIRED AND CONSTRUCT 6" P.C. GROUT RAMP PAVEMENT OVER GROUTED RIP-RAP PER PLAN, PROFILE, SECTION, AND DETAILS HEREON.
 - REMOVE INTERFERING PORTIONS OF EXISTING DIRT AND/OR RIP-RAP AND CONSTRUCT GROUTED RIP-RAP LEVEE RAMP PER PLAN, PROFILE, AND SECTION HEREON.
 - PROTECT EXISTING BRIDGE PIER.

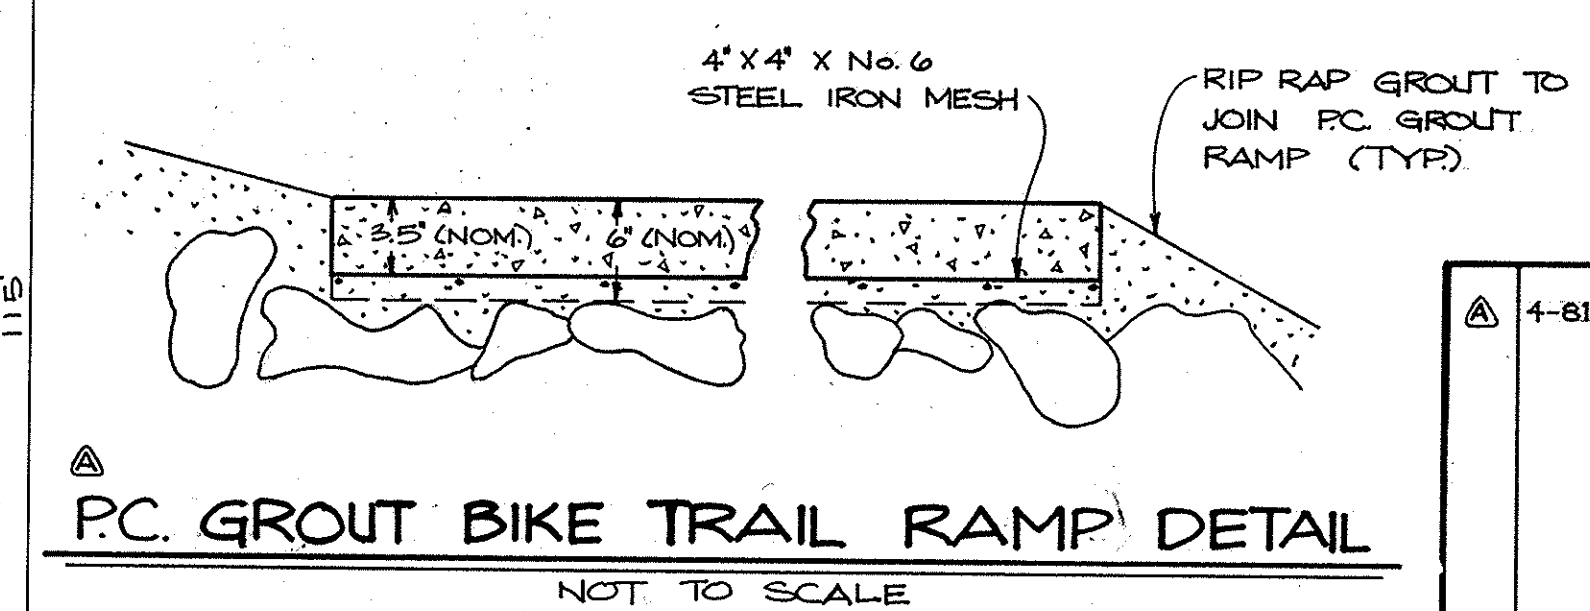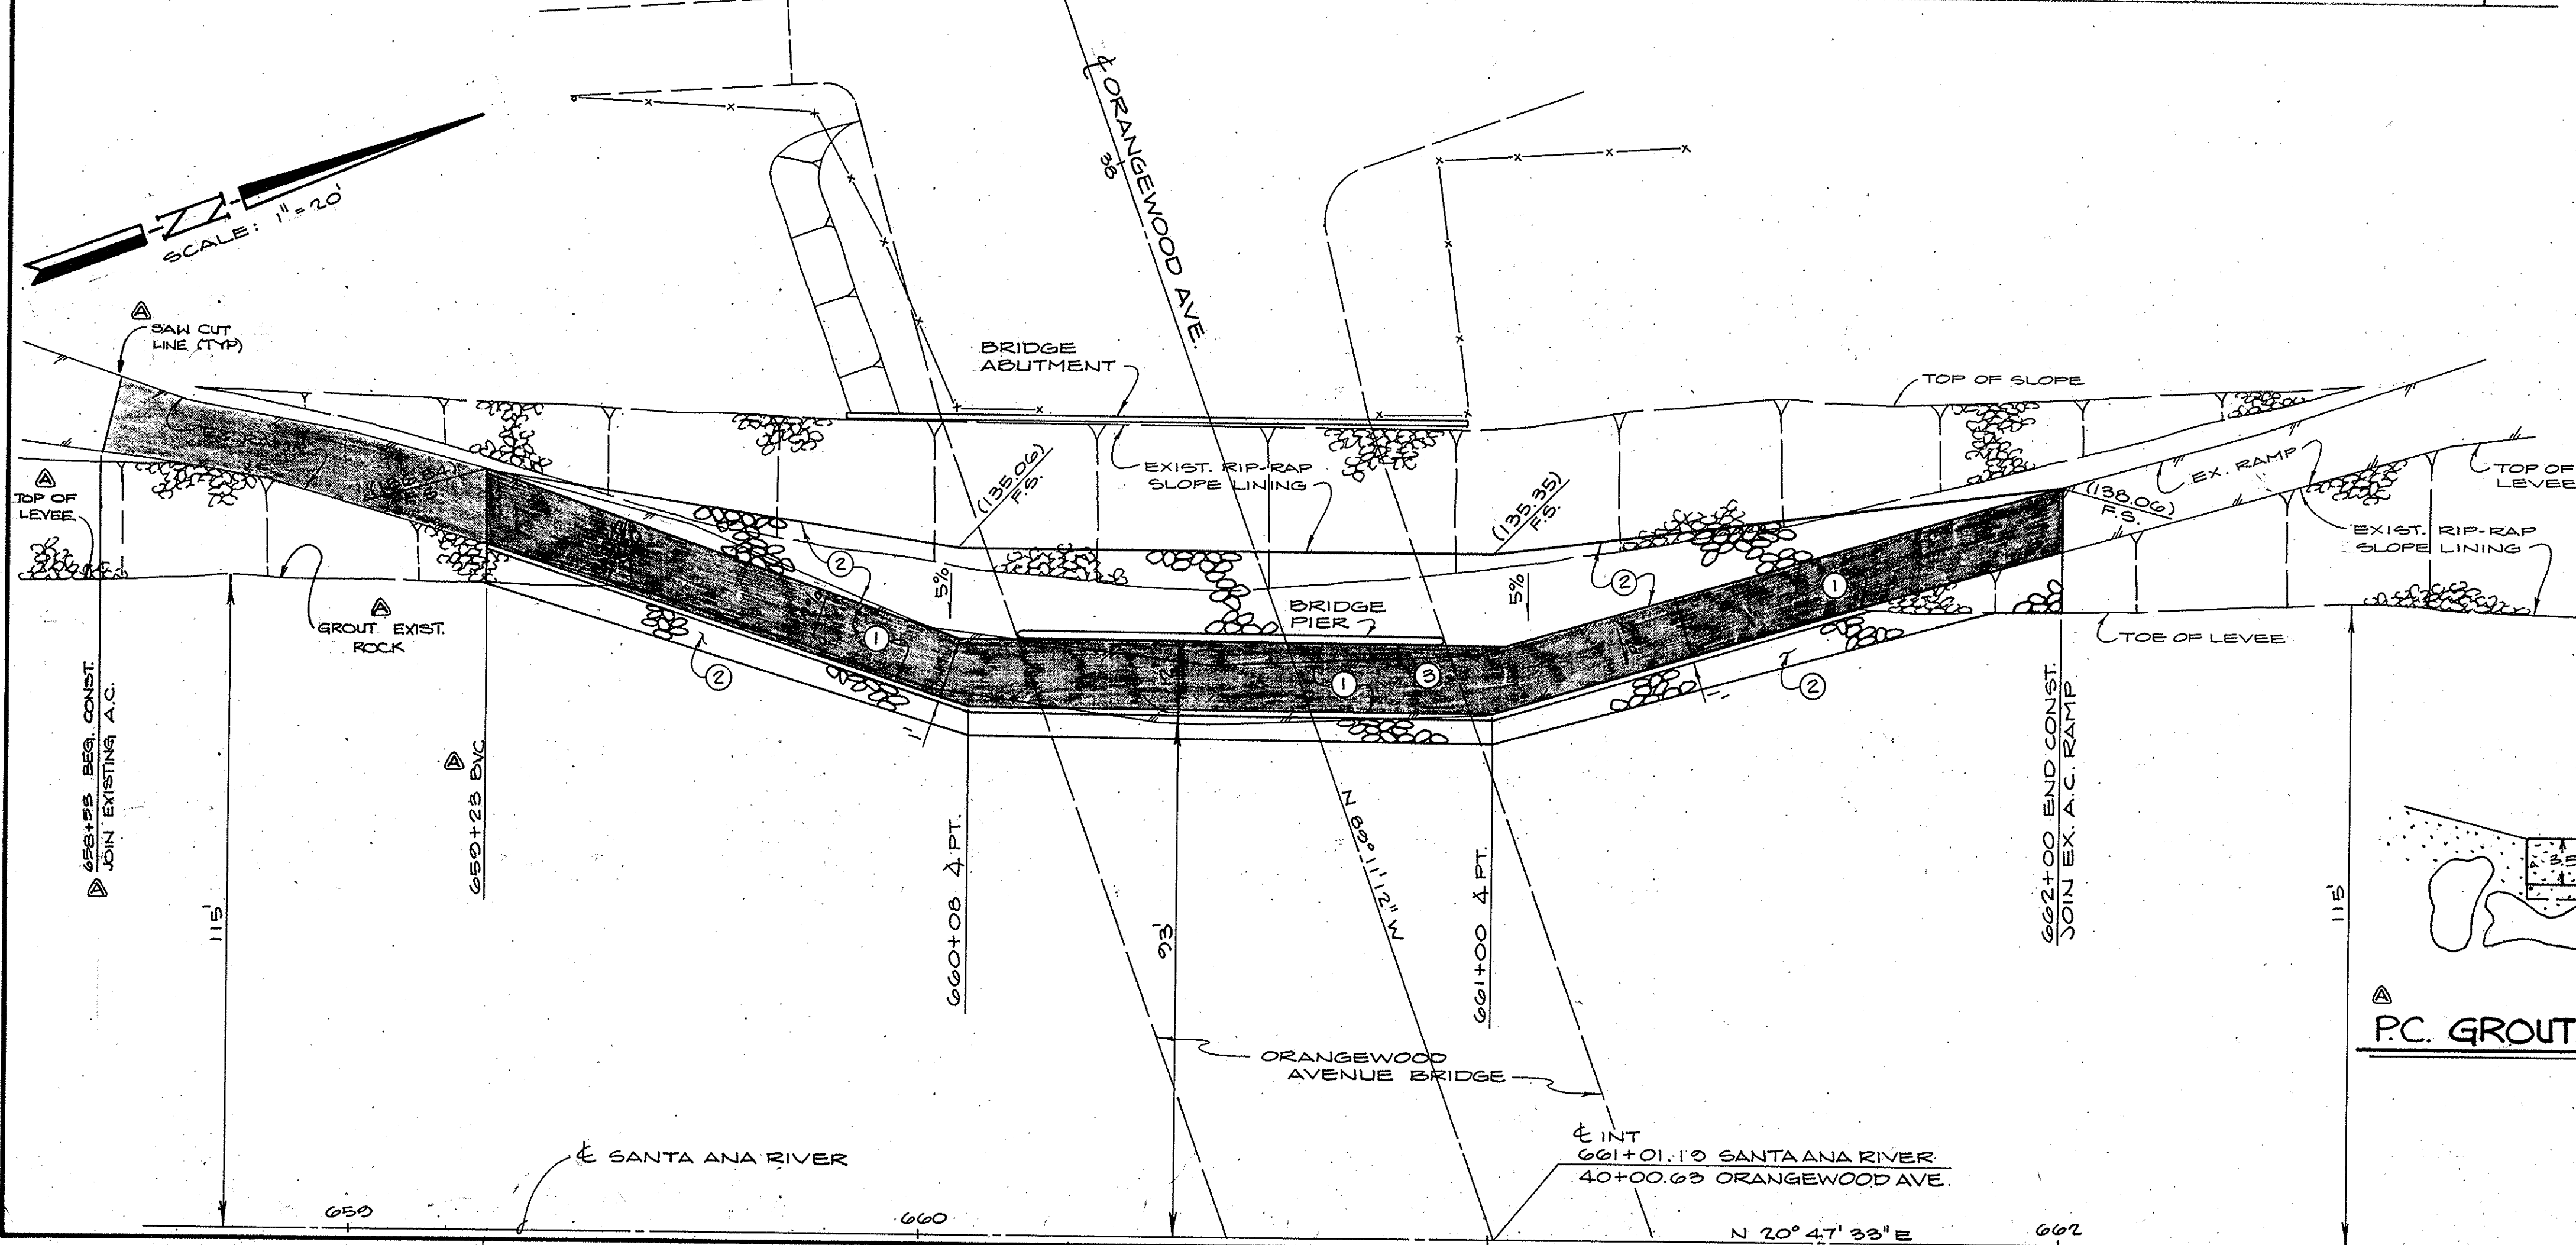

1 1/2 0 1 2
3 inches on original drawing

4-SI. AS BUILT		ORANGE COUNTY ENVIRONMENTAL MANAGEMENT AGENCY	
		ORANGEWOOD AVE. BRIDGE	
		BIKE TRAIL PLAN & PROFILE	
MARK	DATE	DESCRIPTION	PREPARED UNDER SUPERVISION OF
DESIGNED		REVISIONS	DATE
DRAWN		SCALE	DWG. NO.
		AS SHOWN	