


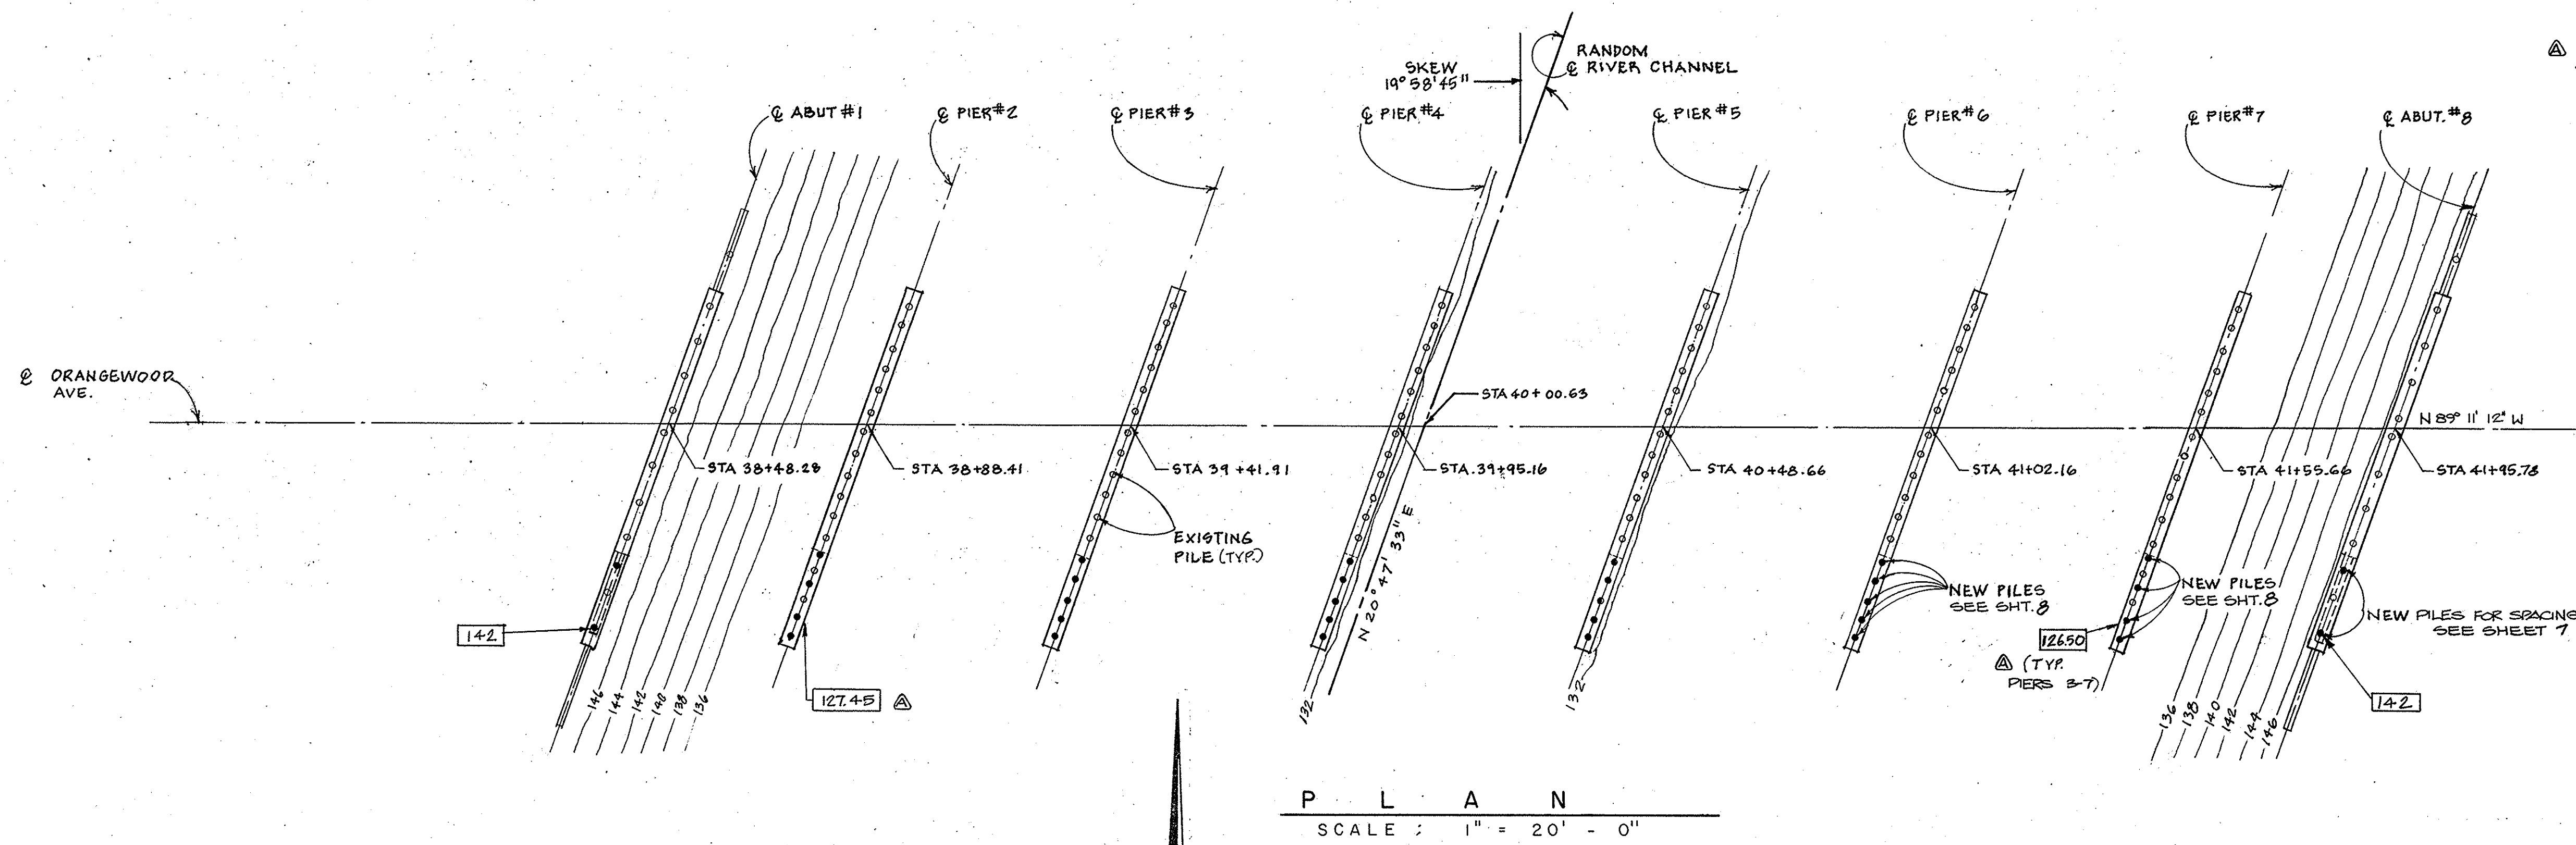

△ PILE DATA (AS BUILT)



PILE NUMBER	CUT OFF ELEV.	TIP ELEV.	PAY LENGTH	PILE NUMBER	CUT OFF ELEV.	TIP ELEV.	PAY LENGTH
ABUT. NO. 1	142.58	101.23	41.25'	1	126.90	105.15	21.75'
	EXISTING			2	126.89	106.56	20.33'
PIER NO. 1	142.50	106.92	35.58'	3	126.95	105.20	21.75'
	EXISTING			4	127.09	105.27	21.72'
PIER NO. 2	128.27	109.62	18.75'	5	127.06	105.31	21.75'
	EXISTING			1	126.98	106.40	20.58'
PIER NO. 3	128.00	108.00	25.75'	2	127.03	105.28	21.75'
	EXISTING			3	127.07	105.32	21.75'
PIER NO. 4	128.24	108.24	25.75'	4	126.90	105.25	21.65'
	EXISTING			5	126.91	105.16	21.75'
PIER NO. 5	128.50	106.55	21.75'	1	126.87	105.12	21.75'
	EXISTING			2	EXISTING		
PIER NO. 6	126.90	105.15	21.75'	3	126.86	105.11	21.75'
	EXISTING			4	EXISTING		
PIER NO. 7	126.95	105.20	18.75'	5	127.21	105.73	21.48'
	EXISTING			6	127.19	105.74	21.45'
PIER NO. 8	126.80	108.05	18.75'	1	142.58	107.33	35.25'
	EXISTING			2	EXISTING		
PIER NO. 9	126.92	110.58	16.24'	3	142.58	110.58	32.00'
	EXISTING						
PIER NO. 10	126.81	108.06	18.75'				
	EXISTING						
PIER NO. 11	127.23	102.00	25.23'				
	EXISTING						
PIER NO. 12	127.19	102.00	25.19'				
	EXISTING						
PIER NO. 13	127.15	102.00	25.15'				
	EXISTING						
PIER NO. 14	127.19	102.00	25.19'				
	EXISTING						
PIER NO. 15	127.21	102.00	25.21'				
	EXISTING						

△ PILING DATA

FOOTING	SPEC PILE TIP ELEV.	ELEV. PILE CUT OFF
ABUT. 1	100	142.25
PIER 2	108	126.75
PIER 3	108	"
PIER 4	105	"
PIER 5	105	"
PIER 6	105	"
PIER 7	105	126.75
ABUT. 8	105	142.25

△ CONSTRUCTION NOTES

- DRIVEN FALSEWORK PILING SHALL BE REQUIRED WHEN INTERMEDIATE FALSEWORK BENTS ARE USED BETWEEN PIER WALLS AS SPECIFIED PER SPECIAL PROVISIONS.
- BRIDGE PILE BEARING CAPACITY = 15 TONS.
- DENOTES BOTTOM OF FOOTING ELEVATION.

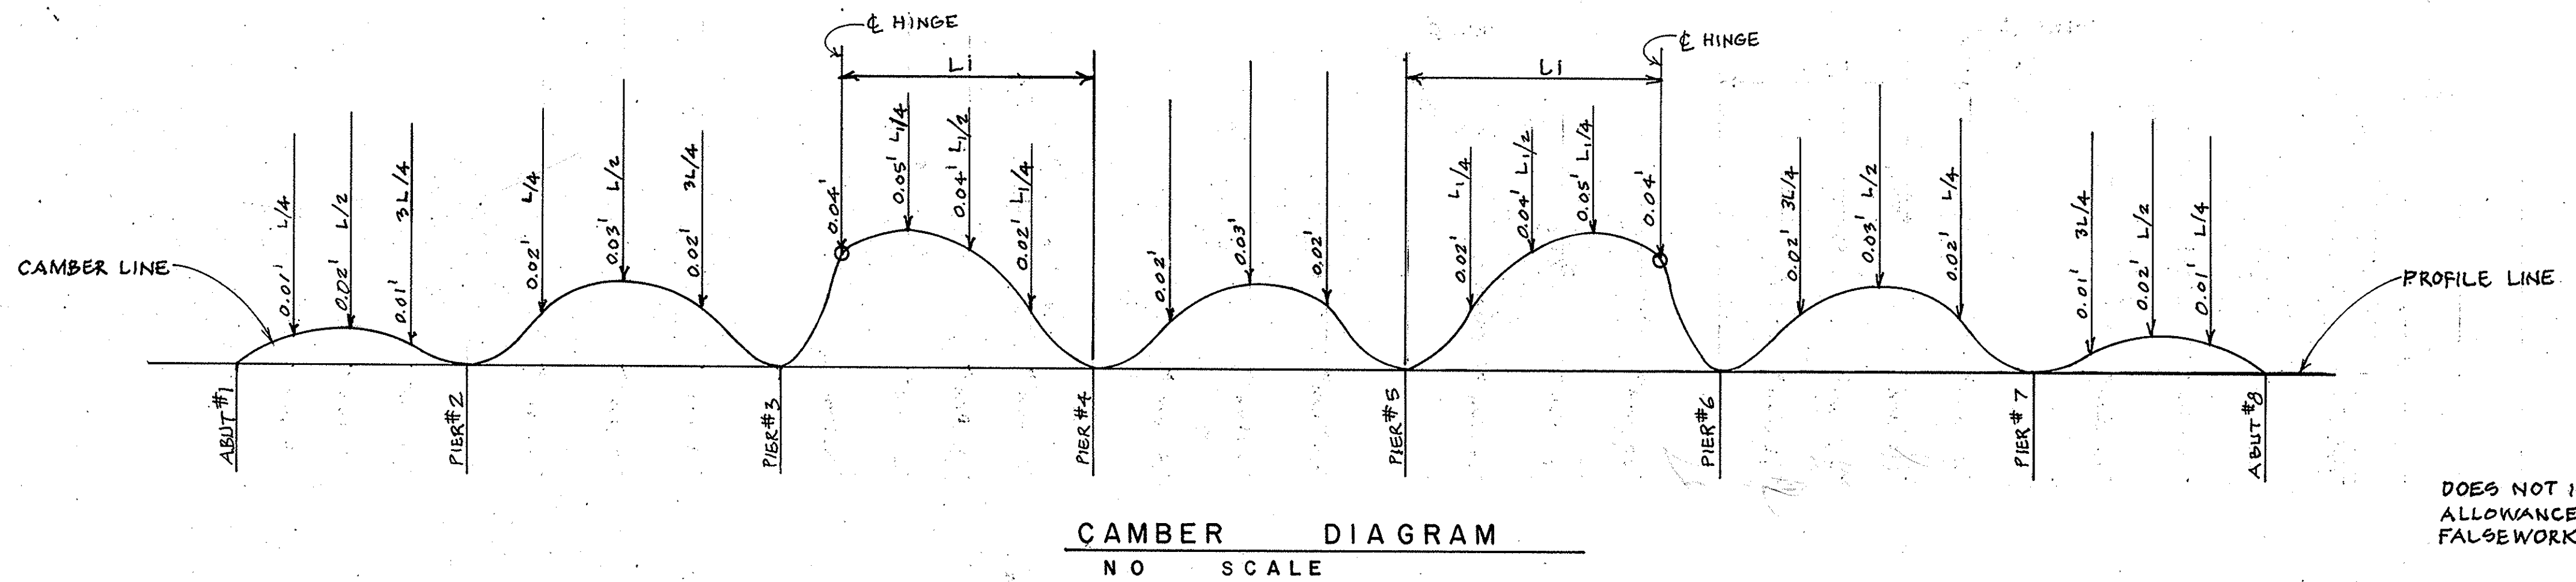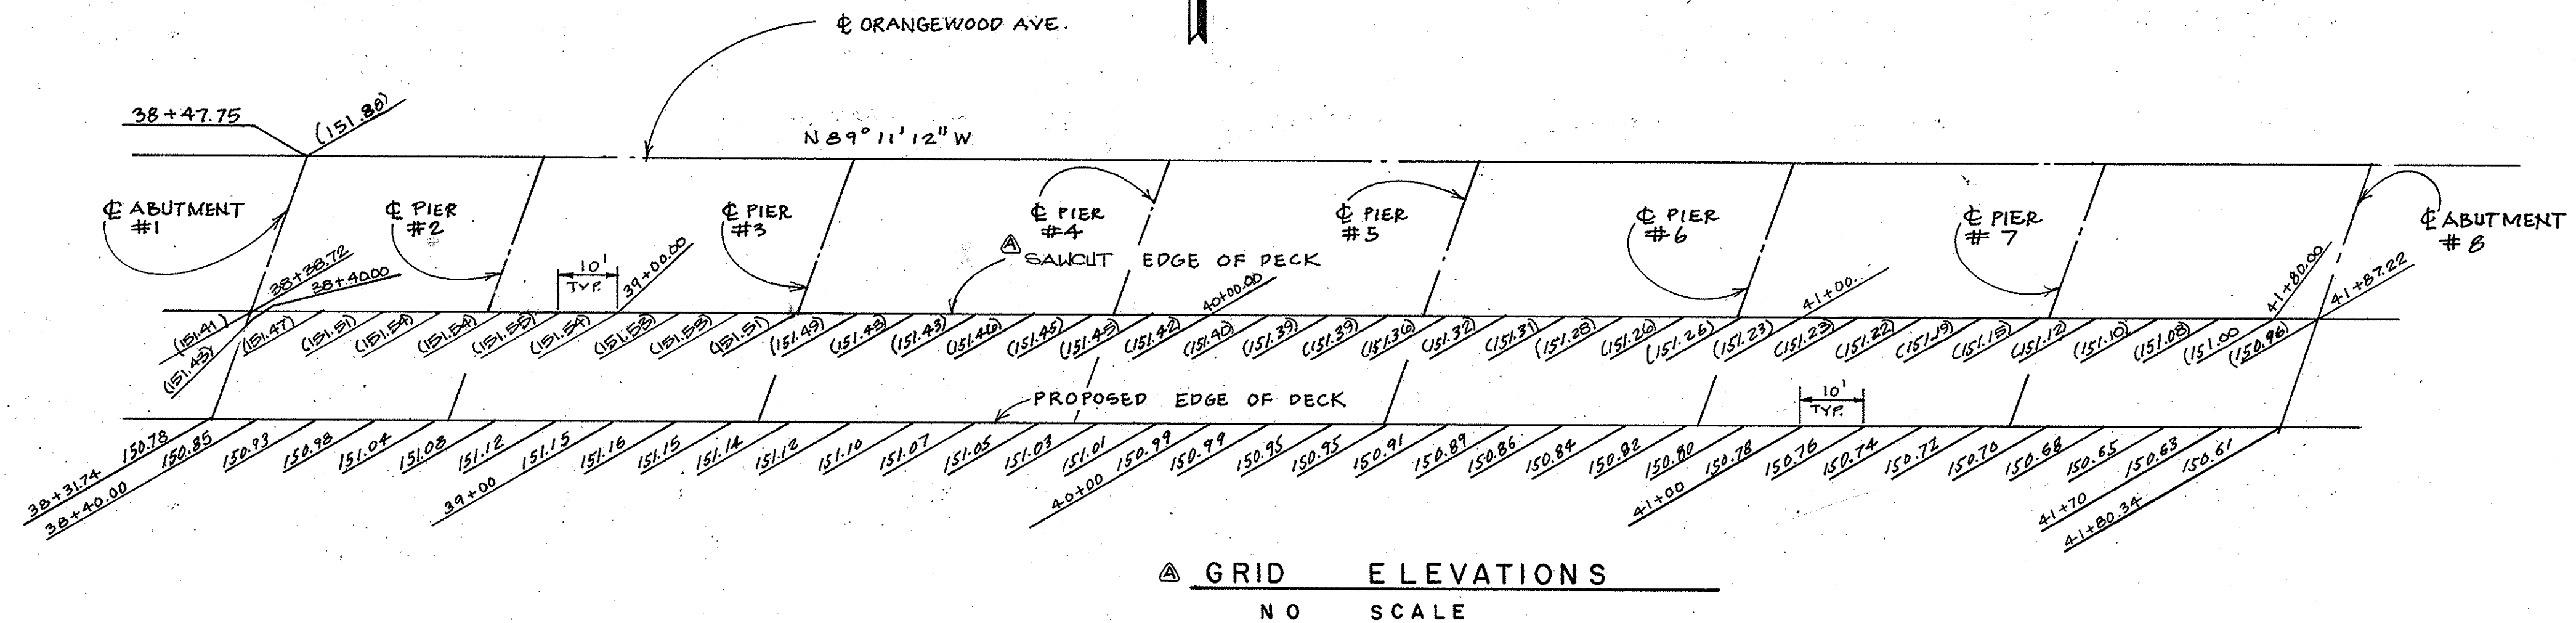

1 1/2 0 1 2
3 inches on original drawing

DOES NOT INCLUDE ALLOWANCE FOR FALSEWORK SETTLEMENT

4-81	ENTERED AS BUILT, STATION AND ELEVATION DATA FOR SAWCUT EDGE OF EXISTING BRIDGE DECK AND PILING DATA.	ORANGE COUNTY ENVIRONMENTAL MANAGEMENT AGENCY	
		ORANGEWOOD AVE. BRIDGE	
		FOUNDATION PLAN AND GRID ELEVATIONS	
MARK	DATE	DESCRIPTION	PREPARED UNDER SUPERVISION OF
REVISIONS			
DESIGNED	E. A.	DATE	DWG. NO.
DRAWN	N. O.	CHECKED	G. A.
			SHEET 6