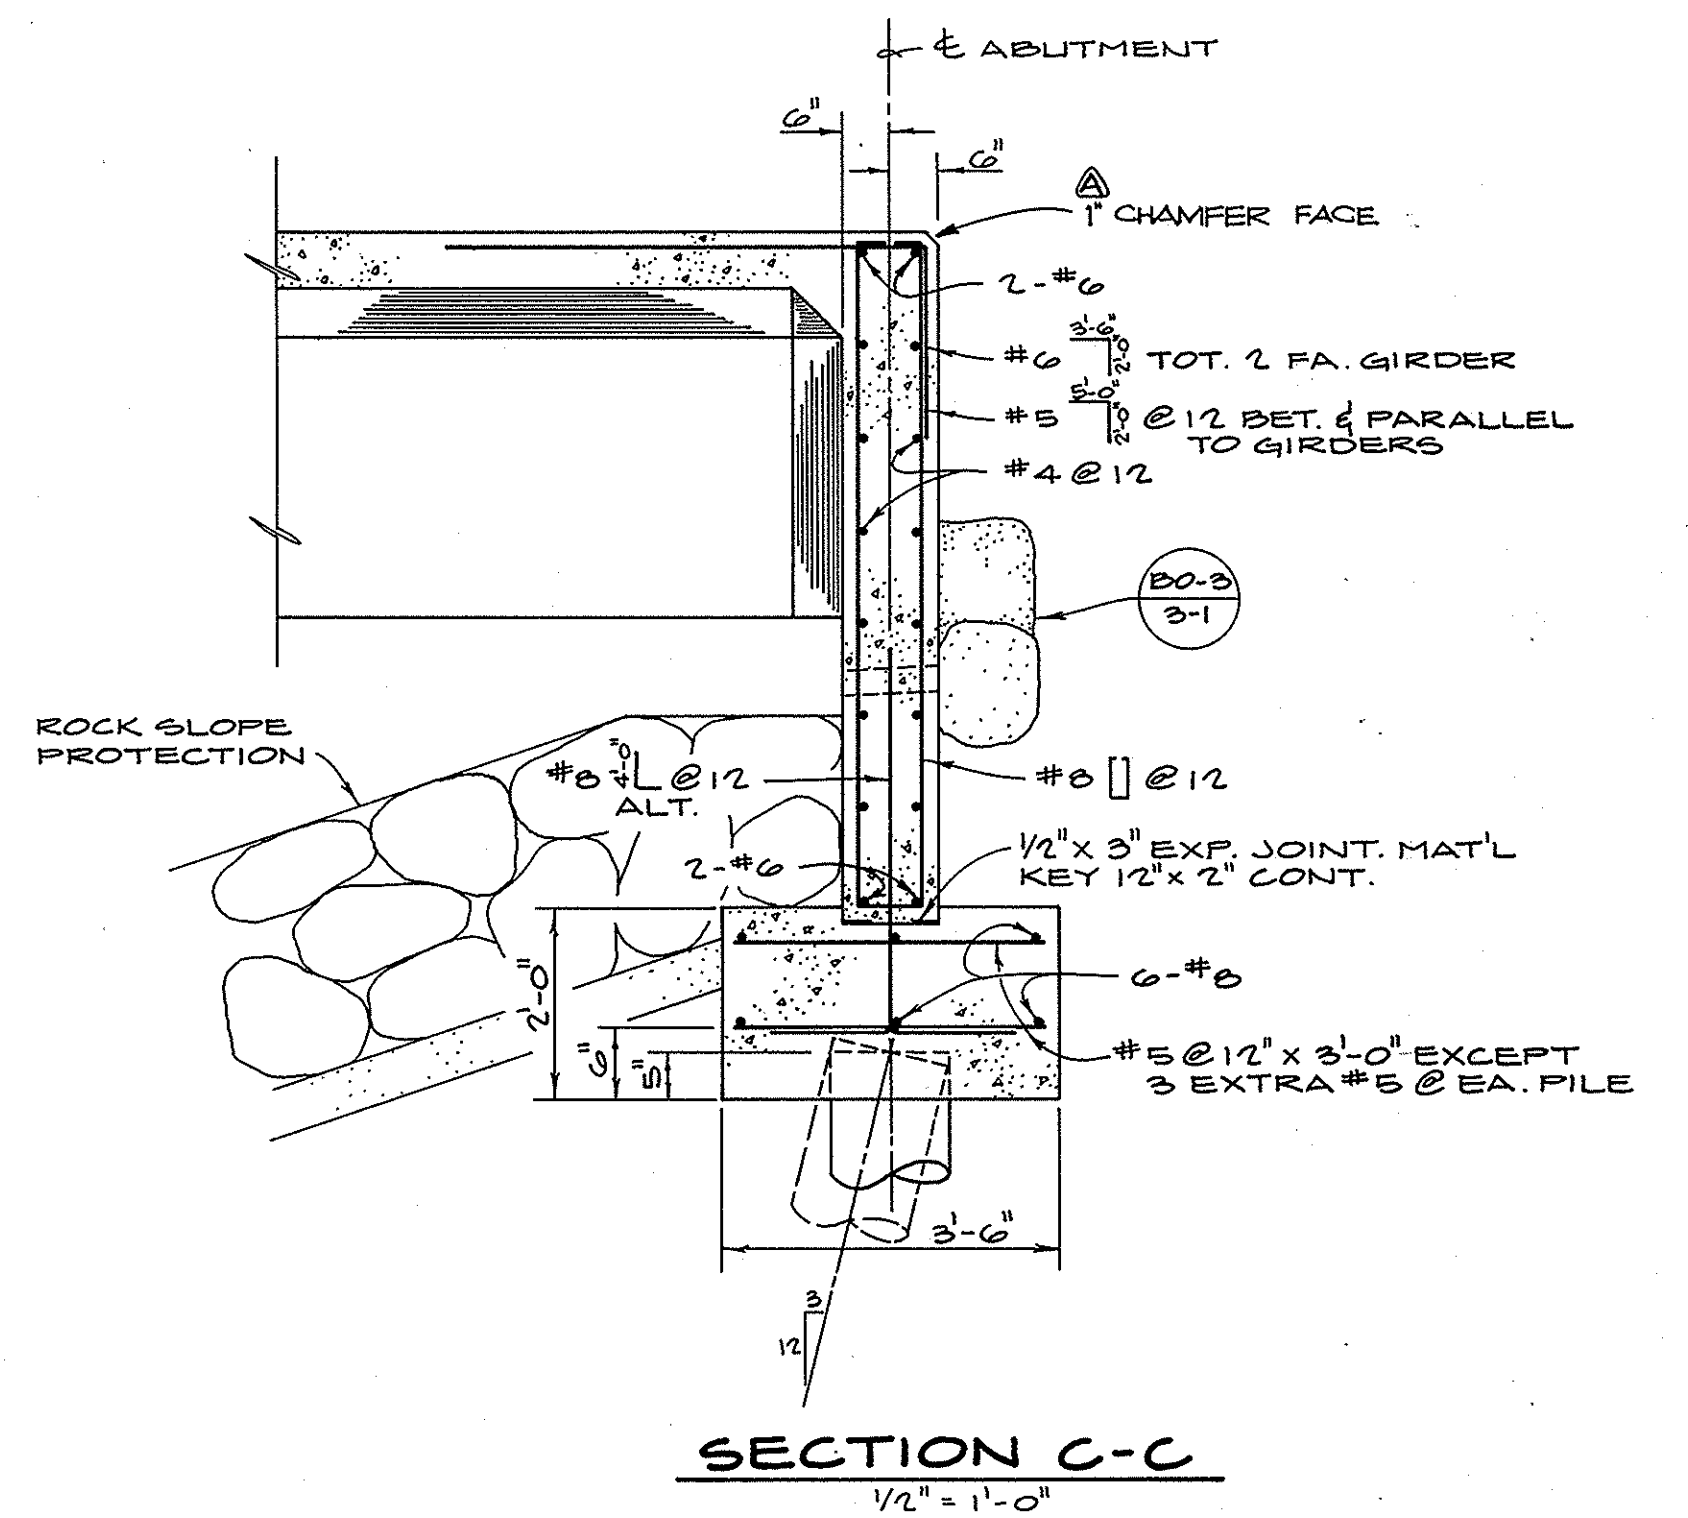
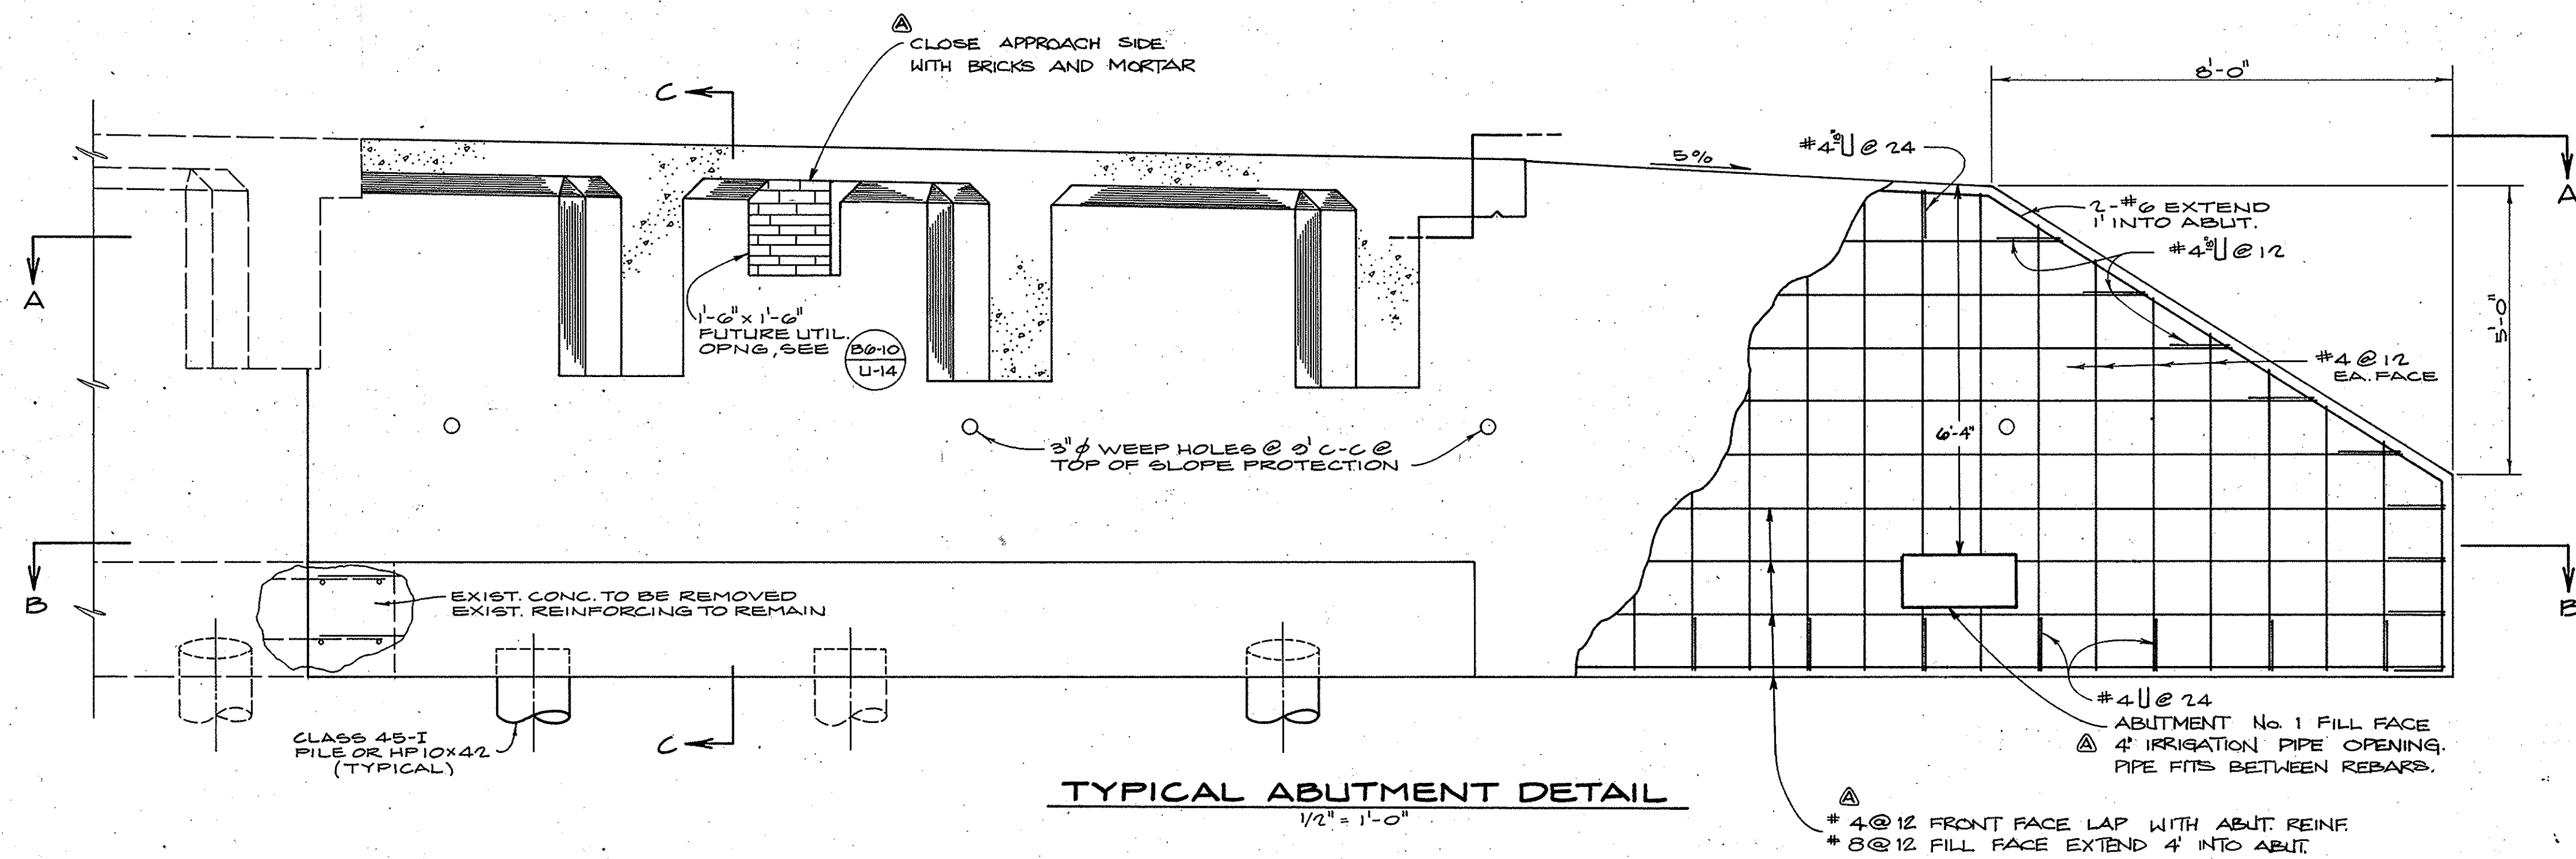
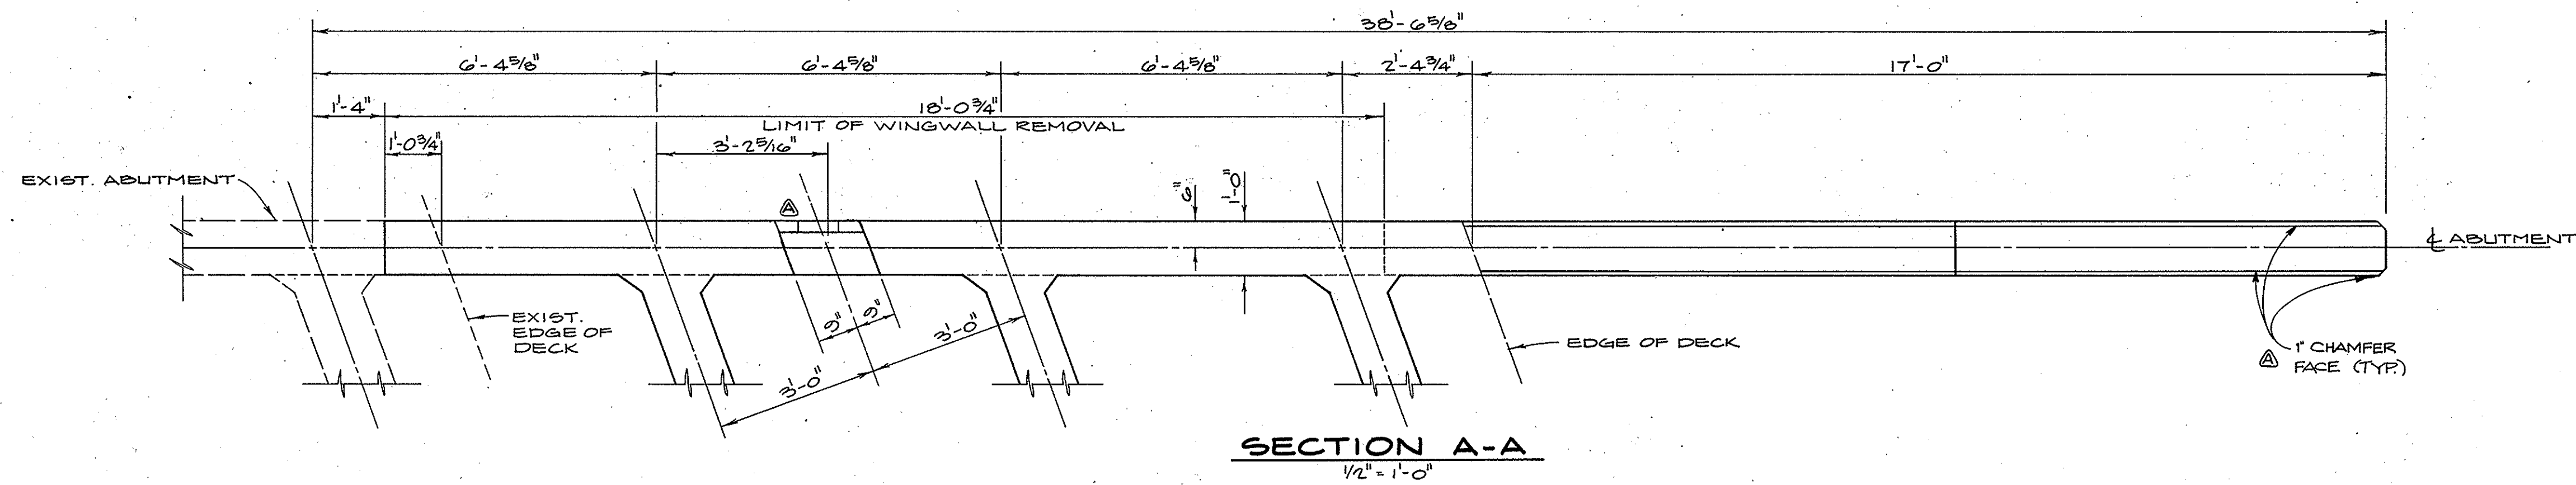


	4-81 AS BUILT CHAMBER FACE AND FIELD CONSTRUCTED UTILITY OPENING FOR EXISTING 4" IRRIGATION PIPE.	ORANGE COUNTY ENVIRONMENTAL MANAGEMENT AGENCY	
		ORANGEWOOD AVE. BRIDGE	
ABUTMENT LAYOUT		SHEET	
		7	
MARK	DATE	DESCRIPTION	PREPARED UNDER SUPERVISION OF <i>[Signature]</i> 6-18-82 DATE
REVISIONS			
DESIGNED <u>E.A.</u>	SCALE	DATE	DWG. NO.
DRAWN <u>D.C.H.</u>	AS SHOWN		
CHECKED <u>E.A.</u>			