


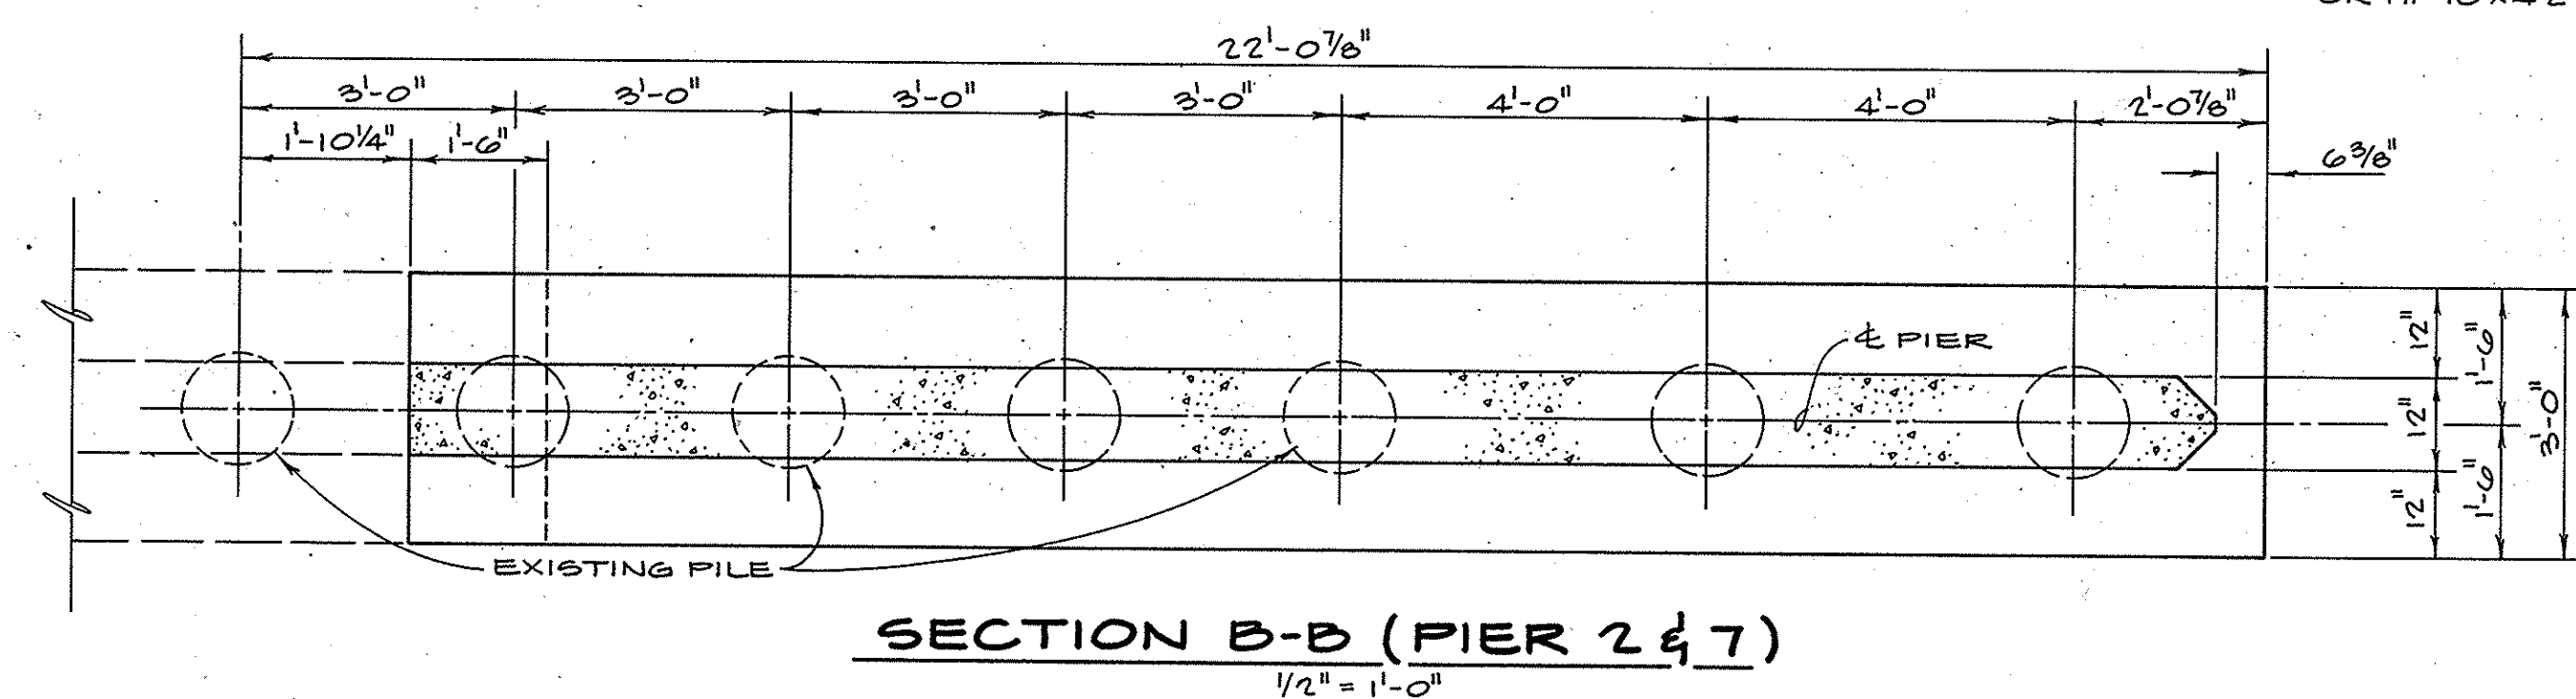
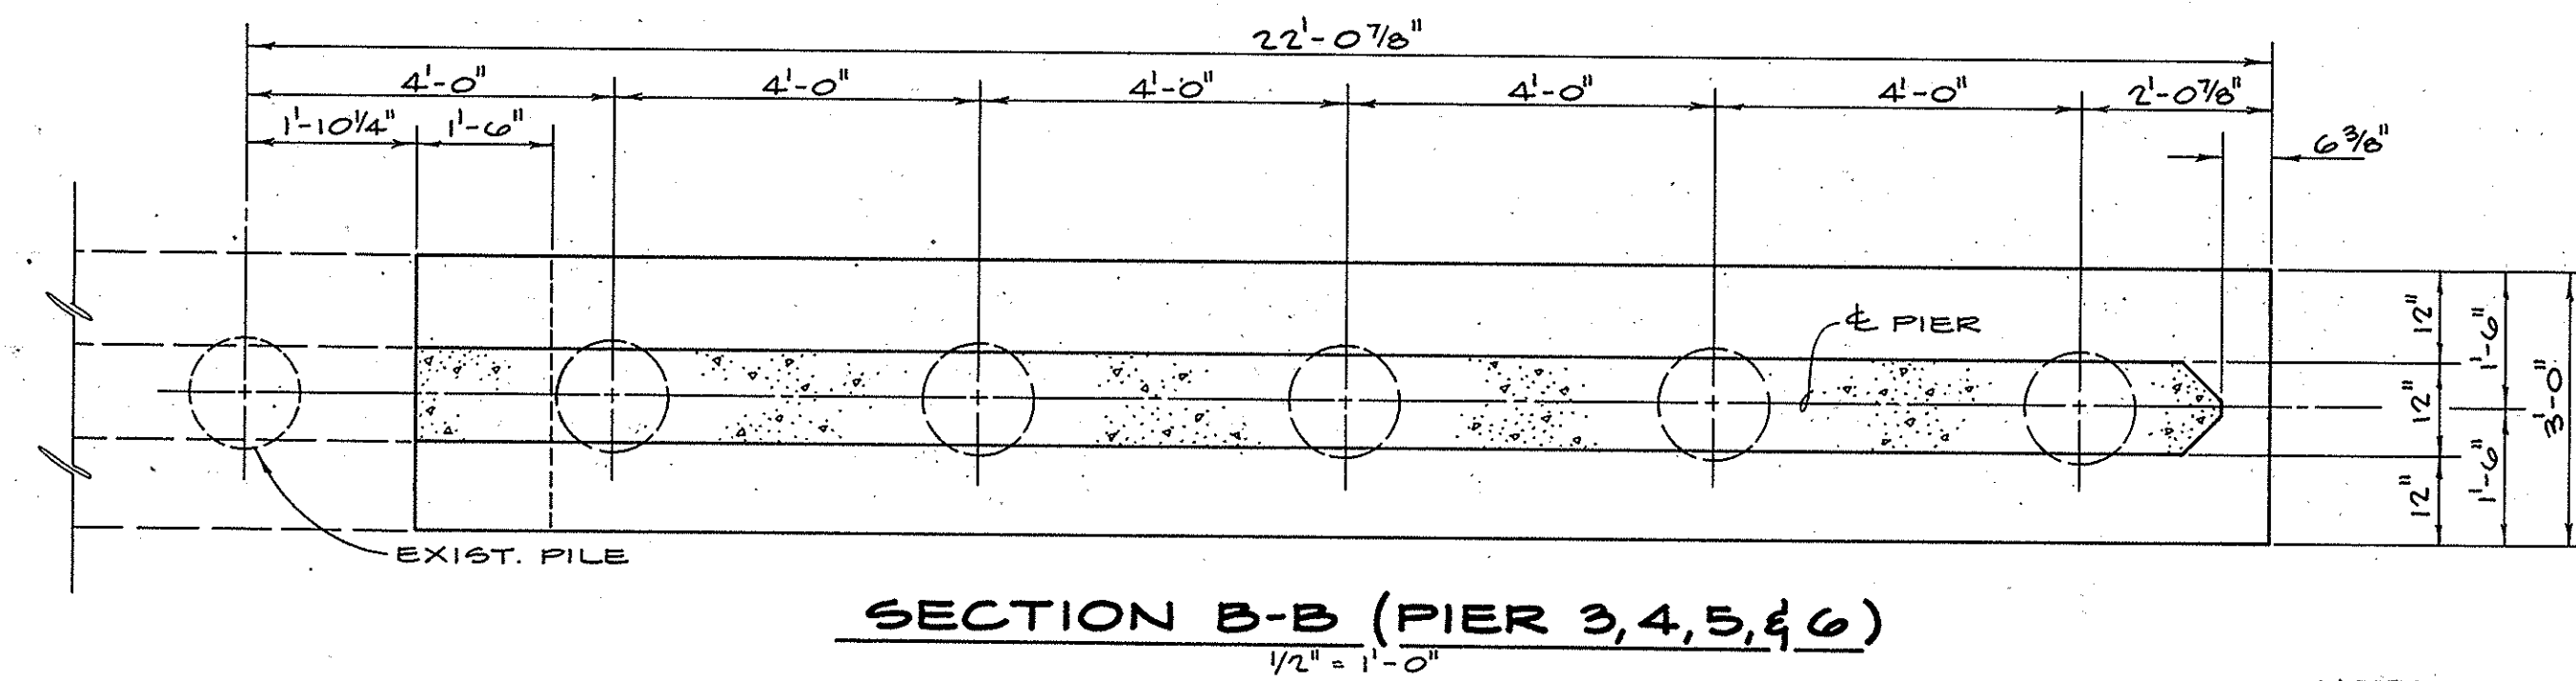
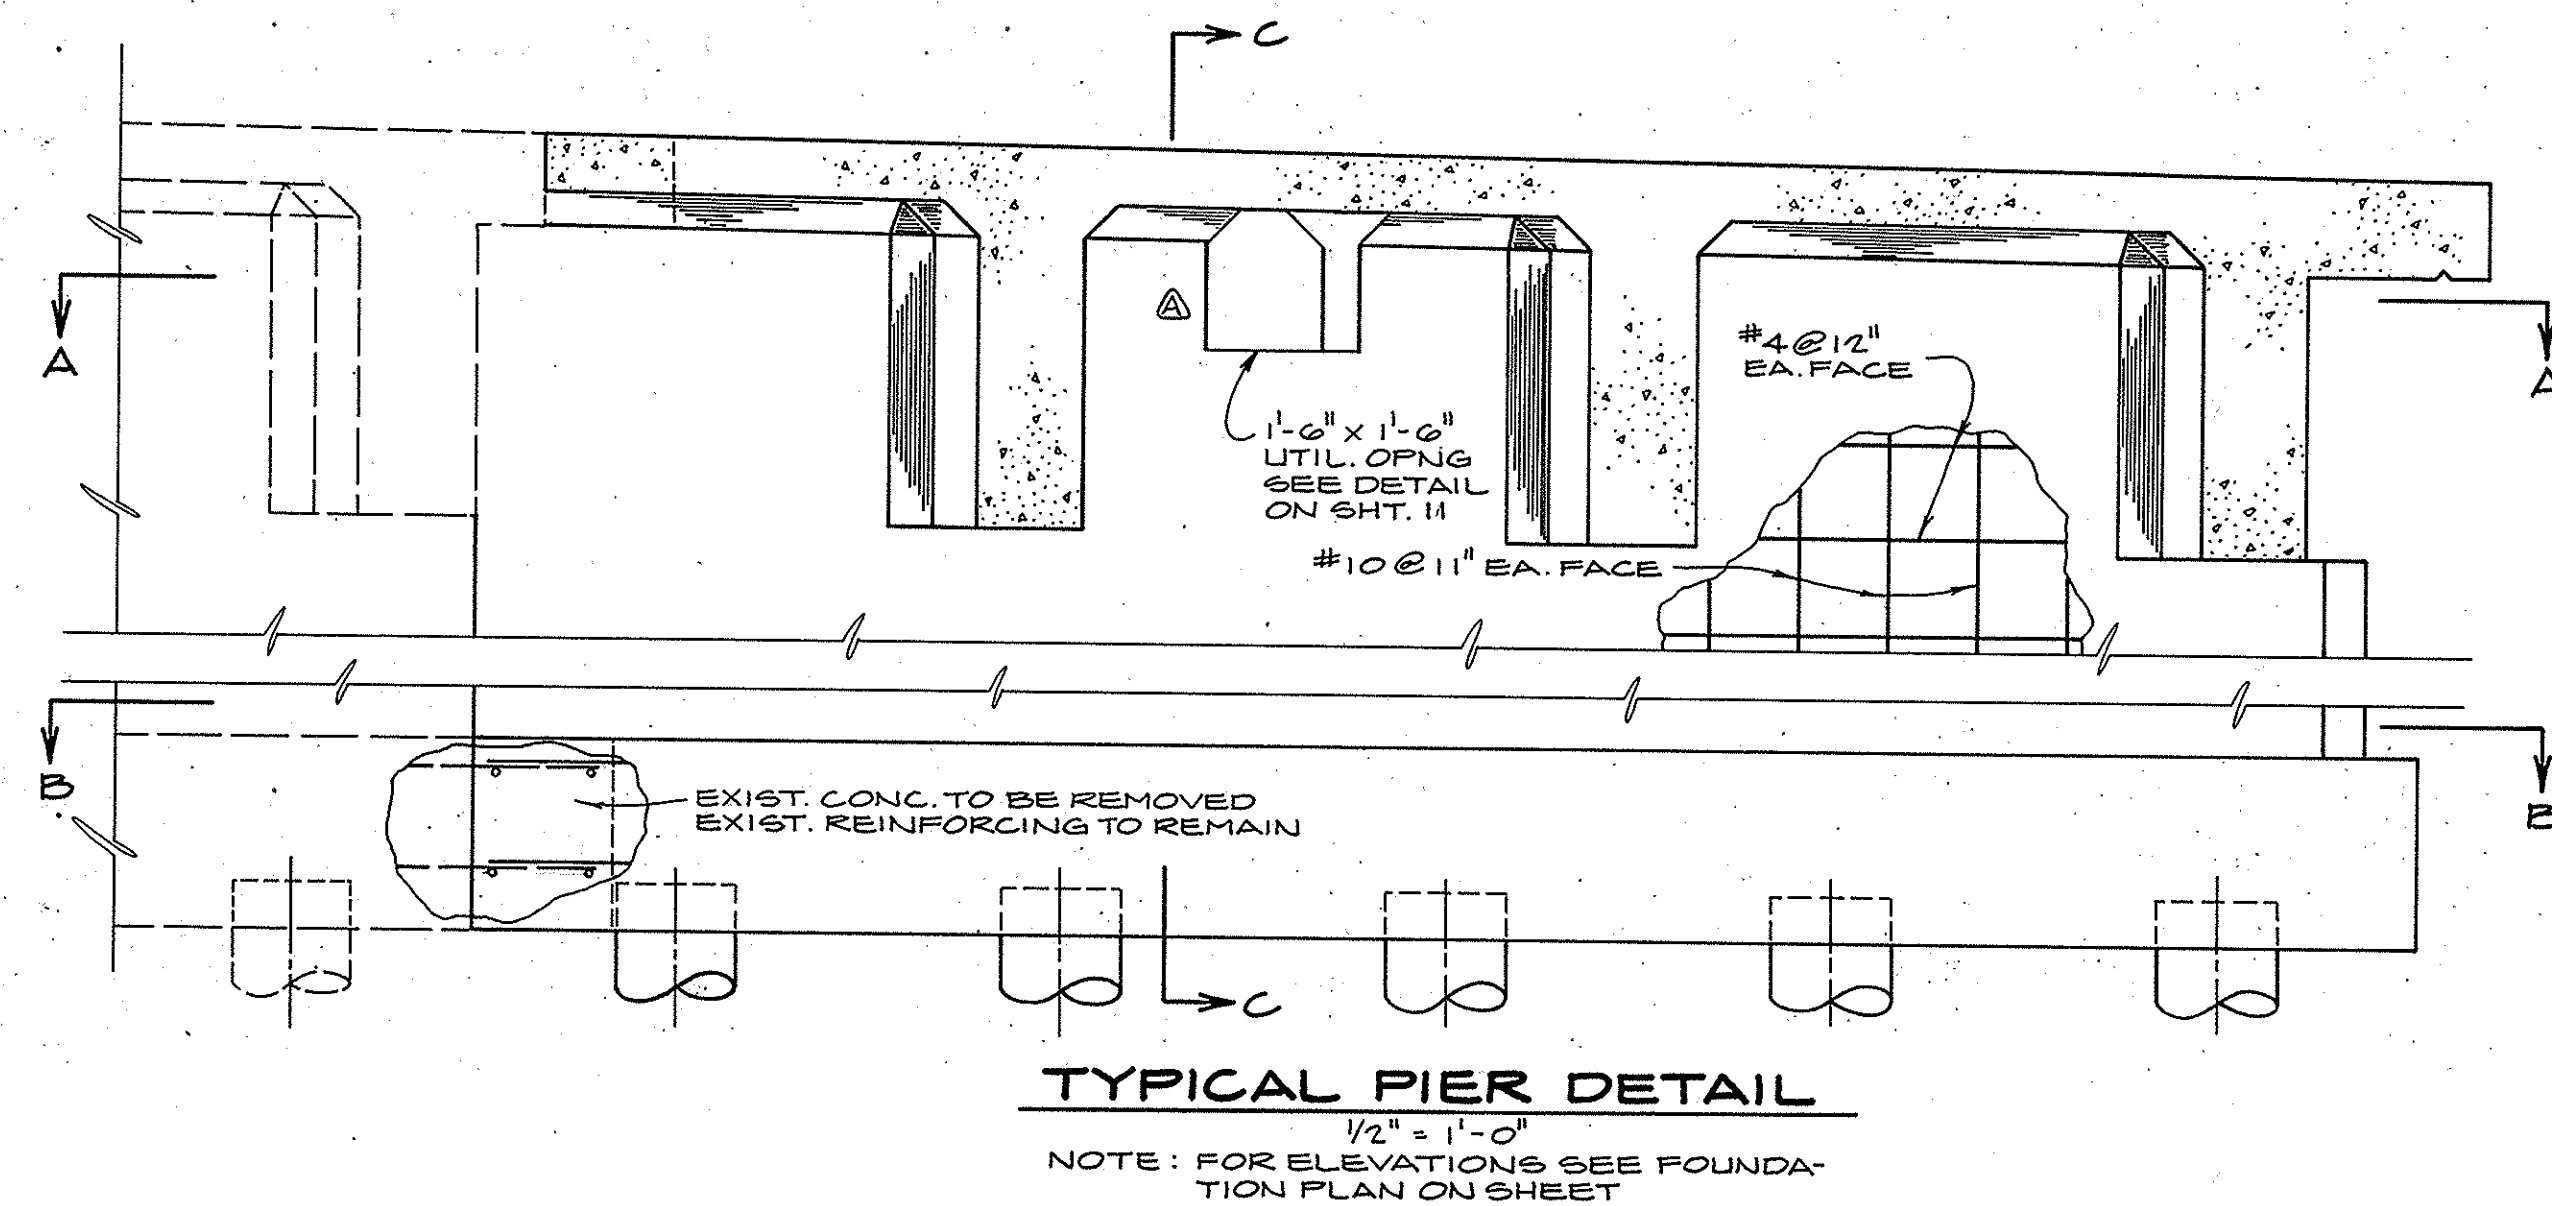
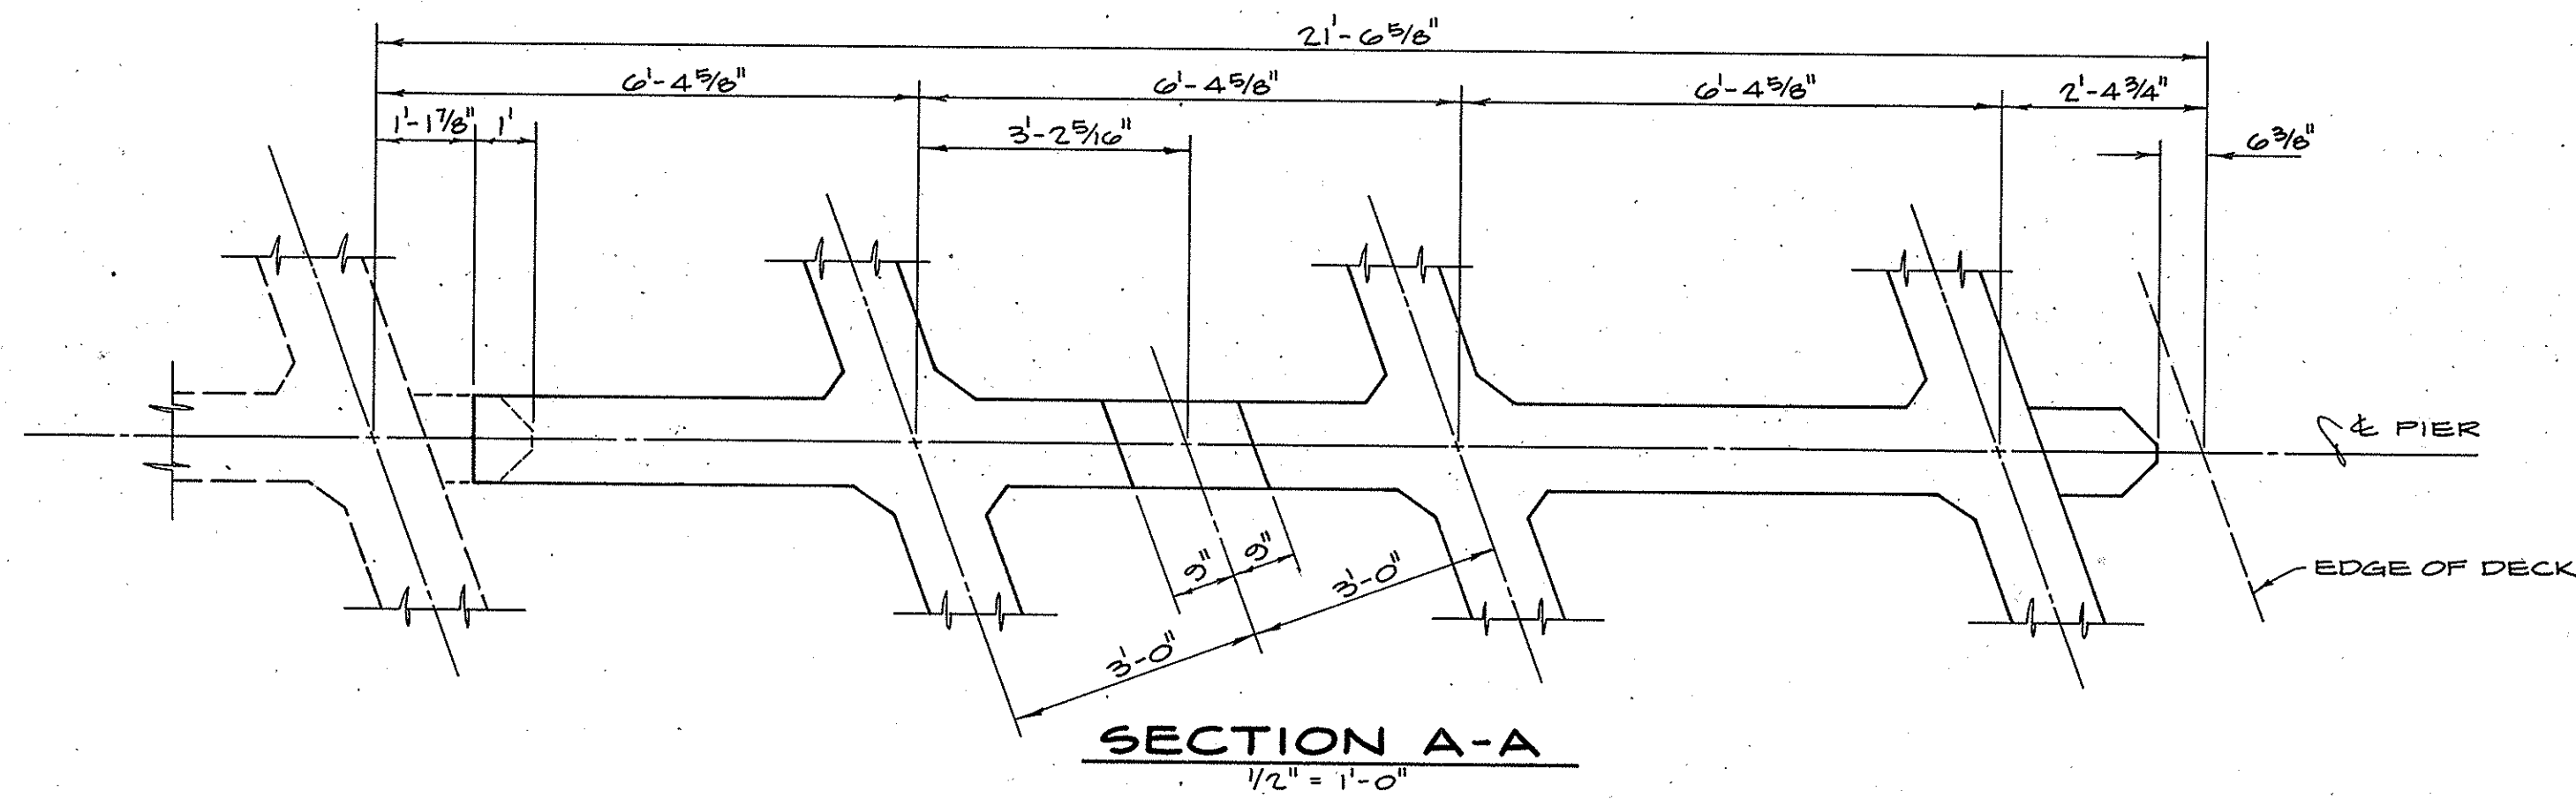
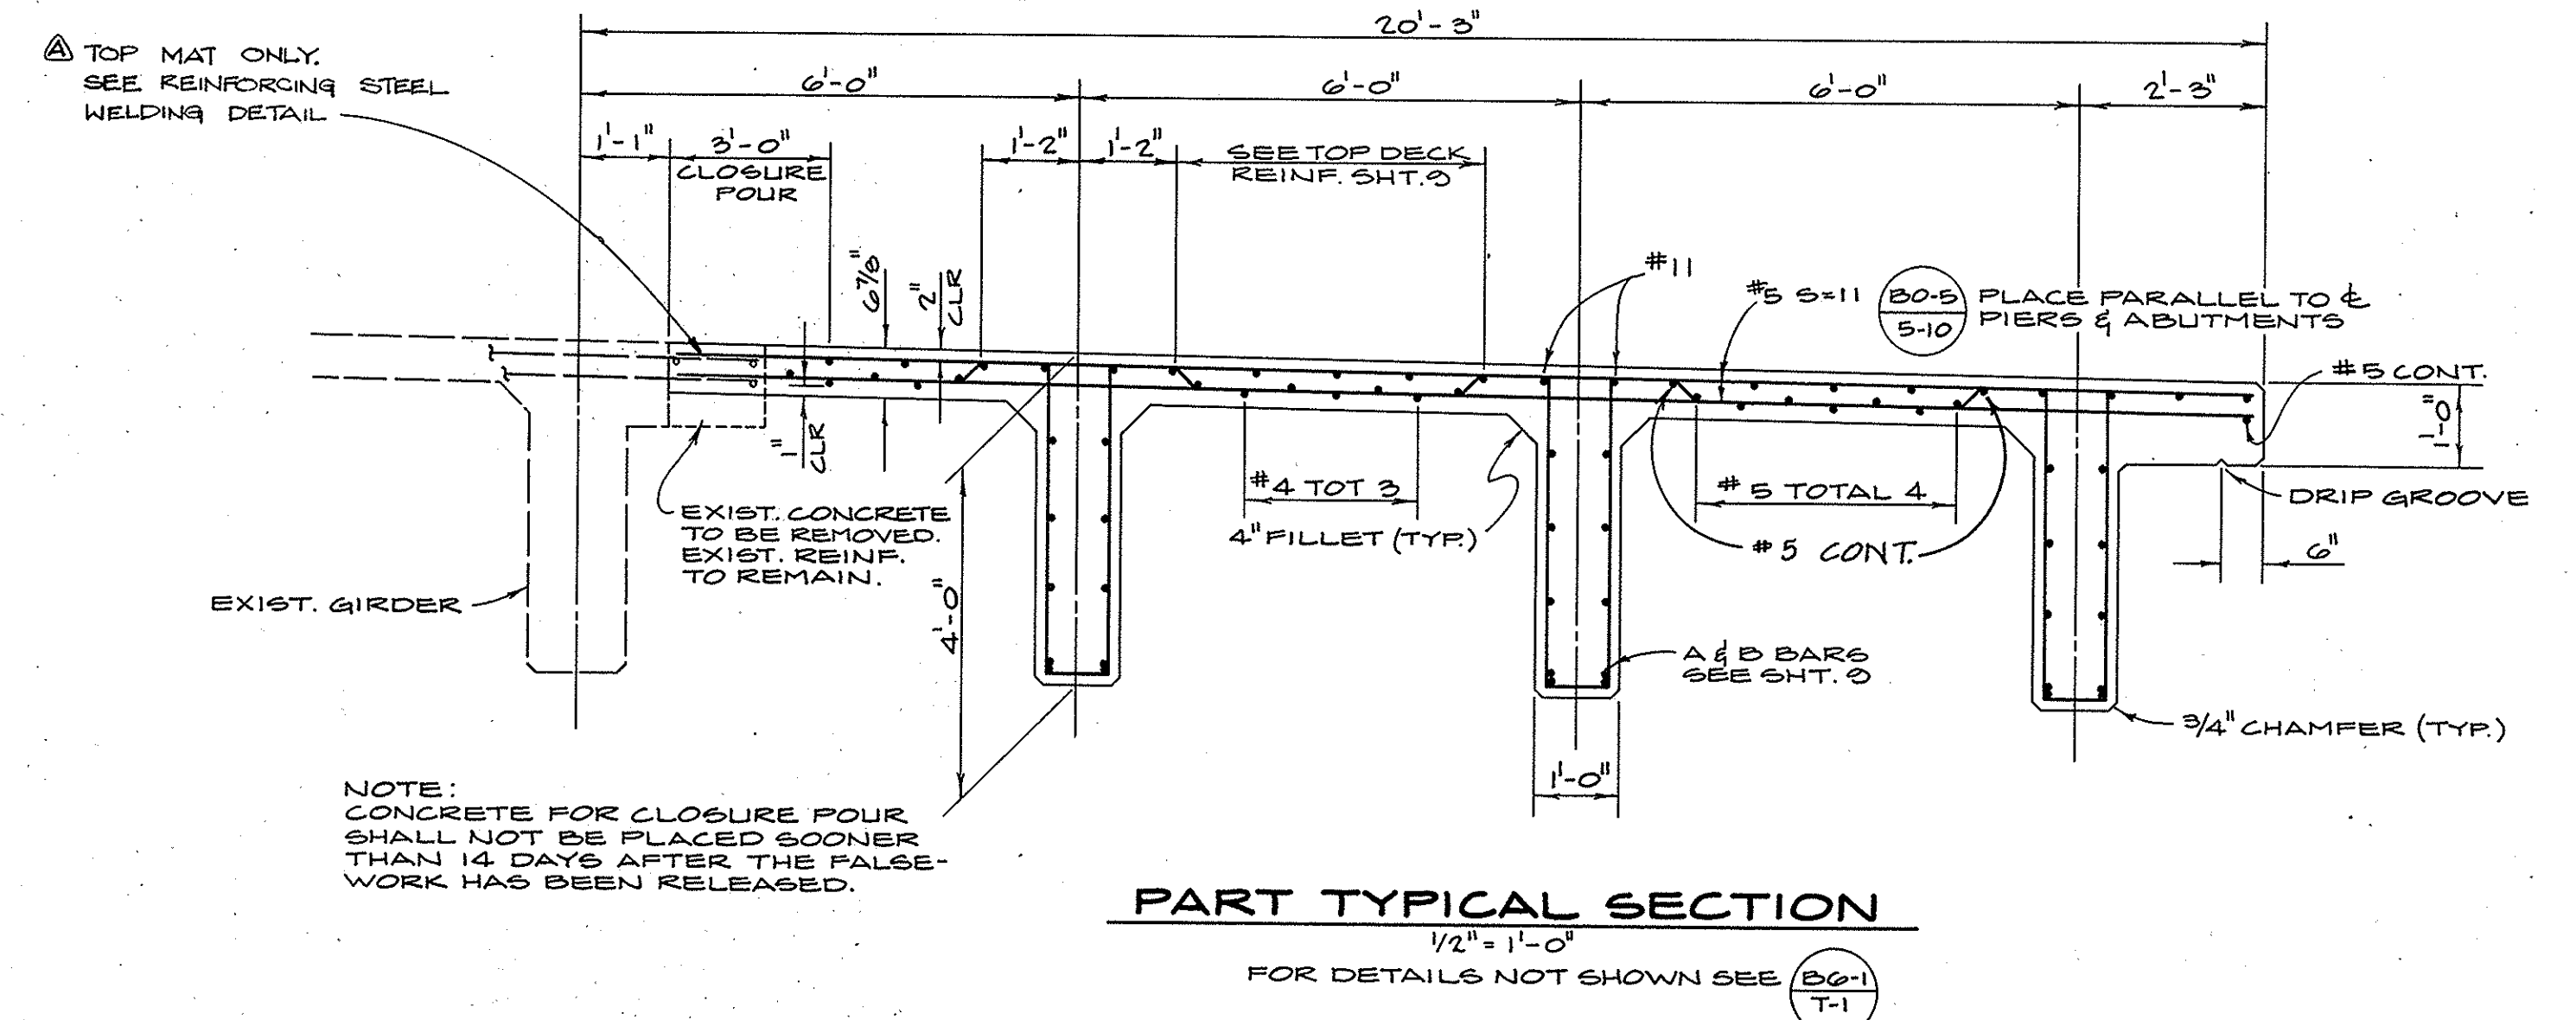


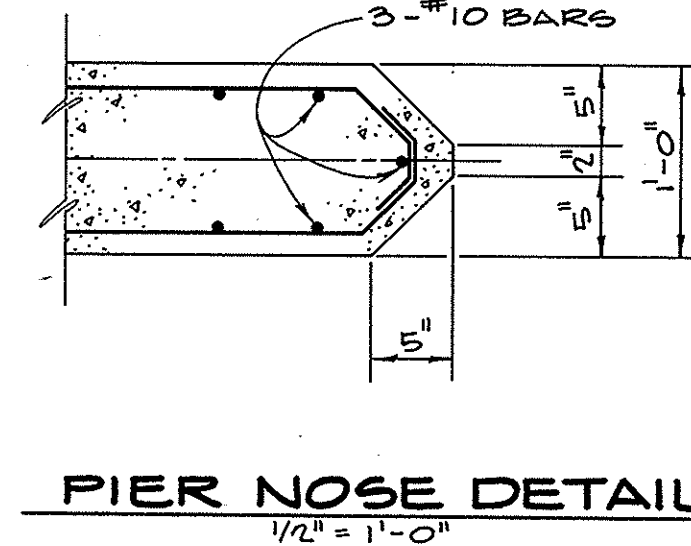

NOTE:
PILES TO BE CLASS 45-I
OR HP 10 X 42 (TYP.)

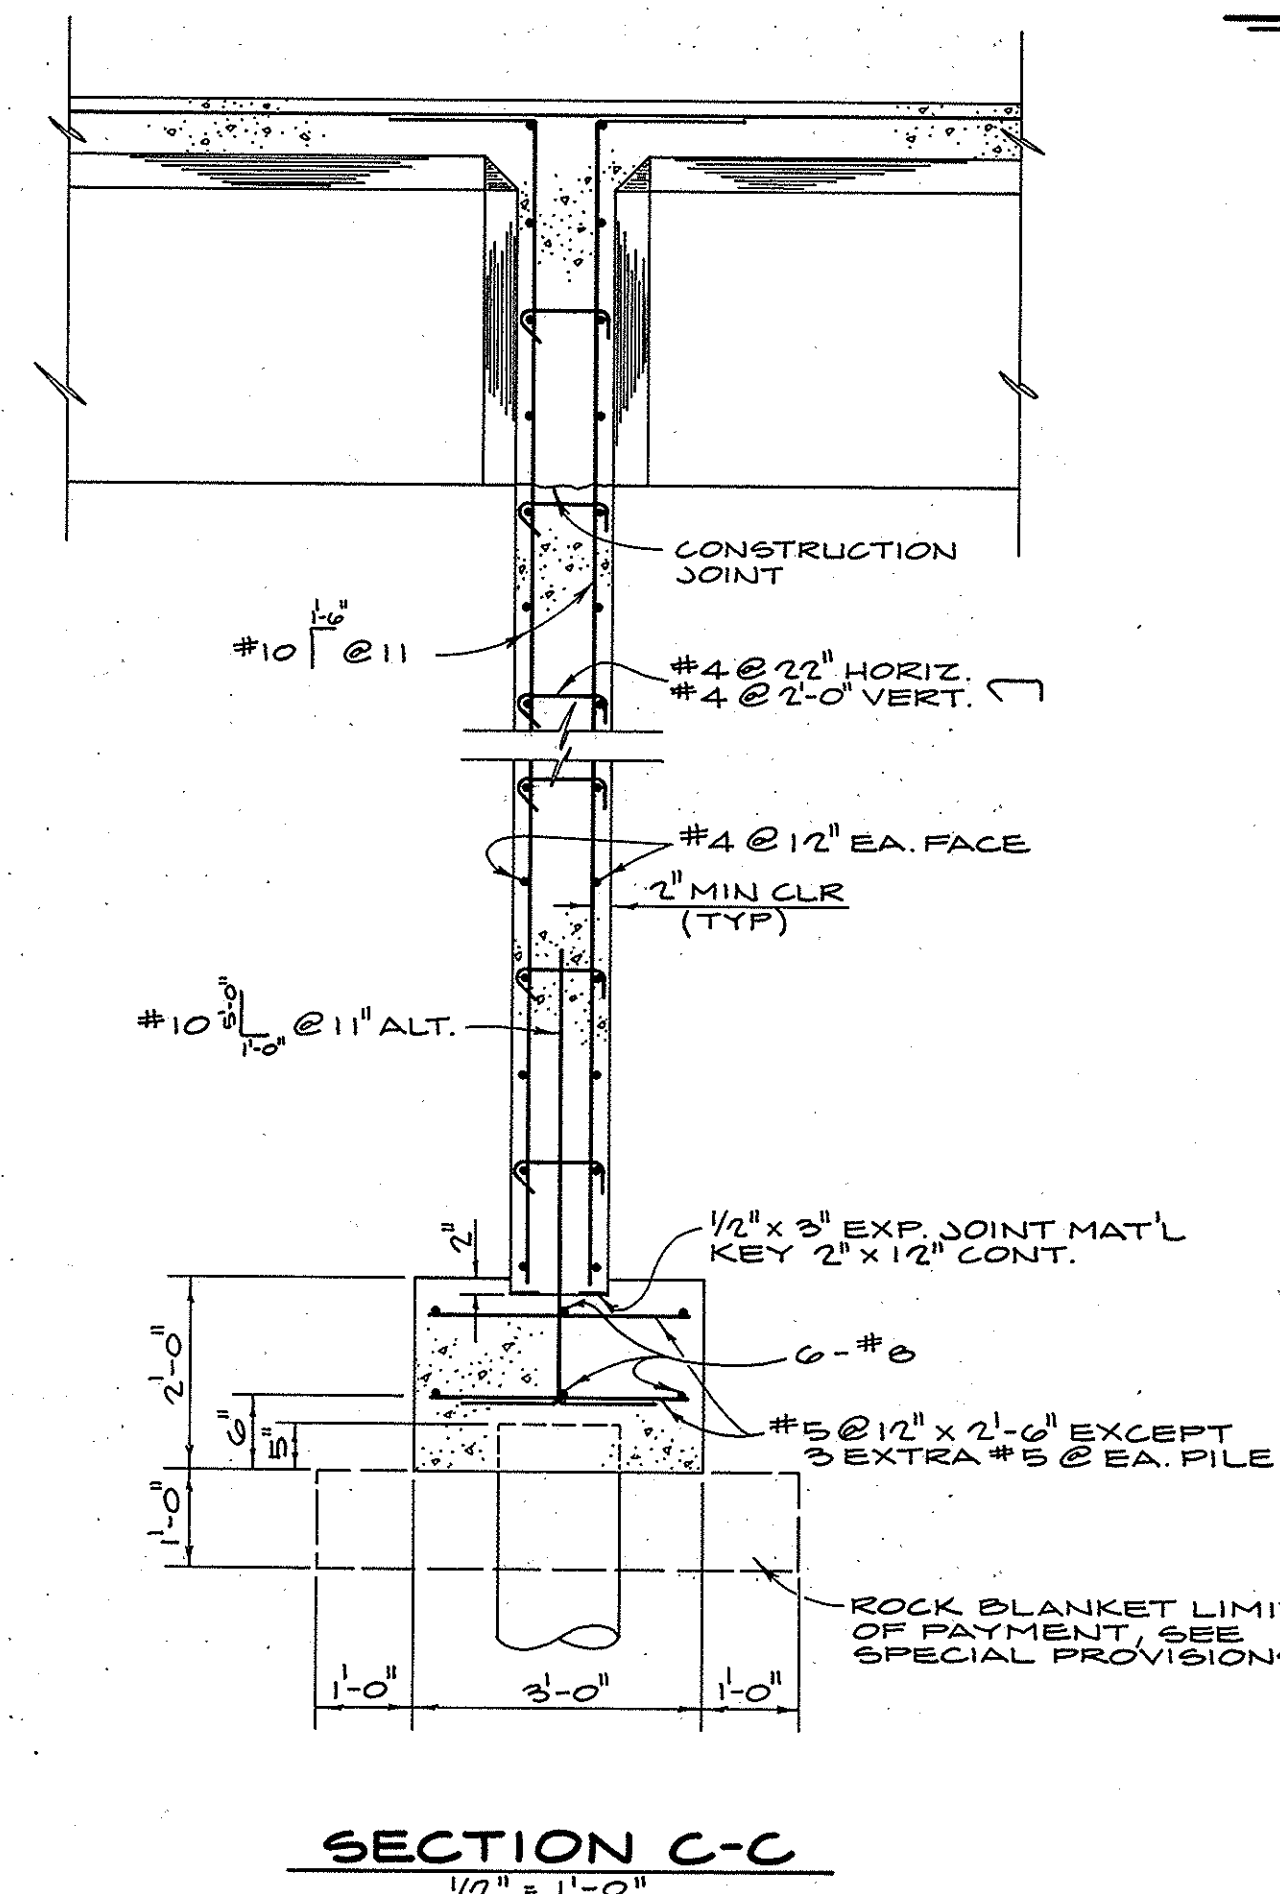

NOTE:
CONCRETE FOR CLOSURE POUR
SHALL NOT BE PLACED SOONER
THAN 14 DAYS AFTER THE FALSE-
WORK HAS BEEN RELEASED.

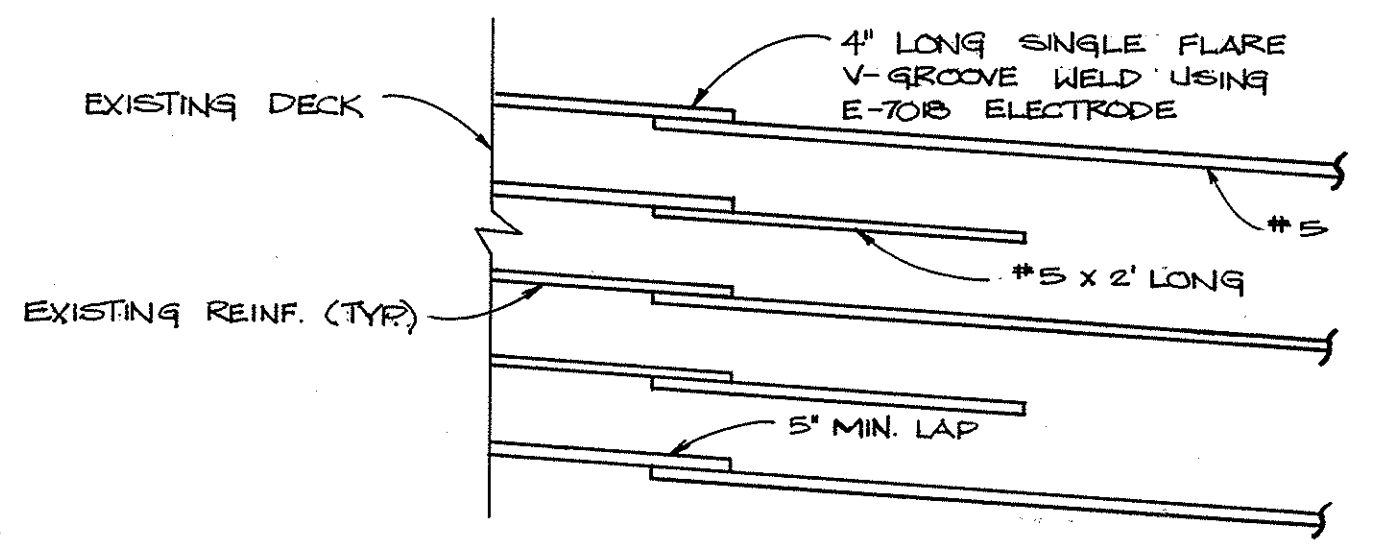

1 1/2 0 1 2
3 inches on original drawing

4-81 AS BUILT		ORANGE COUNTY ENVIRONMENTAL MANAGEMENT AGENCY	
		ORANGWOOD AVE. BRIDGE	
		PIER LAYOUT AND TYPICAL SECTION	
MARK	DATE	DESCRIPTION	PREPARED UNDER SUPERVISION OF
		DESIGNED	SCALE
		DRAWN	CHECKED
		DATE	DWG. NO.
		SHEET	
		8	