


- NOTES:
1. ALL MATERIALS AND WORK SHALL CONFORM TO THE CALIFORNIA DEPARTMENT OF TRANSPORTATION STANDARD SPECIFICATIONS, JANUARY, 1978, STANDARD PLANS, MARCH, 1977, AND THE SPECIAL PROVISIONS.
 2. REMOVE EXISTING 1-W-A & 2-W-A 4-#18 DETECTOR CABLES AND INSTALL 3-4 #18 DETECTOR CABLES FOR 1-W-A, 2-W-A & 3-W-A.
 3. UPON COMPLETION OF CONSTRUCTION, STREET WILL BE RESTRIPE BY THE CITY OF ANAHEIM.
 4. NEW MAGNETOMETER HEADS SHALL BE COMPATIBLE WITH EXISTING SENSORS.
 5. IN CONTROLLER, INSTALL ONE ADDITIONAL MAGNETOMETER SENSOR.

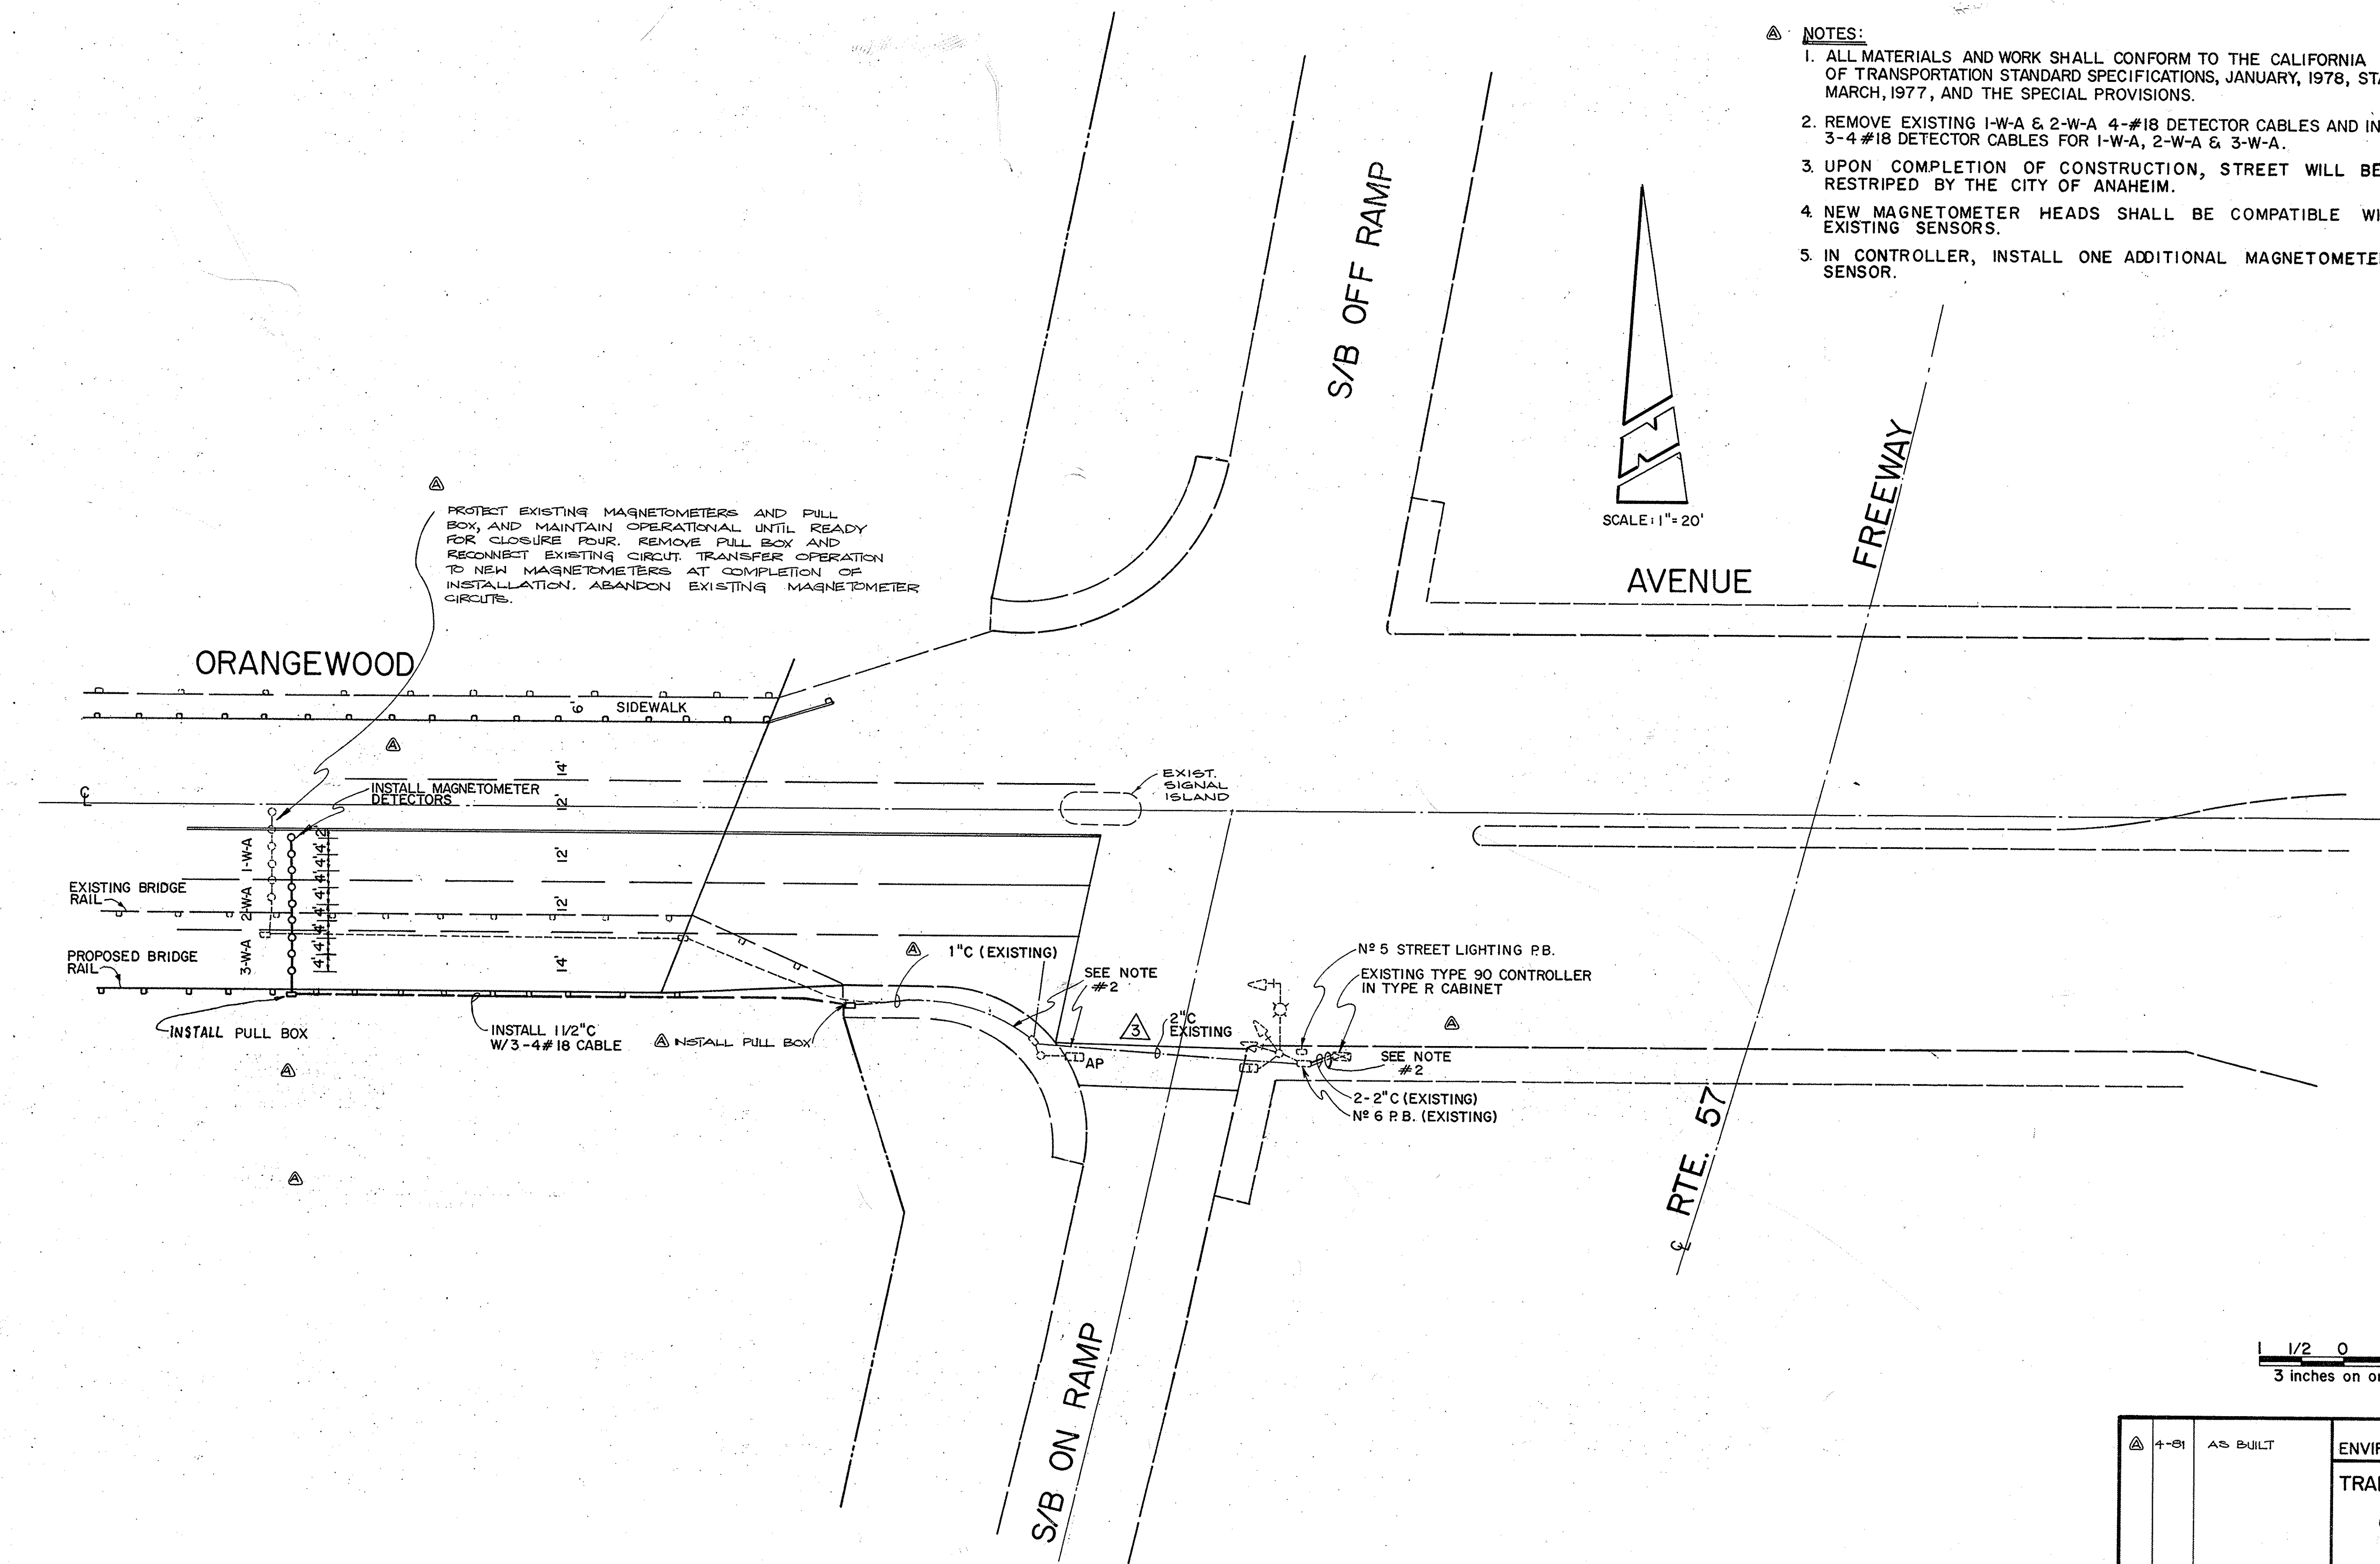

CALTRANS - TRAFFIC			
SUBMITTED BY	REVIEWED BY	APPROVAL RECOMMENDED BY	DATE
Norme P. Ellis	W. Baile	B. H. Clark	6/80

PERMIT NO - 780-E-766292

ORA-57-11.82

PREPARED BY
Weston Pringle Jr.
 DESIGN ENGINEER
 WESTON PRINGLE AND ASSOCIATES
 RCE 16828
 DATE 5-14-80

ORANGE COUNTY ENVIRONMENTAL MANAGEMENT AGENCY	
TRAFFIC SIGNAL MODIFICATION ORANGEWOOD AVENUE AT ROUTE 57 S/B ON & OFF RAMPS	
MARK 4-81	AS BUILT
DESIGNED DRAWN CARLSON	REVISIONS CHECKED
PREPARED UNDER SUPERVISION OF	SCALE AS SHOWN
DATE	DWG. NO.
SHEET 15	