
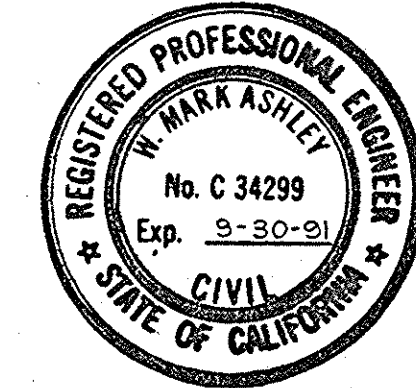
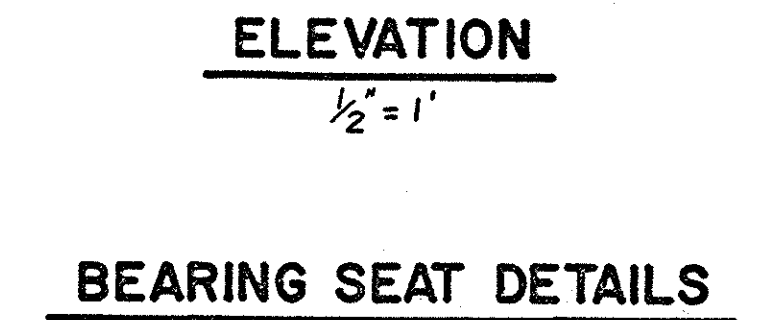
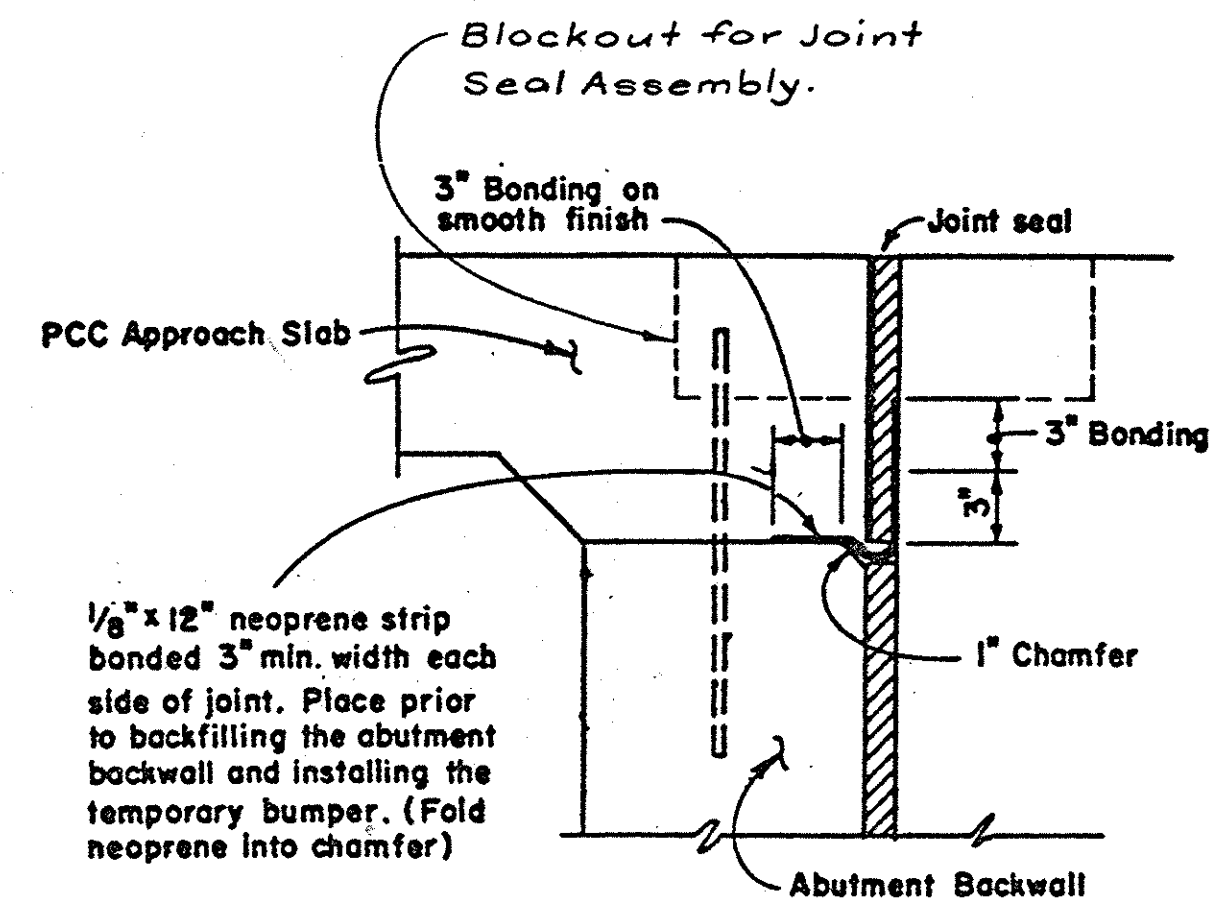
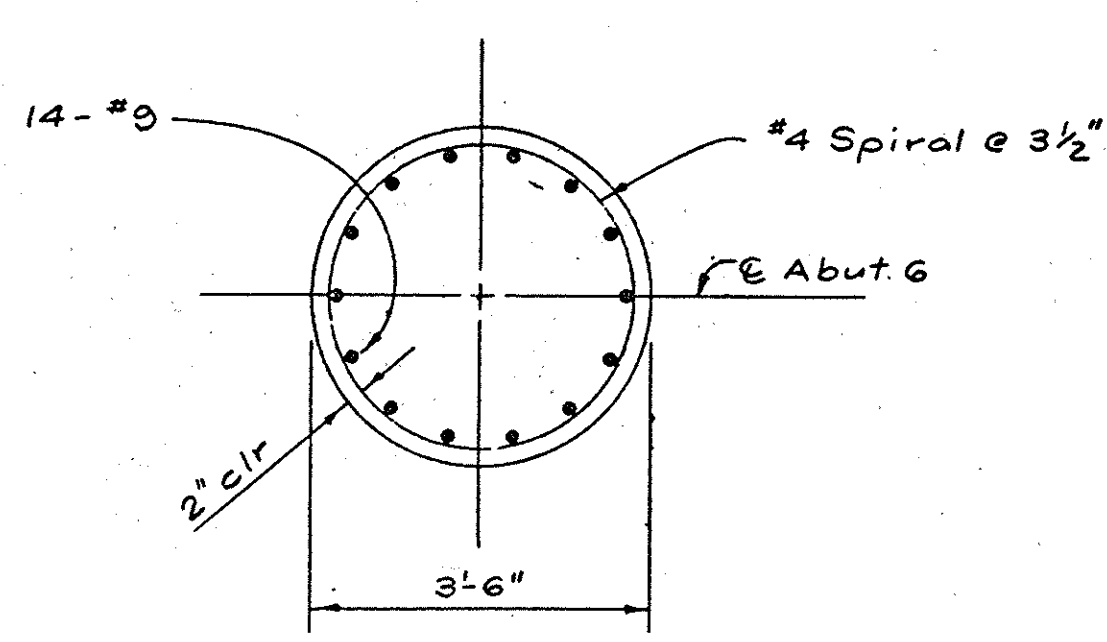
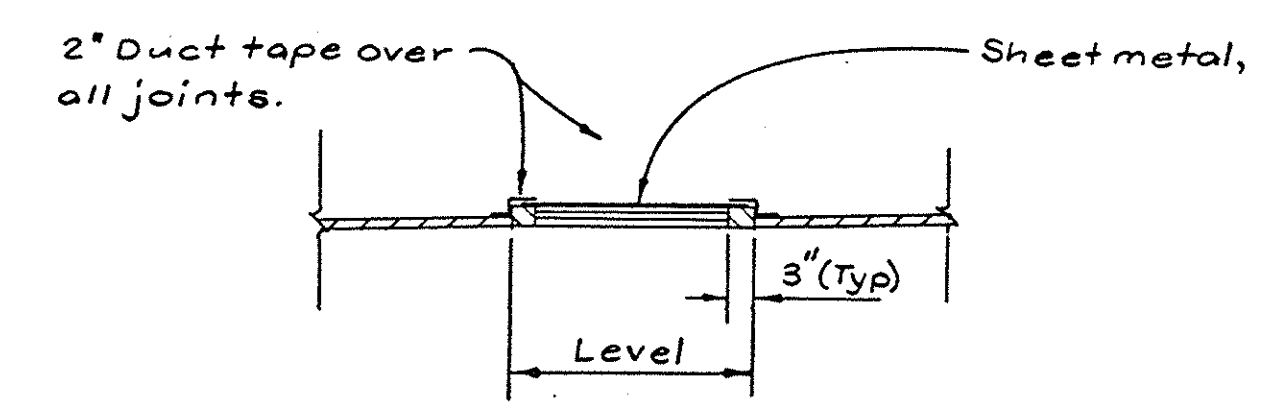
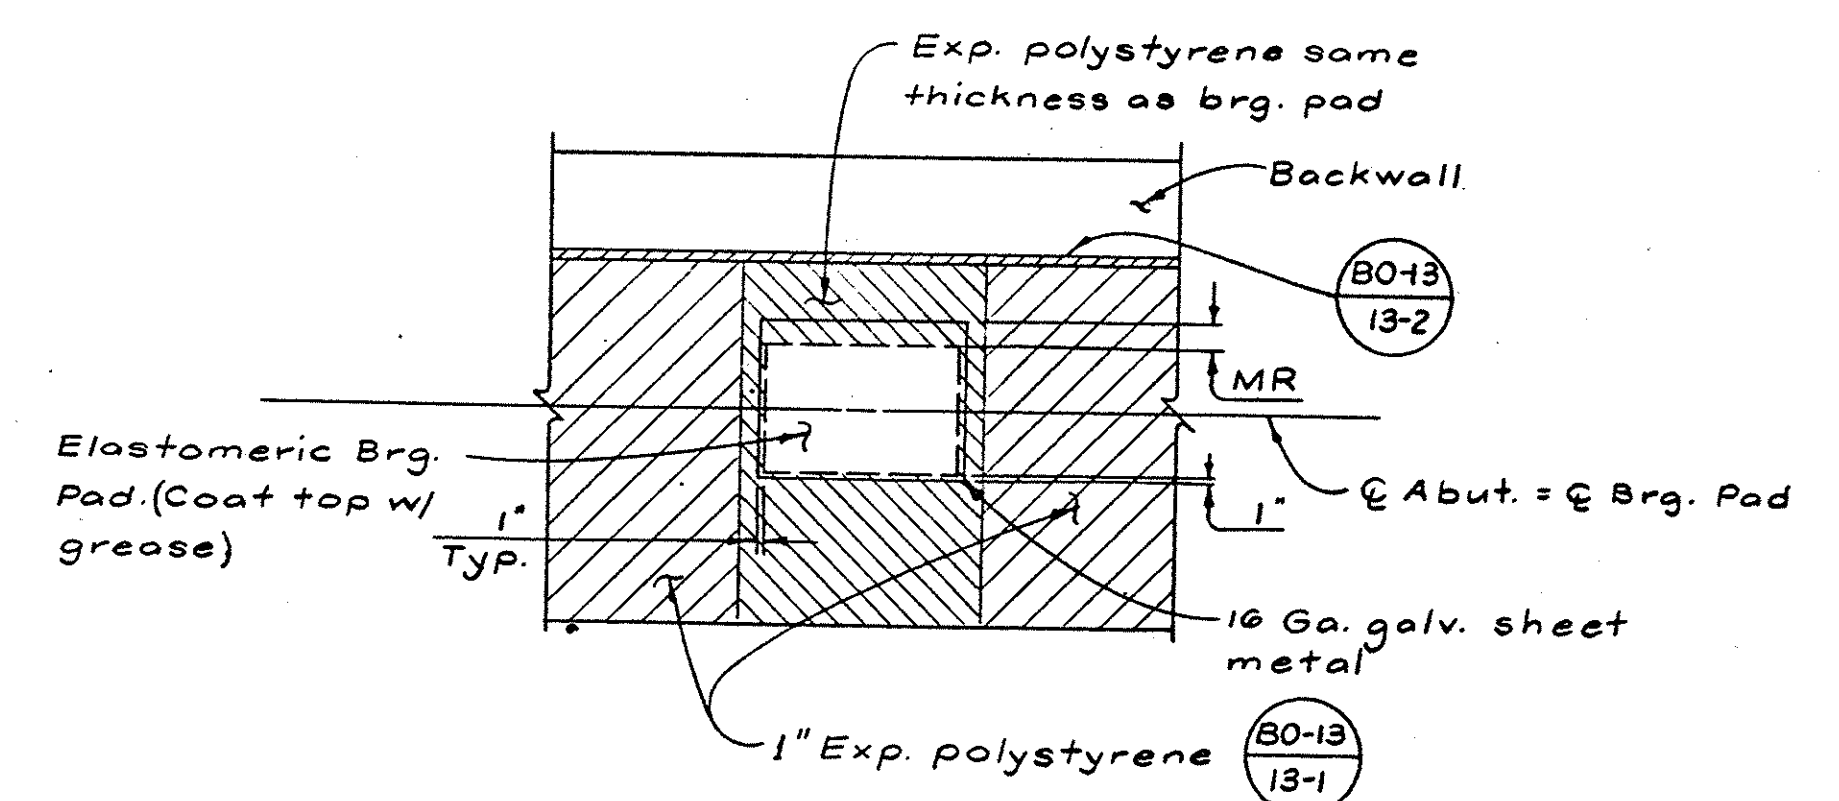
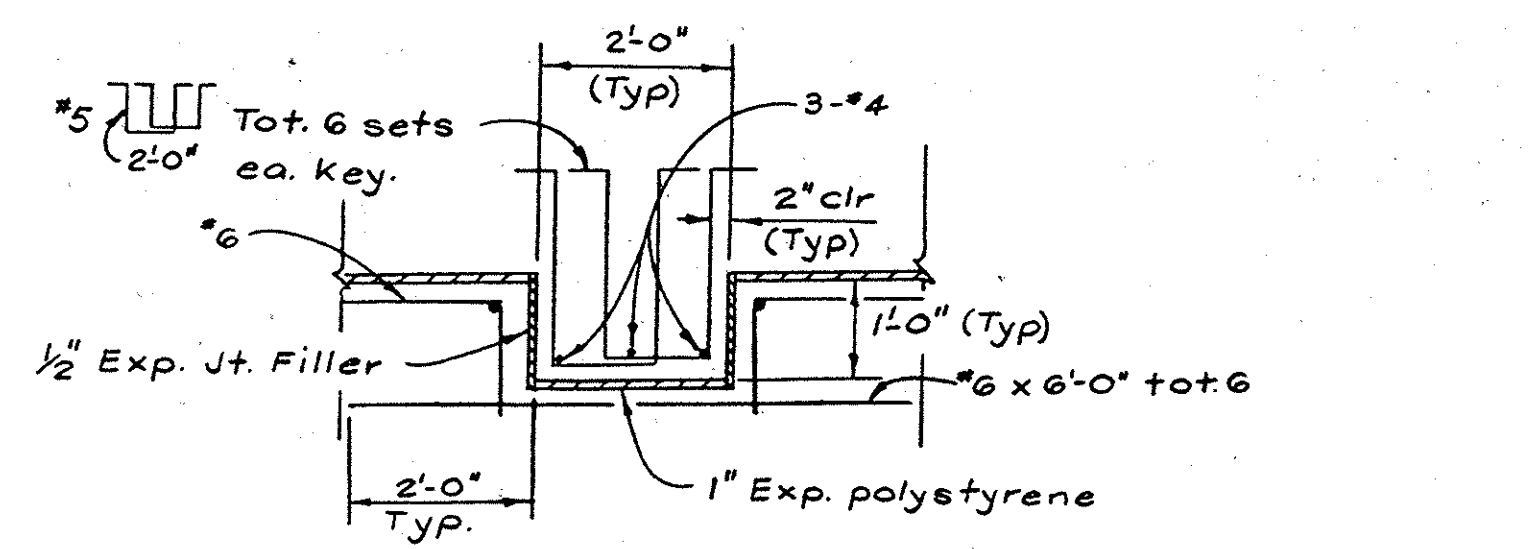
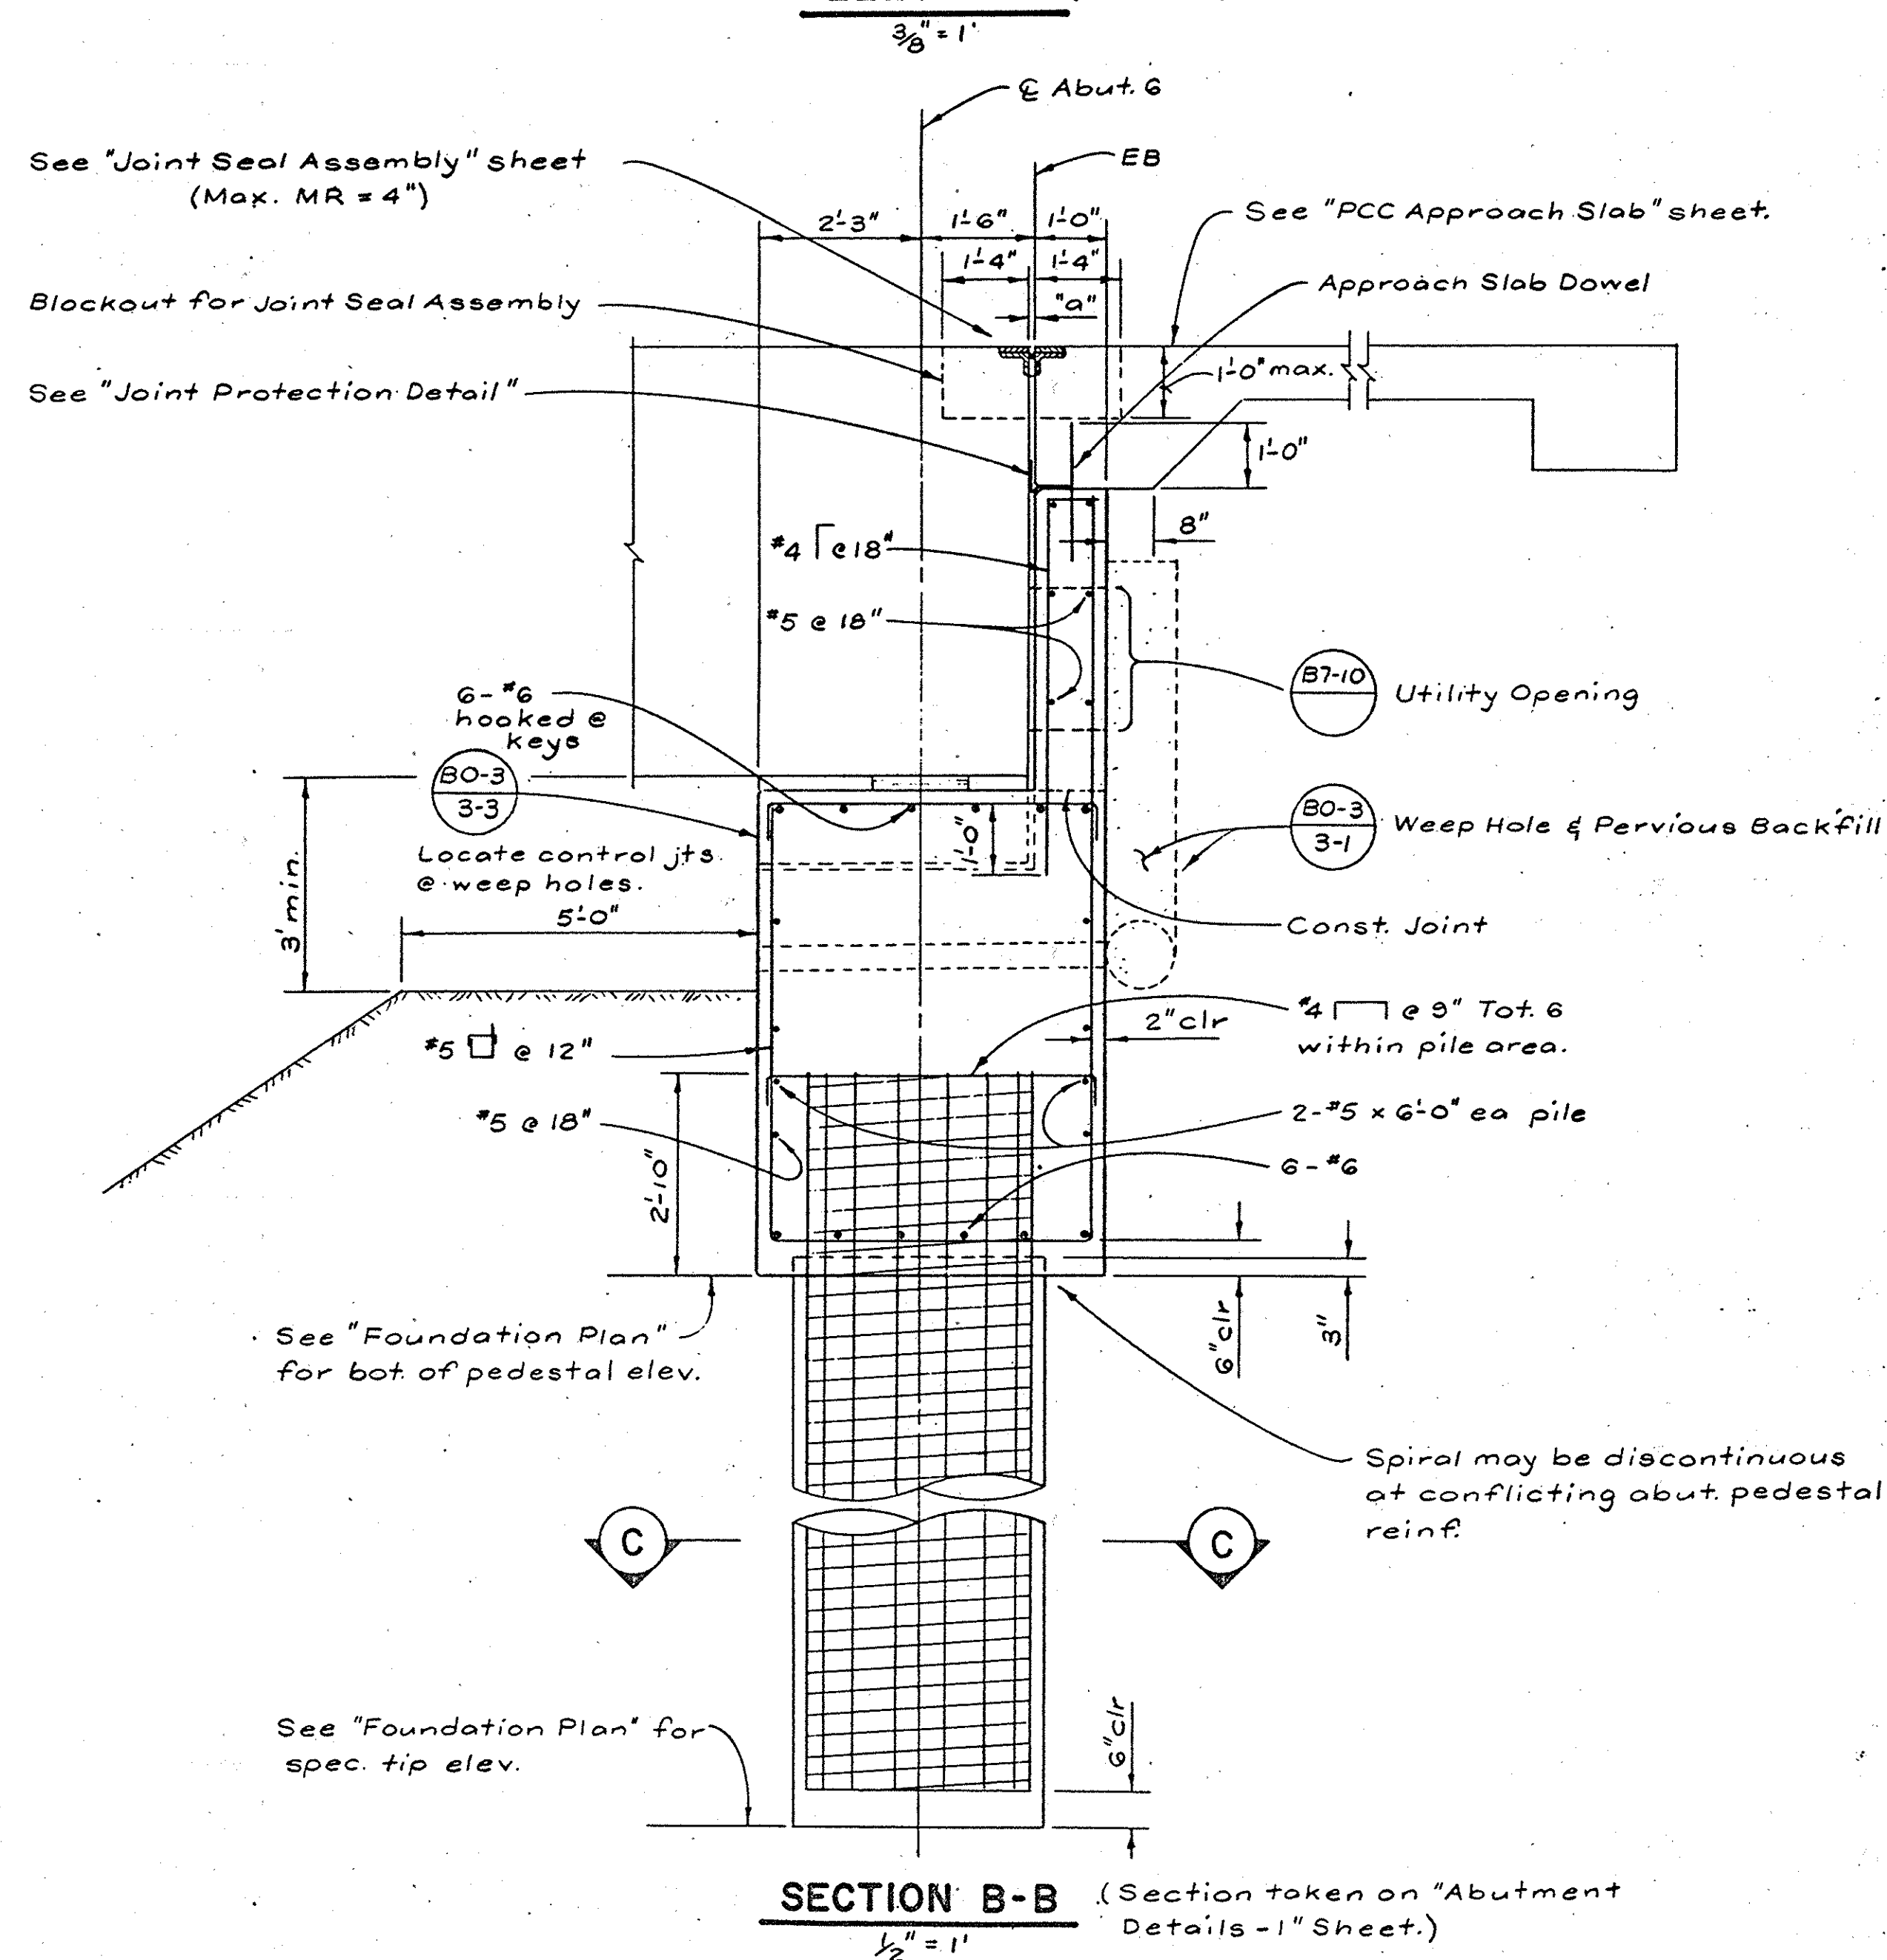
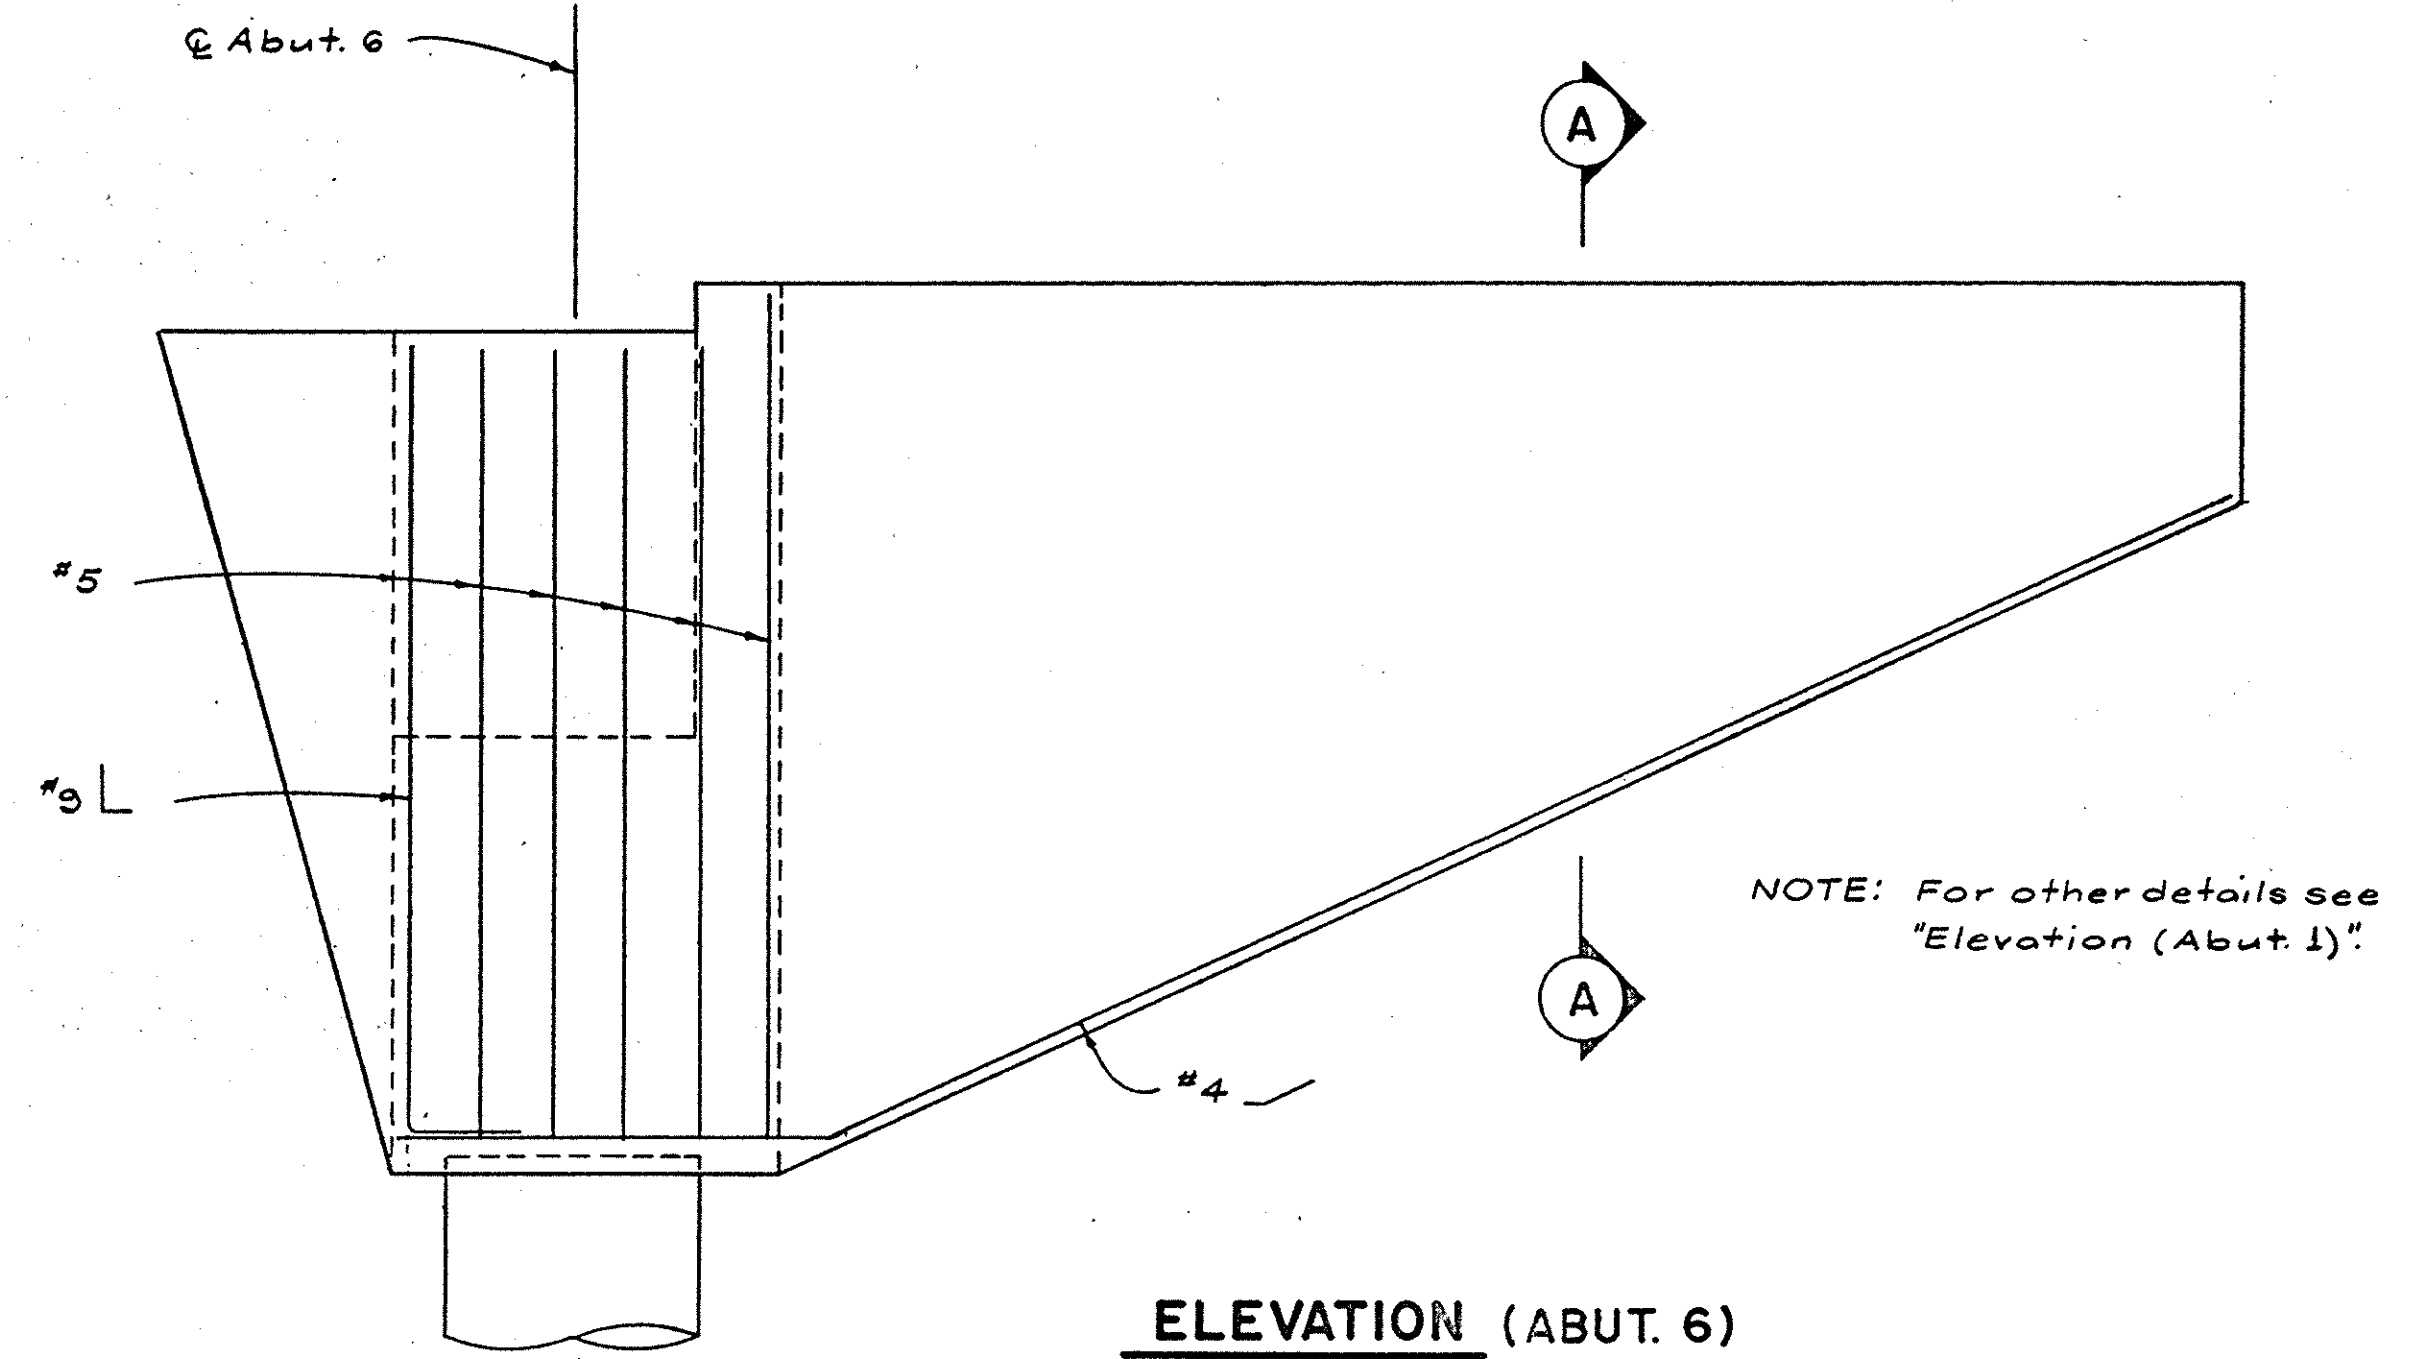
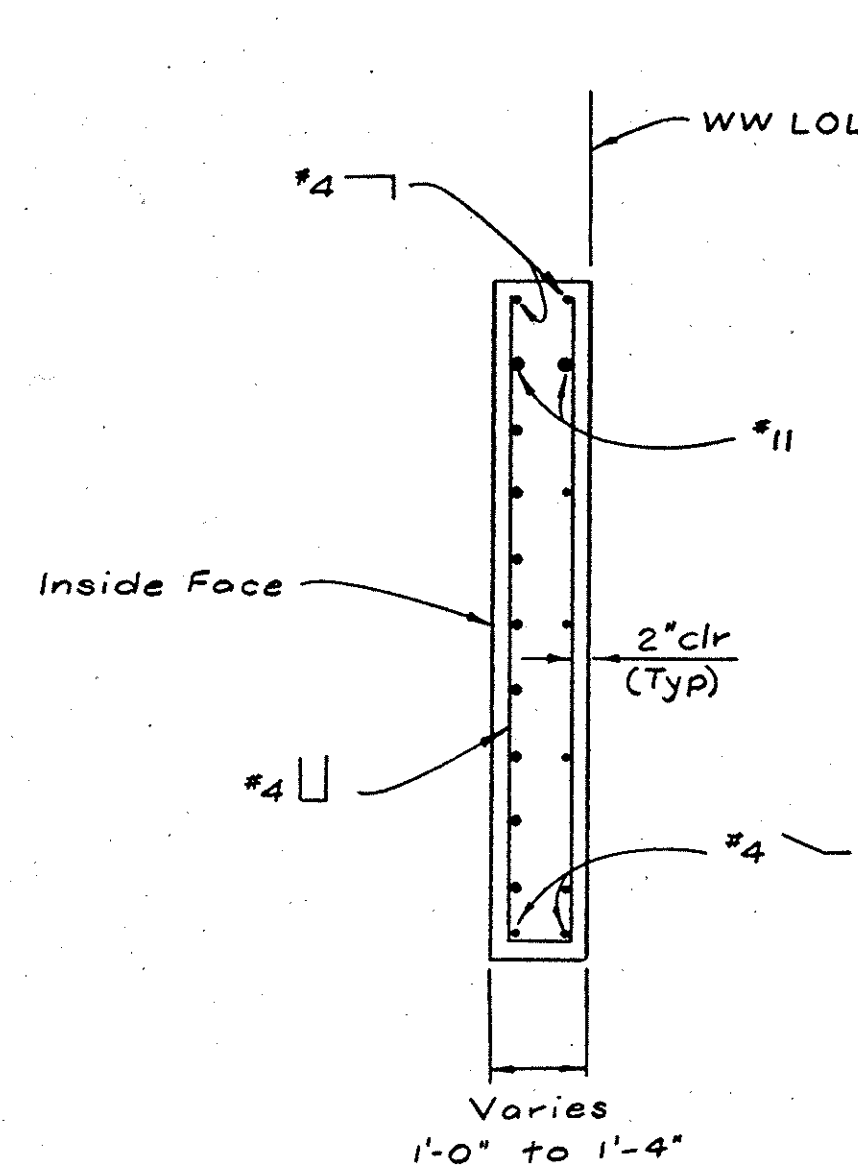


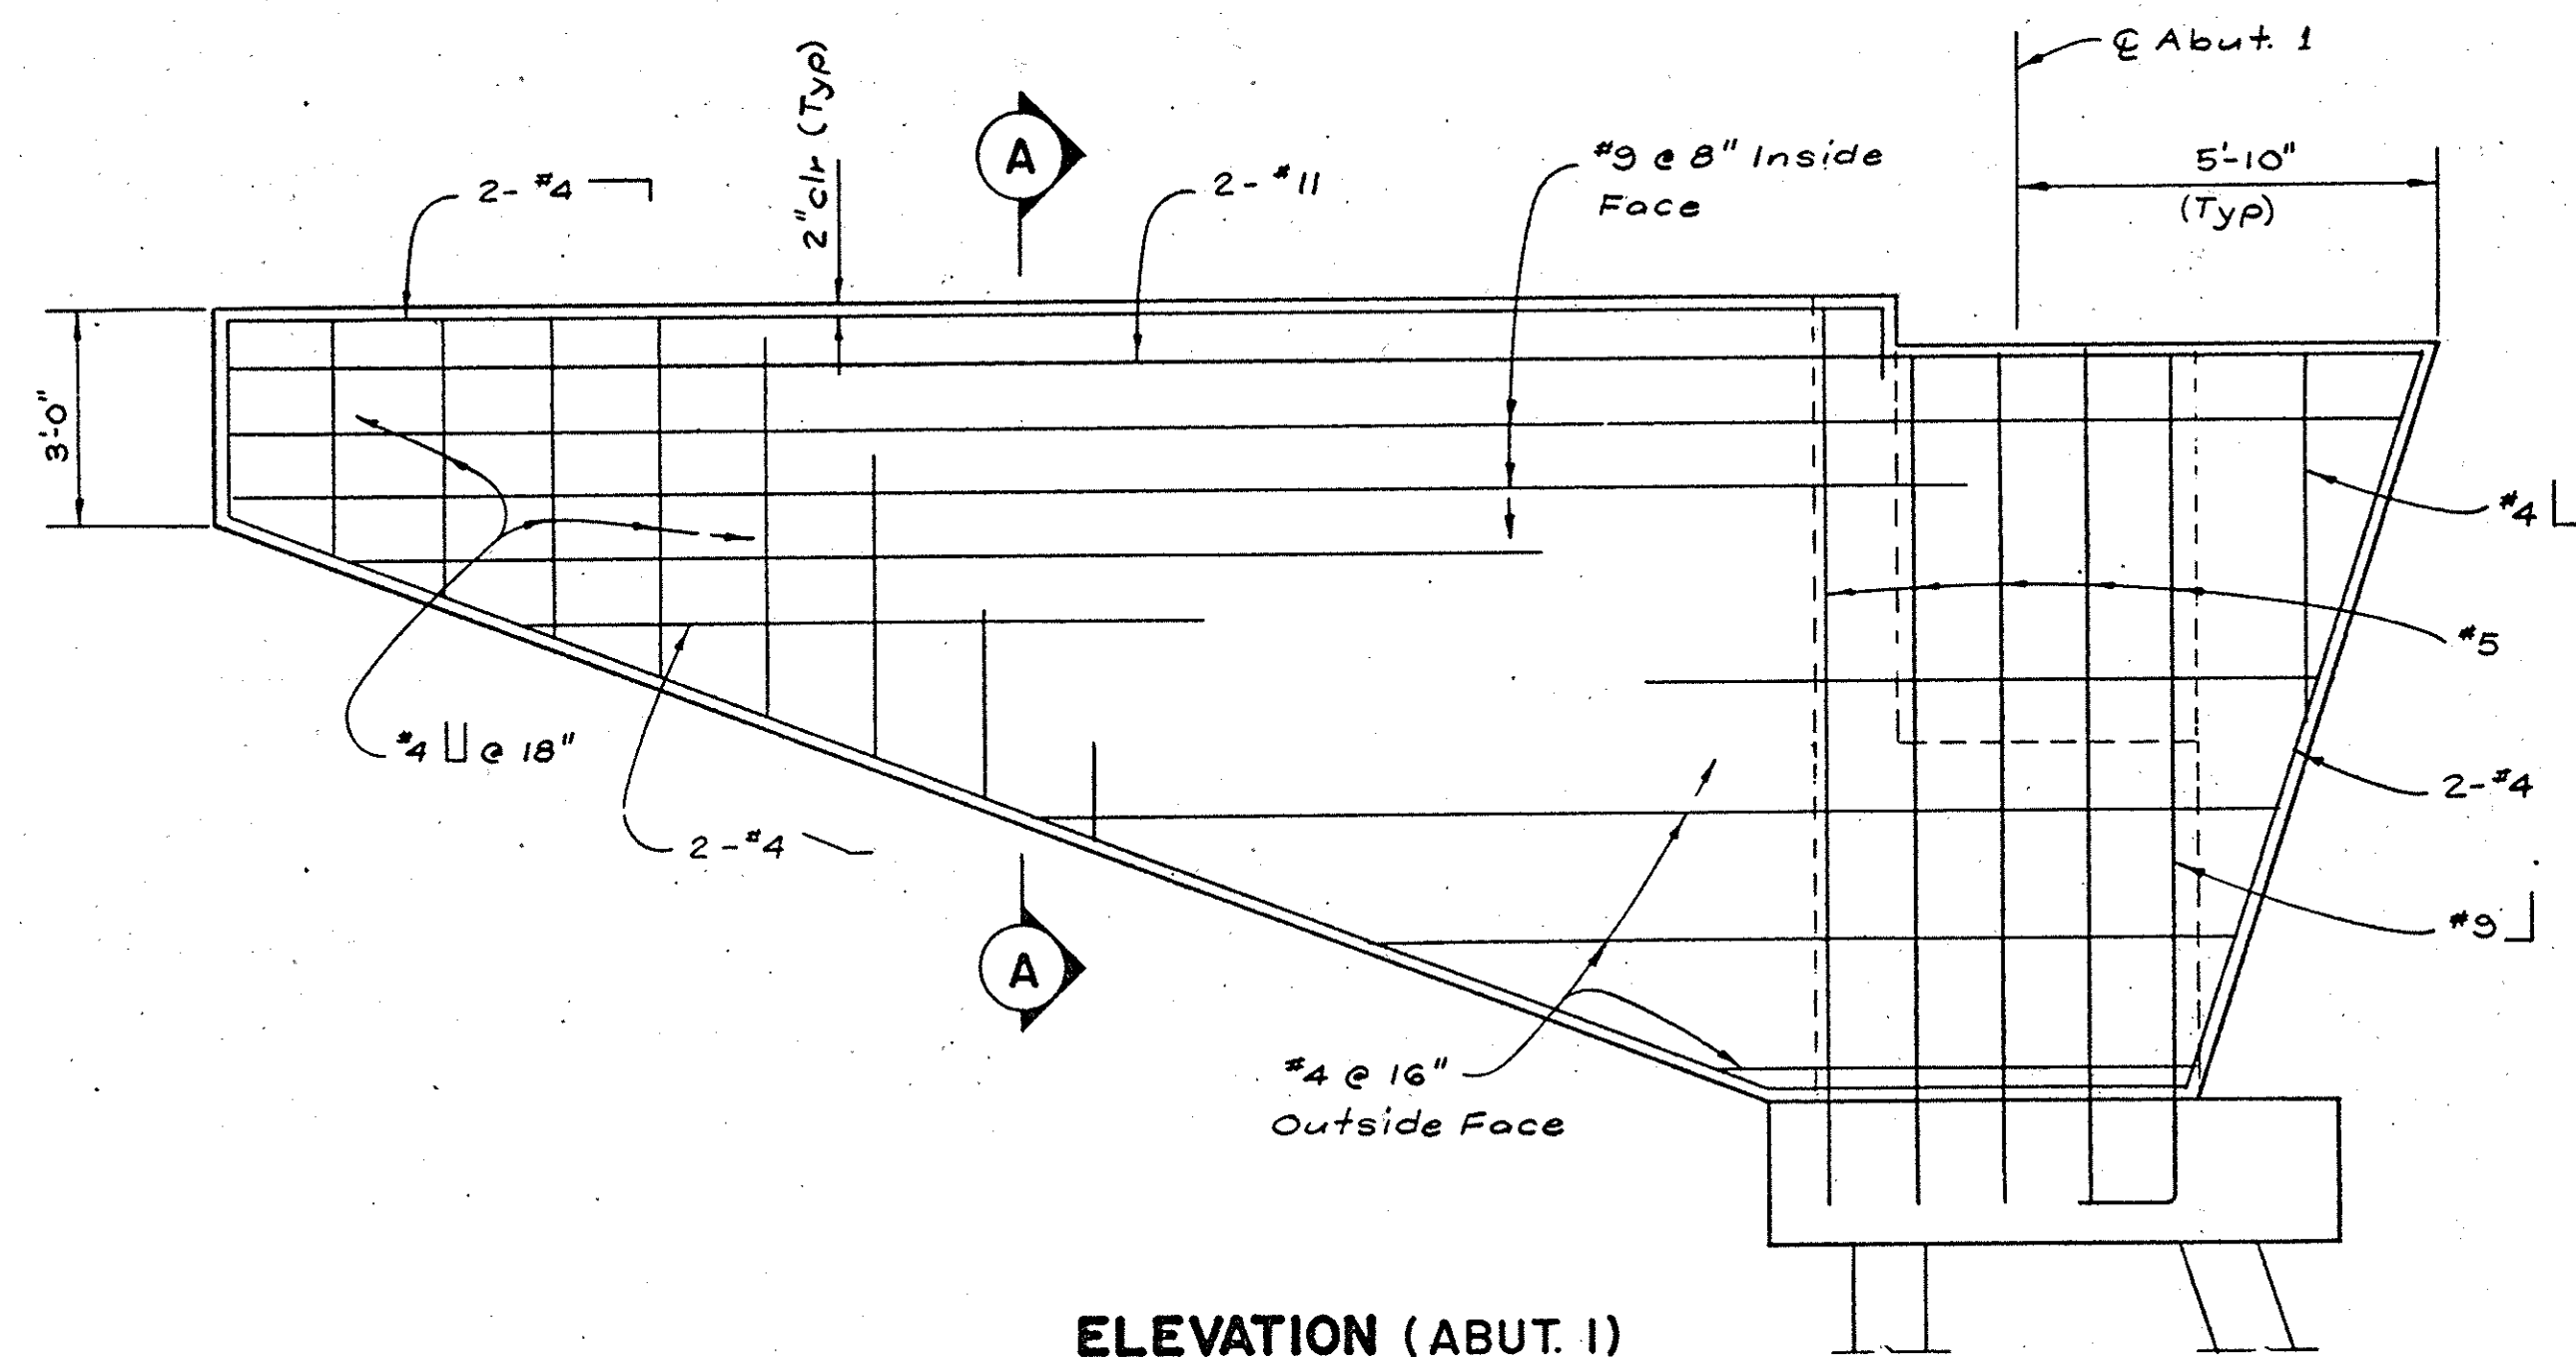

 **McDANIEL ENGINEERING COMPANY, INC.**
3080 OLD TOWN AVE., SUITE 207B, SAN DIEGO, CA 92110 • (619) 595-1020

ENGINEER OF WORK:
W. Mark Ashley C34299 9-30-91 8-
W. Mark Ashley RCE EXP D

			ORANGE COUNTY ENVIRONMENTAL MANAGEMENT AGENCY		
			OSO PARKWAY BRIDGE OVER ARROYO TRABUCO		
			ABUTMENT DETAILS-2		
MARK	DATE	DESCRIPTION	PREPARED UNDER SUPERVISION OF		SHEET
REVISIONS			DATE		45/76
DESIGNED			SCALE	DATE	
DRAWN			AS SHOWN	DWG. NO.	
CHECKED					