




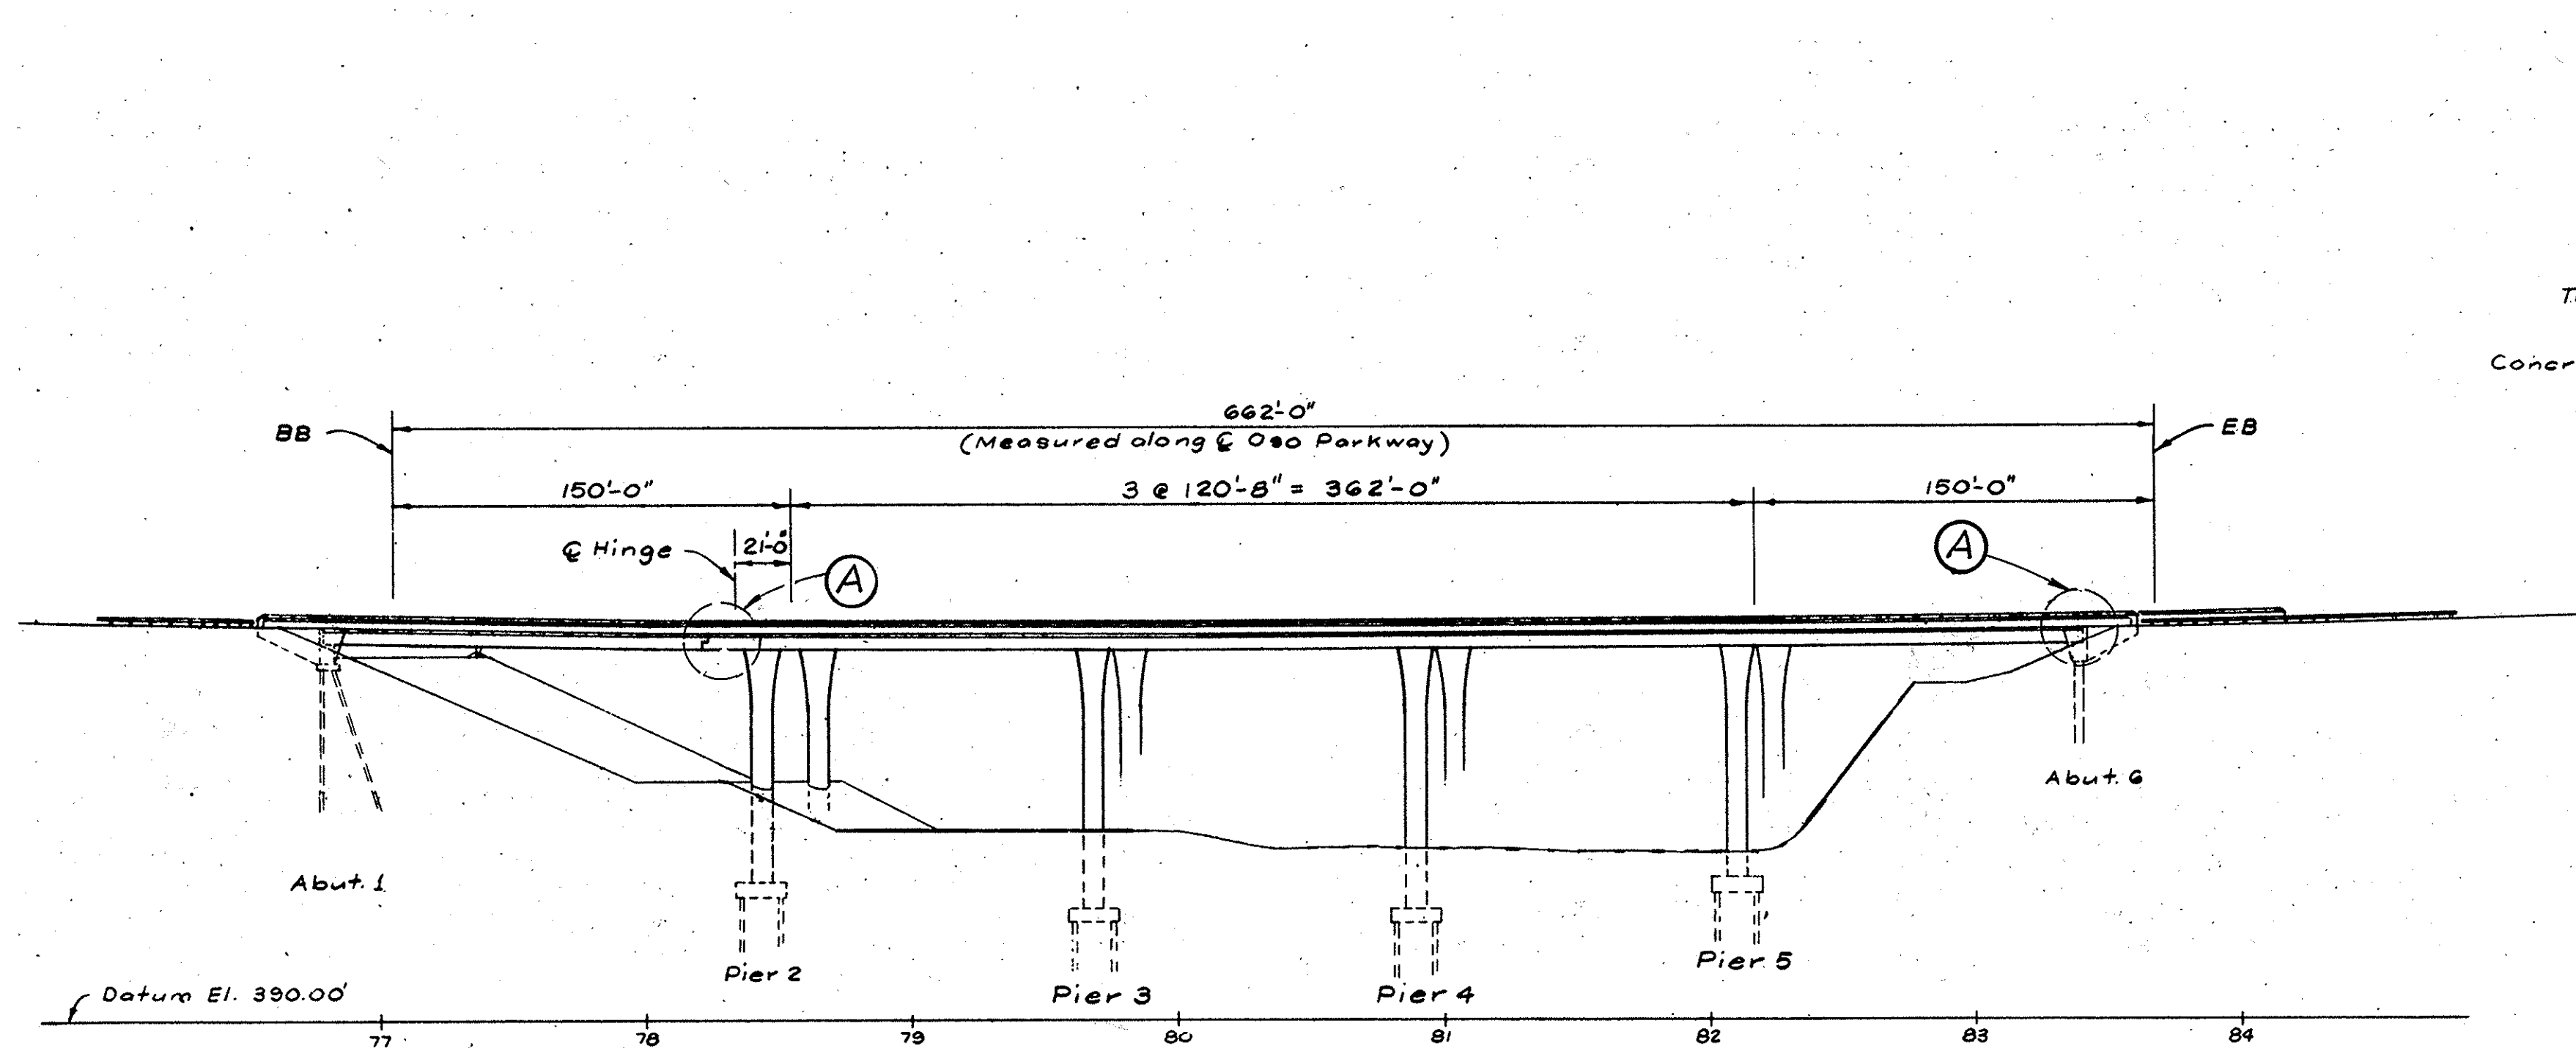

ELEVATION
1" = 50'

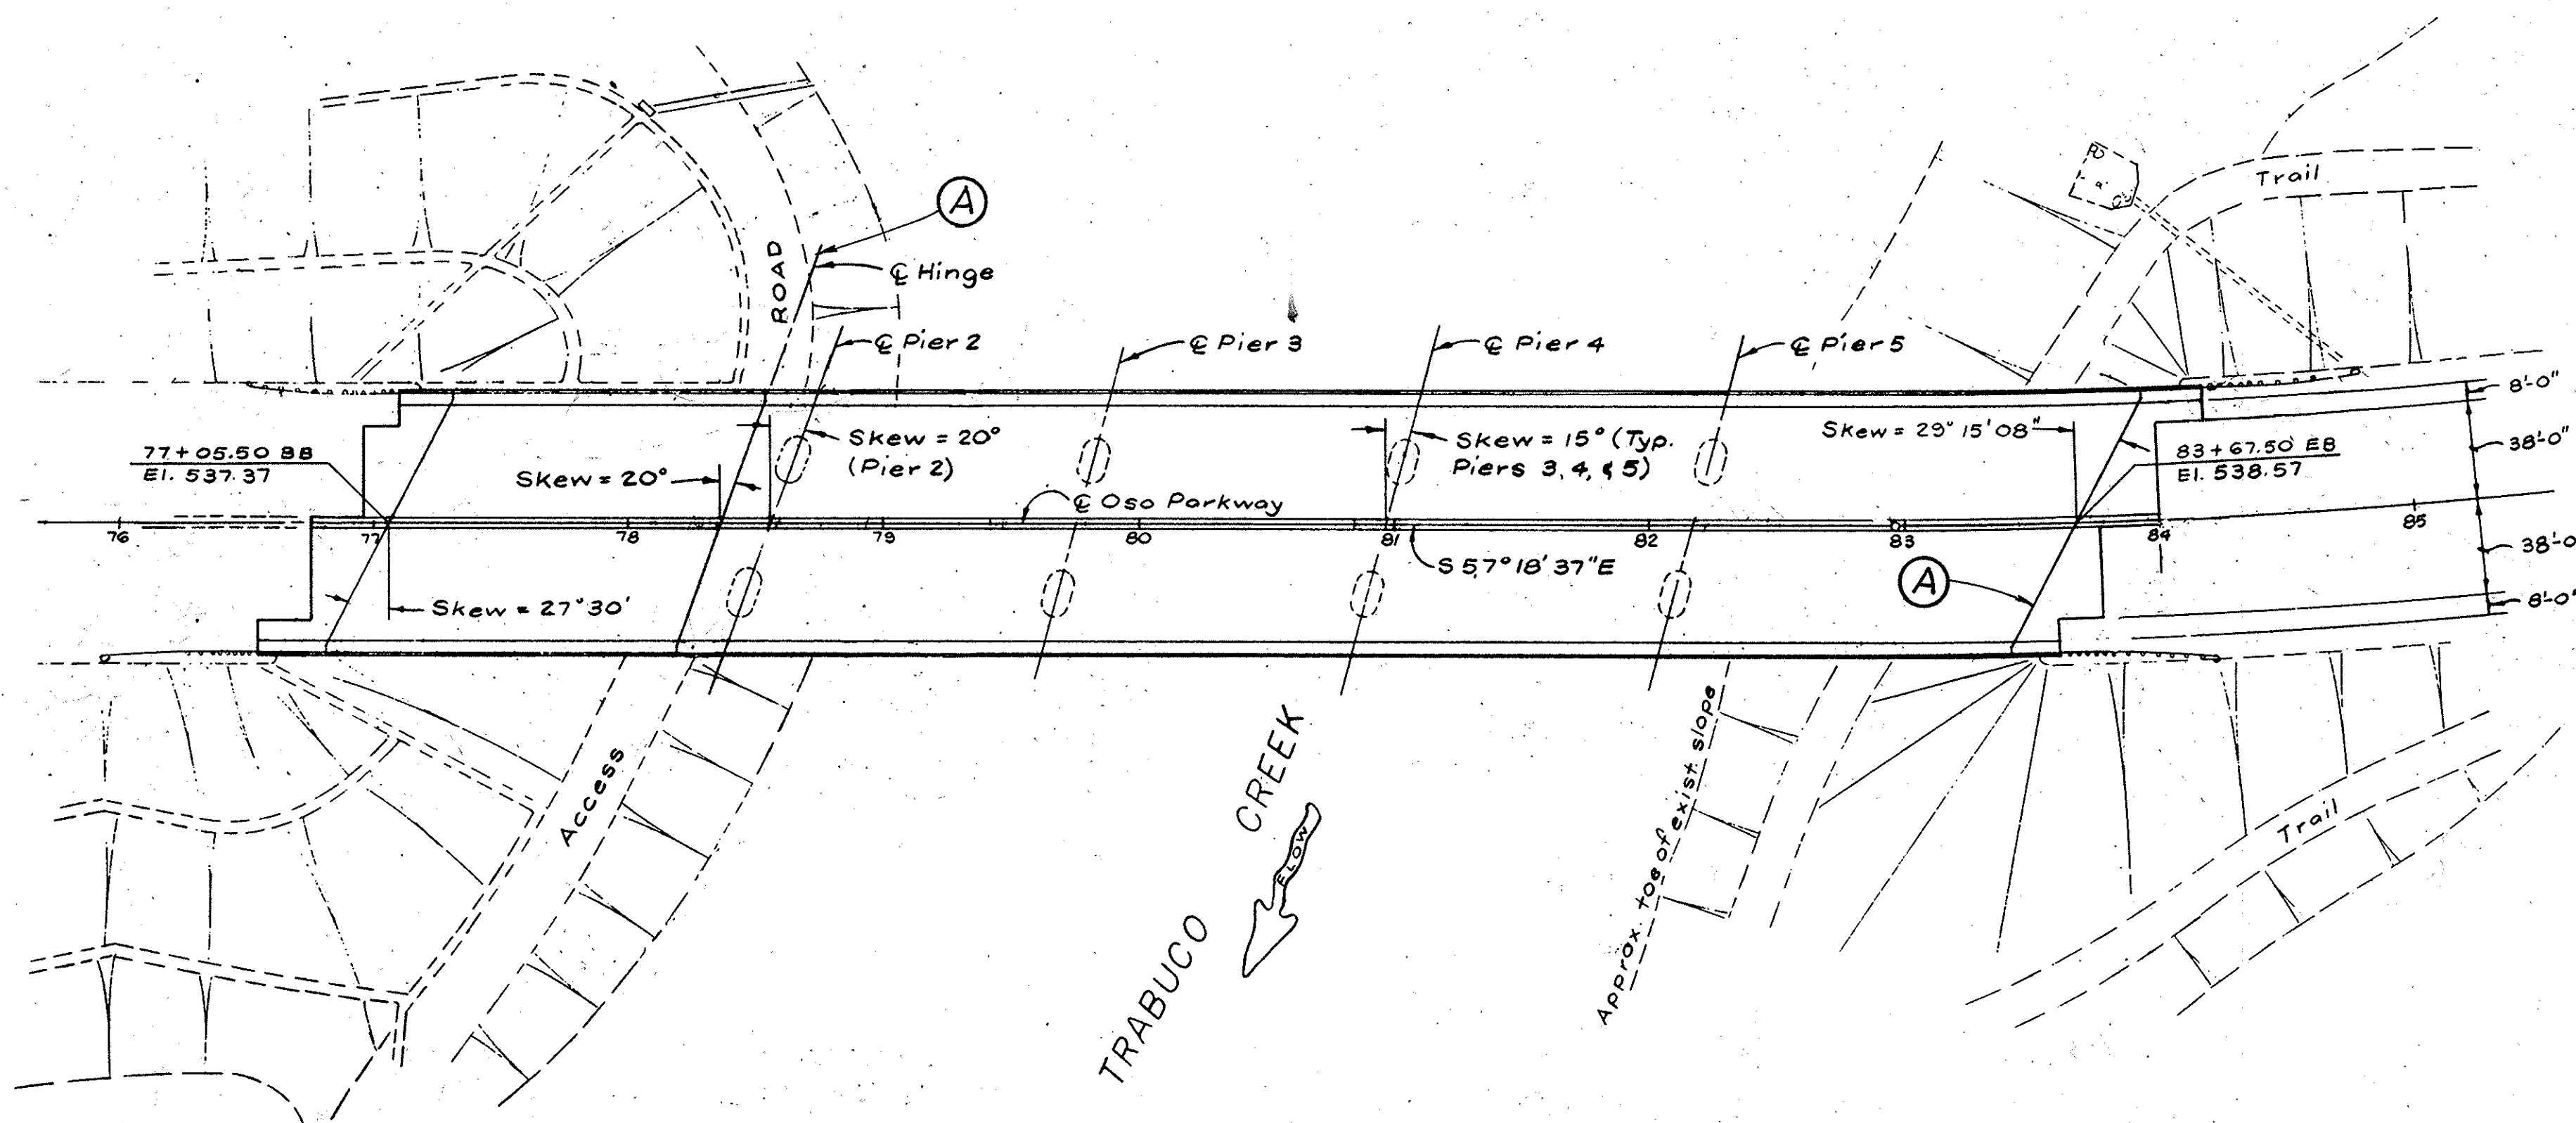

PLAN
1" = 50'

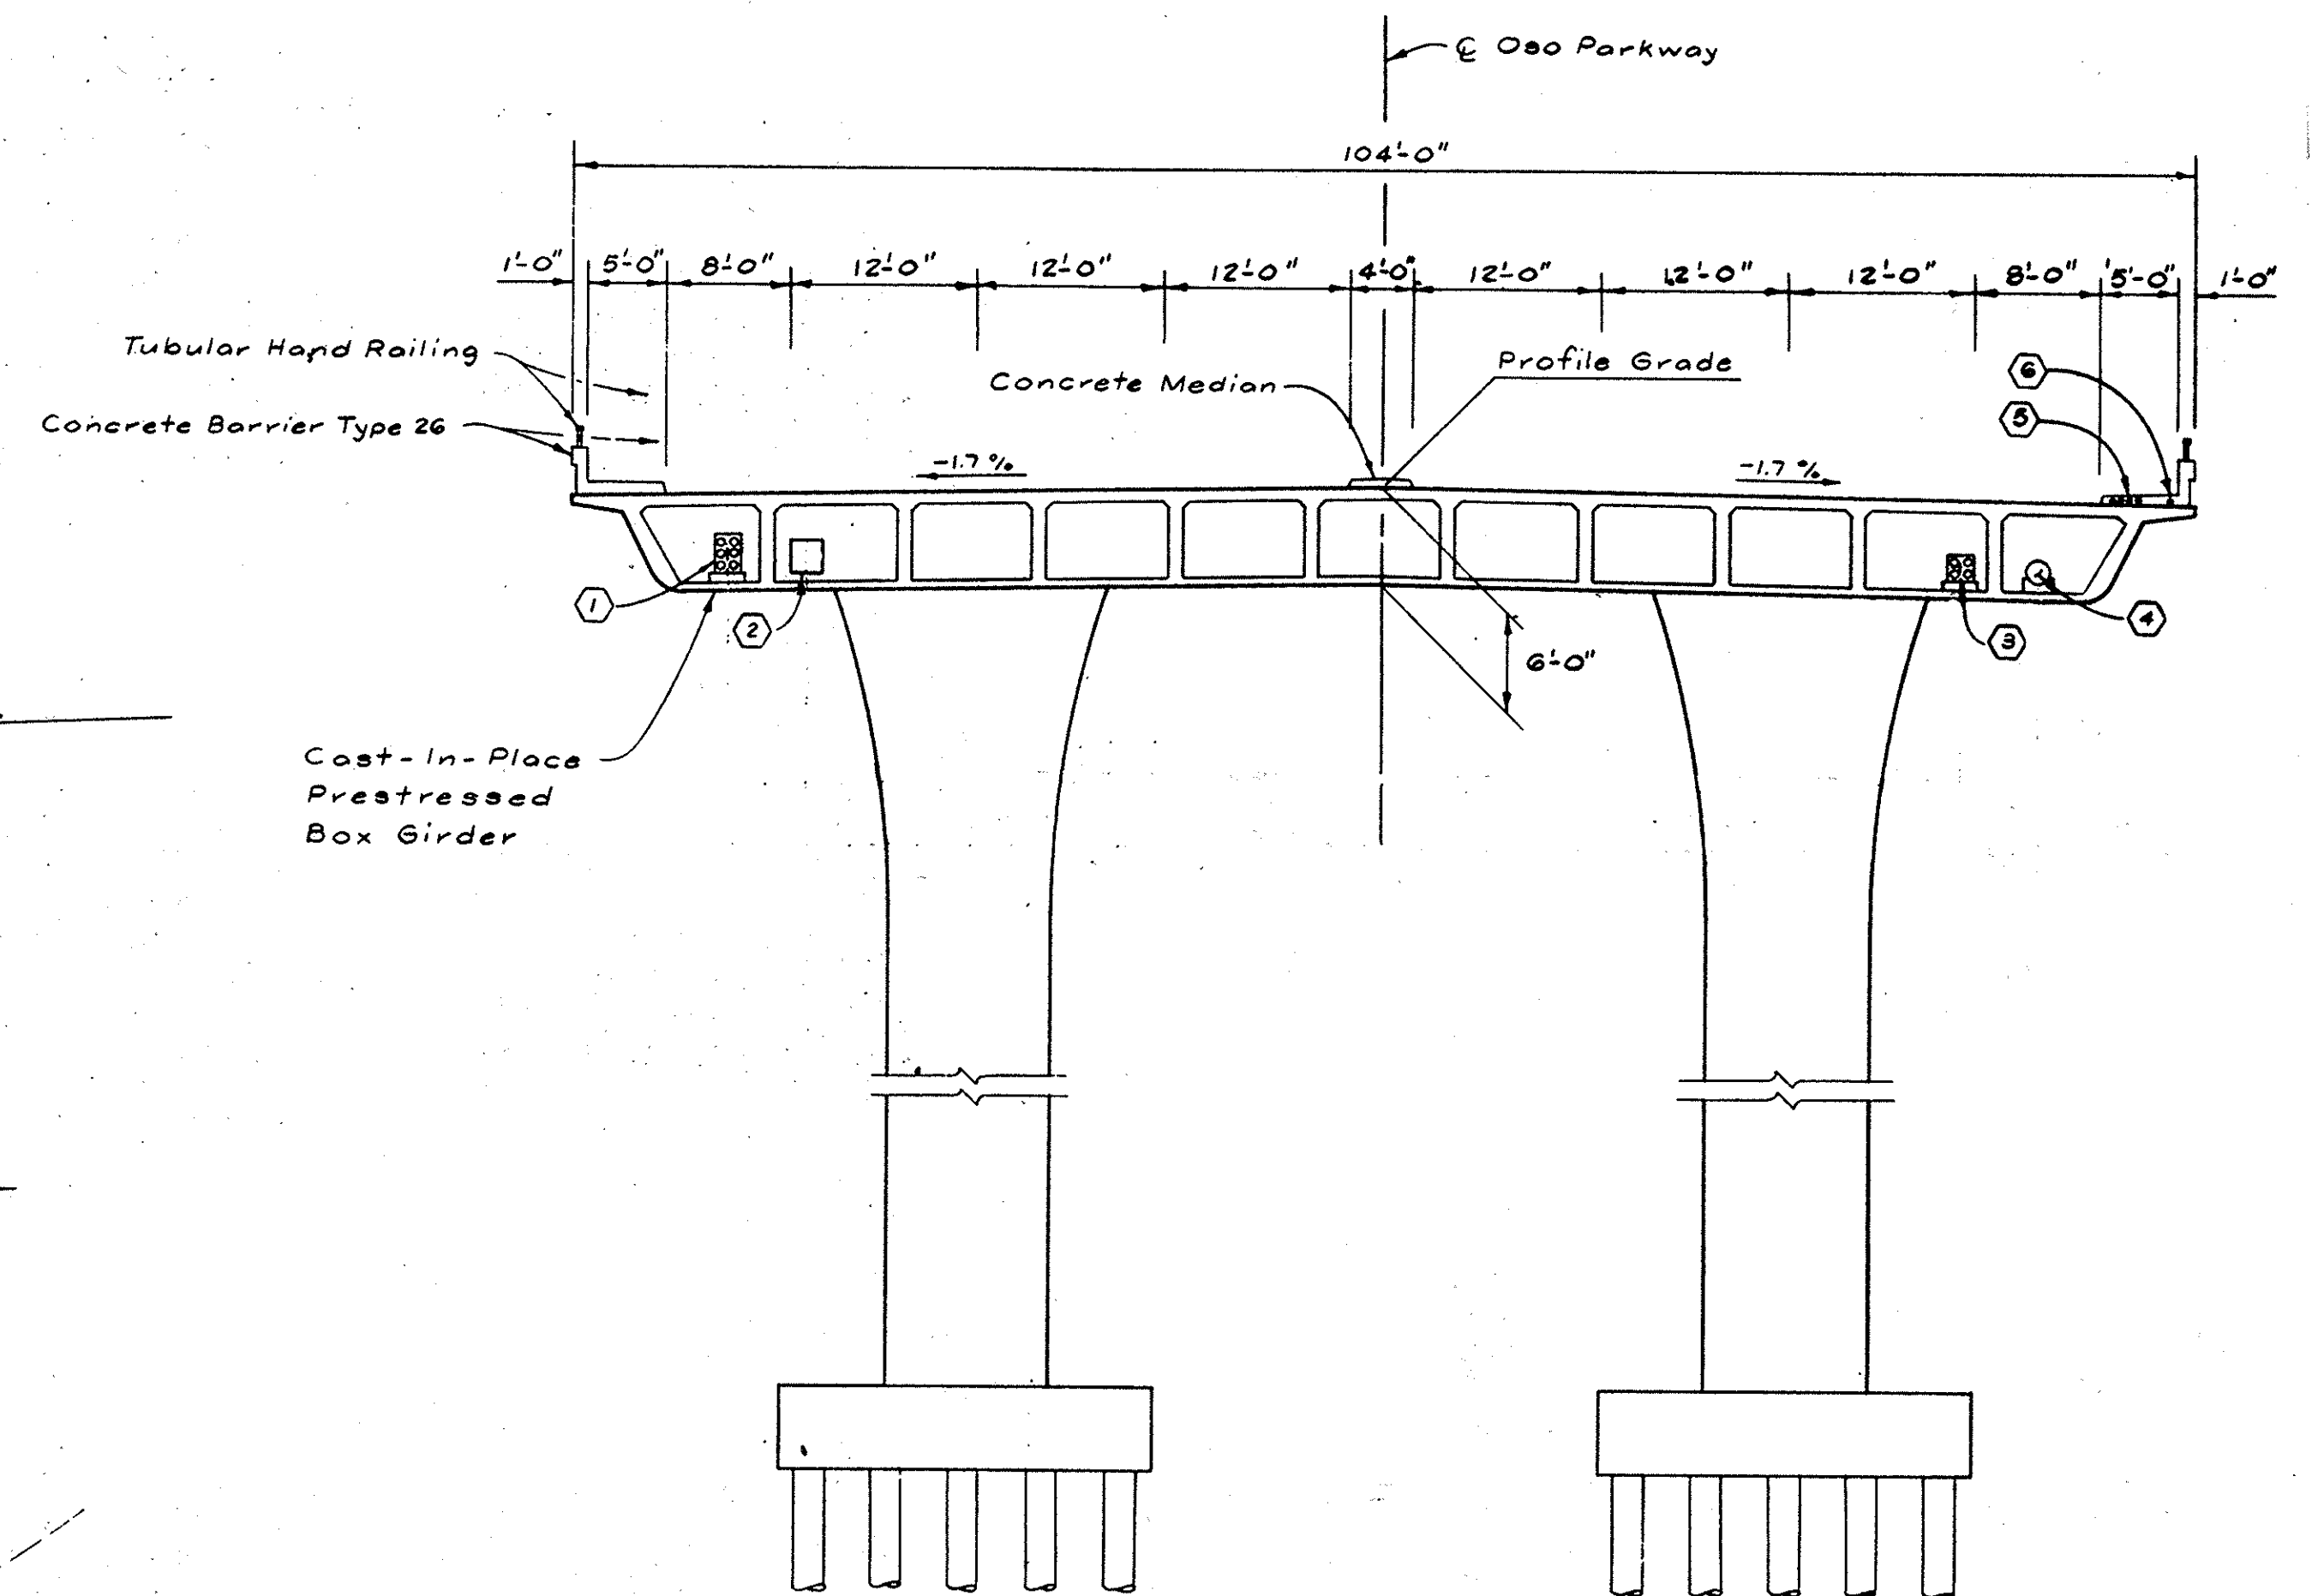

TYPICAL SECTION
1" = 10'

UTILITIES:

- ① - 6 - 4" dia. Telephone Ducts, 24" H x 18" W Openings, Pac. Bell
- ② - 2'-0" x 2'-0" Openings for future utilities.
- ③ - 4 - 5" dia. Electric Conduits, 18" H x 20" W Openings, SDG&E
- ④ - 10" I.D. Gas Main w/ 18" dia. casing, 24" H x 24" W Opening
The Gas Co.
- ⑤ - 4-2" Cable TV Conduits, Cox Communications
- ⑥ - 1-2" Signalization Conduit, and
1-2" Street Lighting Conduit

- Ⓐ - JOINT SEAL ASSEMBLY REPLACEMENT
(HINGE AND ABUT. 6)

RECORD DRAWING

1 1/2 0 1 2
3 inches on original drawing



ORANGE COUNTY ENVIRONMENTAL MANAGEMENT AGENCY	
OSO PARKWAY BRIDGE OVER ARROYO TRABUCO	
GENERAL PLAN	
MARK DATE	DESCRIPTION
3/8/01	No As-Built Cms
DESIGNED R. Hunsinger	CHECKED E. Kwan
DRAWN H. PARRA	AS SHOWN
PREPARED UNDER SUPERVISION OF	DATE
SCALE	DWG. NO.
DATE	2
OF 5	

R. H. Hunsinger
4/24/01