



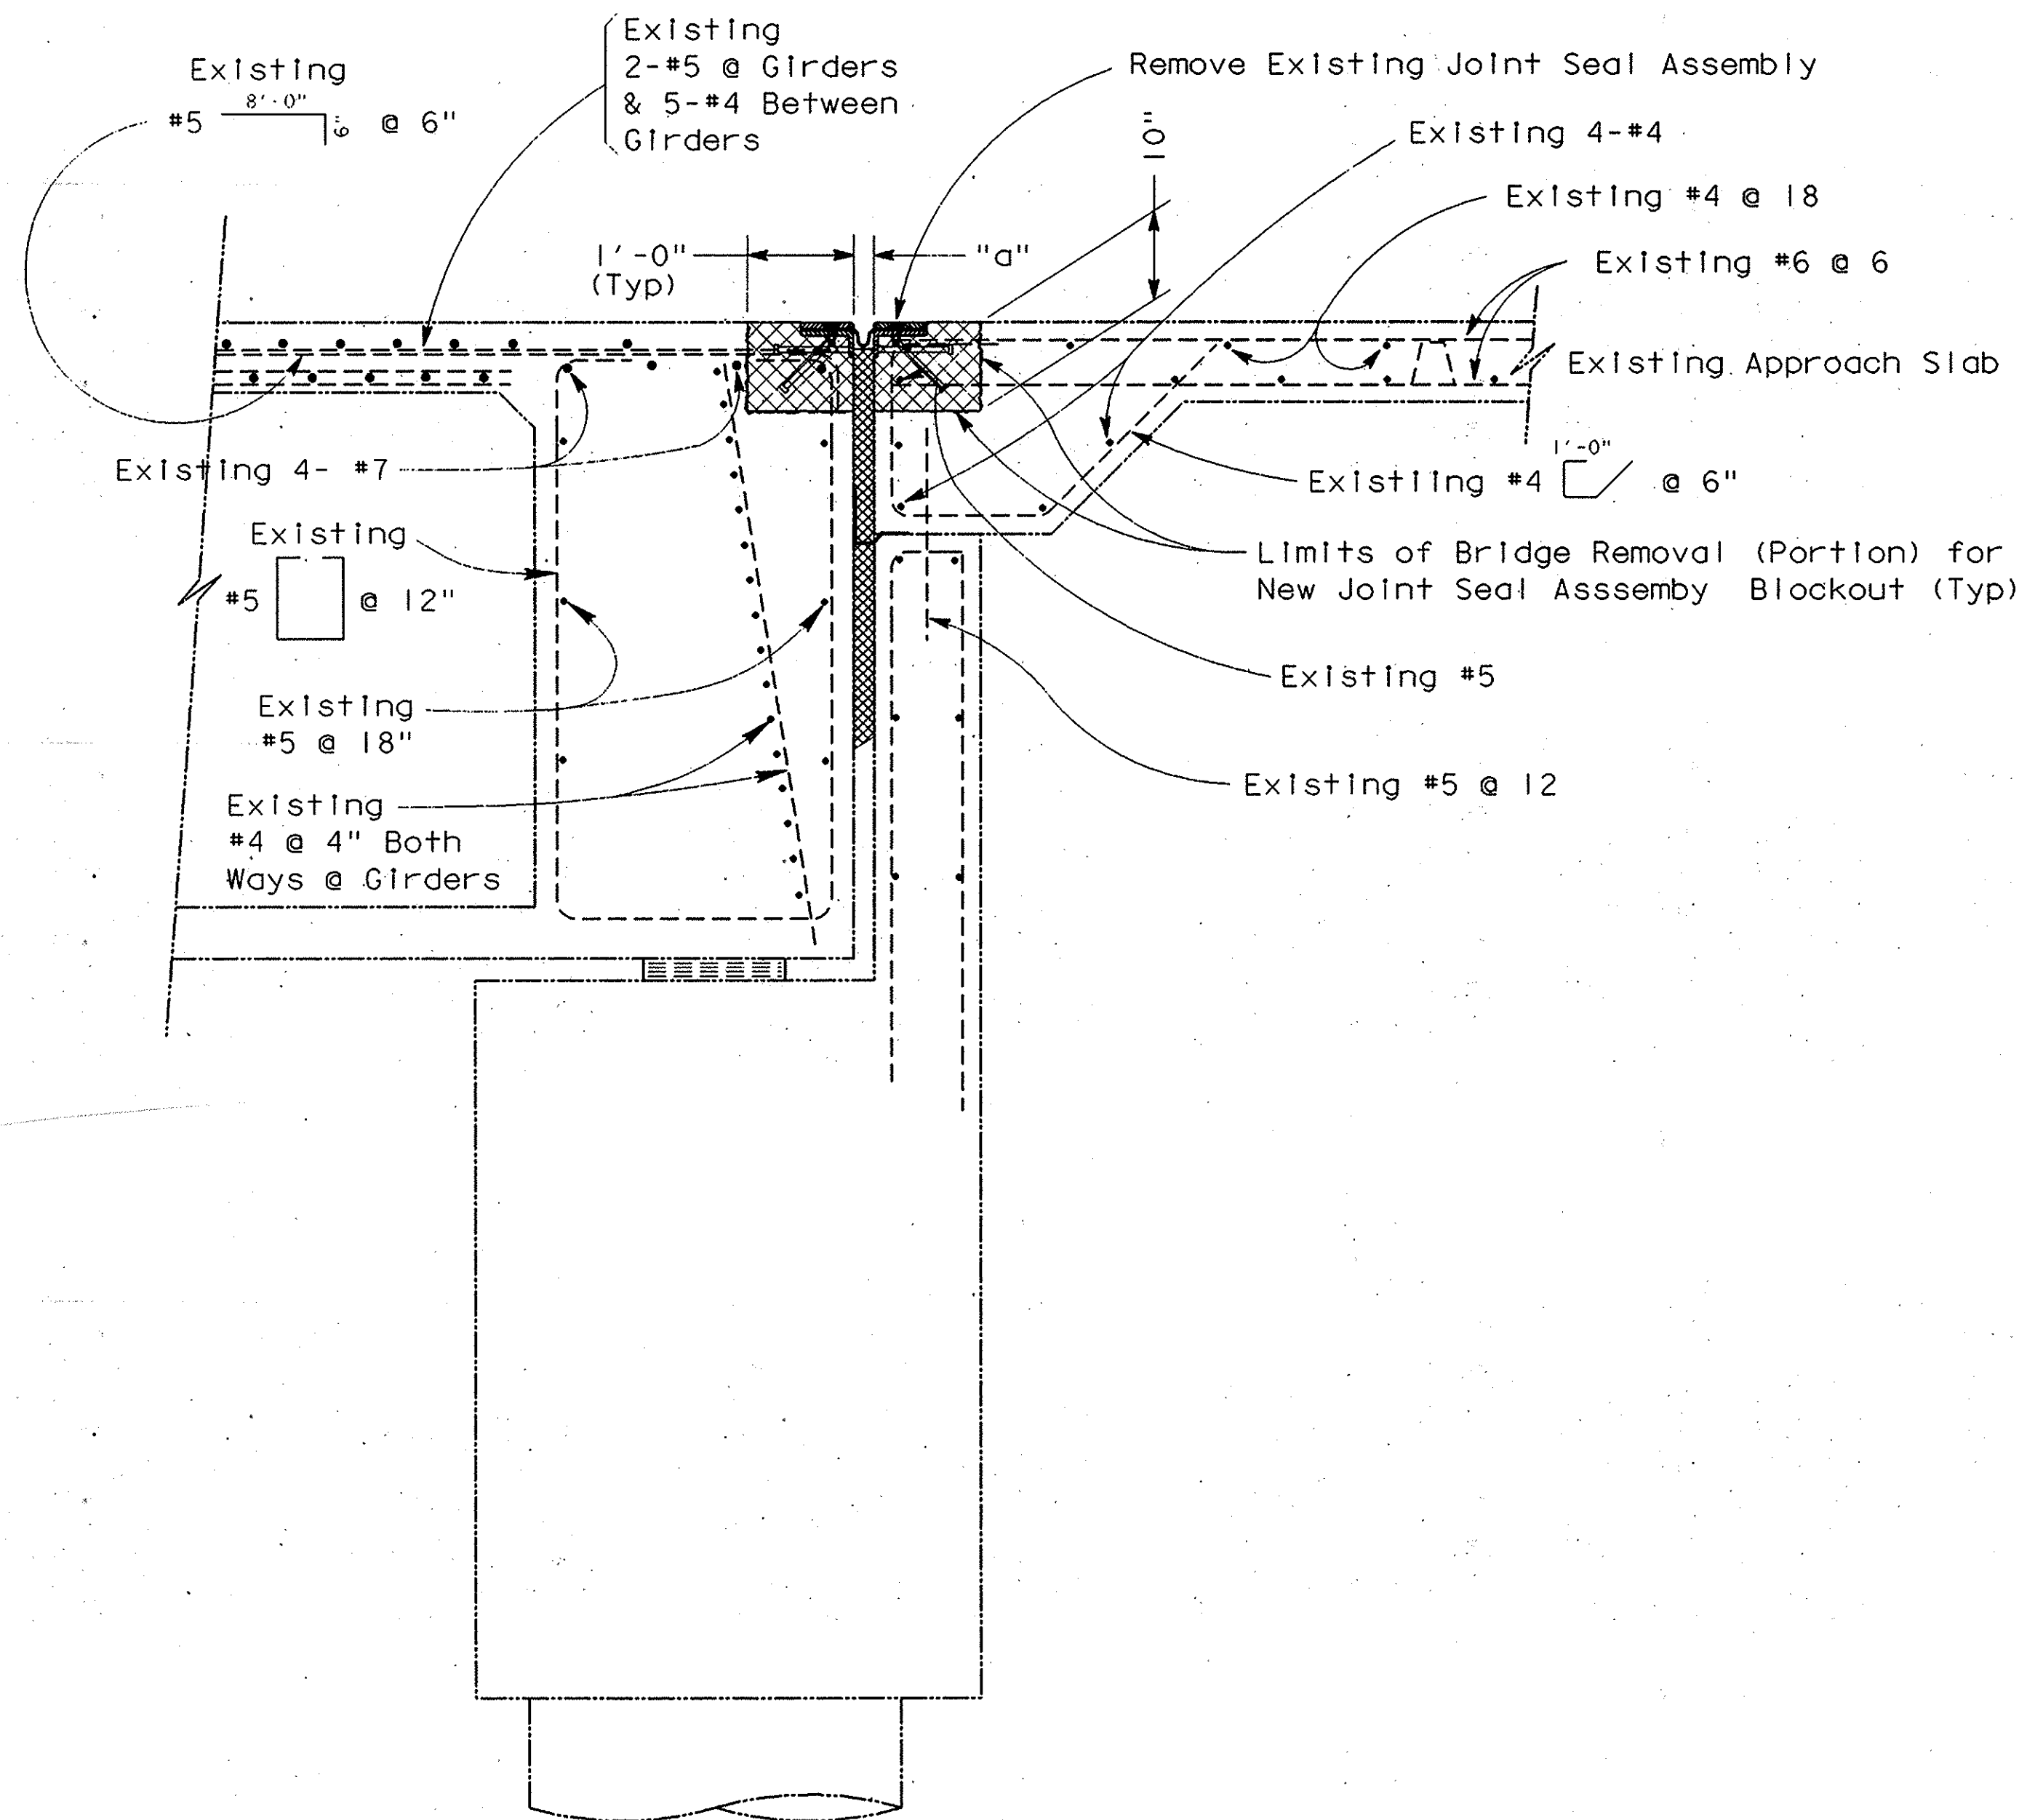

TYPICAL EXISTING ABUTMENT #6 SECTION

$\frac{3}{4}" = 1'-0"$

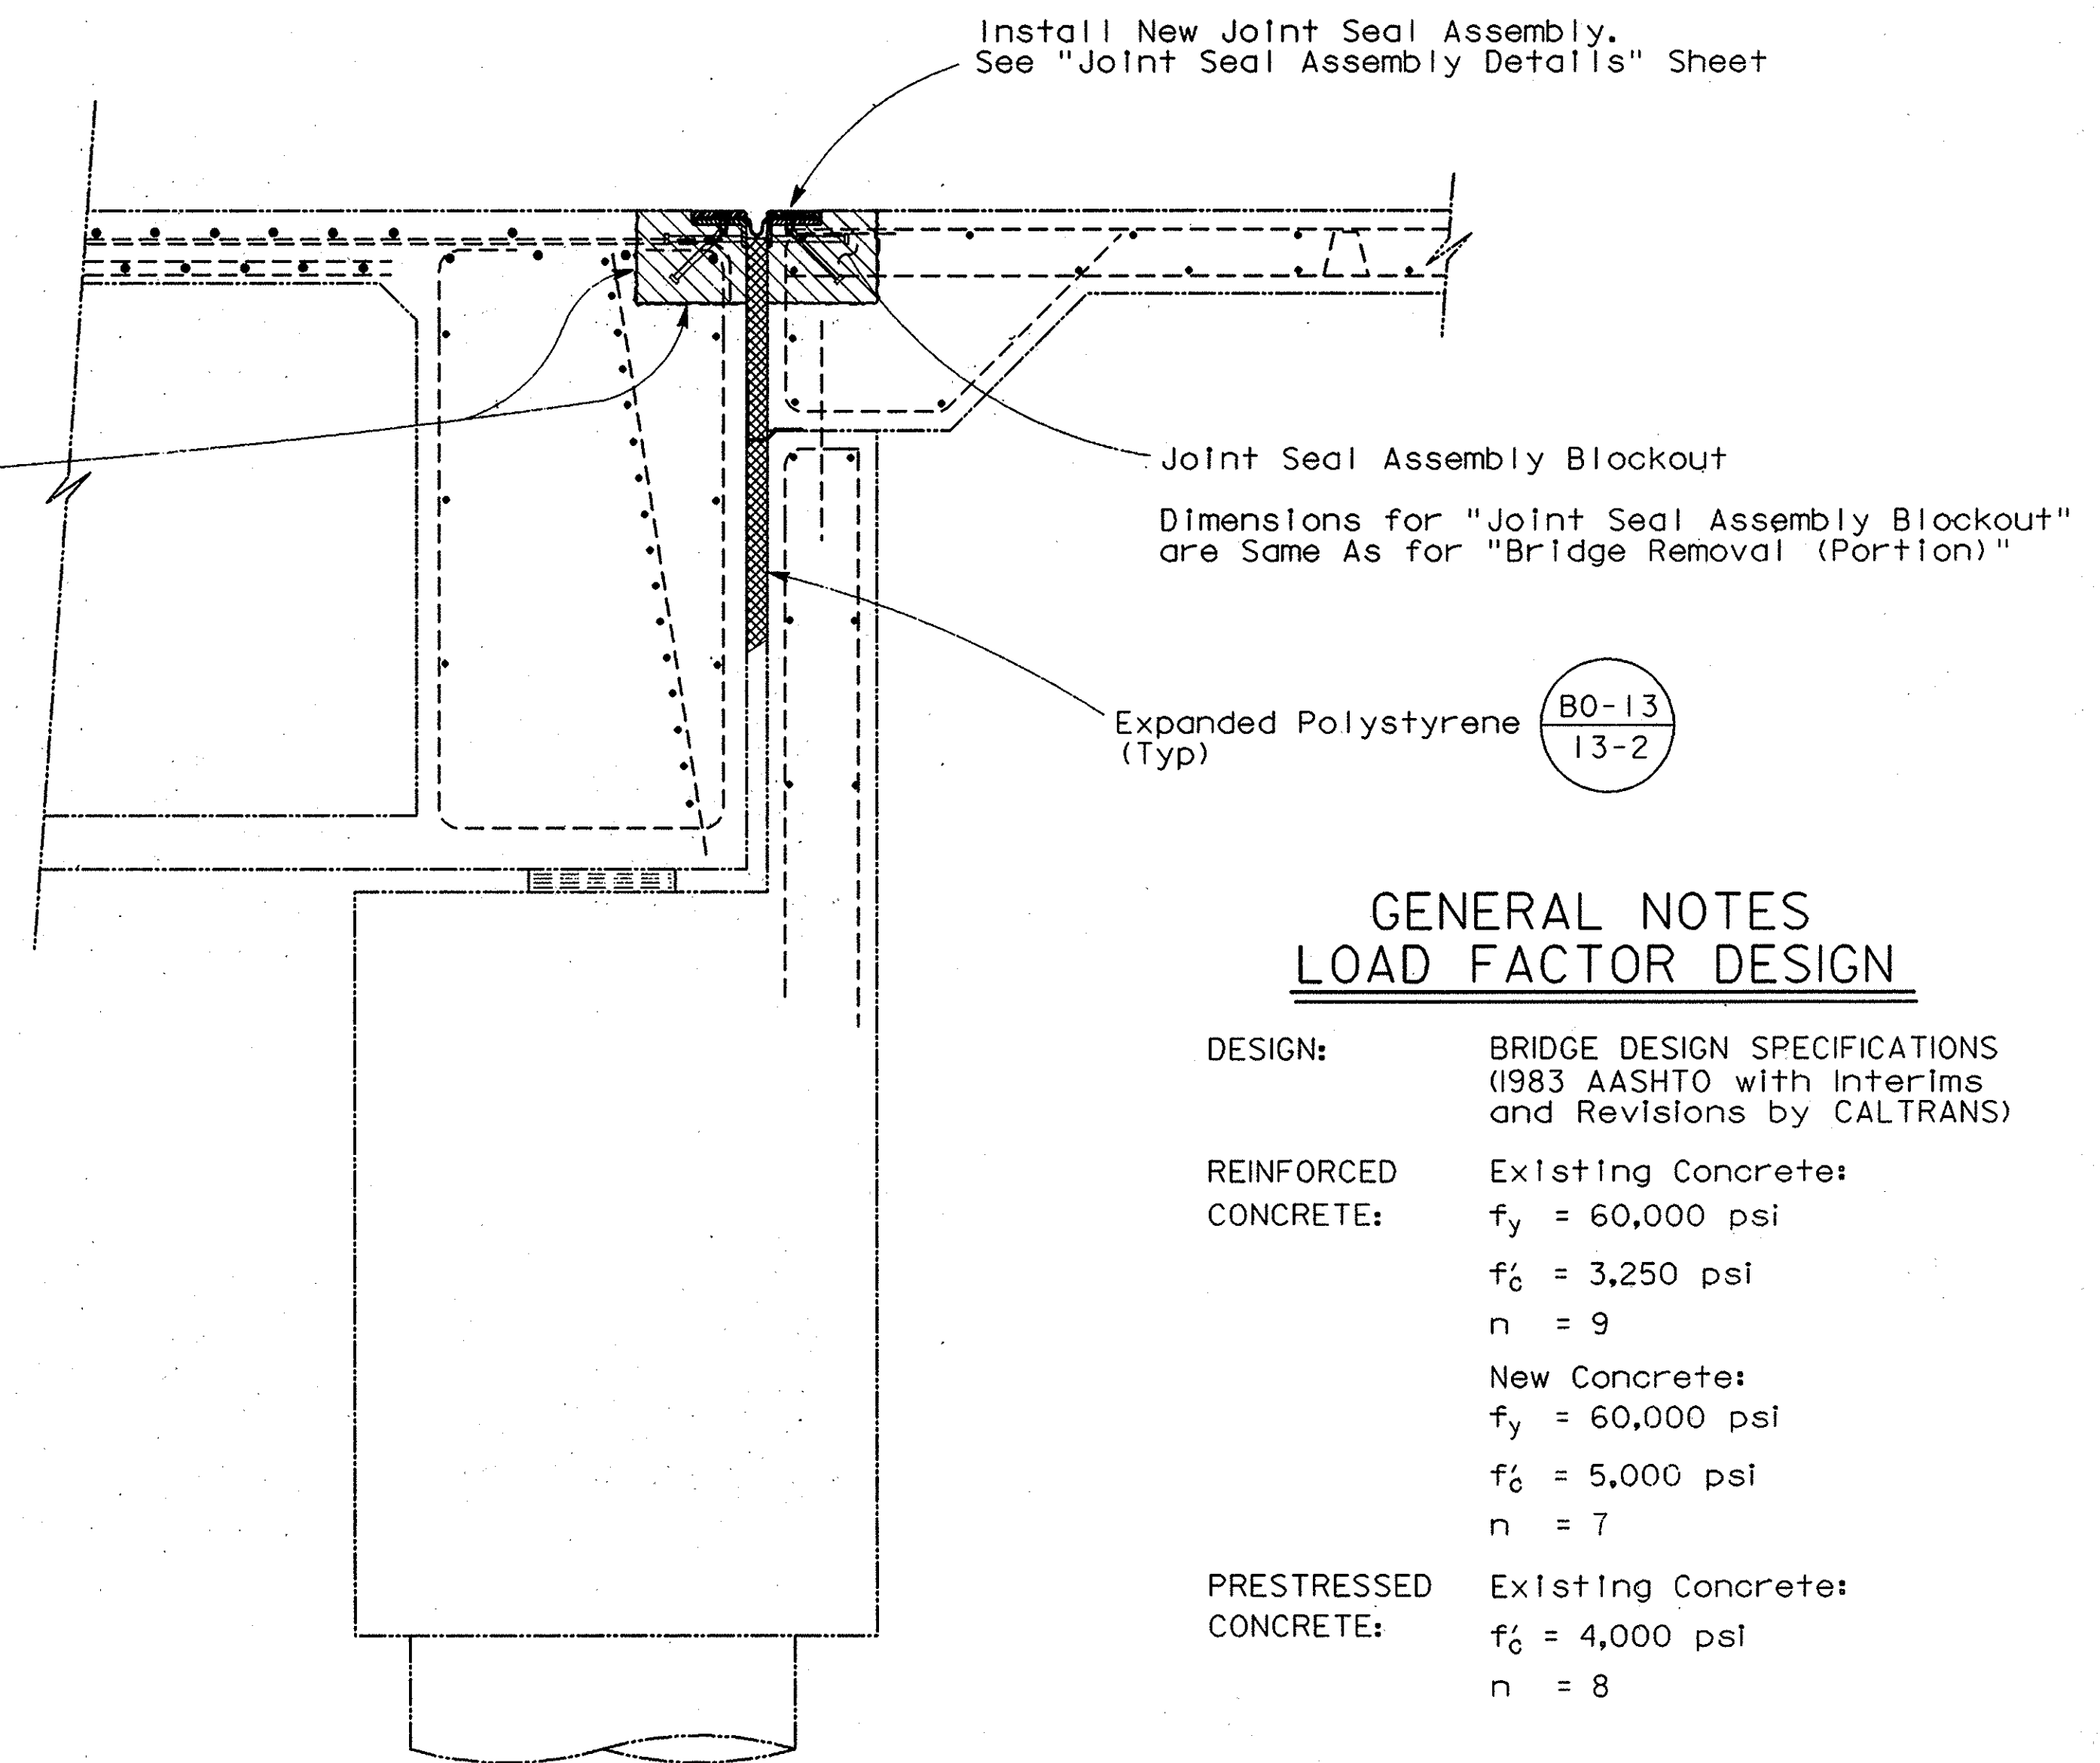

TYPICAL EXISTING ABUTMENT #6 SECTION

WITH NEW JOINT SEAL ASSEMBLY

$\frac{3}{4}" = 1'-0"$

GENERAL NOTES LOAD FACTOR DESIGN

DESIGN:	BRIDGE DESIGN SPECIFICATIONS (1983 AASHTO with Interims and Revisions by CALTRANS)
REINFORCED CONCRETE:	Existing Concrete: $f_y = 60,000$ psi $f'_c = 3,250$ psi $n = 9$ New Concrete: $f_y = 60,000$ psi $f'_c = 5,000$ psi $n = 7$
PRESTRESSED CONCRETE:	Existing Concrete: $f'_c = 4,000$ psi $n = 8$

NOTES:

- All Existing Reinforcing Steel Shall Remain Undamaged & Shall be Carefully Protected in Place During Concrete Removal Operations. Any Existing Reinforcing Steel Damaged by the Contractor Shall be Repaired by the Contractor as Specified in the Special Provisions.
- For Dimension "a", Match Existing. See Also "Joint Information" Table on "Joint Seal Assembly Details" Sheet.
- Concrete Strength: All Concrete Shall Be $f'_c = 5000$ psi.

NOTE:
ALL DIMENSIONS ON THIS SHEET
ARE NORMAL TO JOINT CENTERLINE

NOTE:
THE CONTRACTOR SHALL VERIFY ALL
CONTROLLING FIELD DIMENSIONS
BEFORE ORDERING OR FABRICATING
ANY MATERIAL.

LEGEND:

	Bridge Removal (Portion)
	Joint Seal Assembly Blockout
	Denotes Existing Structure
	Denotes Existing Reinforcing Steel
	Denotes New Construction

RECORD DRAWING

ORANGE COUNTY PUBLIC FACILITIES AND RESOURCES DEPARTMENT	
ABUTMENT DETAILS	
DESIGNED: Rich Holsington	SHEET 3 OF 5
DRAWN: Rich Holsington	CHECKED: Ed Kinn
SCALE: AS SHOWN	DATE: 4/17/01
DRAWING NO.	

PREPARED UNDER RESPONSIBLE CHARGE OF:

PROFESSIONAL
REGISTERED
CIVIL
ENGINEER
RICHARD W.
HOLSINGTON, JR.
No. 042287
Exp. 3/31/04
DATE: 4/26/01