



ORANGE COUNTY ROAD DEPT.


STATE OF CALIFORNIA

PLANS FOR CONSTRUCTION ON

NEWPORT BLVD.


BRIER LN. TO CHAPMAN AVE.

A DISTANCE OF 1.81 MILES

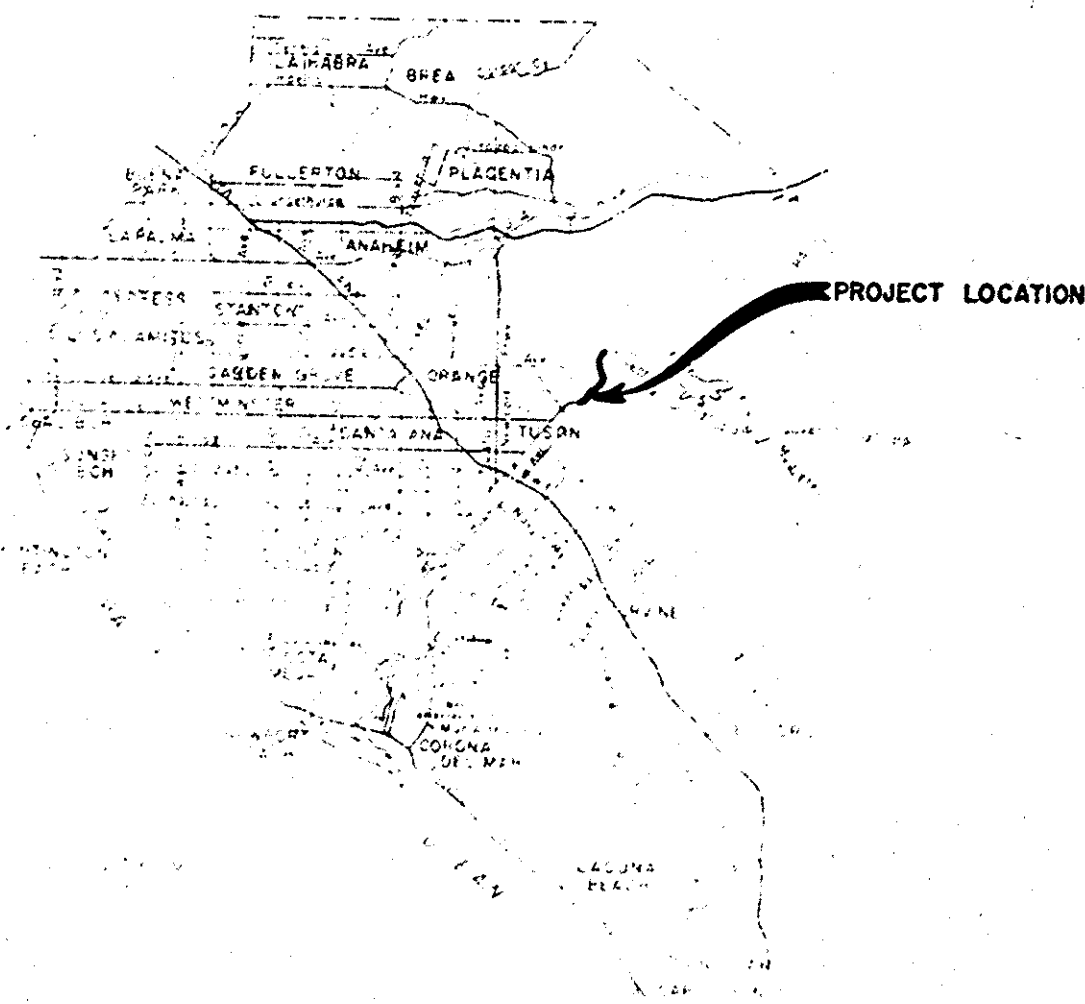

INDEX OF SHEETS

SHEET*	DESCRIPTION
1	TITLE SHEET
2	TYPICAL SECTIONS
3-9	PLAN & PROFILE
10	INTERSECTION DETAILS
11	BRIDGE GENERAL PLAN
12-17	MISCELLANEOUS DETAILS
18	BRIDGE FOUNDATION PLAN
19	BRIDGE ABUTMENT DETAILS
20	BRIDGE BENT DETAIL
21	BRIDGE SUPERSTRUCTURE LAYOUT
22	BRIDGE TYPICAL SECTION
23	BRIDGE MISCELLANEOUS DETAILS
24	BARRIER RAILING TYPE I
25	BARRIER RAILING DETAILS
26	CULVERT PROFILES
27-60	CROSS SECTIONS

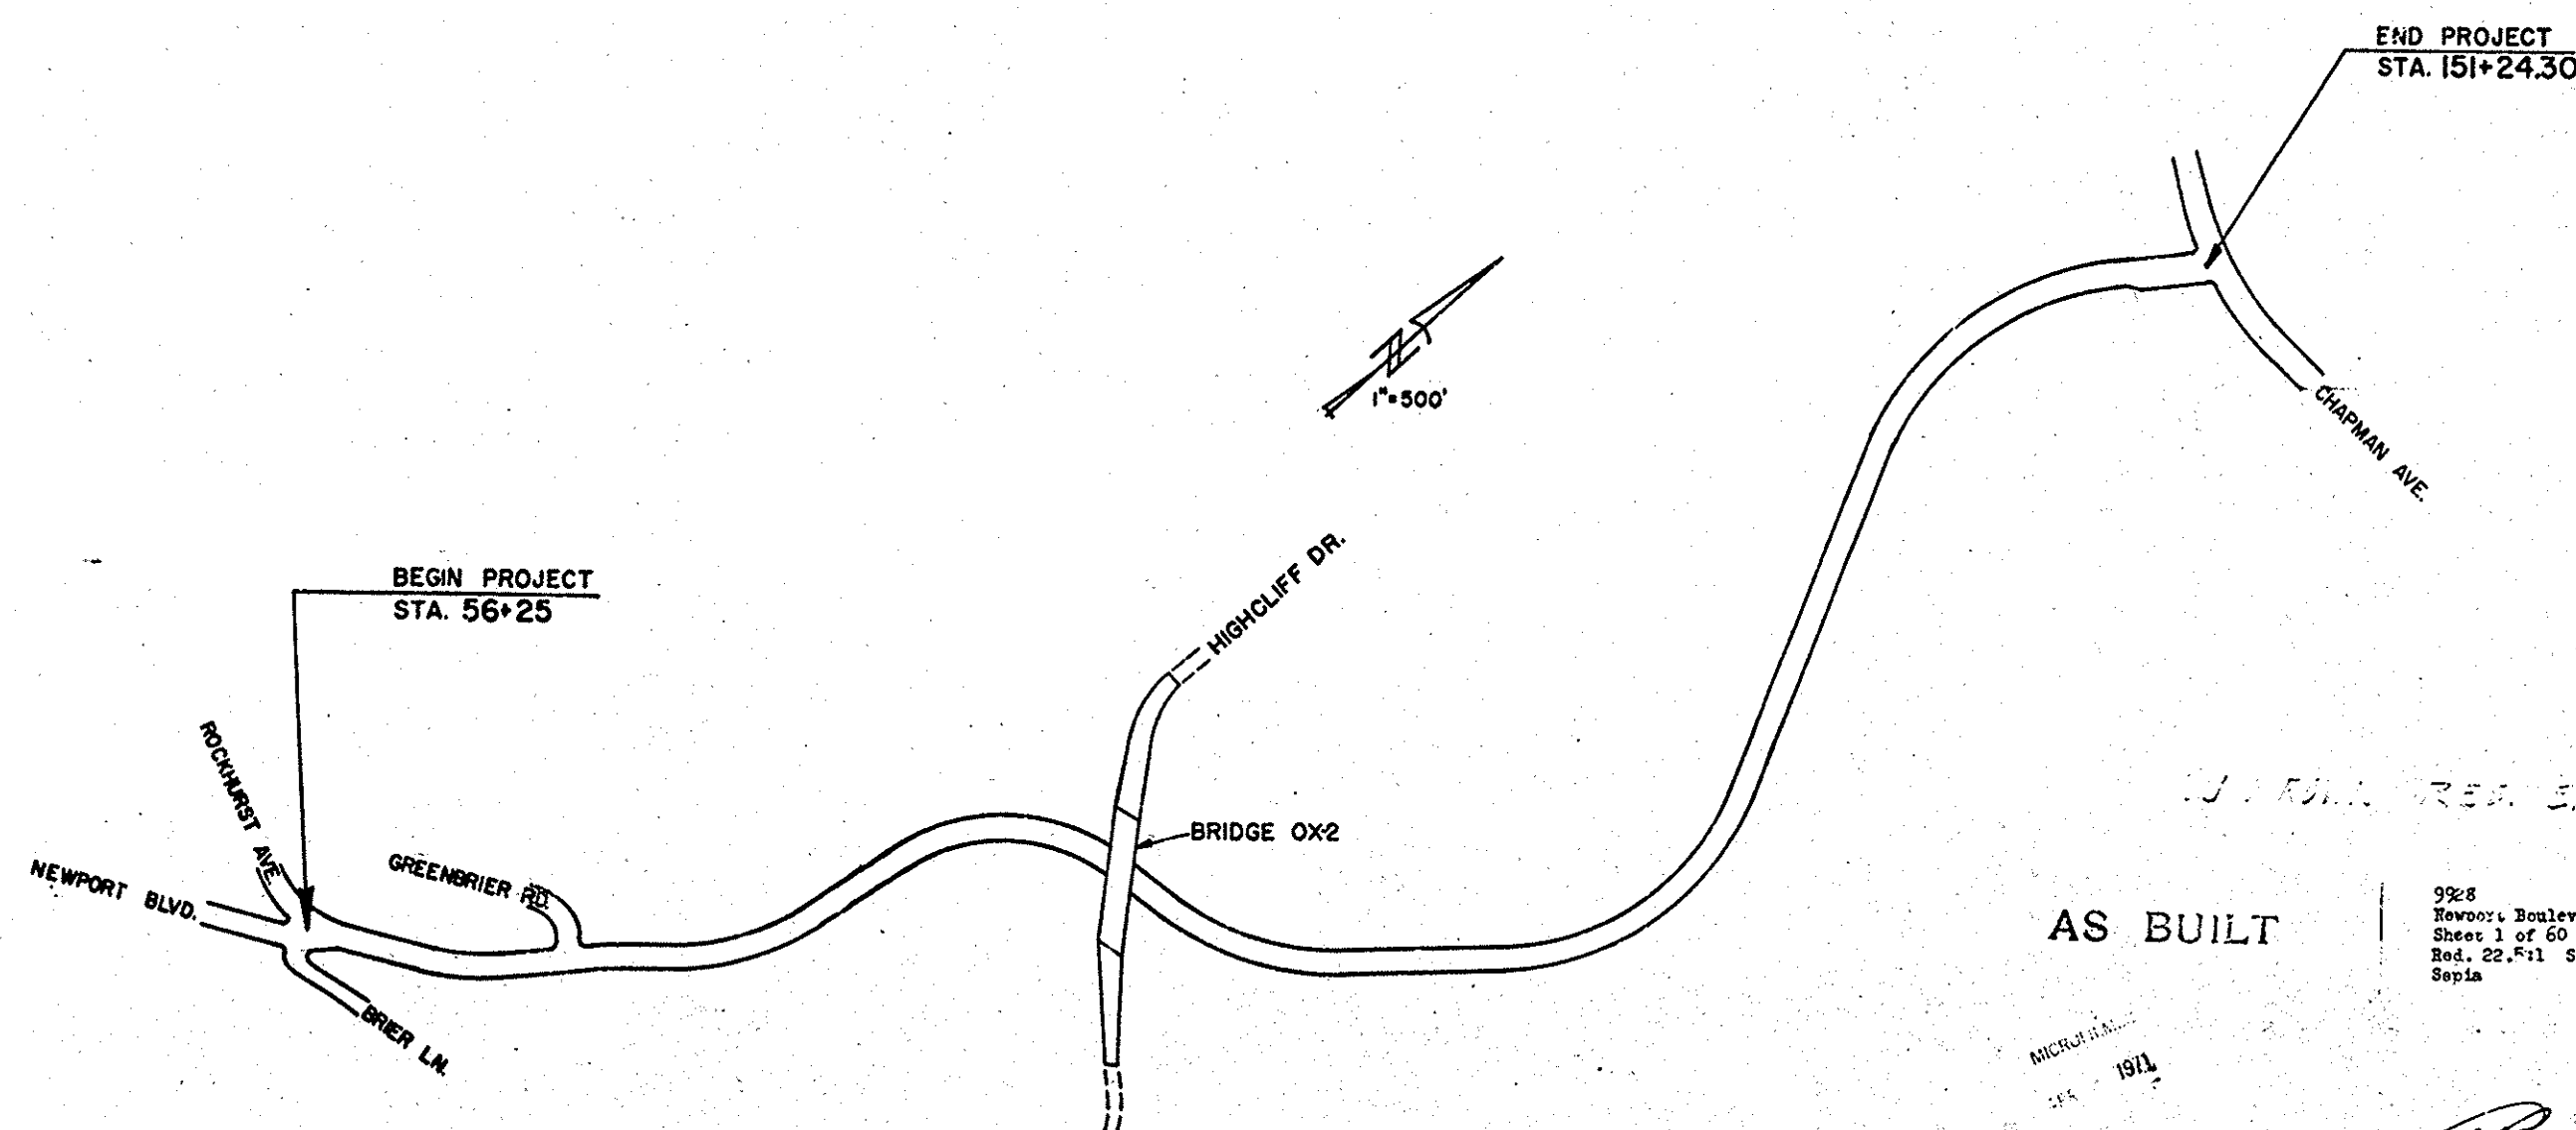

CONVENTIONAL SIGNS

1. STOP	11. AHEAD OF STOP
2. YIELD	12. AHEAD OF YIELD
3. AHEAD OF STOP	13. AHEAD OF YIELD
4. AHEAD OF STOP	14. AHEAD OF YIELD
5. AHEAD OF STOP	15. AHEAD OF YIELD
6. AHEAD OF STOP	16. AHEAD OF YIELD
7. AHEAD OF STOP	17. AHEAD OF YIELD
8. AHEAD OF STOP	18. AHEAD OF YIELD
9. AHEAD OF STOP	19. AHEAD OF YIELD
10. AHEAD OF STOP	20. AHEAD OF YIELD

AS BUILT

928
Newport Boulevard
Sheet 1 of 60
Red. 22.611 Scale: 1"=500'
Sepia

APPROVED: *[Signature]* May 7 '89
ROAD COMMISSIONER R.C.E. 1972 DATE

Dr. 13 (9928)

Newport Blvd.

Dr. 13 (9928)

Bridge Plans