
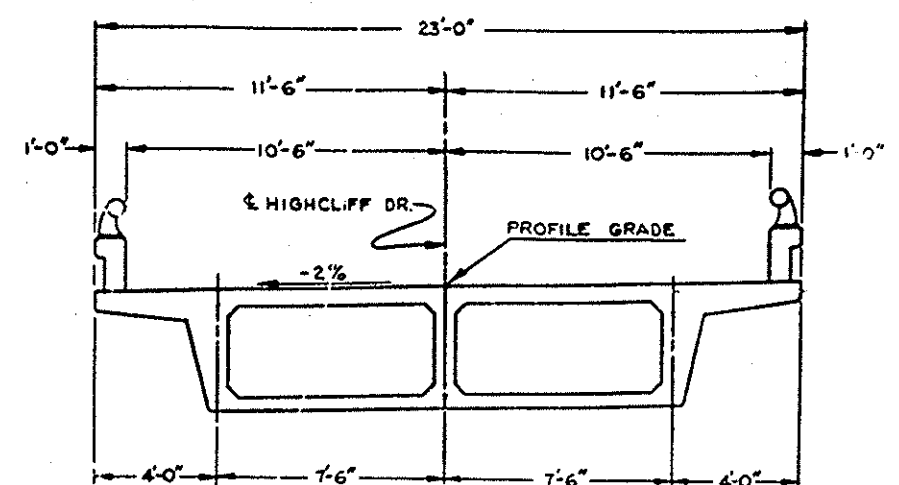




EXACT

STRAIGHT EDGE RULE SE-48

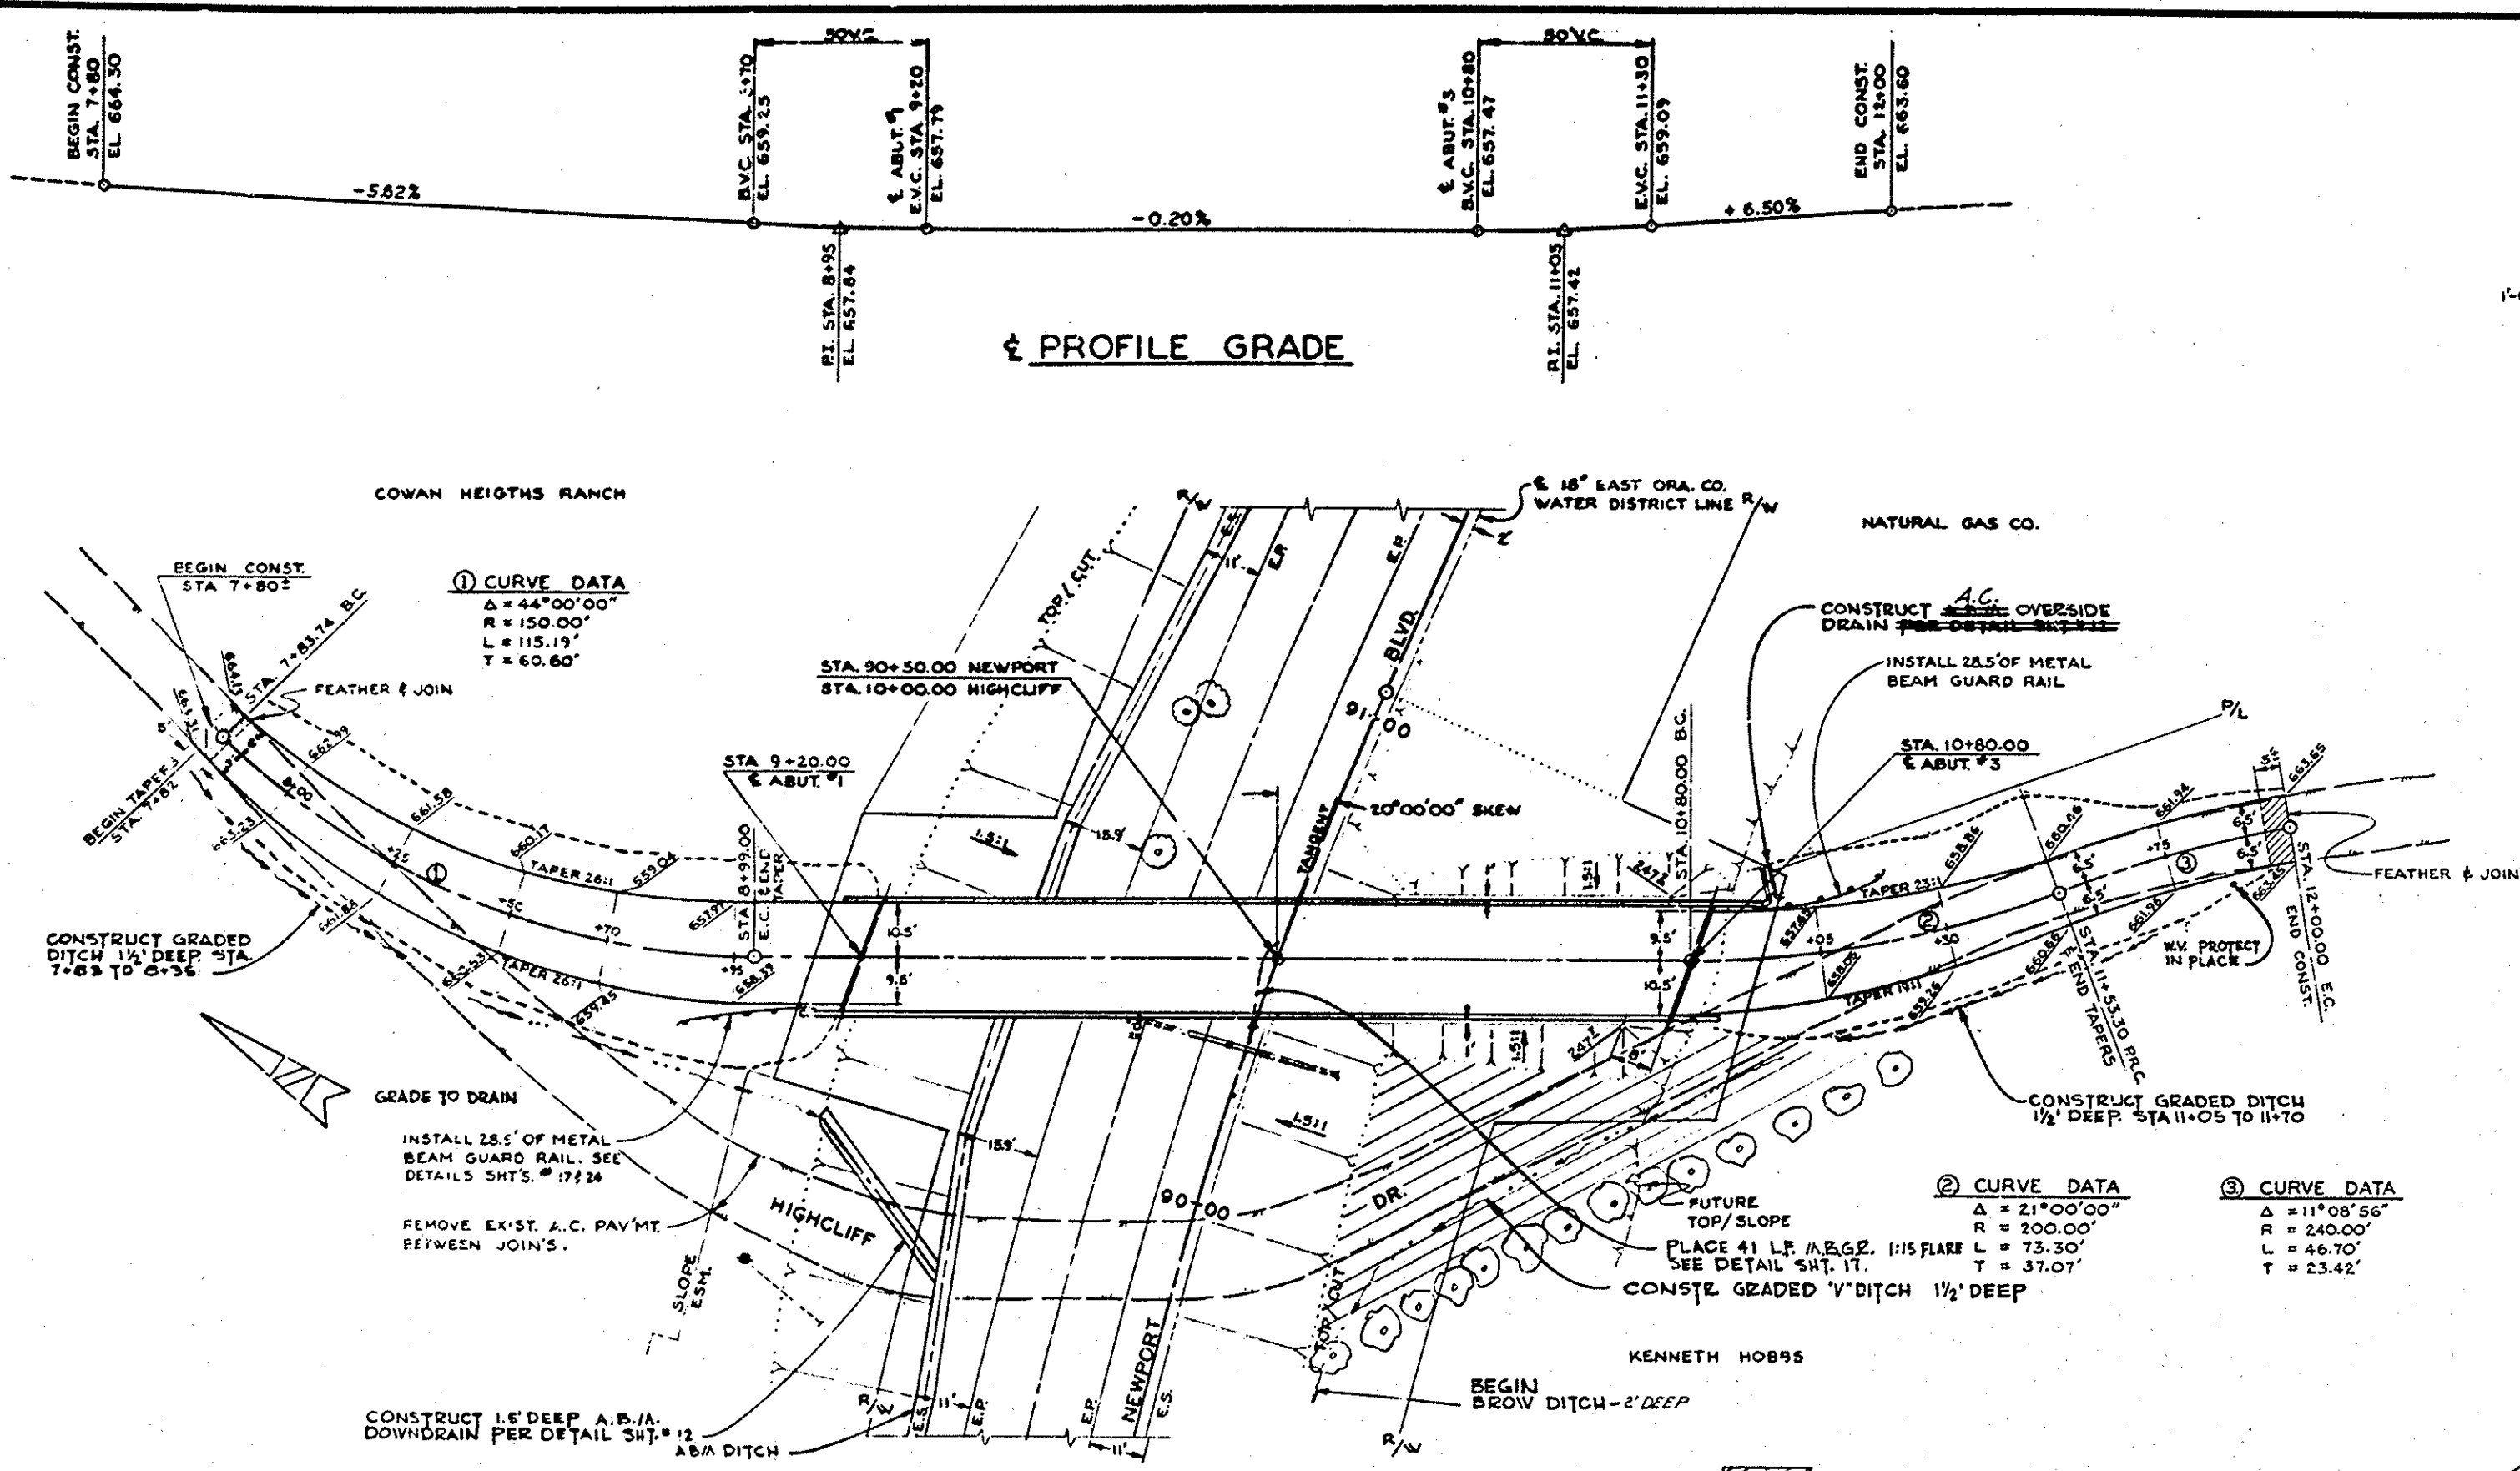

LOCATION	ELEV.	DATE
E.A.B. (LT.)	657.57	NOV. 1966
MID. SPAN (LT.)	657.52	"
E.B. (LT.)	657.40	"
MID. SPAN (RT.)	657.37	"
E.A.B. (RT.)	657.25	"

NOTE: THIS ARE 1/8" BRASS FEEL SCREWS LOCATED 18" FROM LEFT & RIGHT EDGE OF DECK.

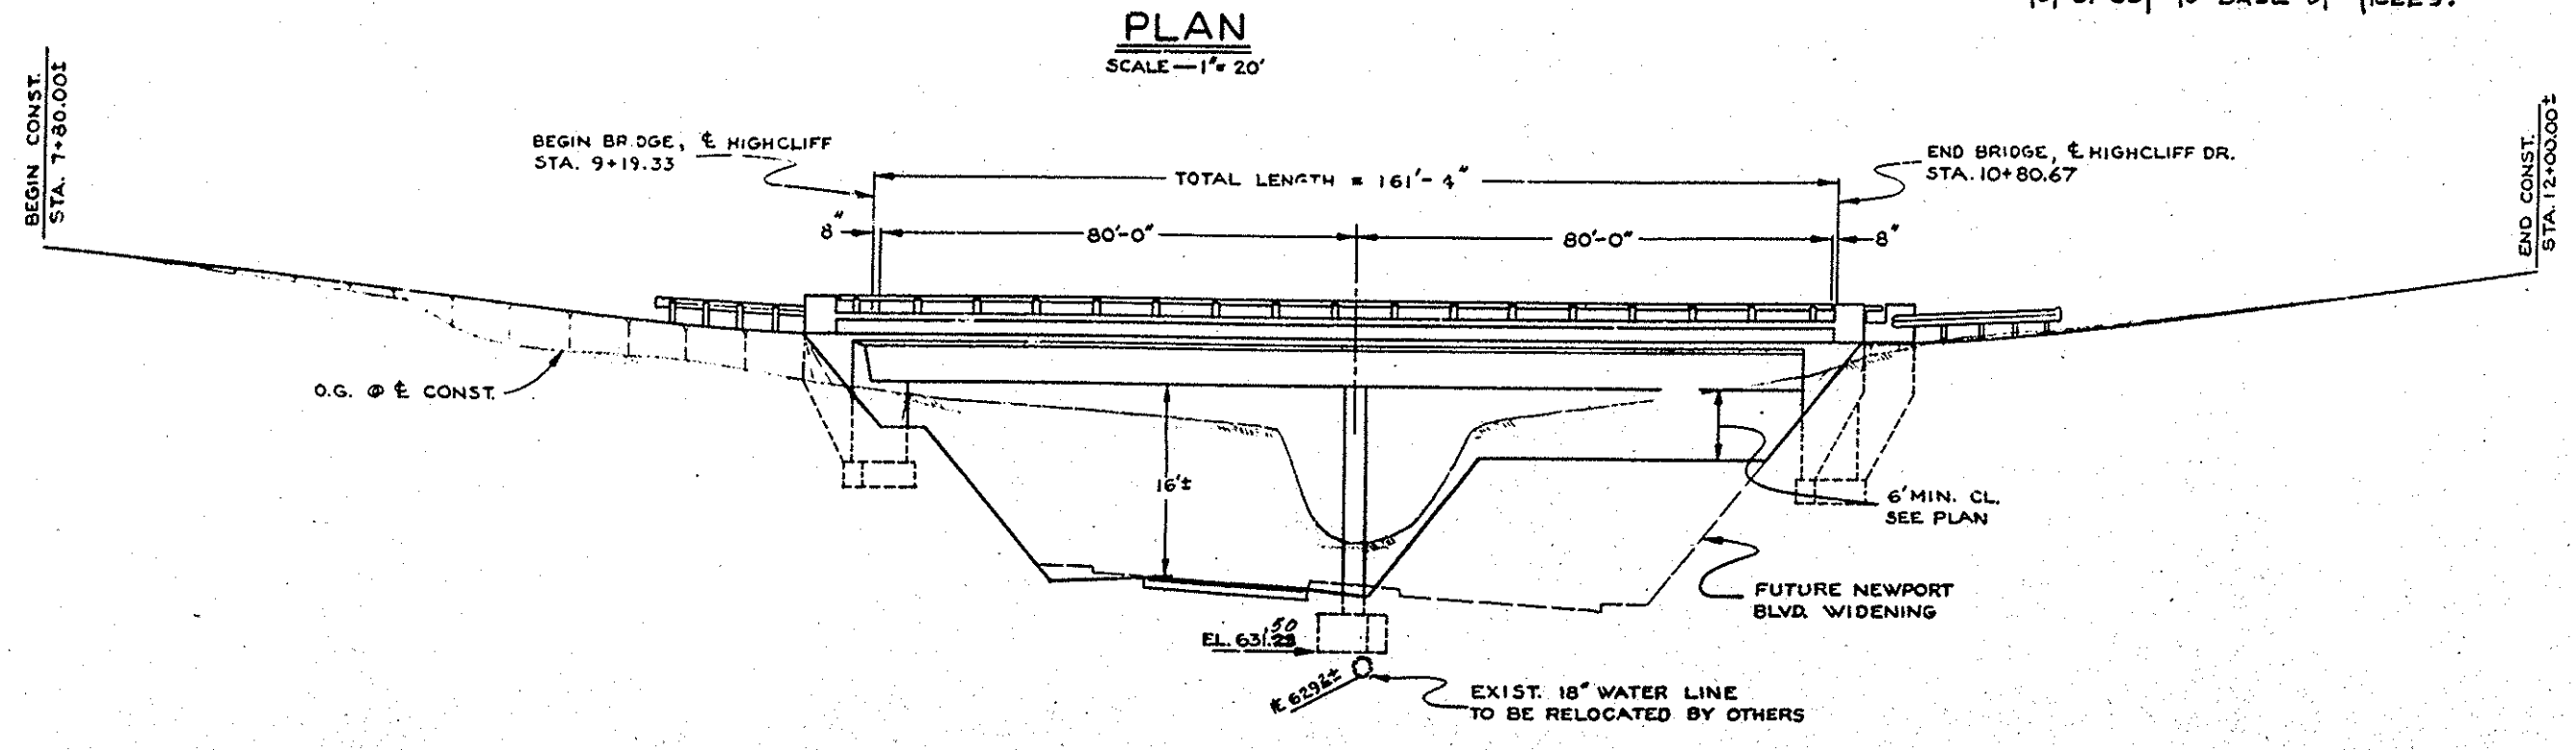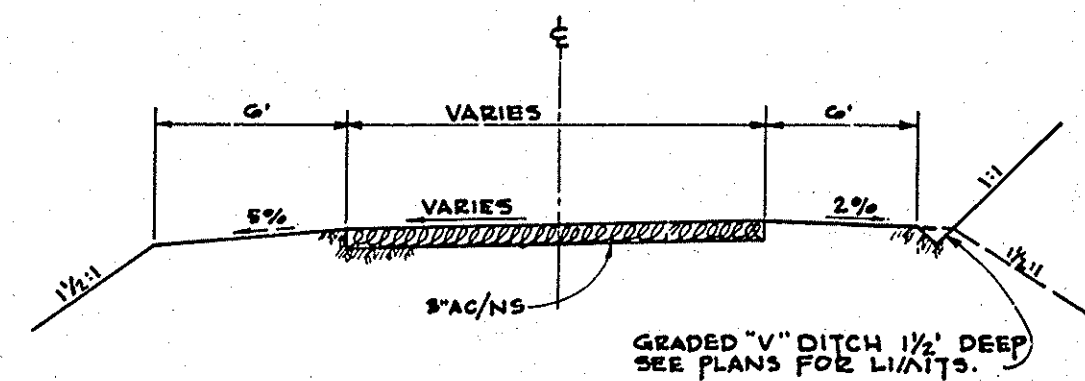

AS BUILT

9928
Newport Boulevard
Sheet 11 of 60
Red. 22.5.11 Scale: as shown
Vellan

NEWPORT BLVD.
BRIER LANE TO CHAPMAN AVE.
HIGHCLIFF DR. OVERCROSSING
BRIDGE 0X-2
GENERAL PLAN

No. 13 (9928)