
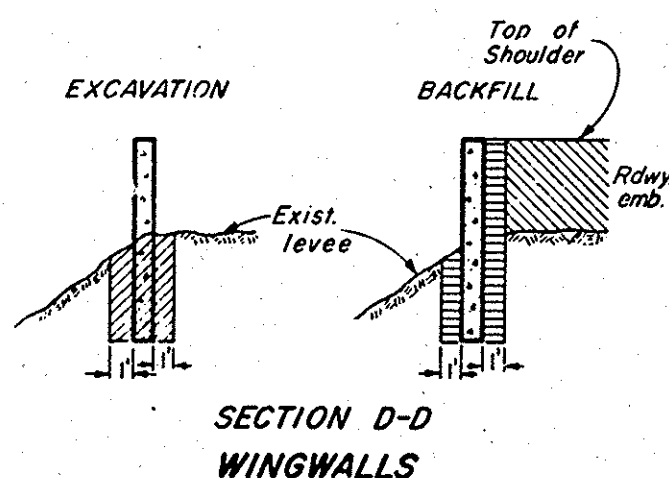
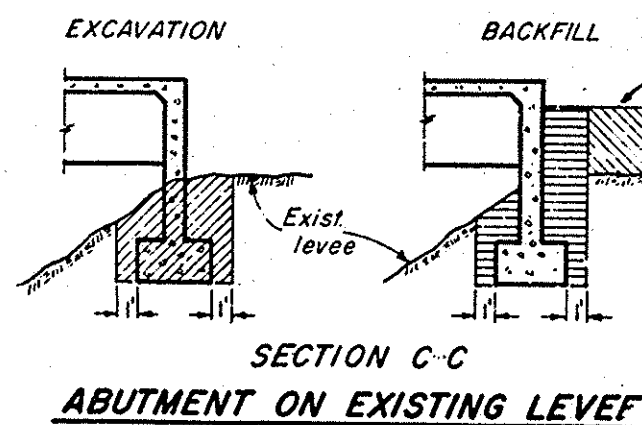
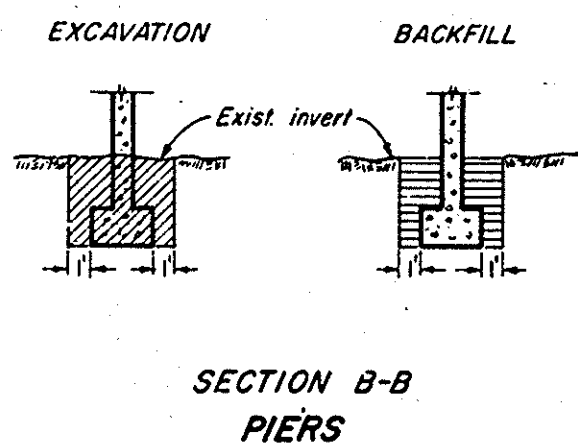
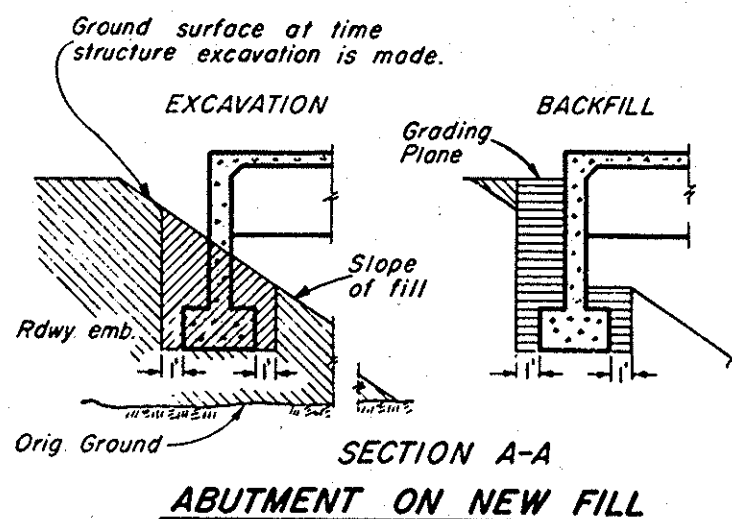






EXACT

STRAIGHT EDGE RULE SE-48

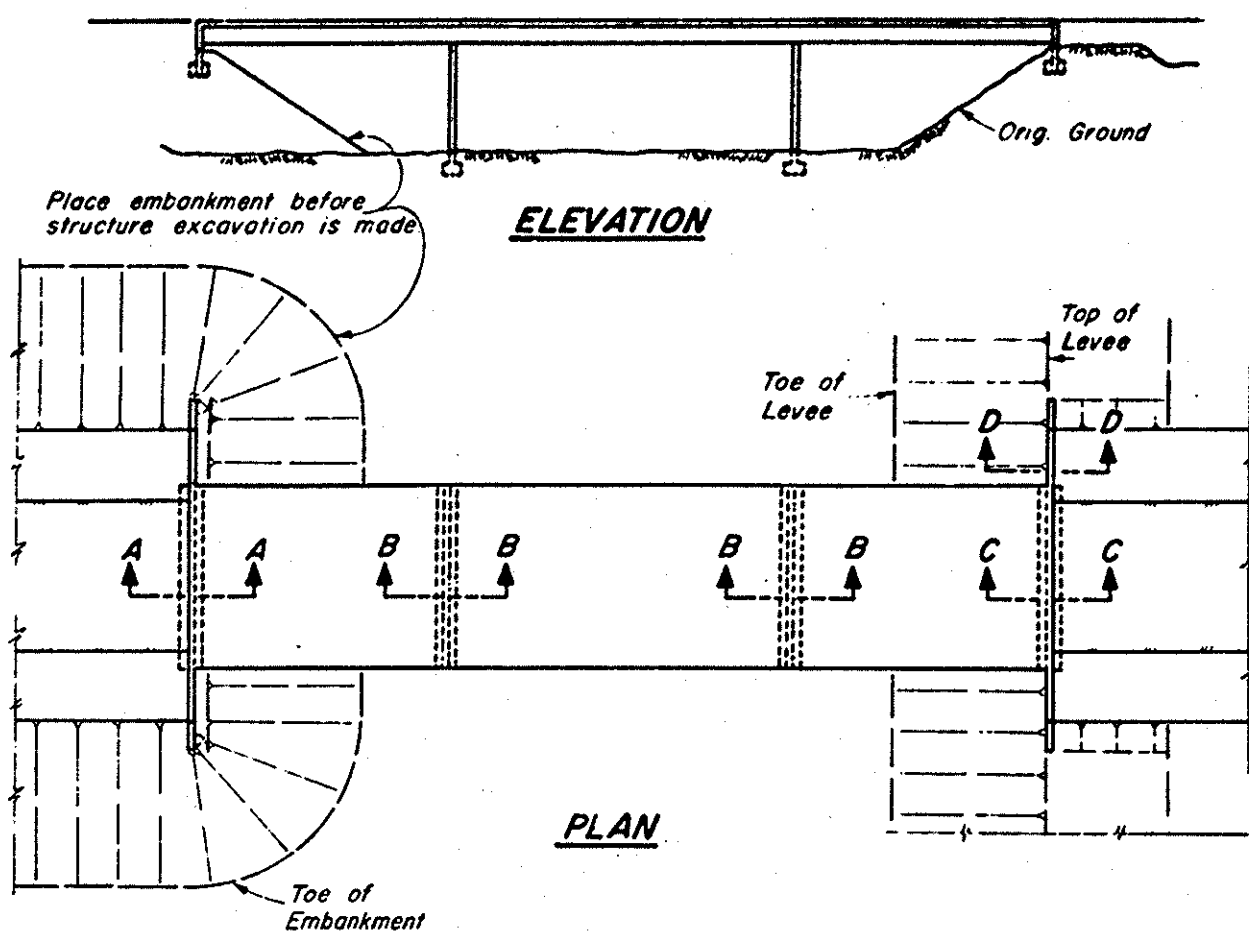

LEGEND
 STRUCTURE EXCAVATION
 STRUCTURE BACKFILL
 ROADWAY EMBANKMENT

**TYPICAL
 STRUCTURE EXCAVATION &
 BACKFILL DETAILS**

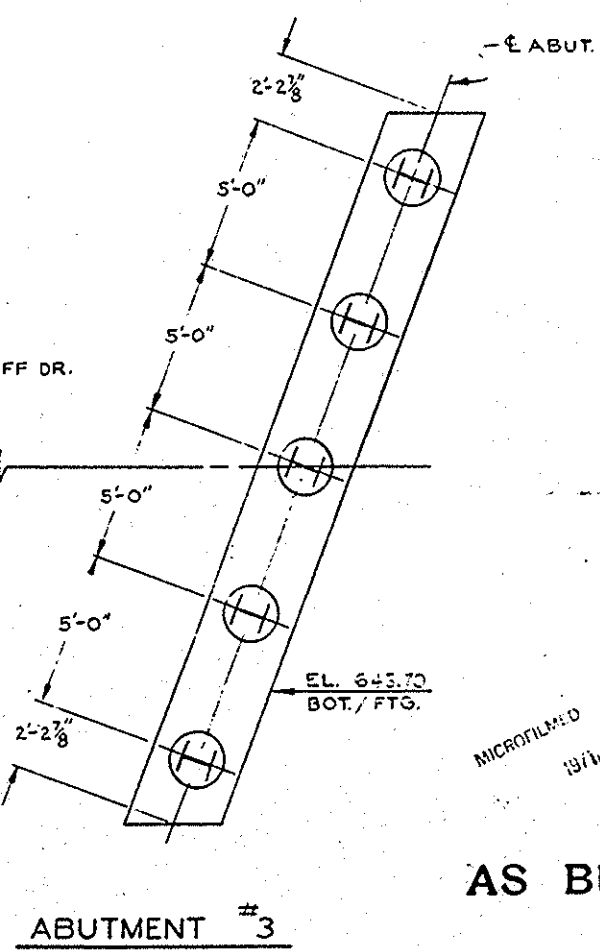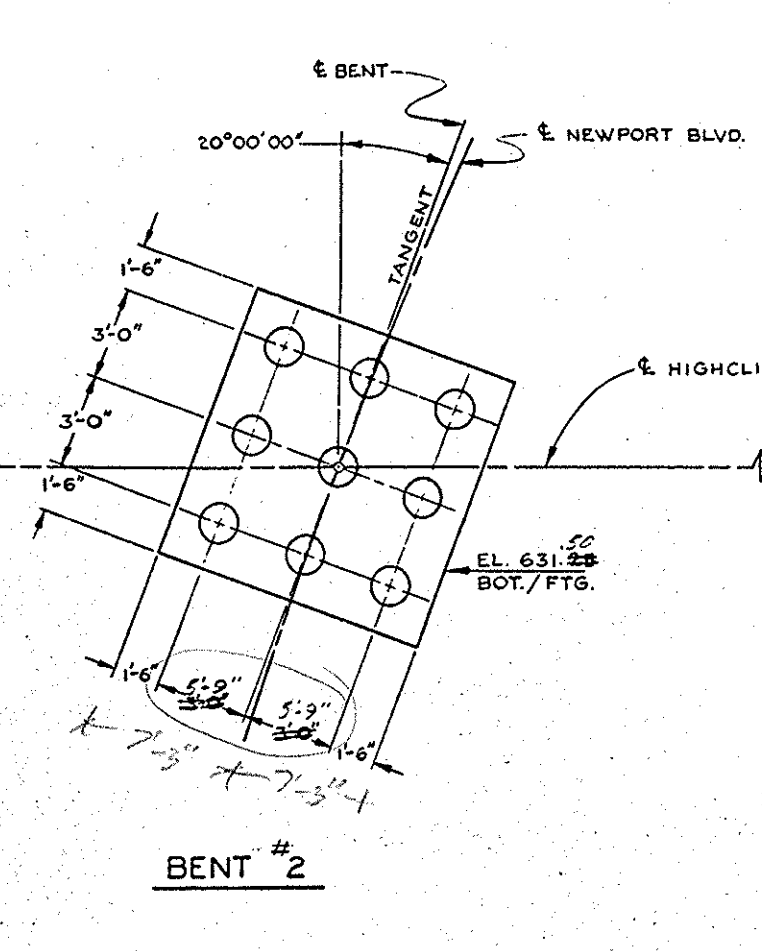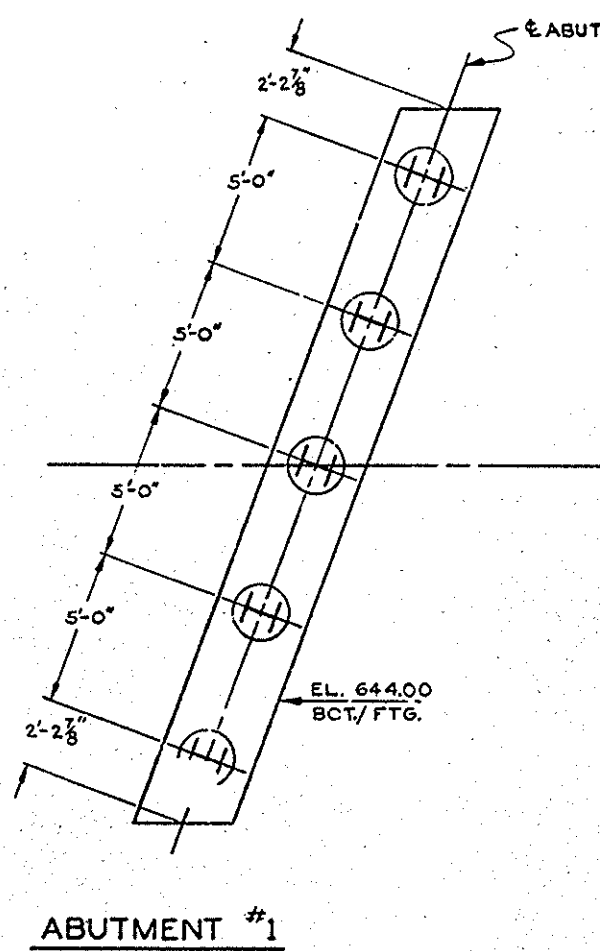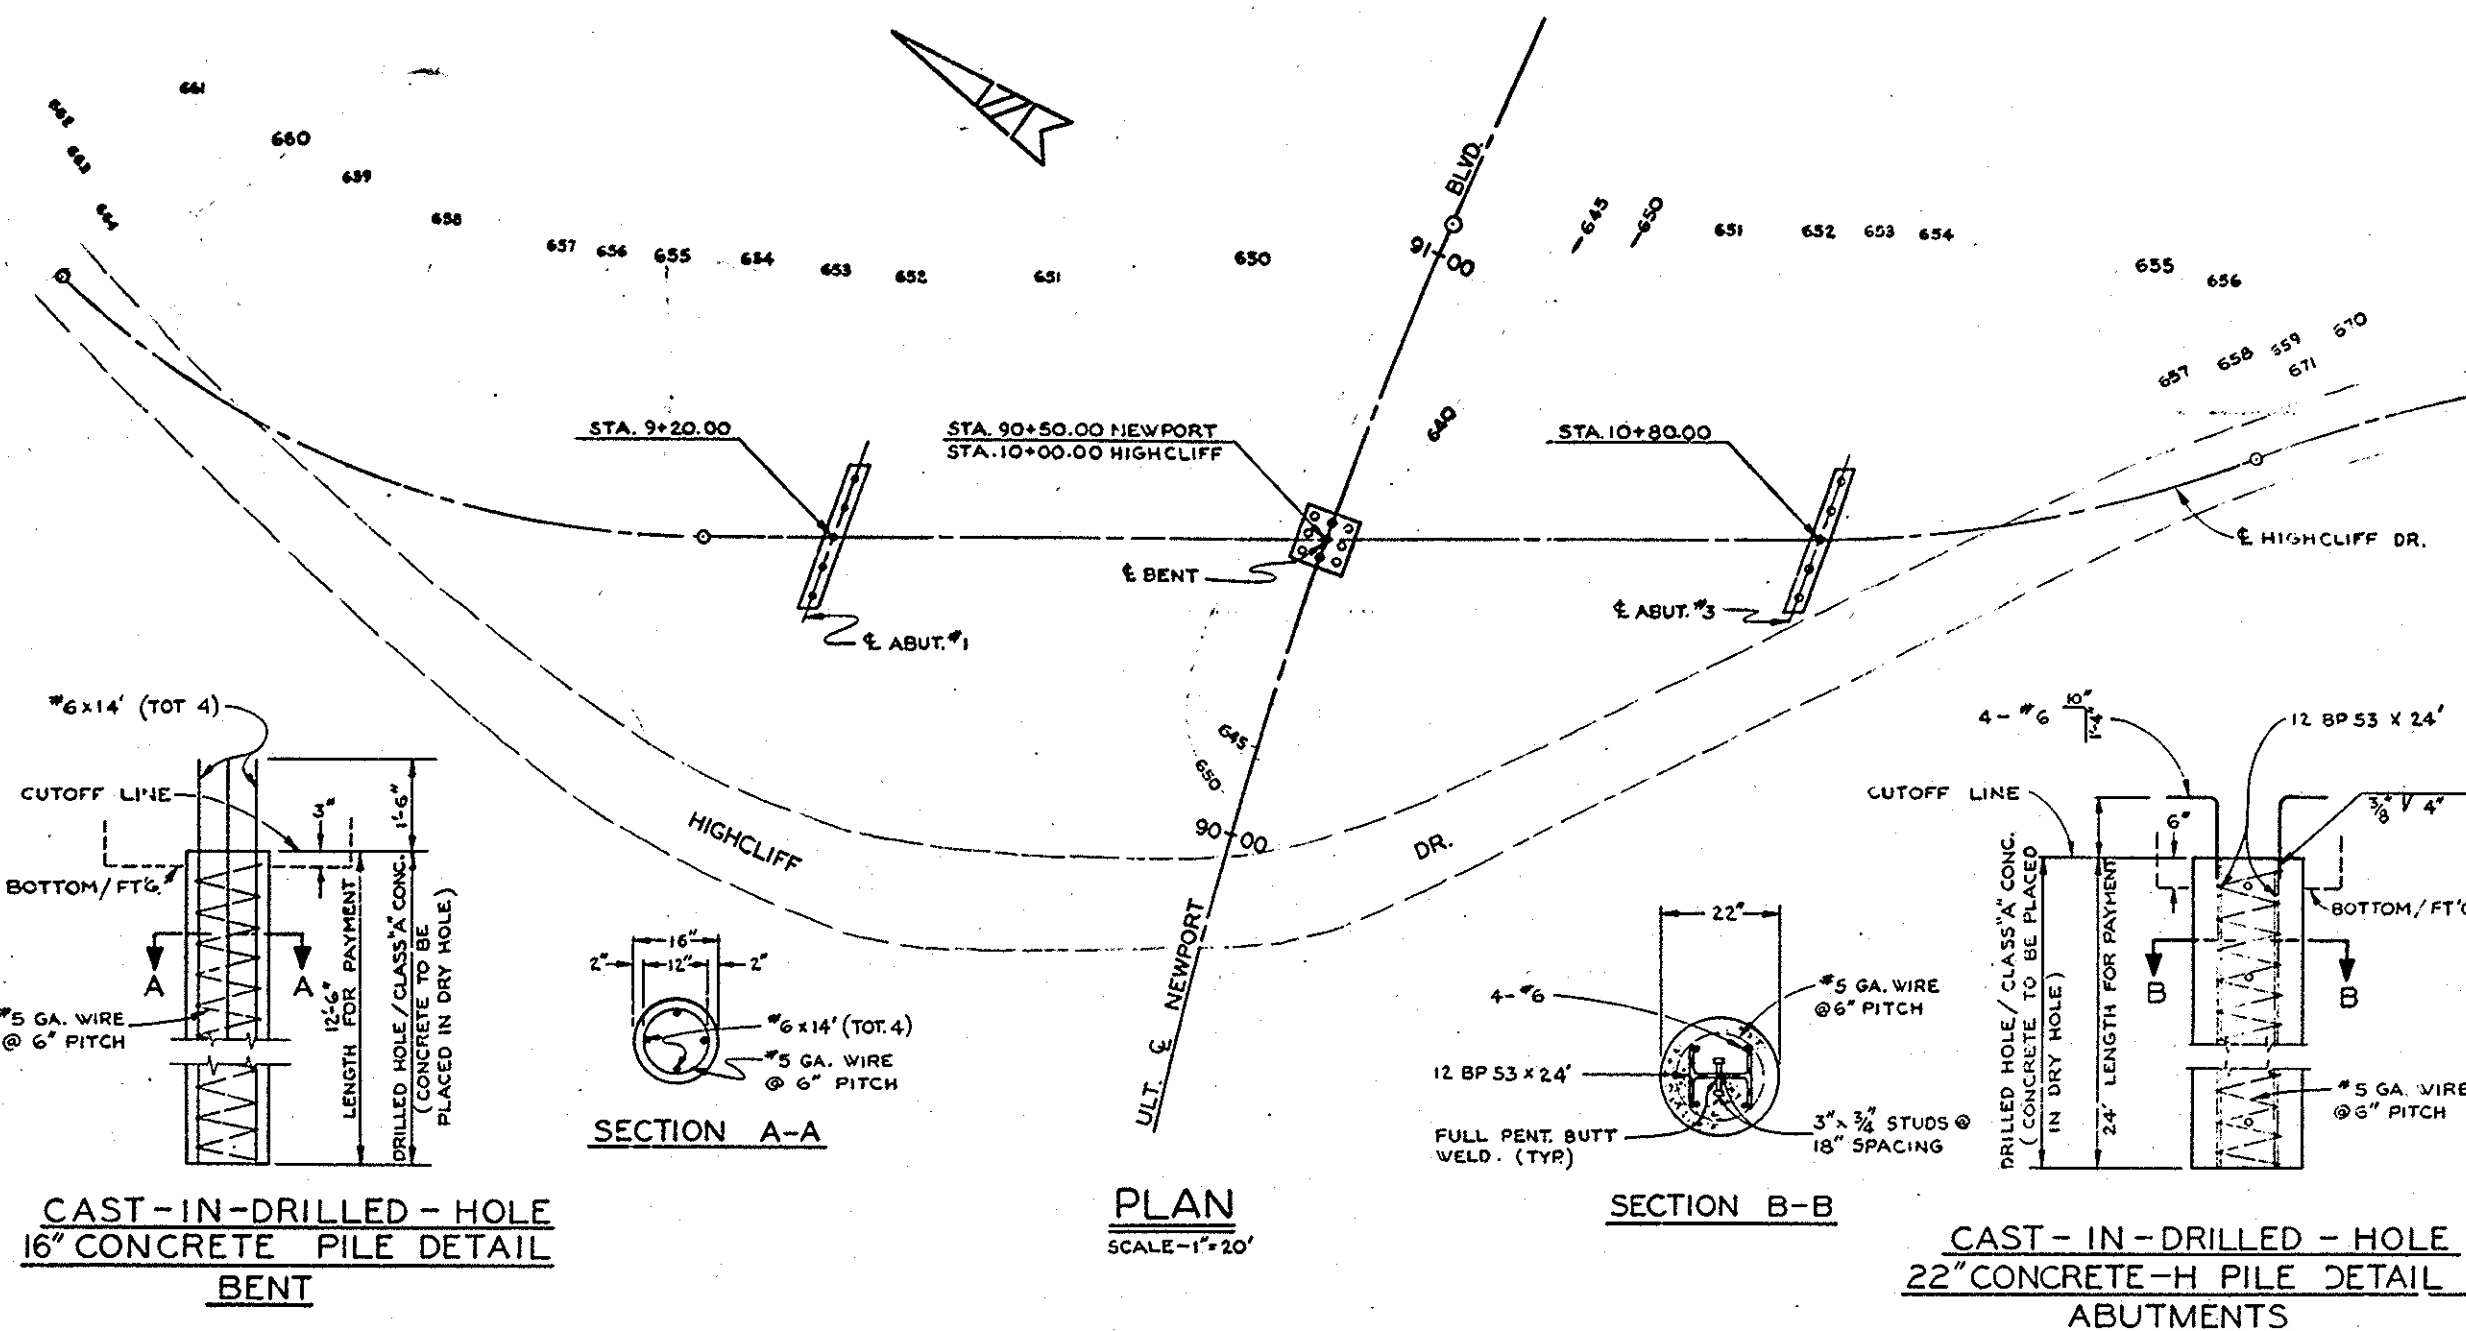

PILE LAYOUT
 SCALE 1/4" = 1'-0"

FOOTING	TIP ELEV.	ELEV. PILE CUTOFF
ABUT. #1	620.50	644.50
BENT #2	619.00	631.50
ABUT. #3	620.20	644.20

9928
 Newport Boulevard
 Sheet 18 of 50
 Red. 22.5:1 Scale: as shown
 Sepia

NEWPORT BLVD.
 BRIER LANE TO CHAPMAN AVE.
 HIGHCLIFF DR OVERCROSSING
 BRIDGE OX-2

FOUNDATION PLAN

NO. 13 (9928)