
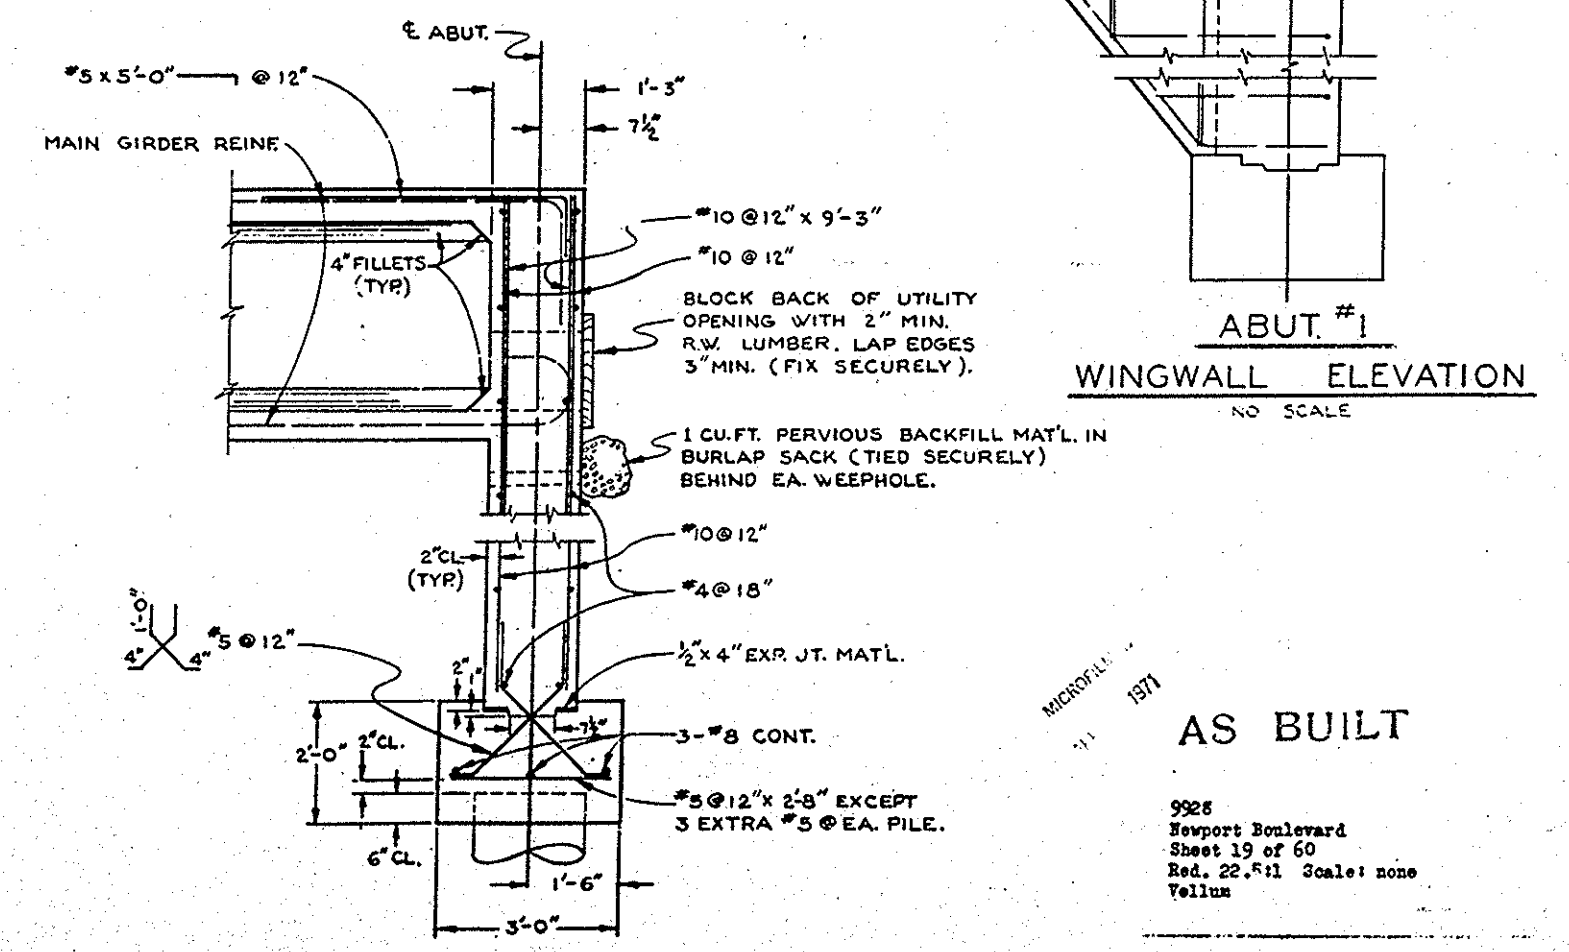
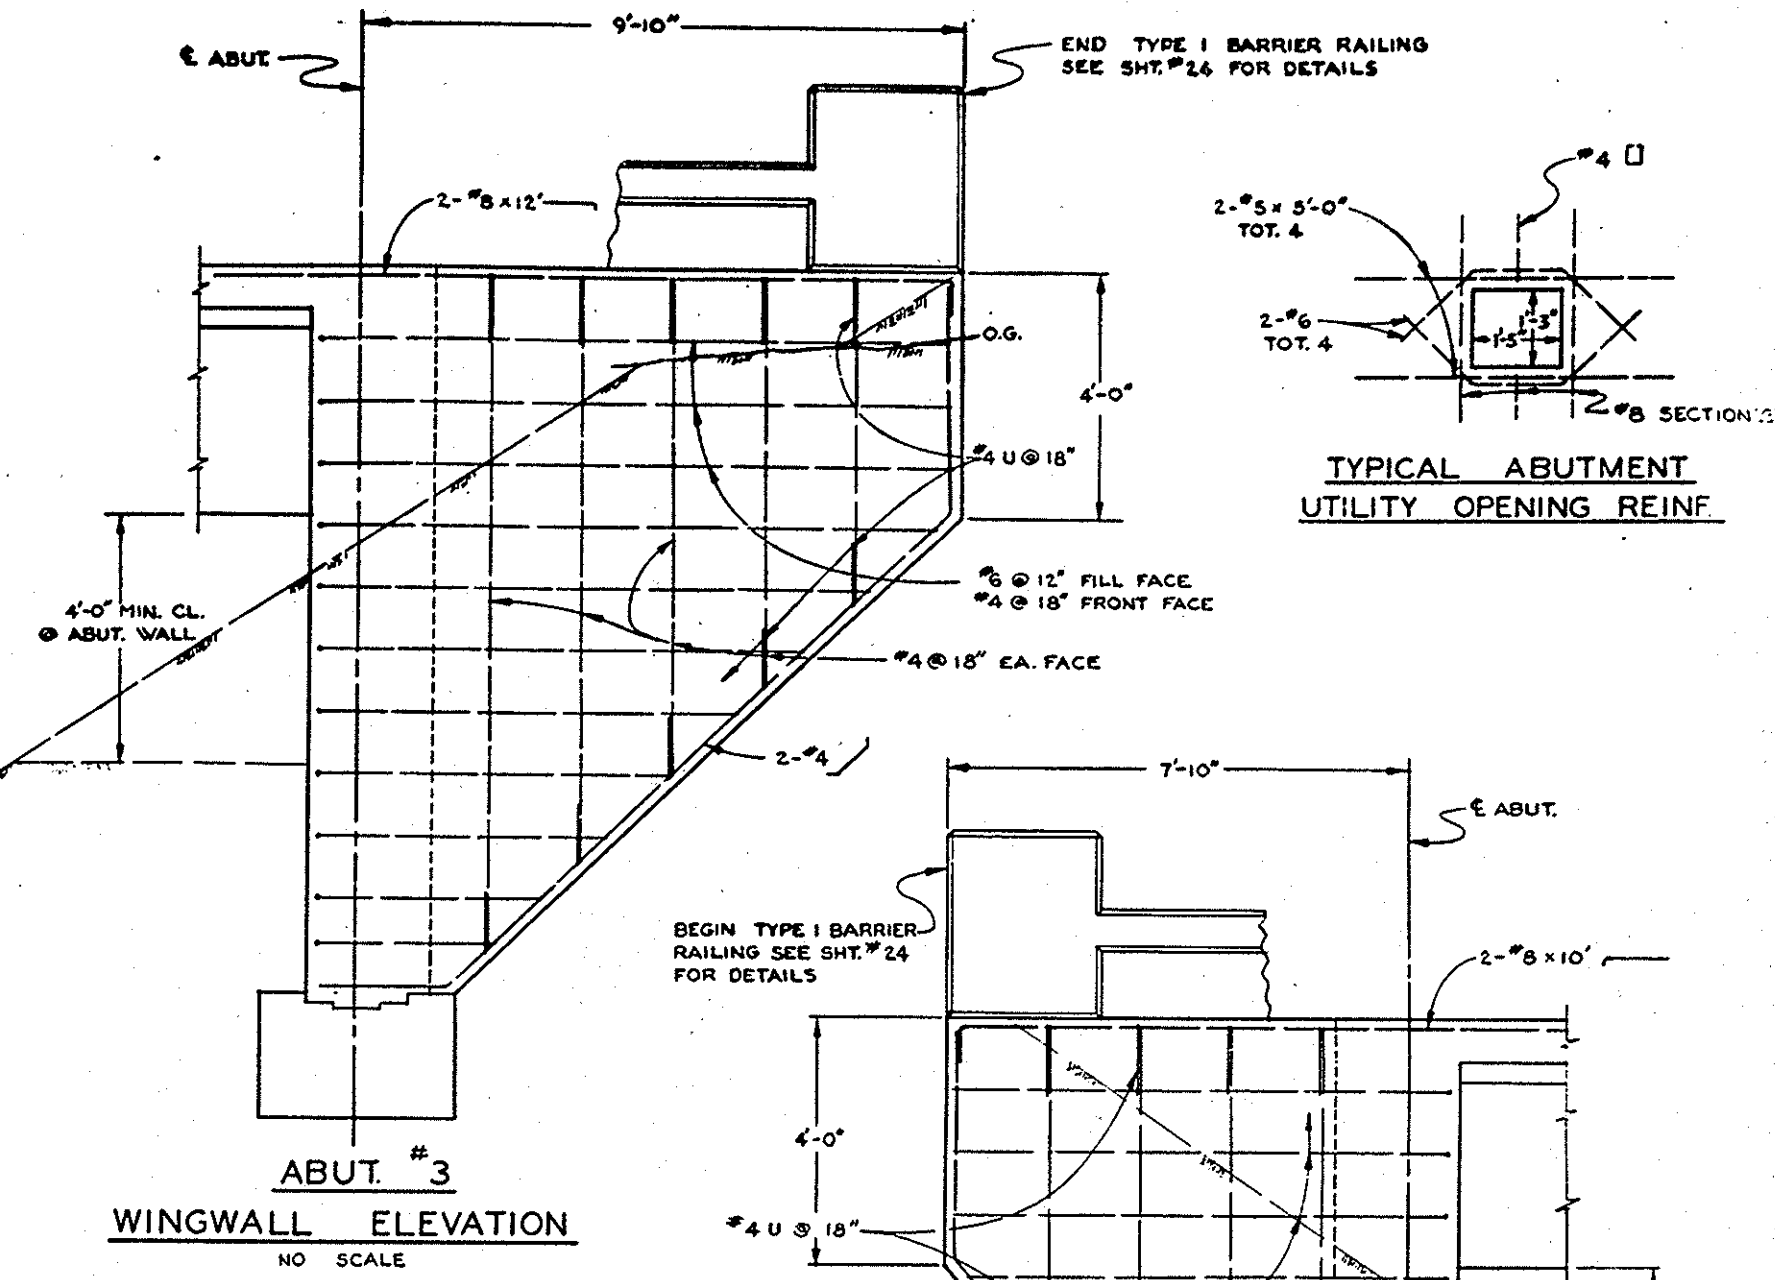
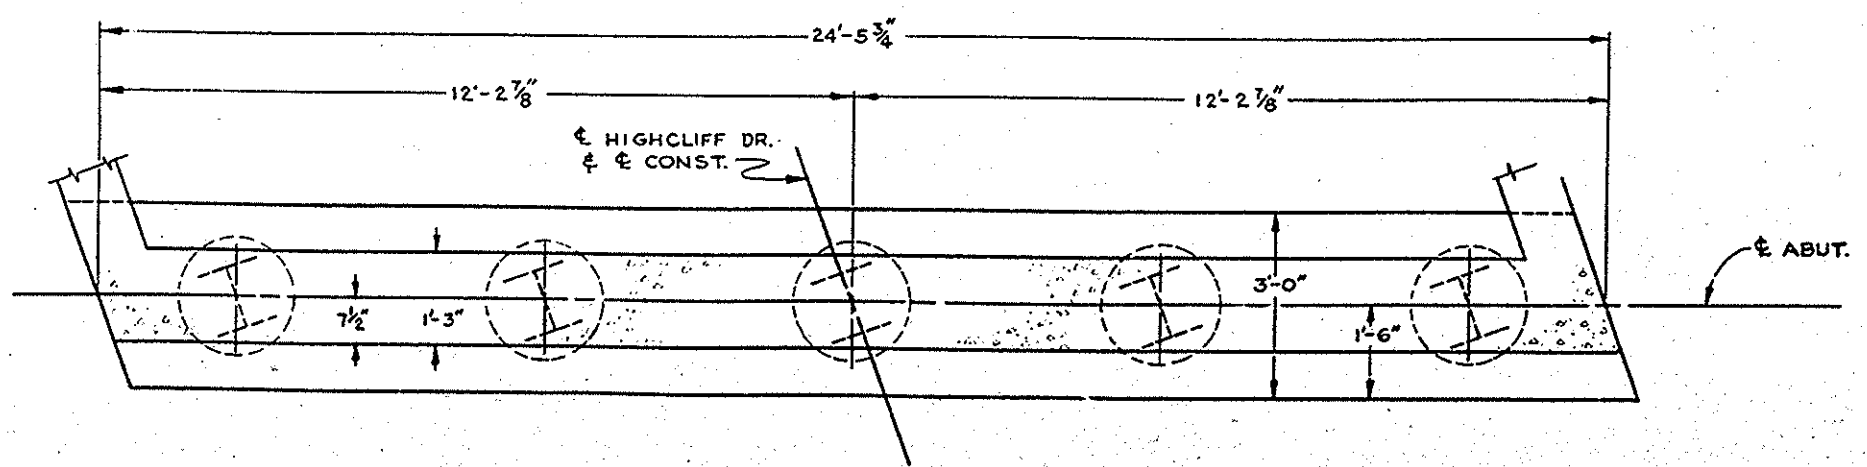
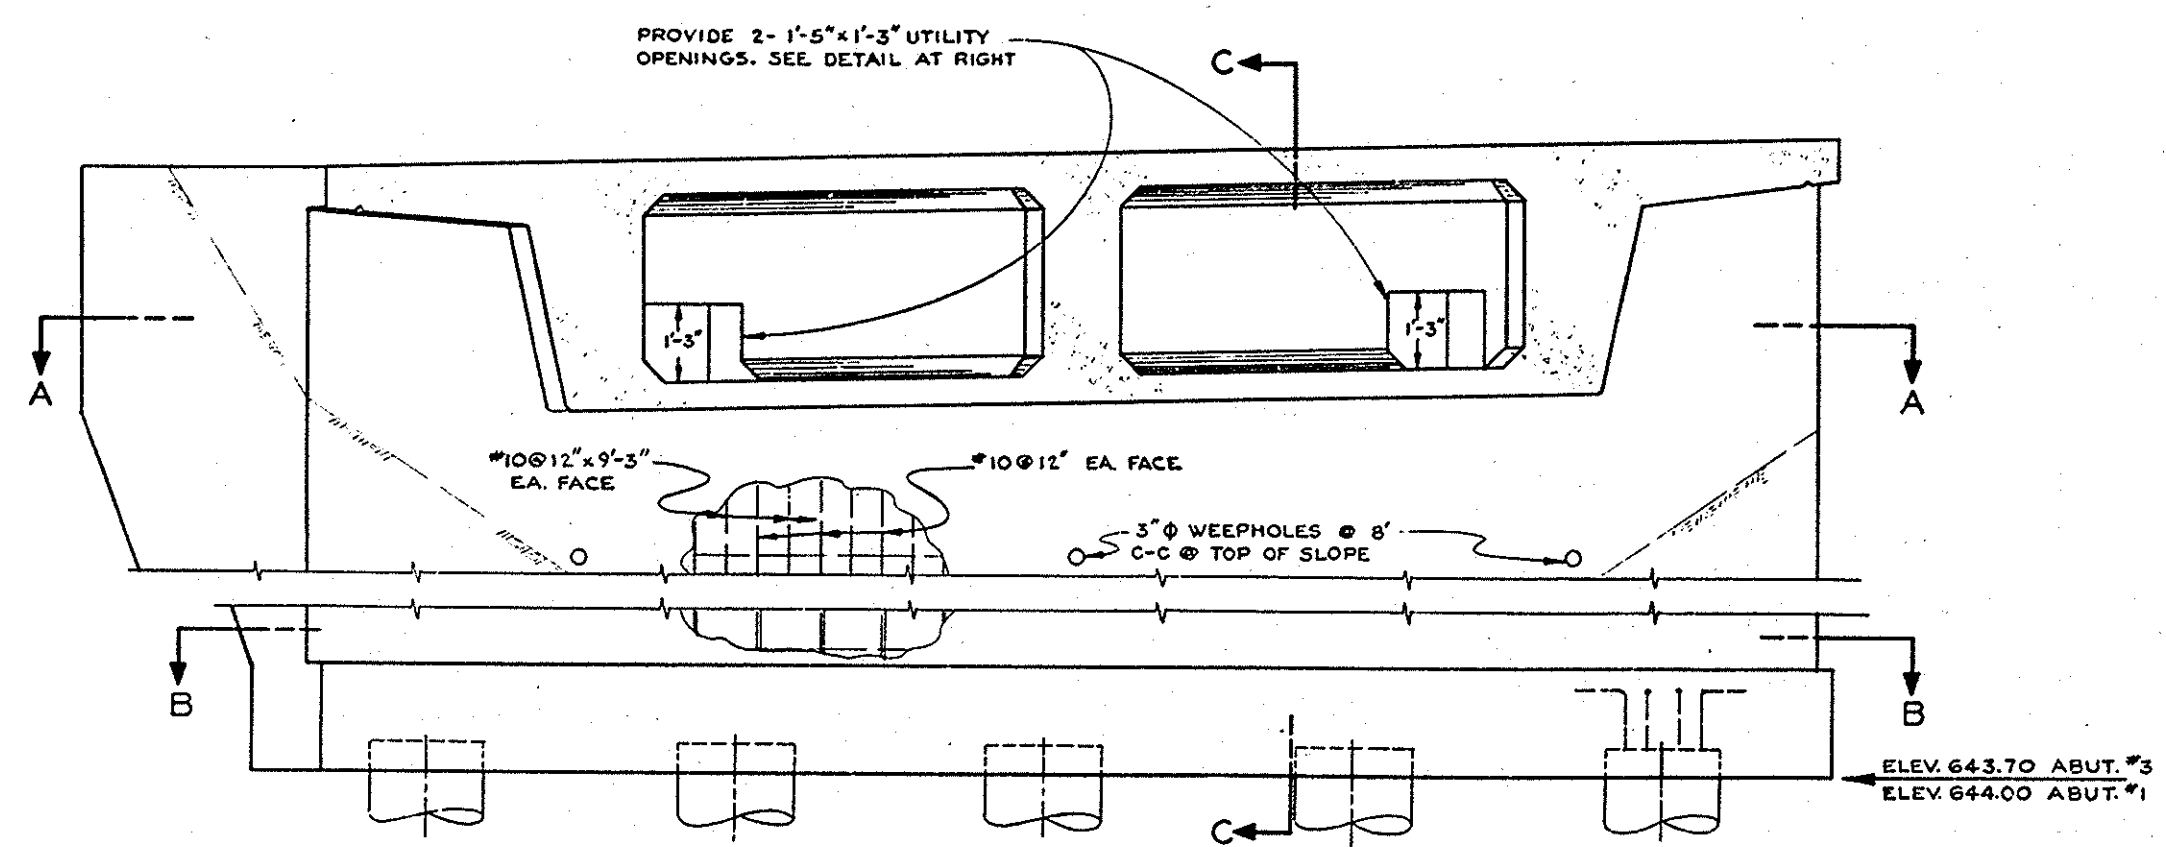


EXACT

STRAIGHT EDGE RULE SE-48

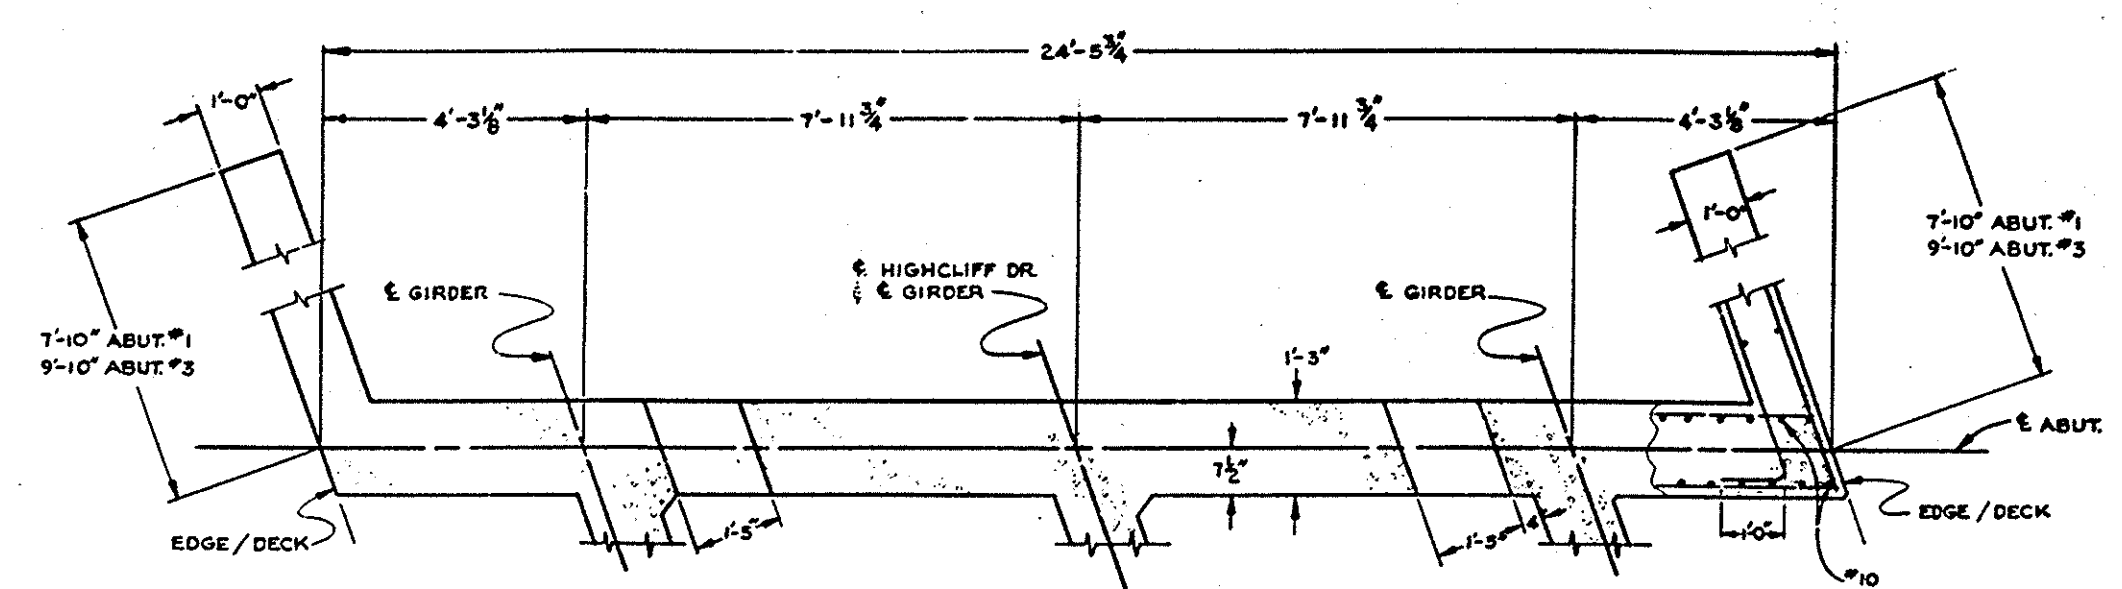

SECTION C-C
NO SCALE

AS BUILT

9928
Newport Boulevard
Sheet 19 of 60
Rev. 22.5.11 Scale: none
Tellen

CHANCE COUNTY ROAD DISTRICT

NEWPORT BLVD.
BRIER LANE TO CHAPMAN AVE.
HIGHCLIFF DR. OVERCROSSING
BRIDGE OX-2

ABUTMENT DETAILS

NONE

19 60

DR. 13 (9928)