



EXACT


STRAIGHT EDGE RULE SE-48

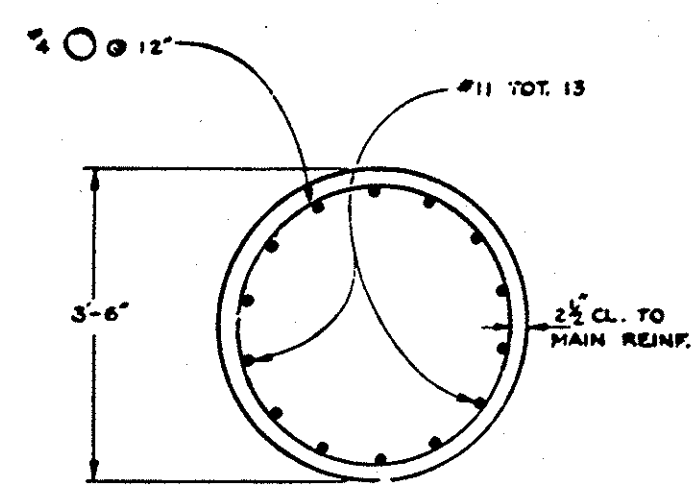


SECTION B-B
SCALE - 3/4" = 1'-0"

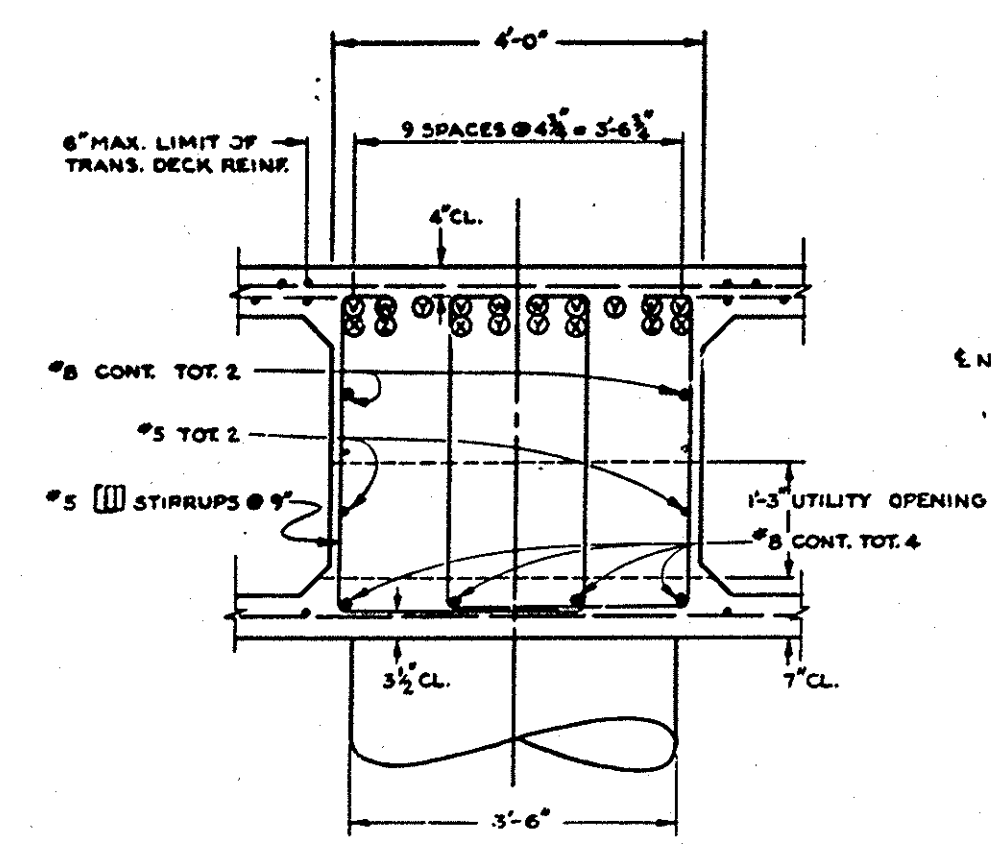


SECTION A-A
SCALE - 3/4" = 1'-0"

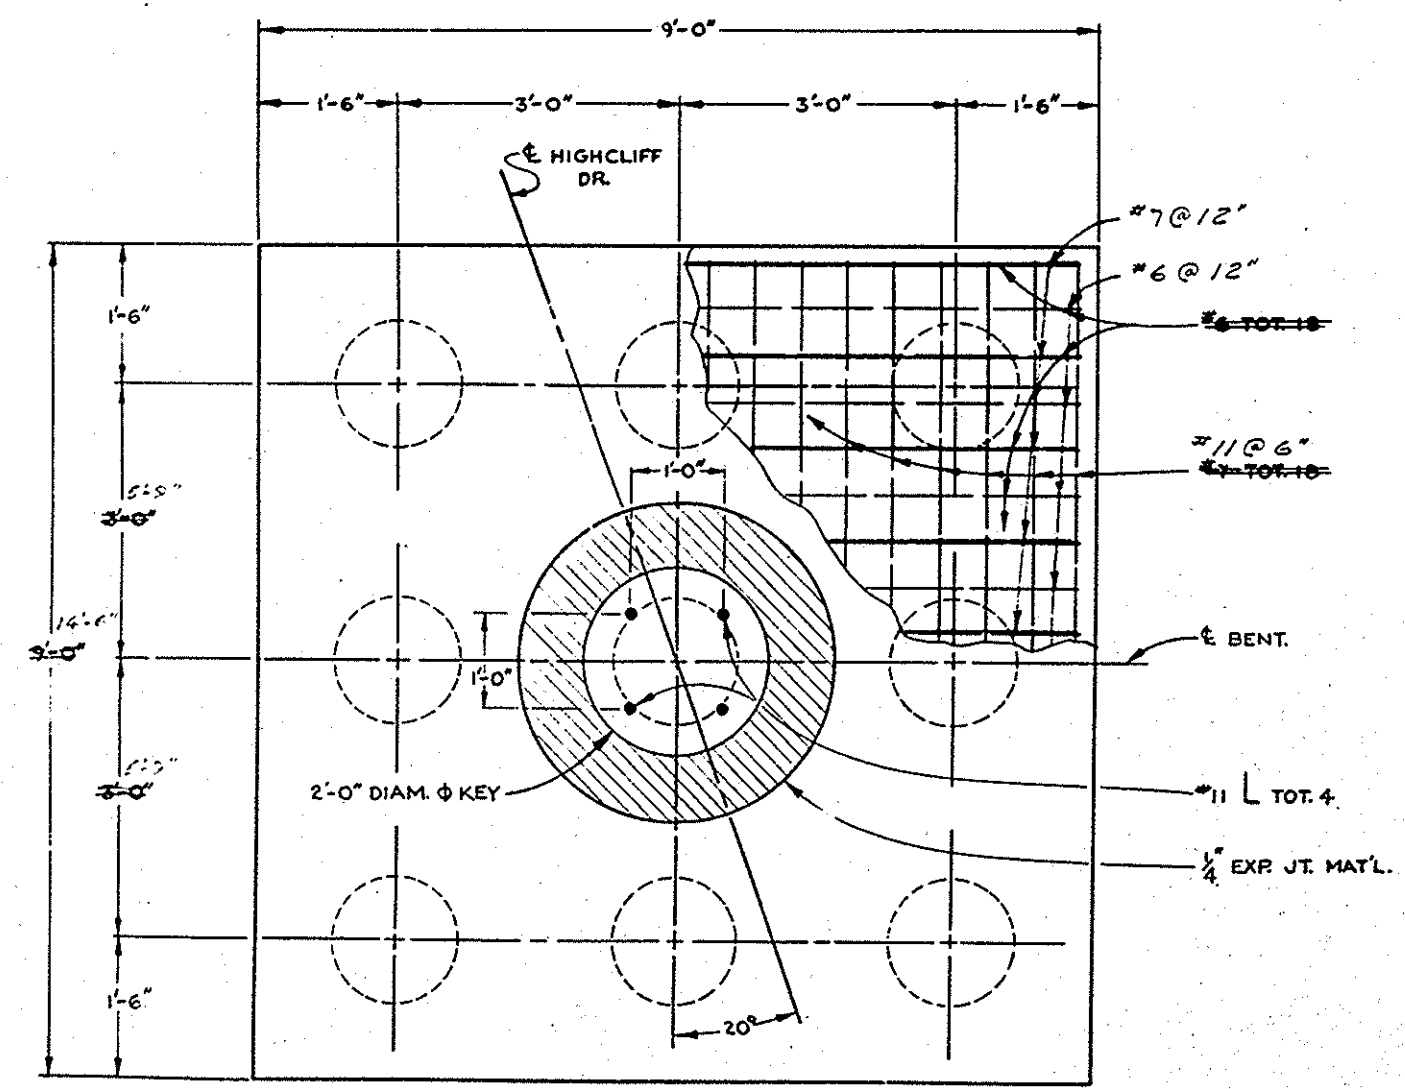


SECTION C-C
SCALE - 3/4" = 1'-0"

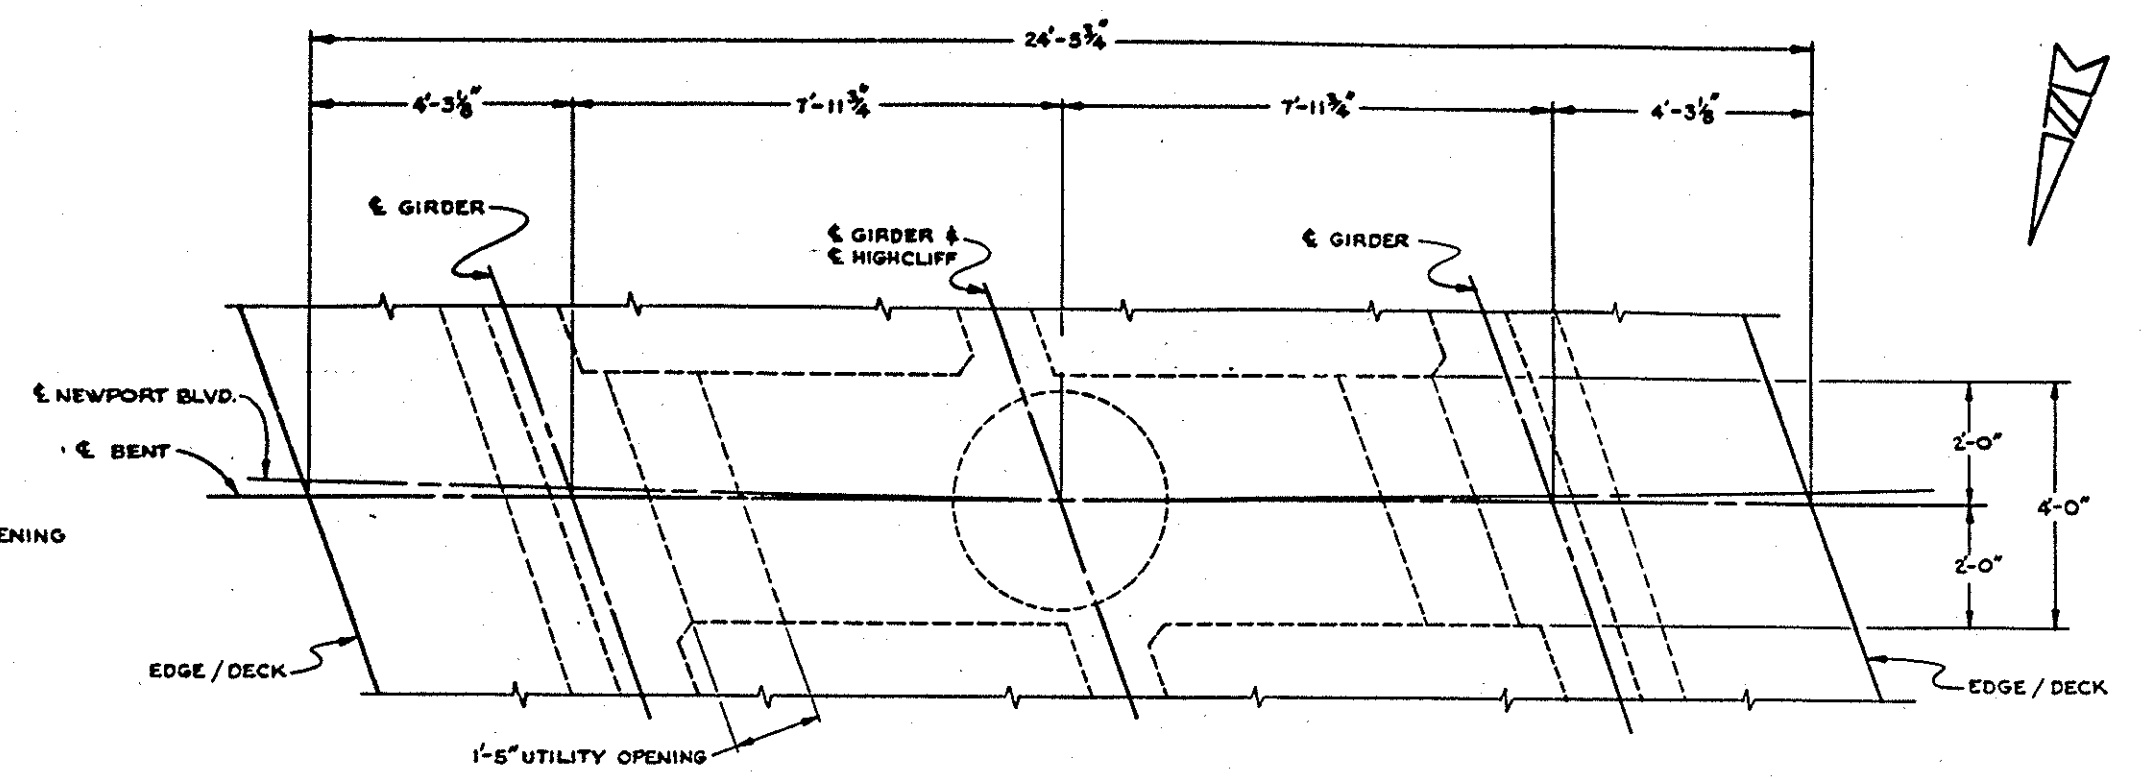

BENT CAP PLAN
SCALE - 3/4" = 1'-0"

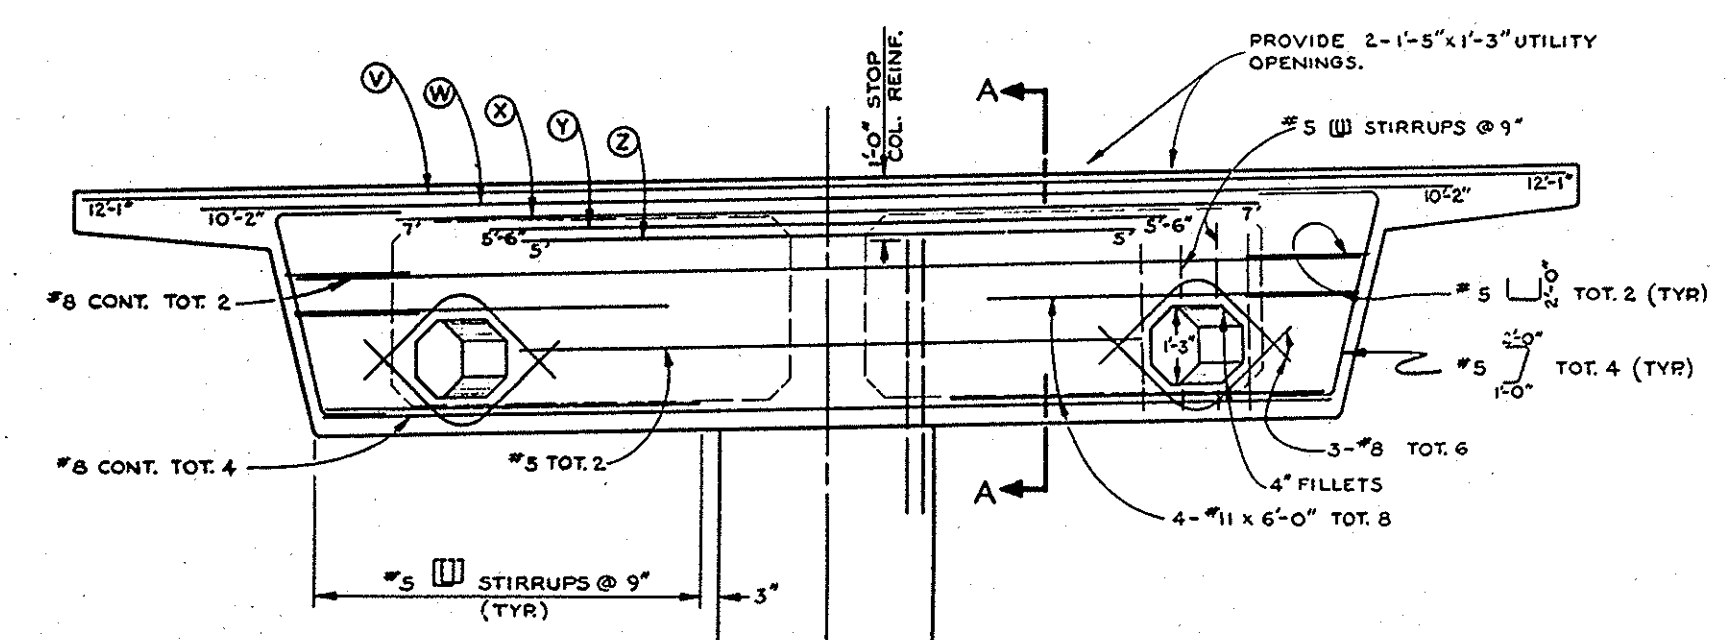

NOTE:
CAP REINF. #11 UNLESS NOTED OTHERWISE.
NUMBERS AT ENDS OF (V) (W) (X) (Y) (Z) BARS
INDICATE DISTANCE FROM COLUMN.

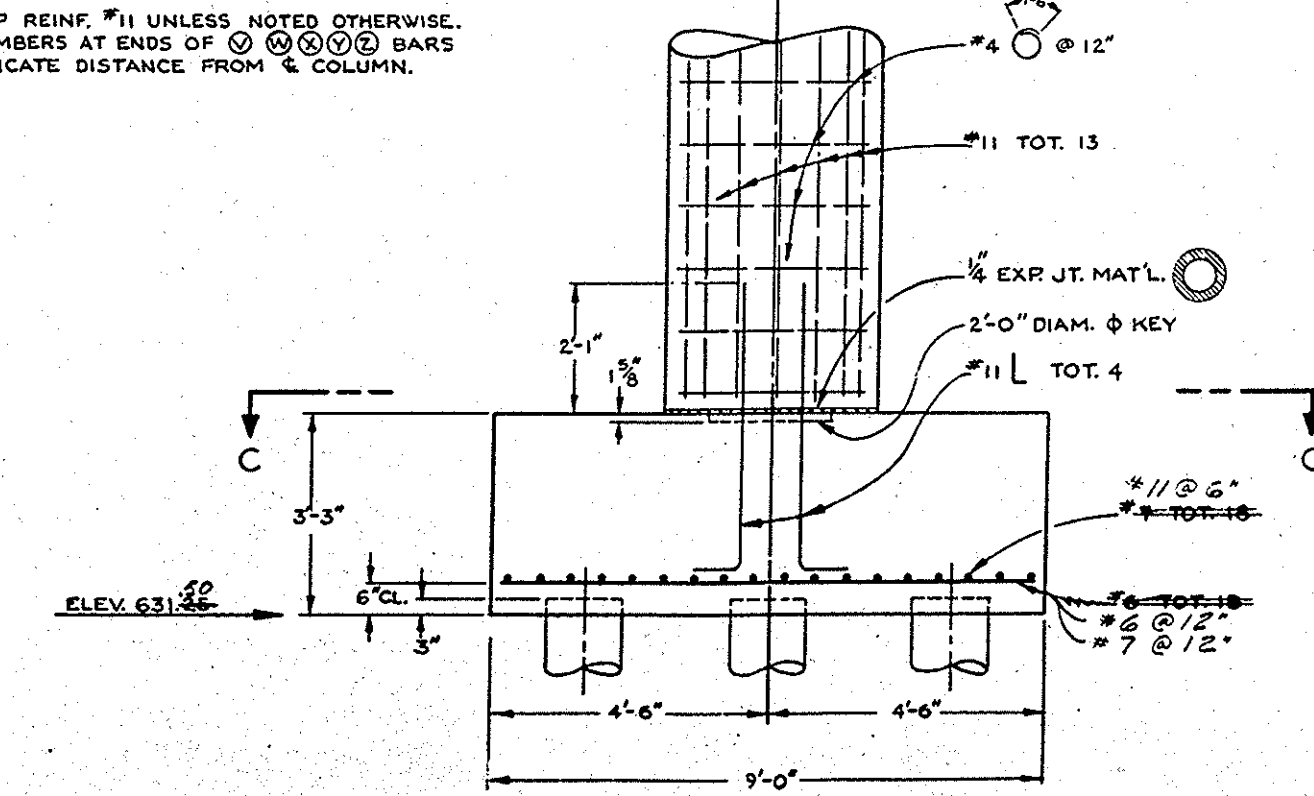

ELEVATION
SCALE - 3/4" = 1'-0"

AS BUILT

9928
Newport Boulevard
Sheet 20 of 60
Red. 22.11 Scale: as shown
Tollan

ORANGE COUNTY ROAD DEPARTMENT
NEWPORT BLVD.
BRIER LANE TO CHAPMAN AVE.
HIGHCLIFF DR. OVERCROSSING
BRIDGE OX-2
BENT DETAIL

Dr. 13(9928)