

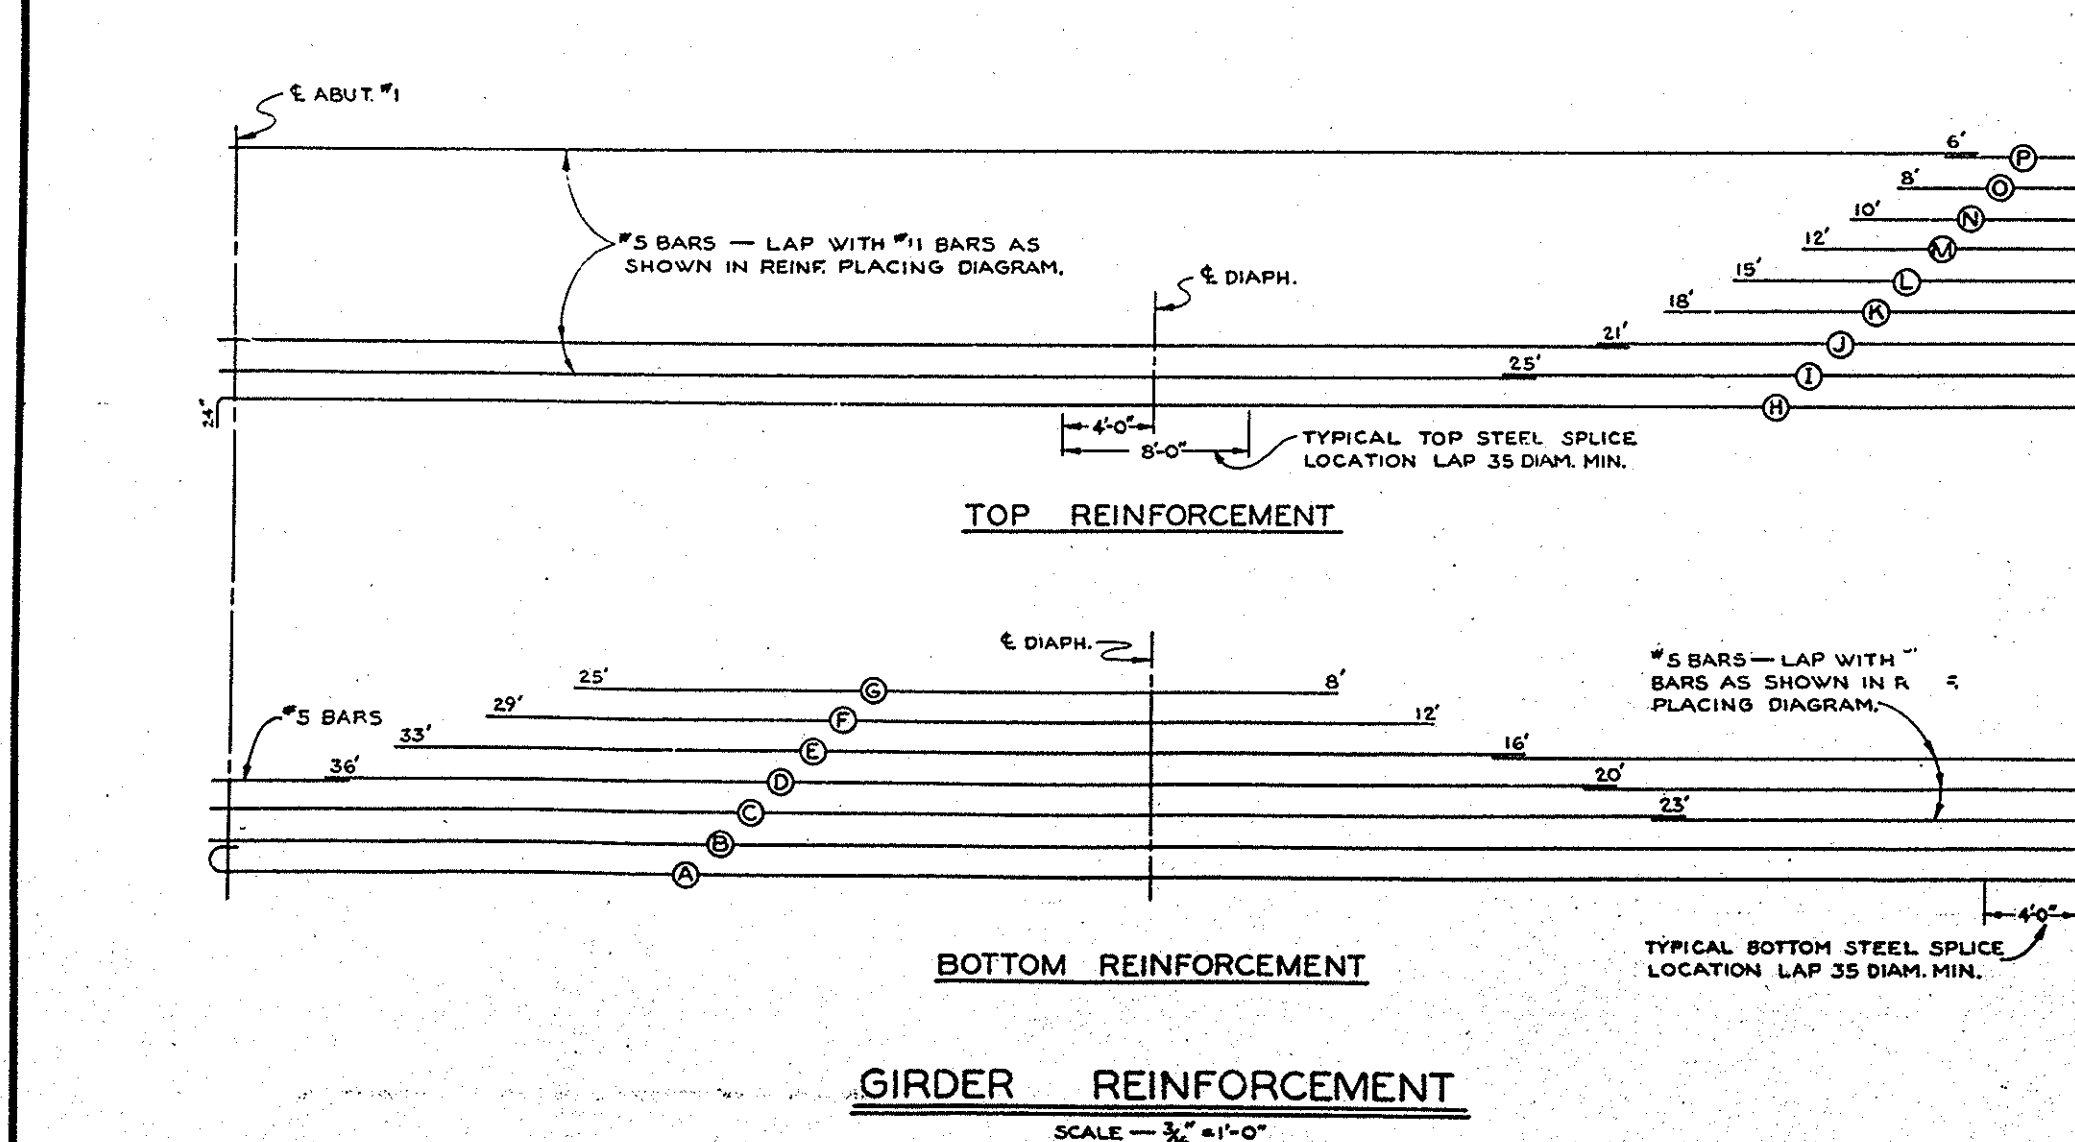
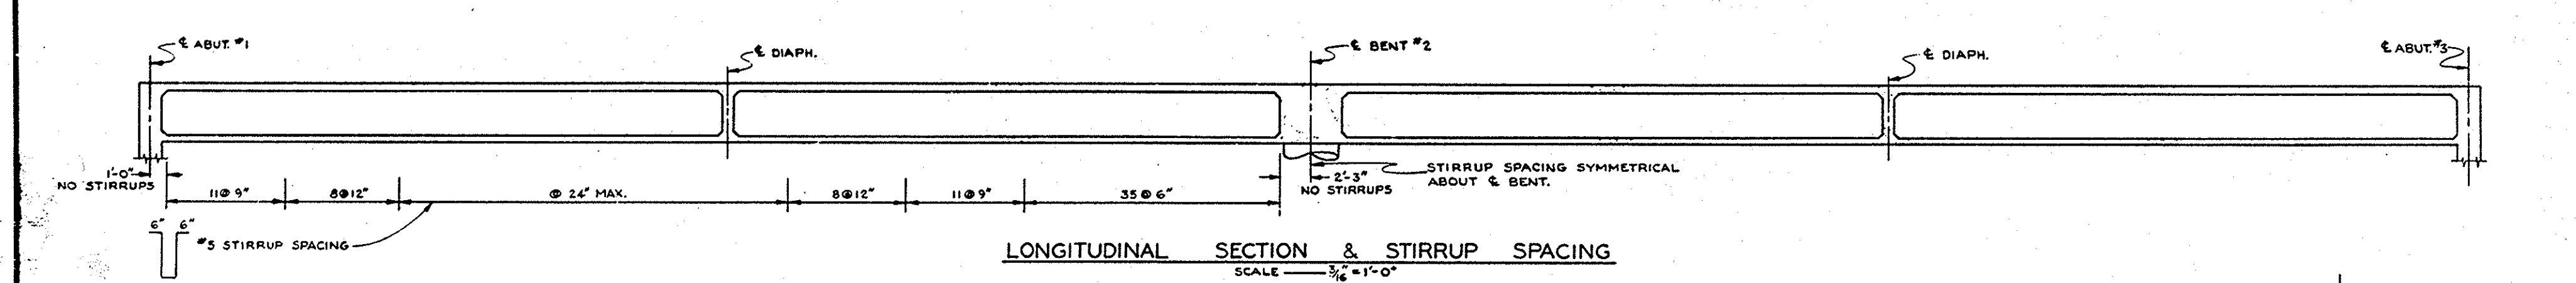


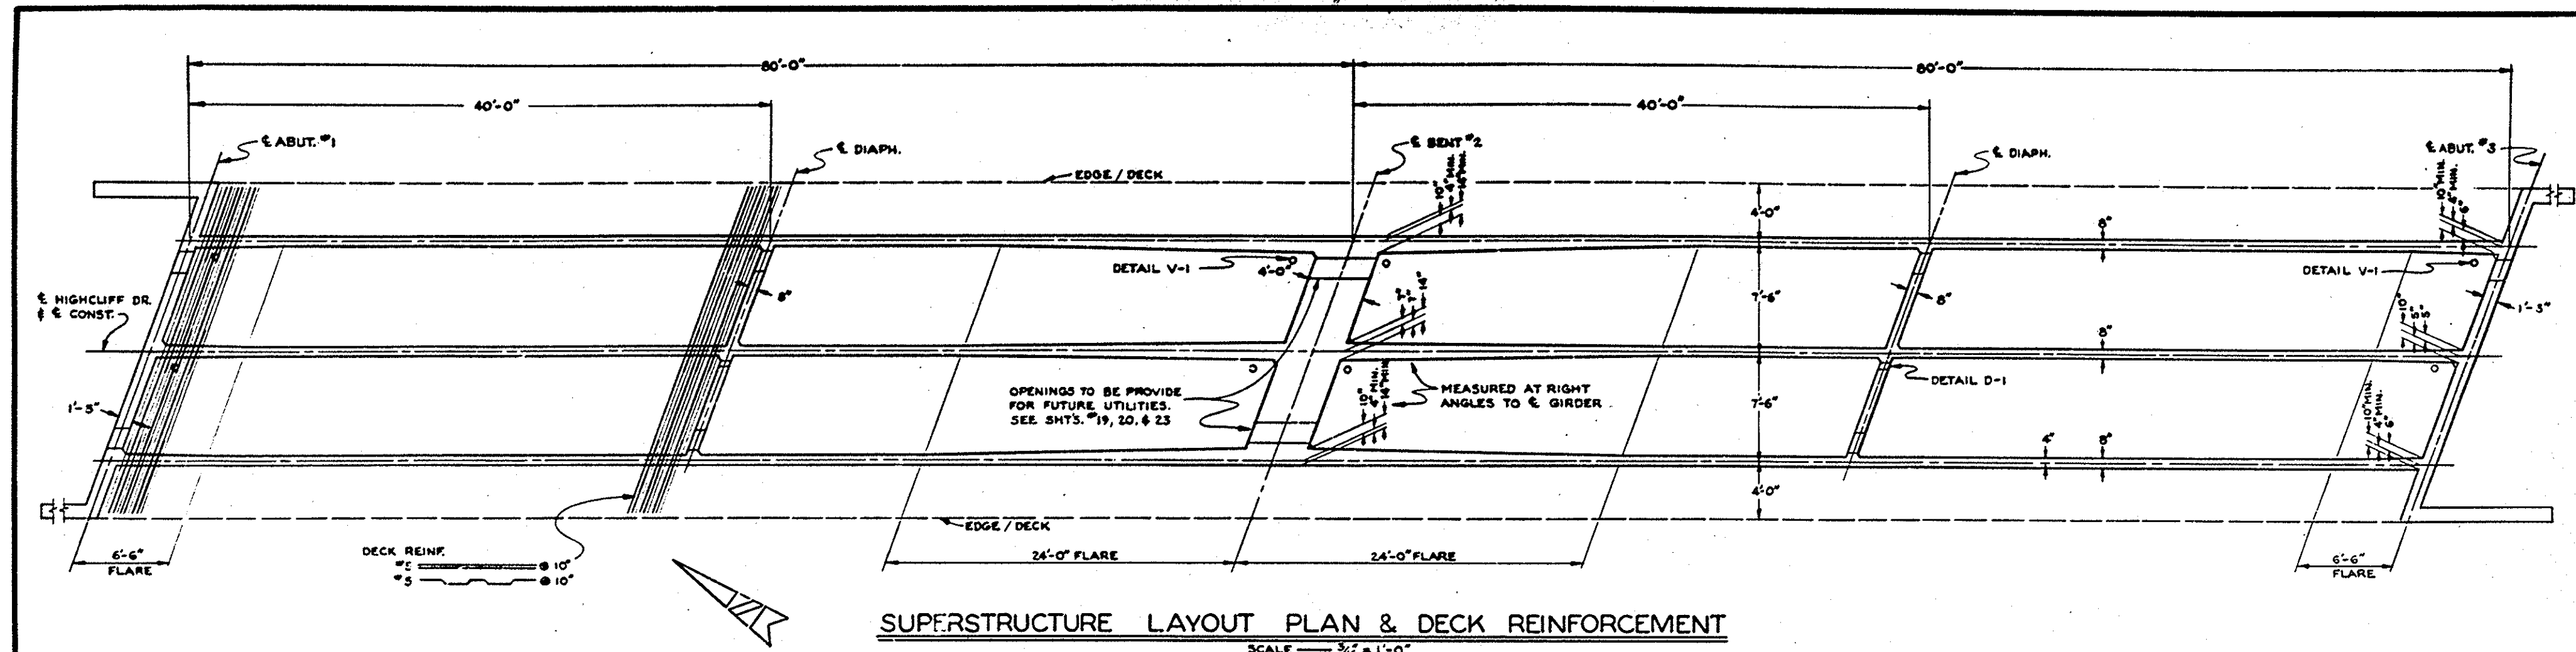

NOTE:
ALL STEEL #11 BARS EXCEPT AS NOTED.
TOP BARS DIM. FROM G. PIER.
BOTTOM BARS DIM. FROM G. DIAPH.

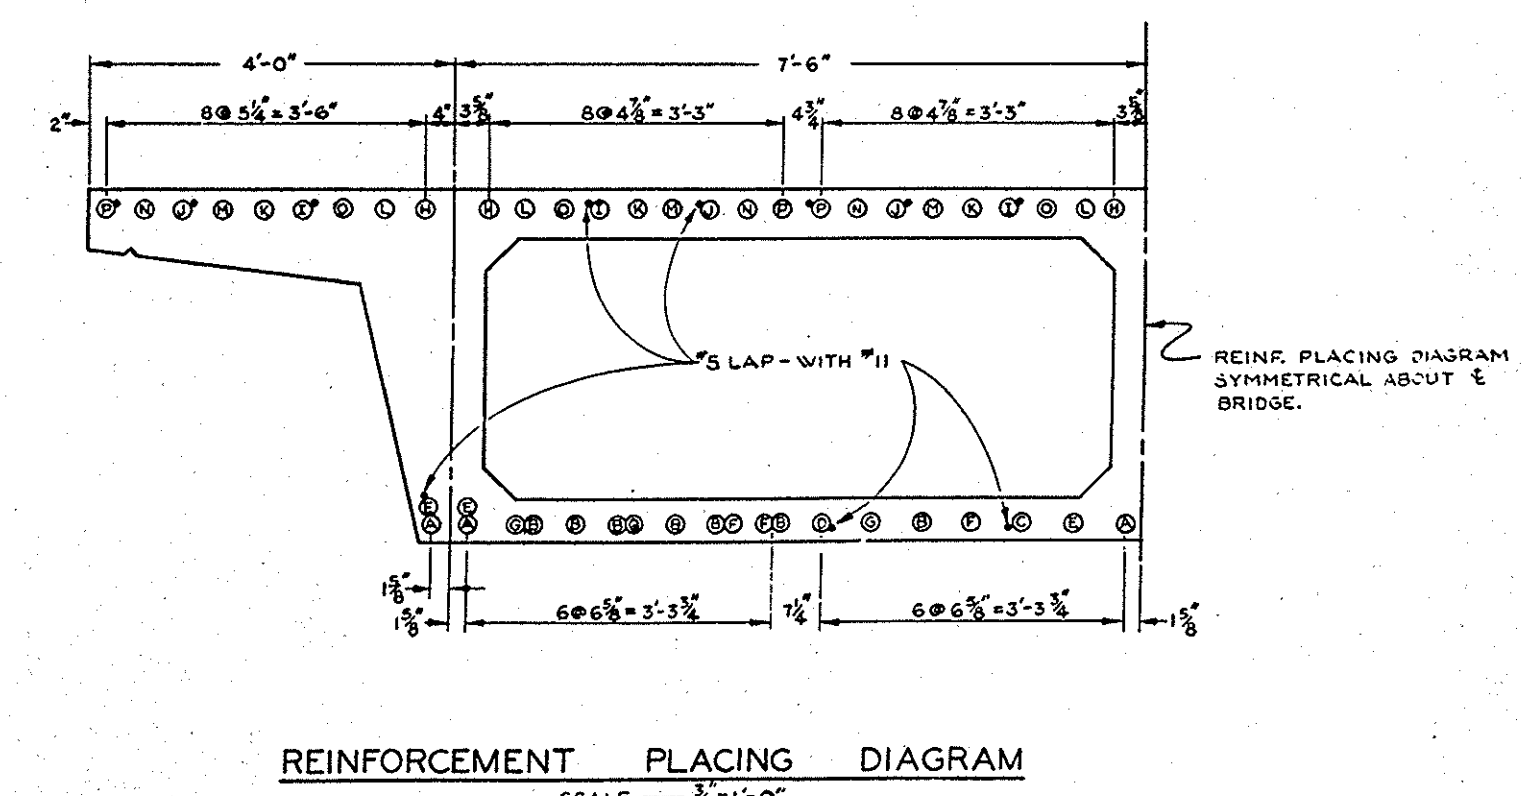

AS BUILT

9928
Newport Boulevard
Sheet 21 of 60
Red, 22.5:1 Scale: as shown
Yellow

GRANDE COUNTY ROAD DEPARTMENT

NEWPORT BLVD.
BRIER LANE TO CHAPMAN AVE.
HIGHCLIFF DR. OVERCROSSING
BRIDGE 0X-2
SUPERSTRUCTURE LAYOUT
& REINFORCEMENT

NOTED

SHEET 21 OF 60

Mr. 13 (9928)