

STRAIGHT EDGE RULE SE-48

Rev. Added 40' on
section A-A & D-D.
Added a "long dim
" nail in section d.
1-60 RTK

changed Dim. in Sec 8-5
to 1 1/2". Revised
on true Sec. 8-6
1-72 J. S. S. 11

changed Dim. in Sec. 8-6
3/8 to 1 7/8. Revised
on form Sec. 0-6
189 12-8-11


Rev. Notes, lower
Right Cor. Rev. Title
Block + Co. Rt. Sec.
Block, Deleted
Signature Block
+ Block above
Co. Rt. Sec. J1112-124

Revised title page
12-87-88
26 Feb 65 EJS

ACCT OUTSIDE A RAIL
CONNECTION FOR THE 4.
CHARGE TO 10 TO 60
Pm Sec. P-2-X S S
RAIL S C.

15192 SECTION CO AND BUILT
 15193 15194 15195
 15196 15197 15198

2-ANAL. TITLE:
"BARBARA RAINES' SWEET"
"TO BARBARA RAINES BETAL"
DATE TO 8/65. 138X/65 ELI

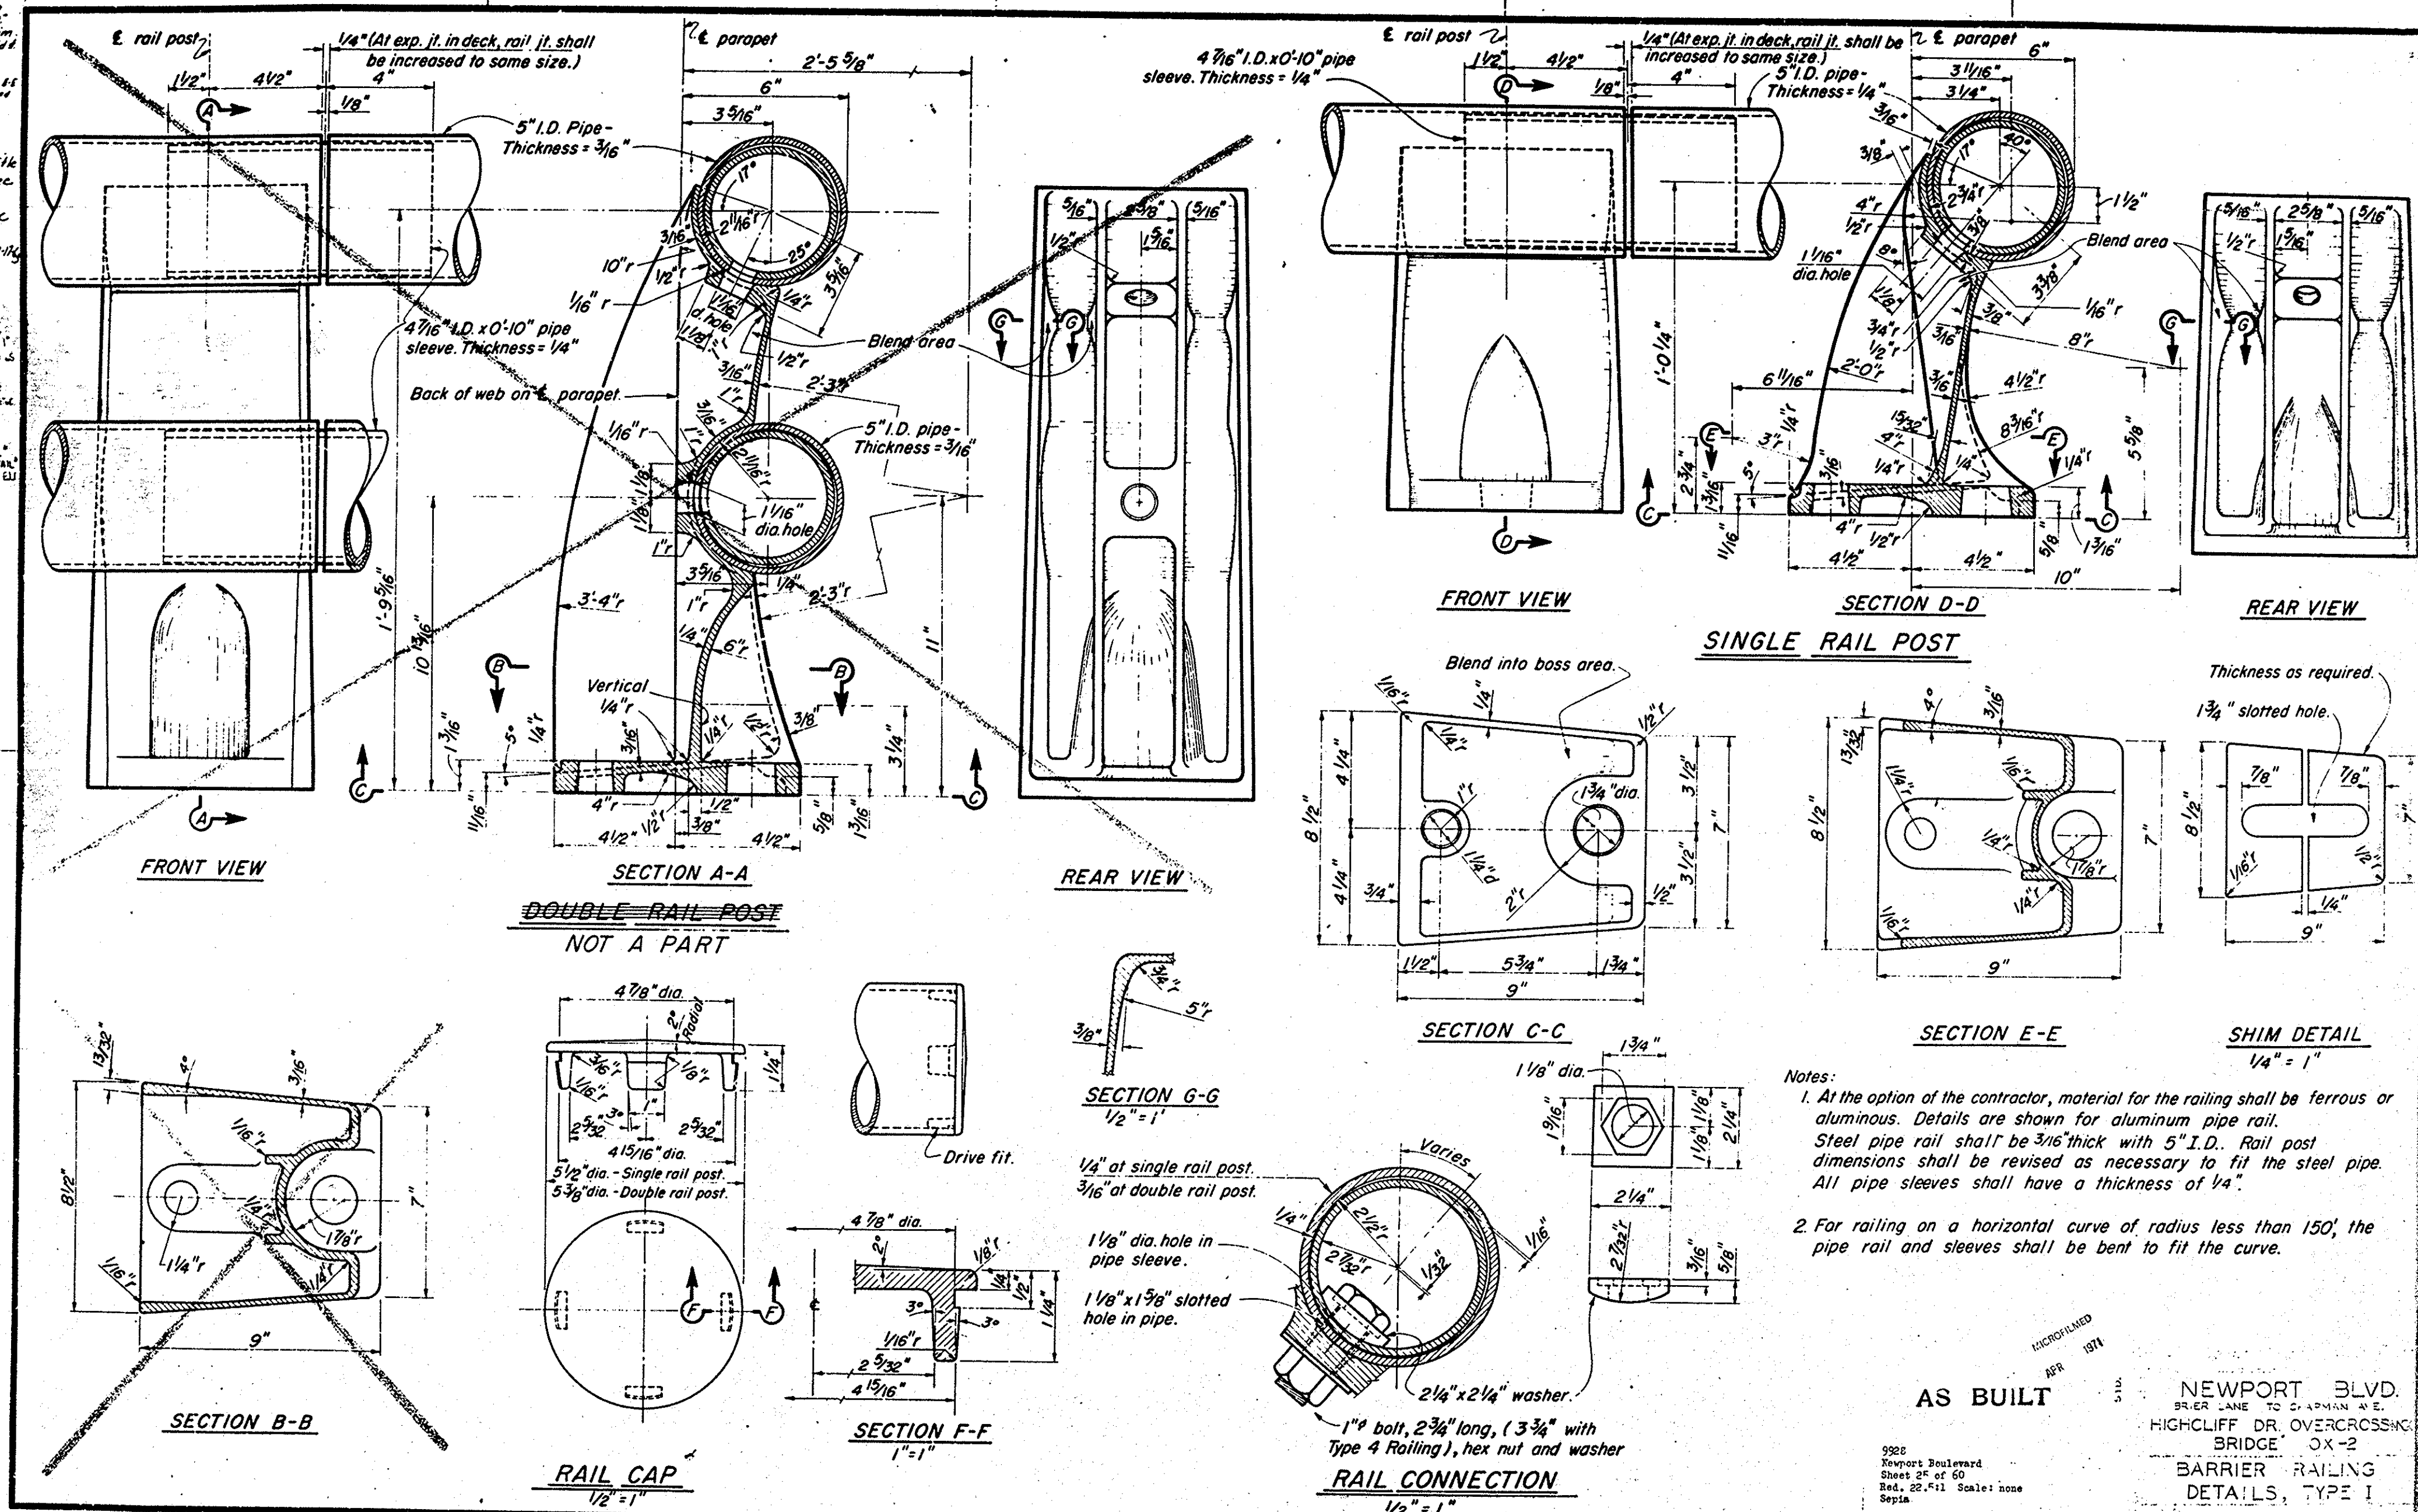

Notes:

1. At the option of the contractor, material for the railing shall be ferrous or aluminum. Details are shown for aluminum pipe rail. Steel pipe rail shall be $\frac{3}{16}$ " thick with 5" I.D. Rail post dimensions shall be revised as necessary to fit the steel pipe. All pipe sleeves shall have a thickness of $\frac{1}{4}$ ".
2. For railing on a horizontal curve of radius less than 150', the pipe rail and sleeves shall be bent to fit the curve.

AS BUILT

NEWPORT BLVD.
BRIDGE TO GRAPMAN AVE.
HIGHCLIFF DR. OVERCROSSING
BRIDGE BOX-2
BARRIER RAILING
DETAILS, TYPE I

Dr. 13 (9928)