


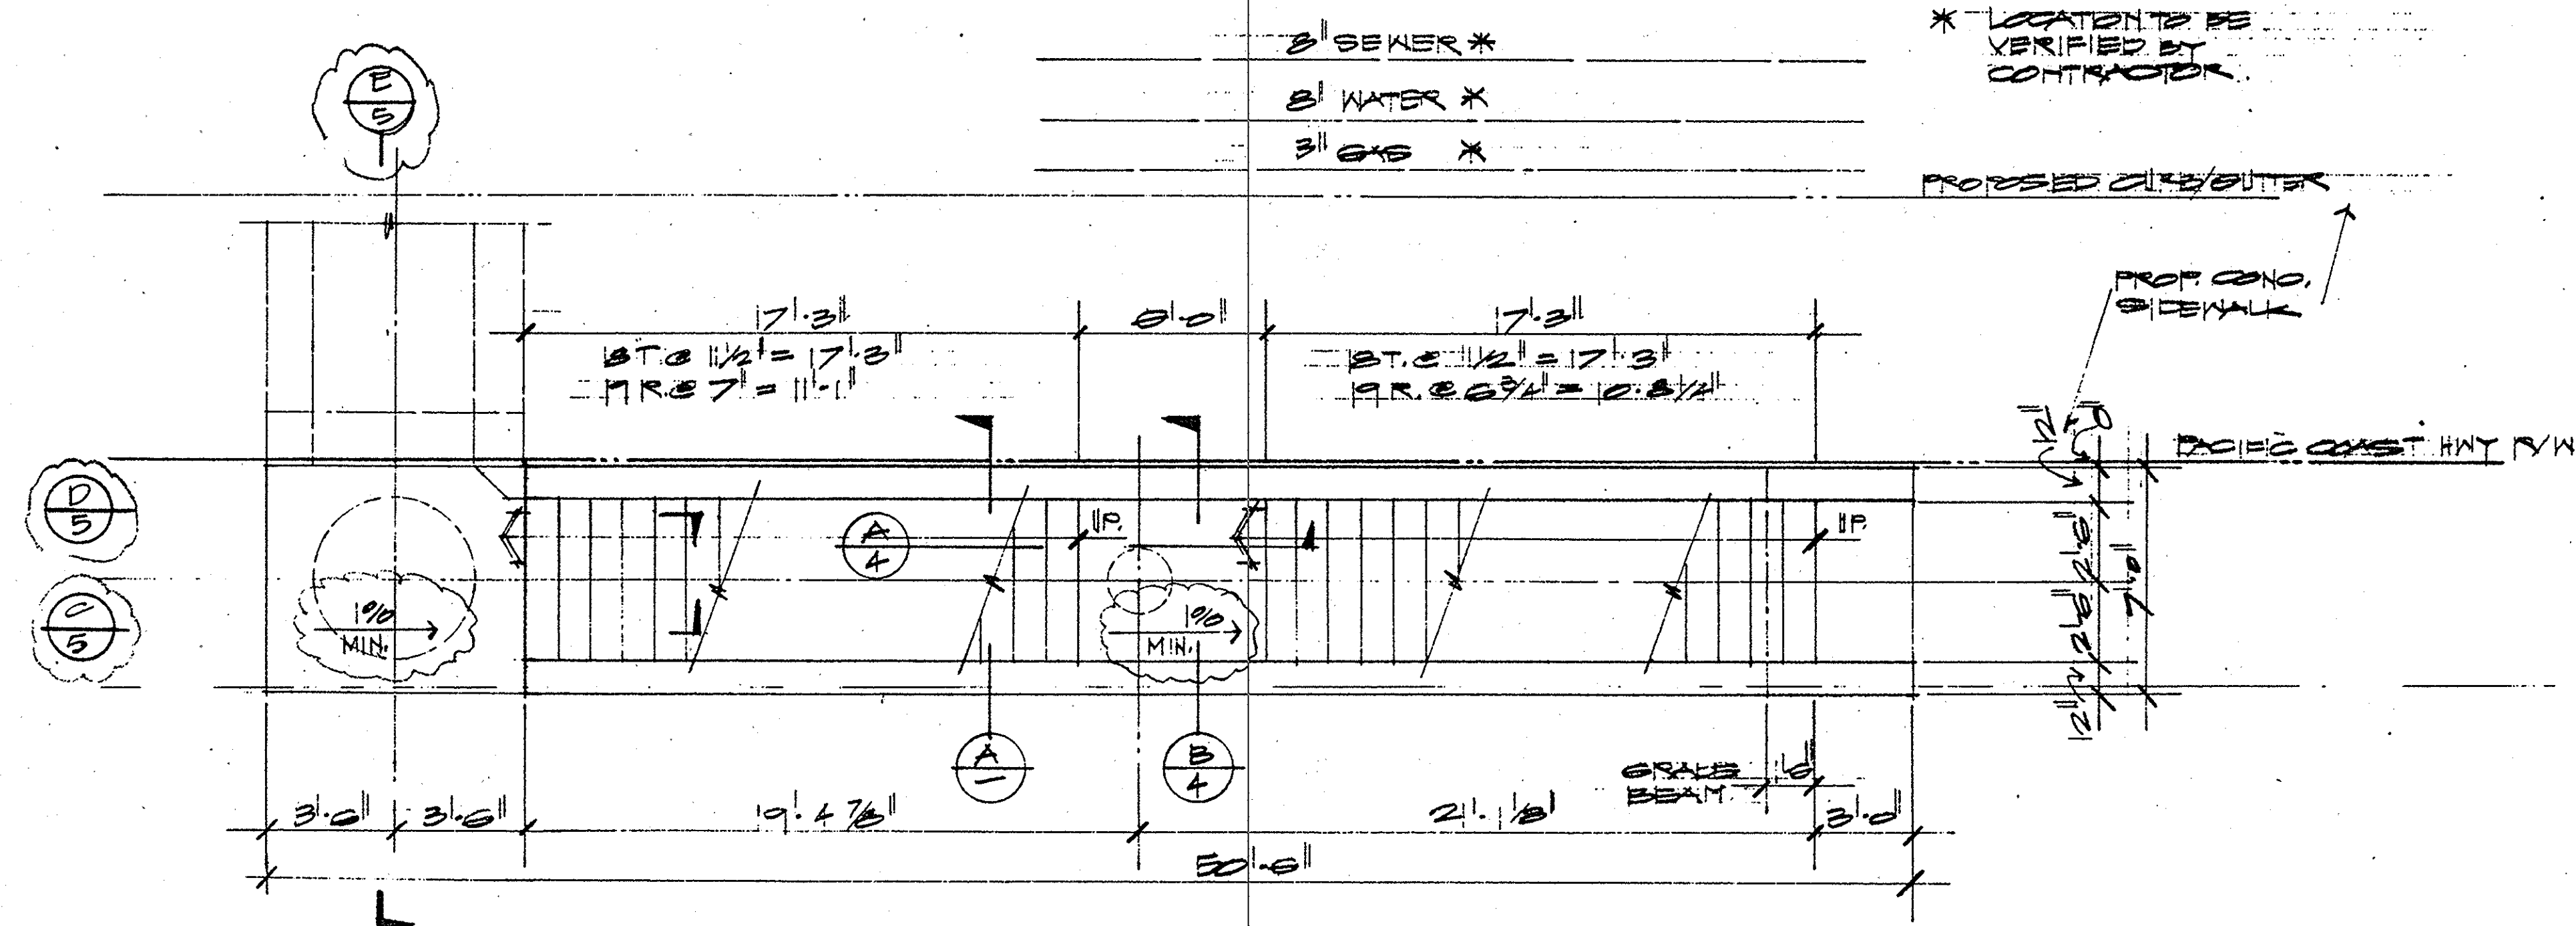


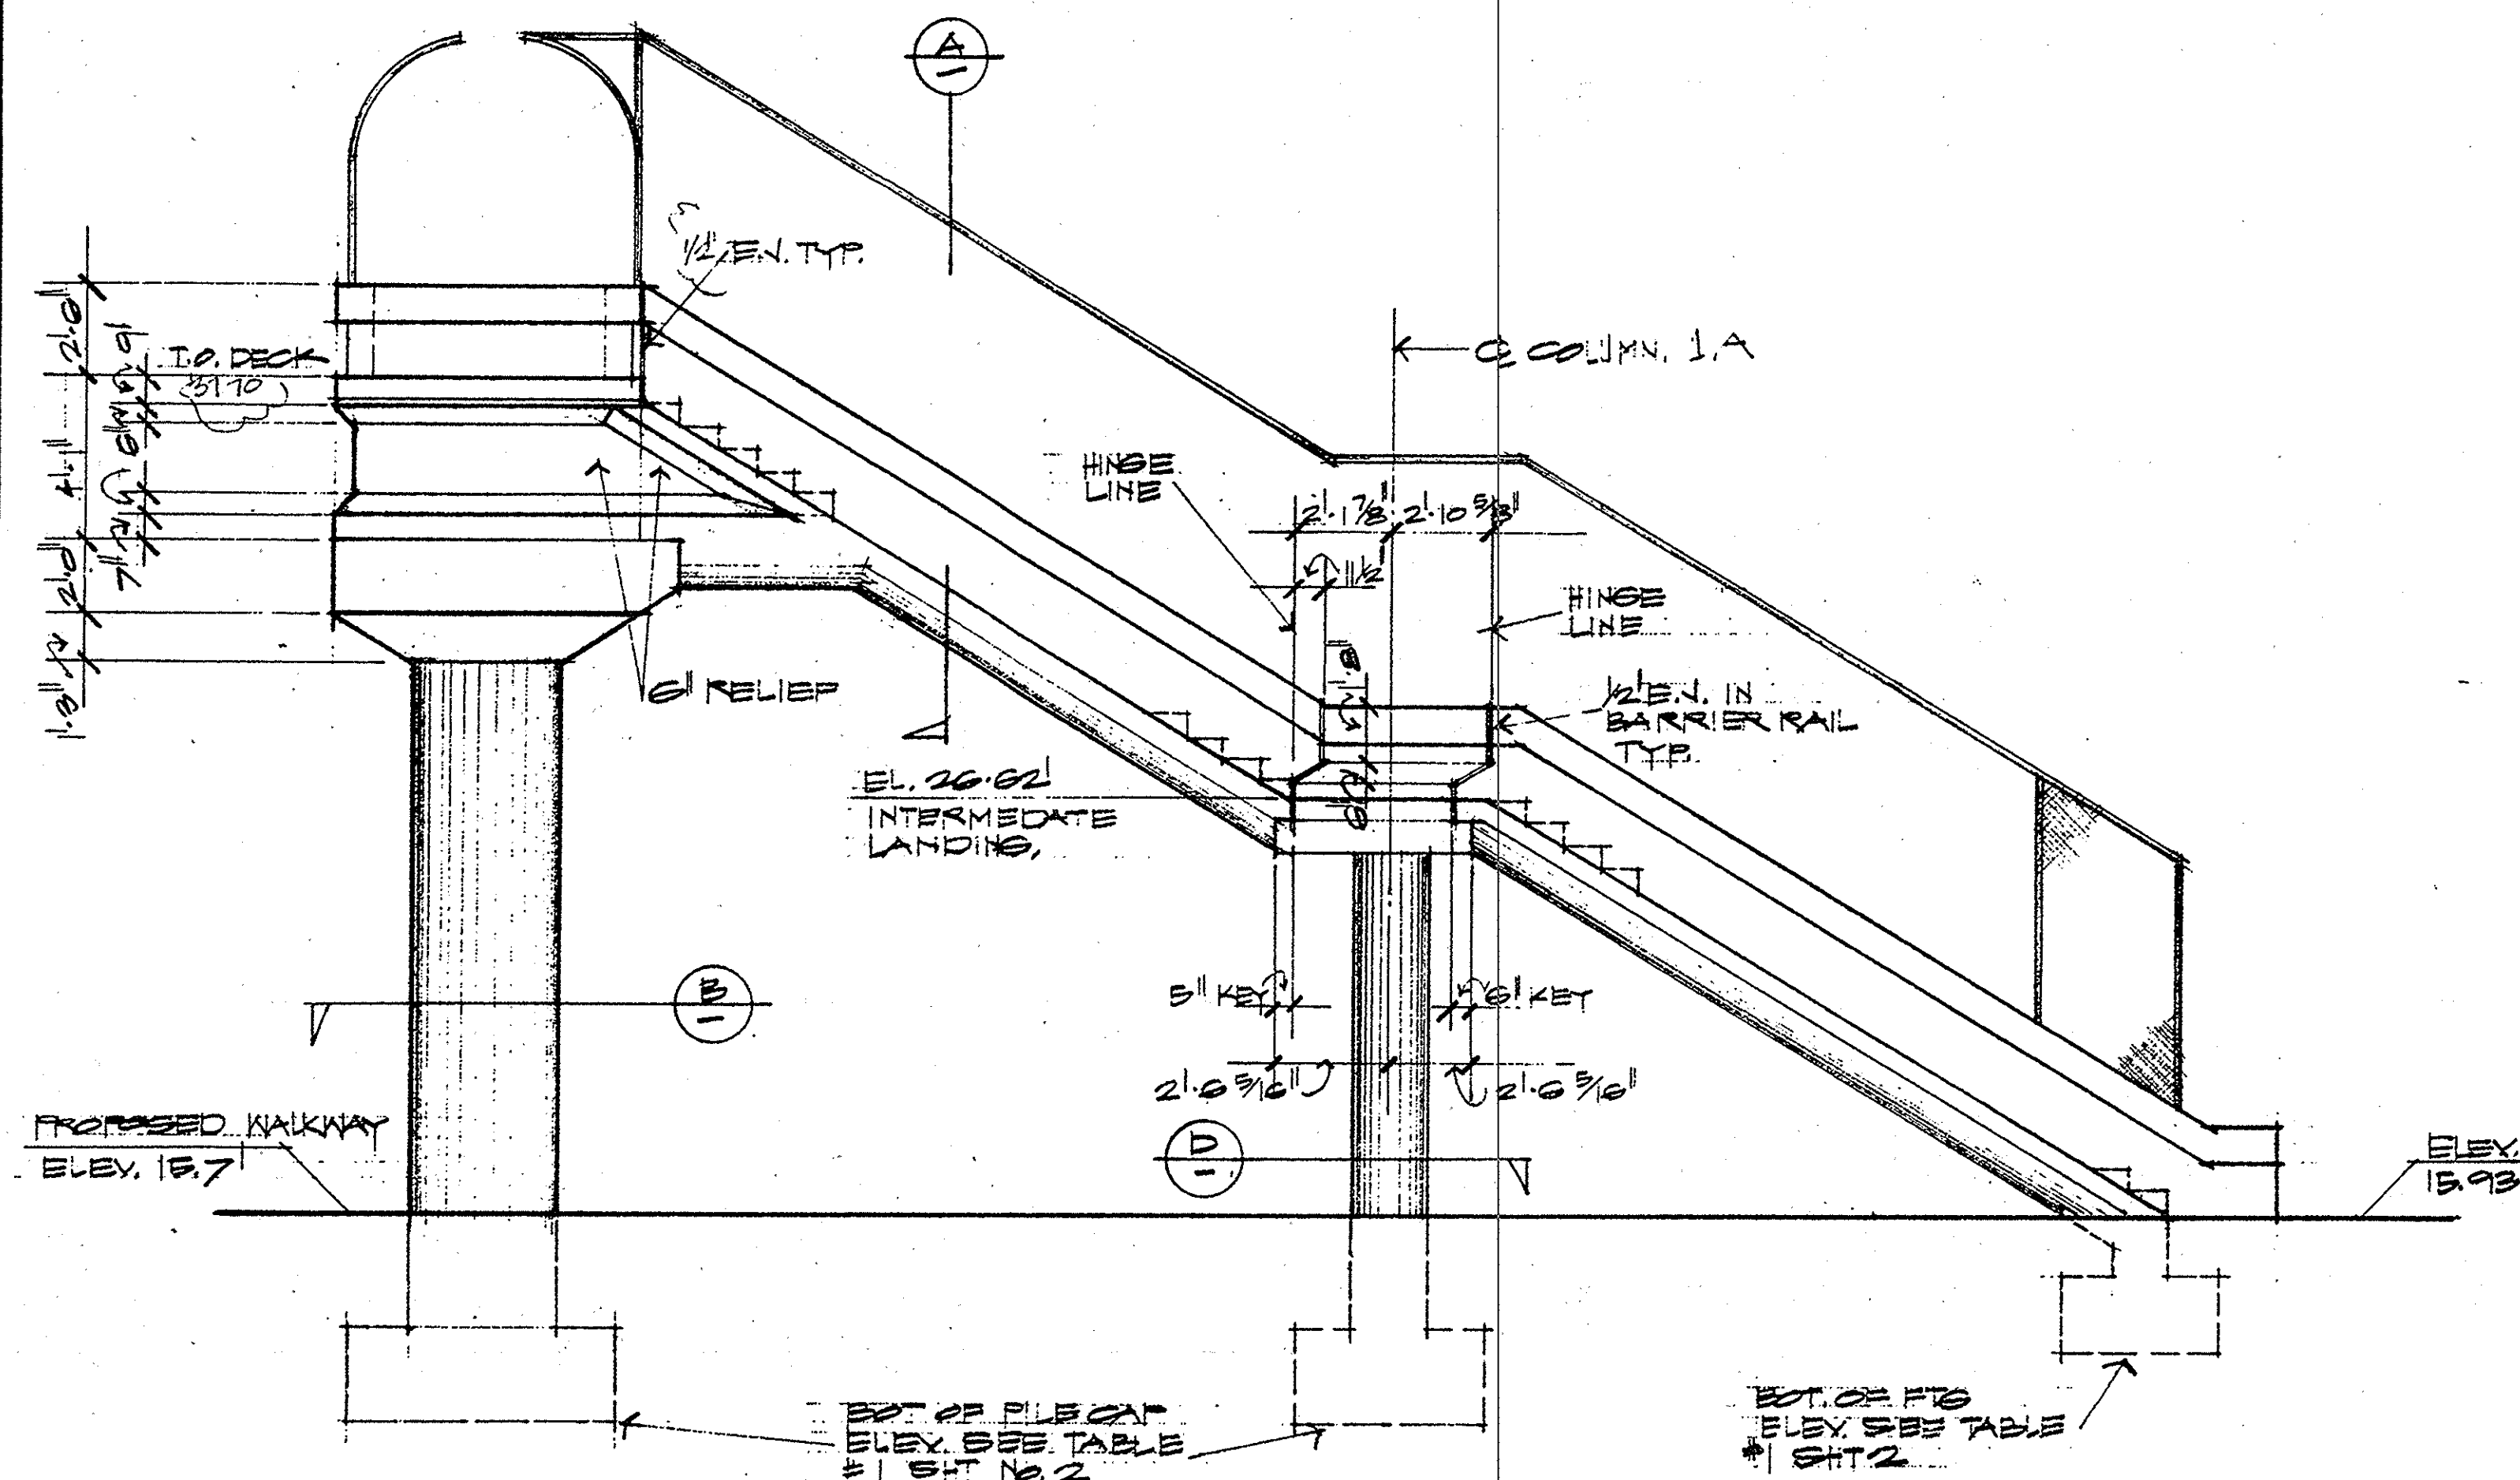

PLAN 1/4"=1'-0"

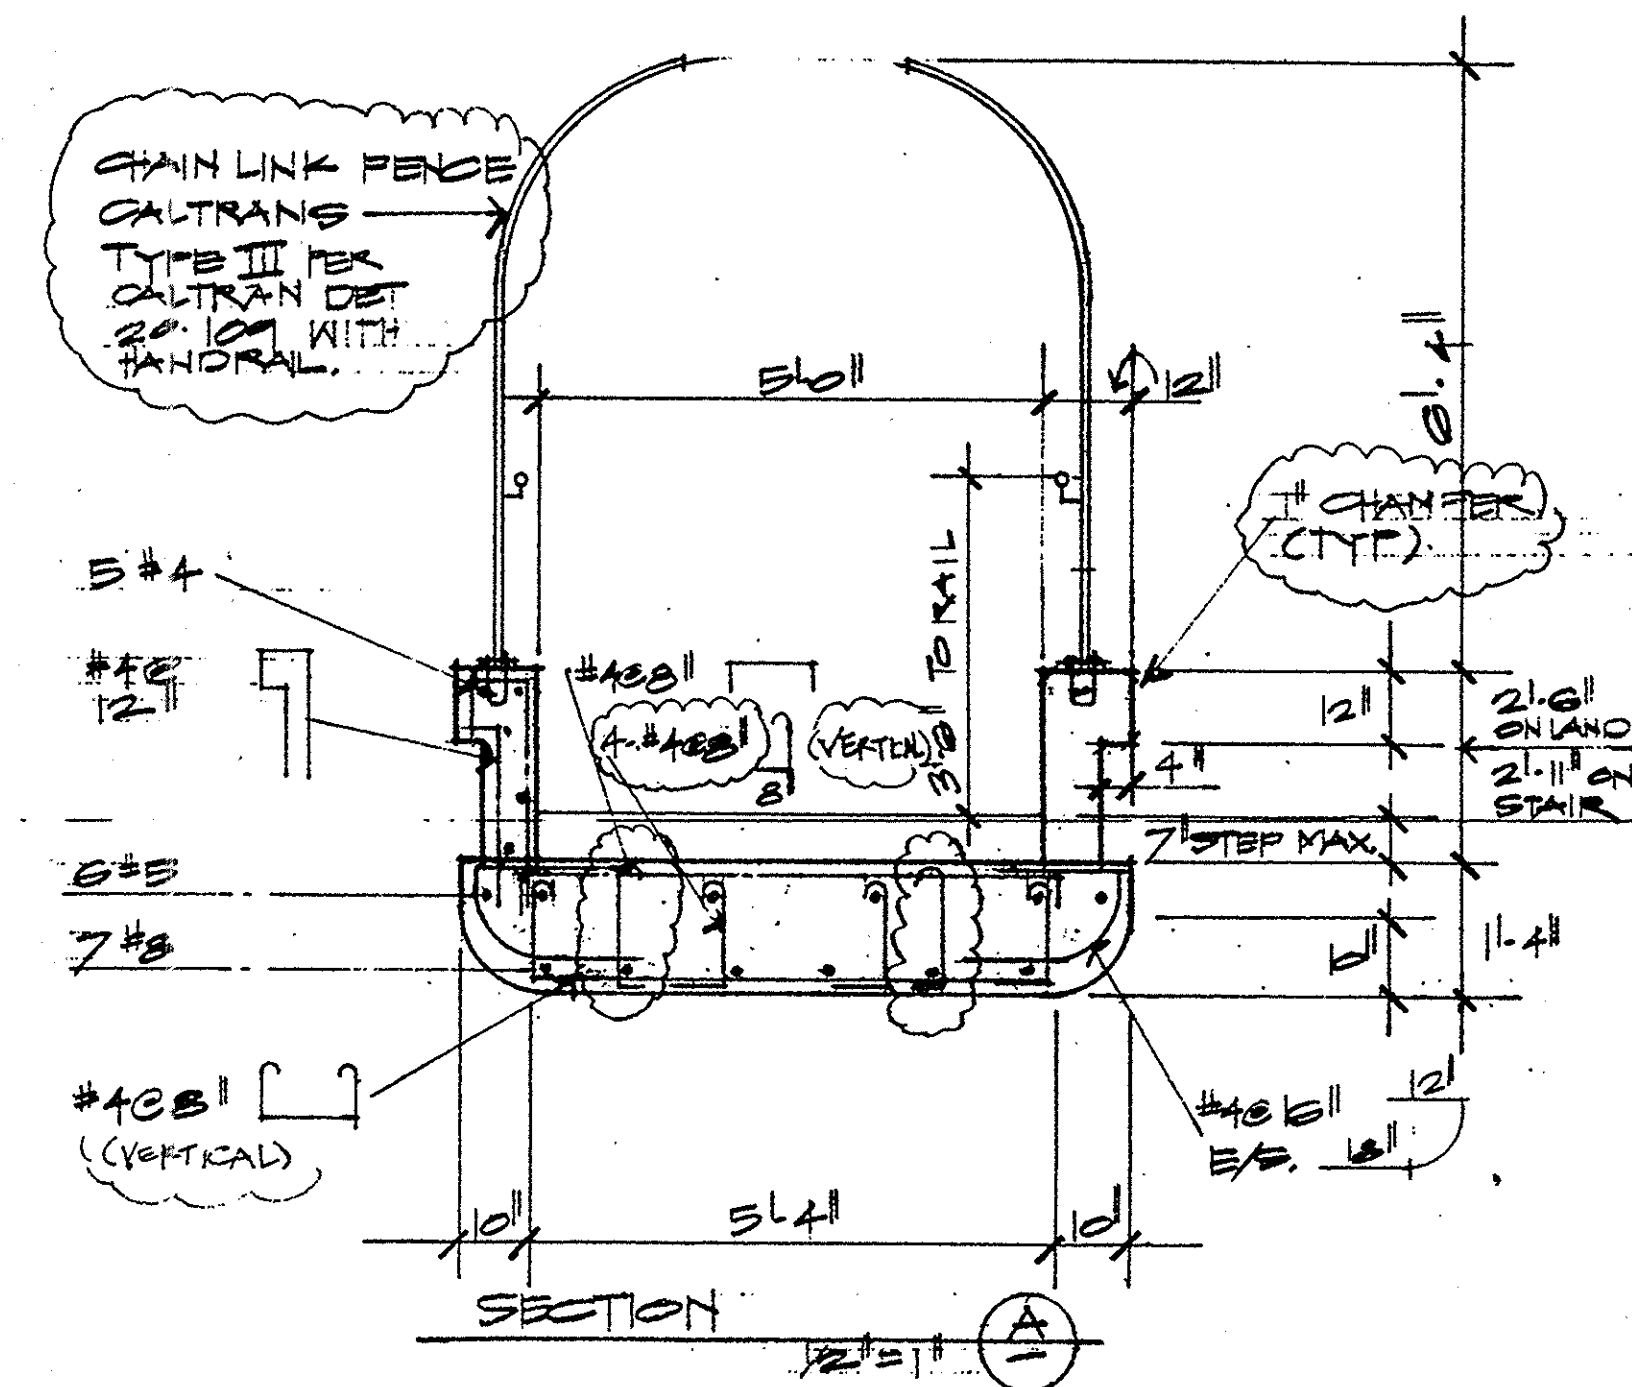

NORTH ELEVATION 1/4"=1'-0"

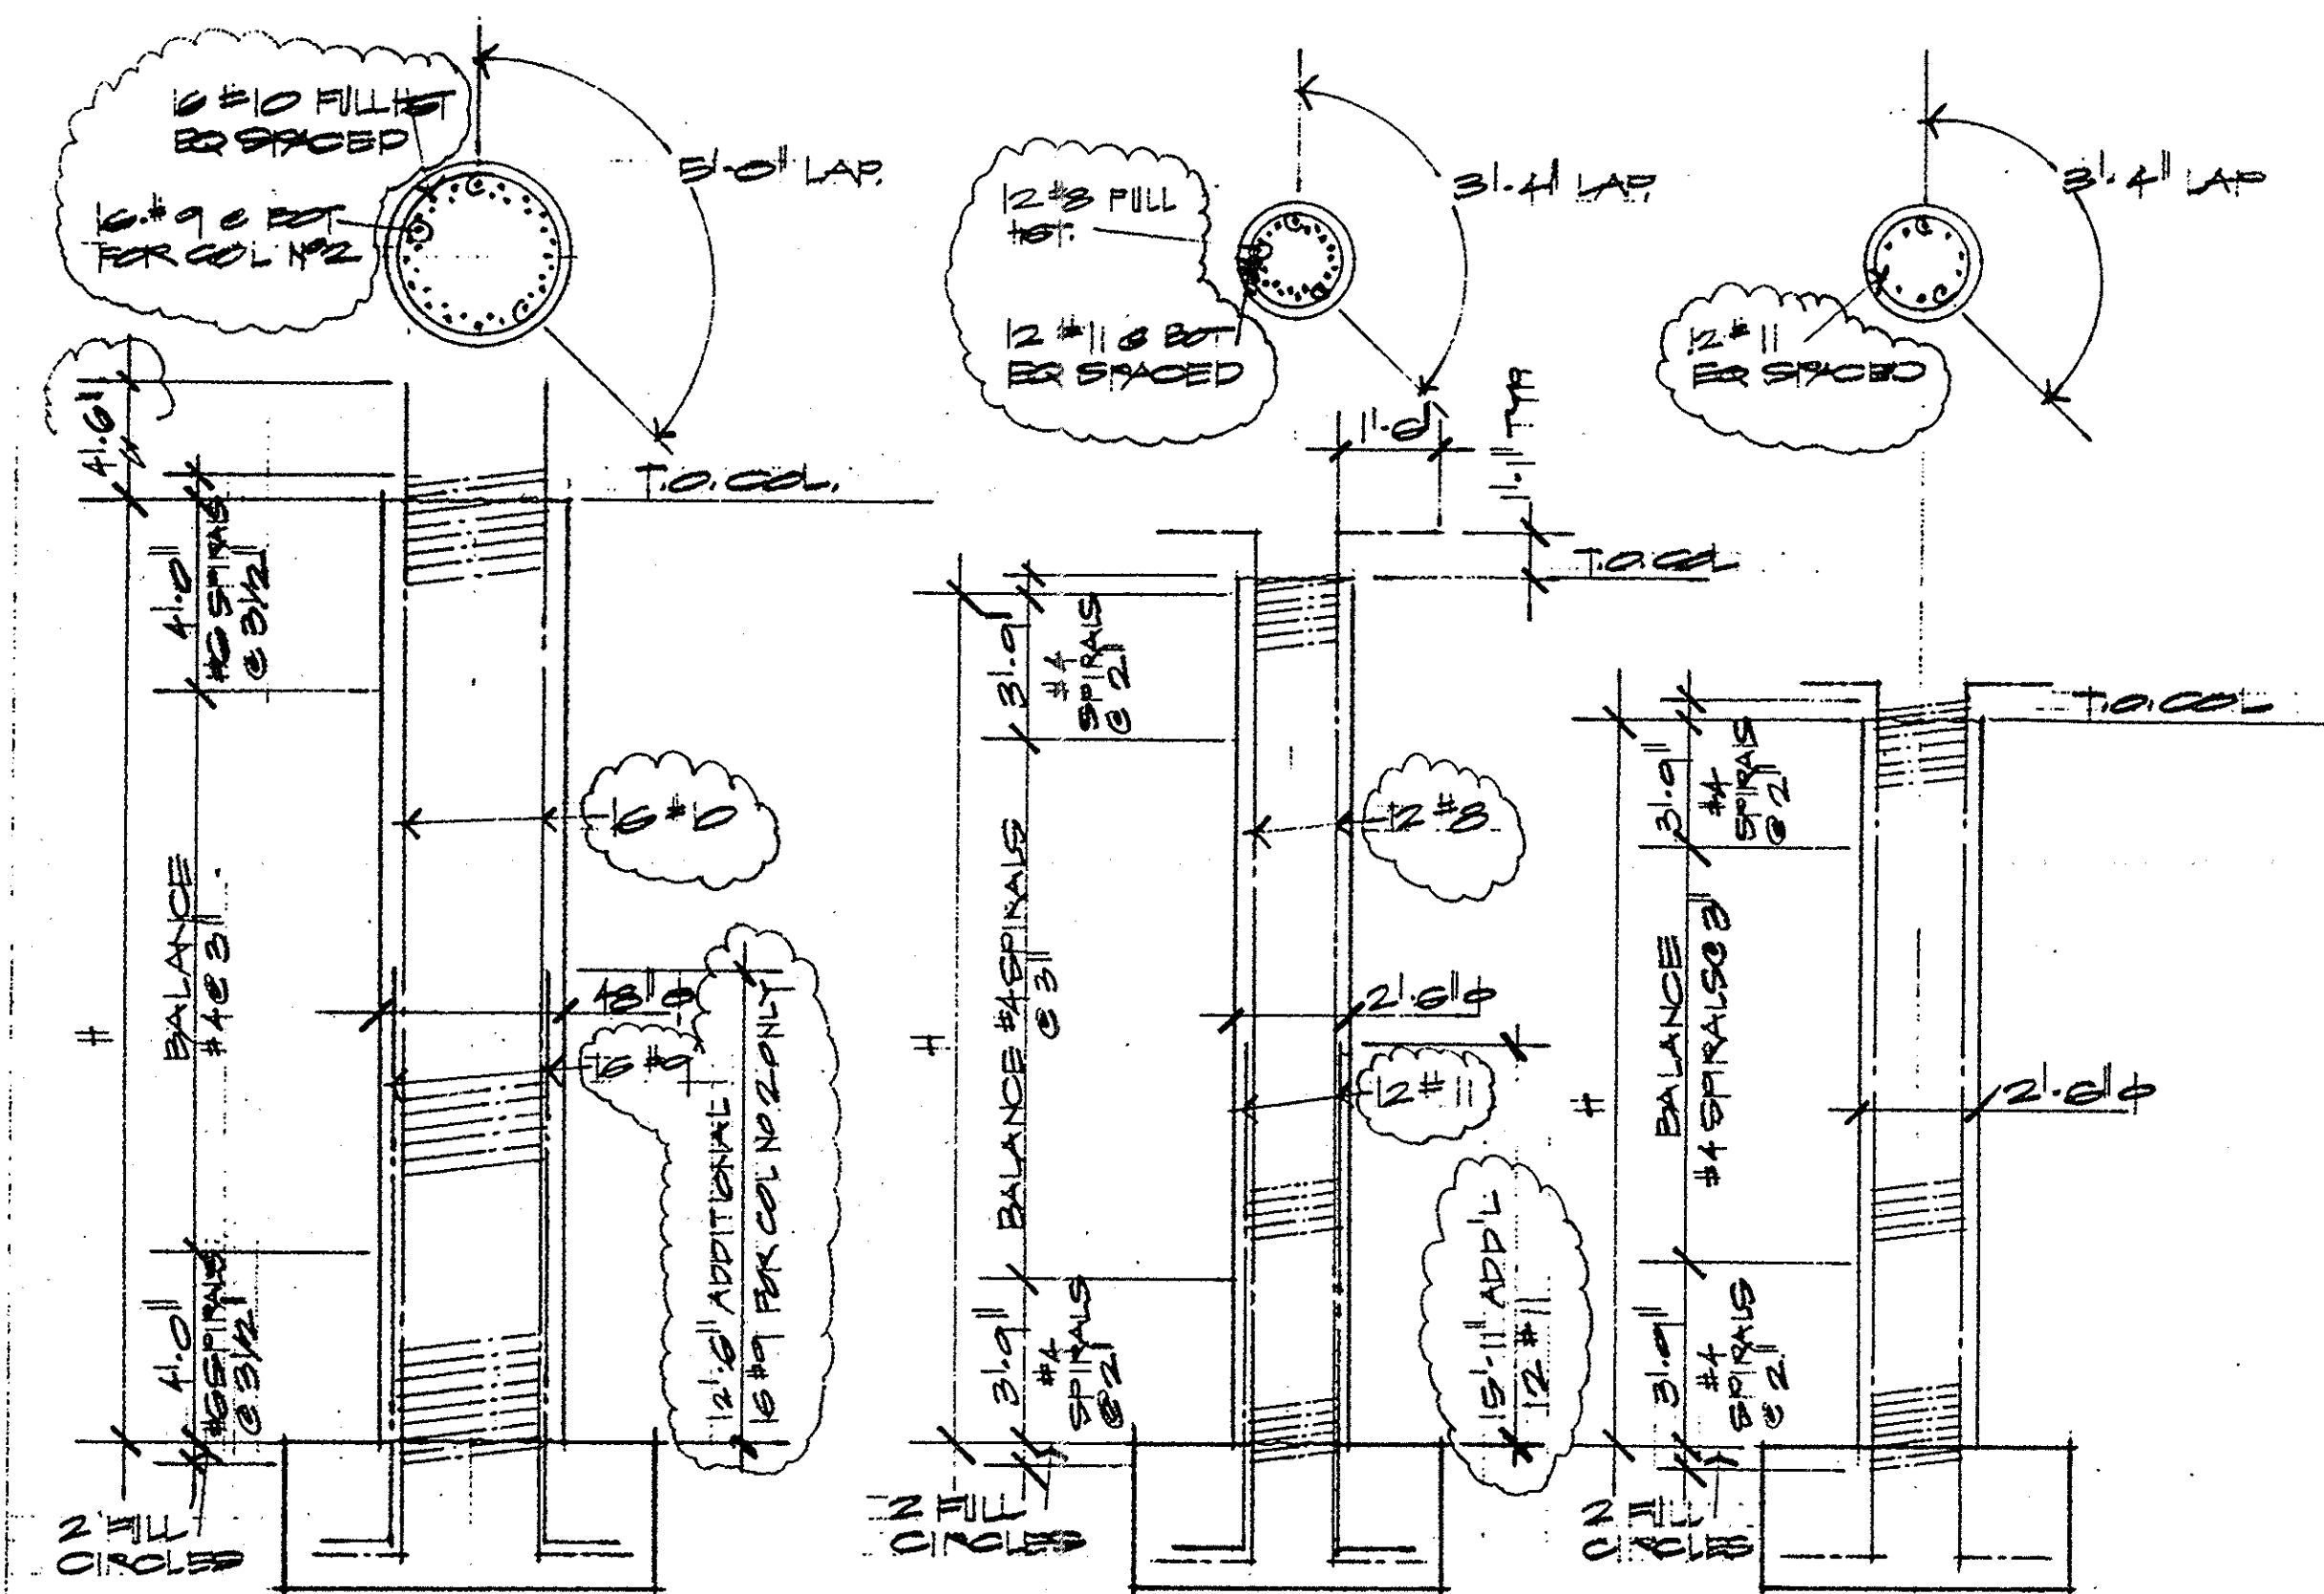

COL. # 1, 2 & 3

COL. # 1A & 2A

COL. # 1B, 2B & 3A