
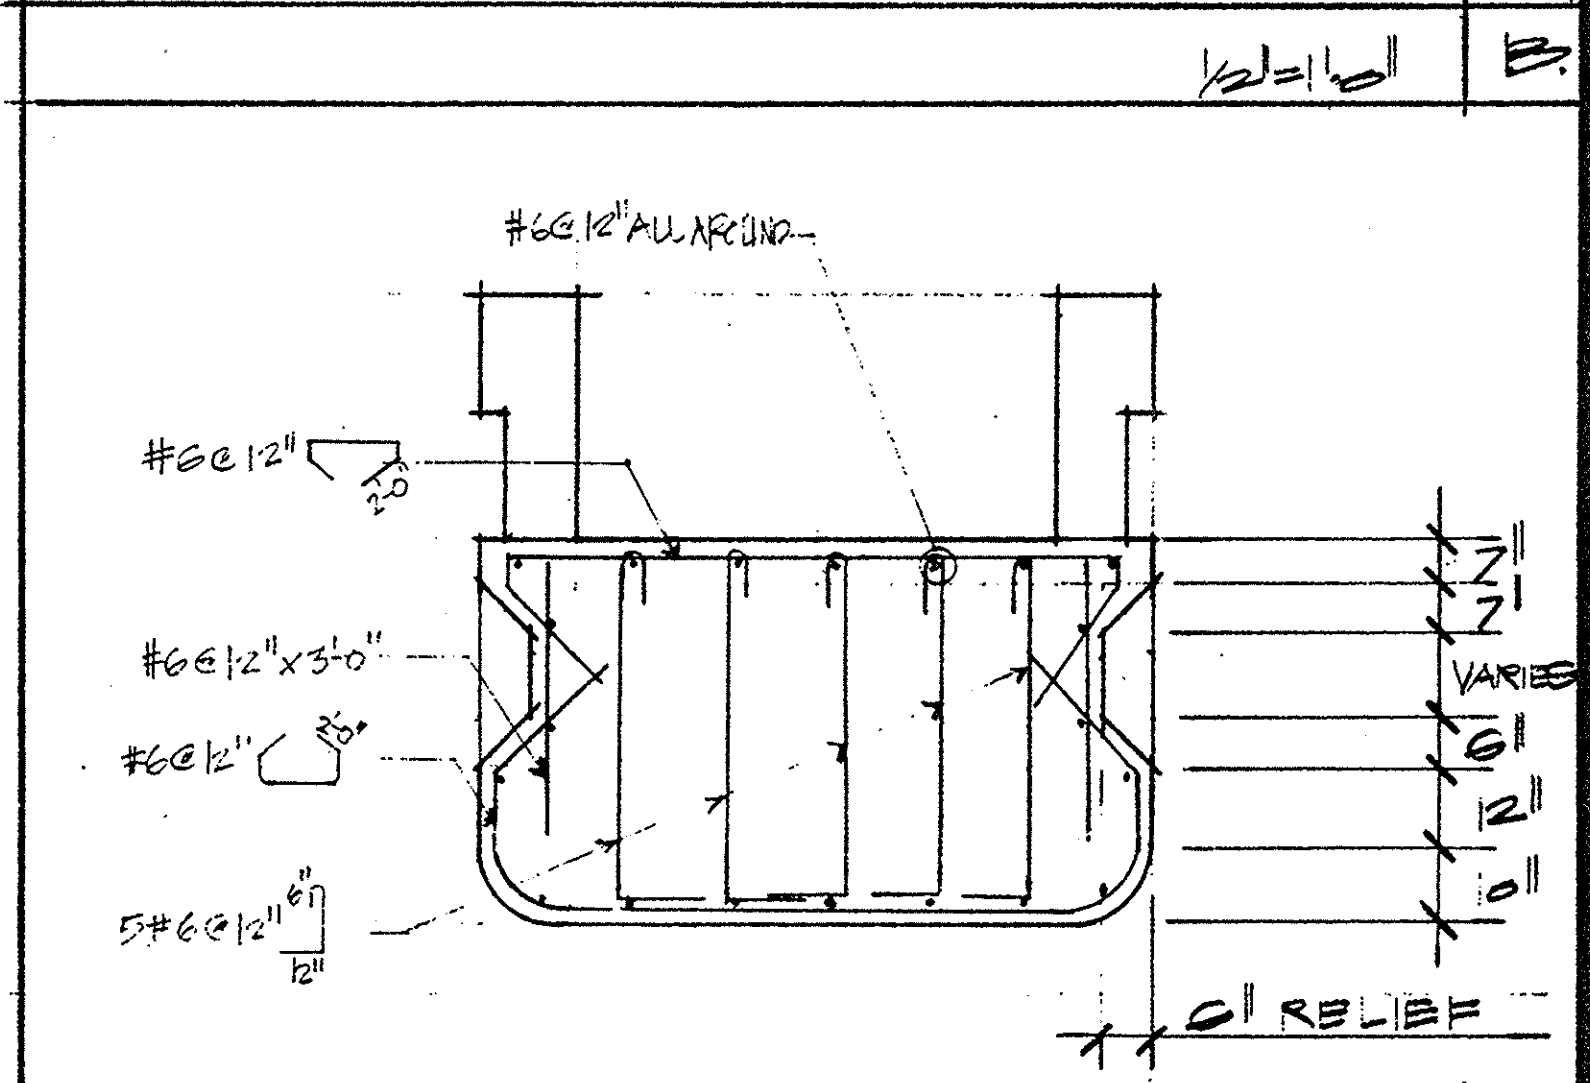
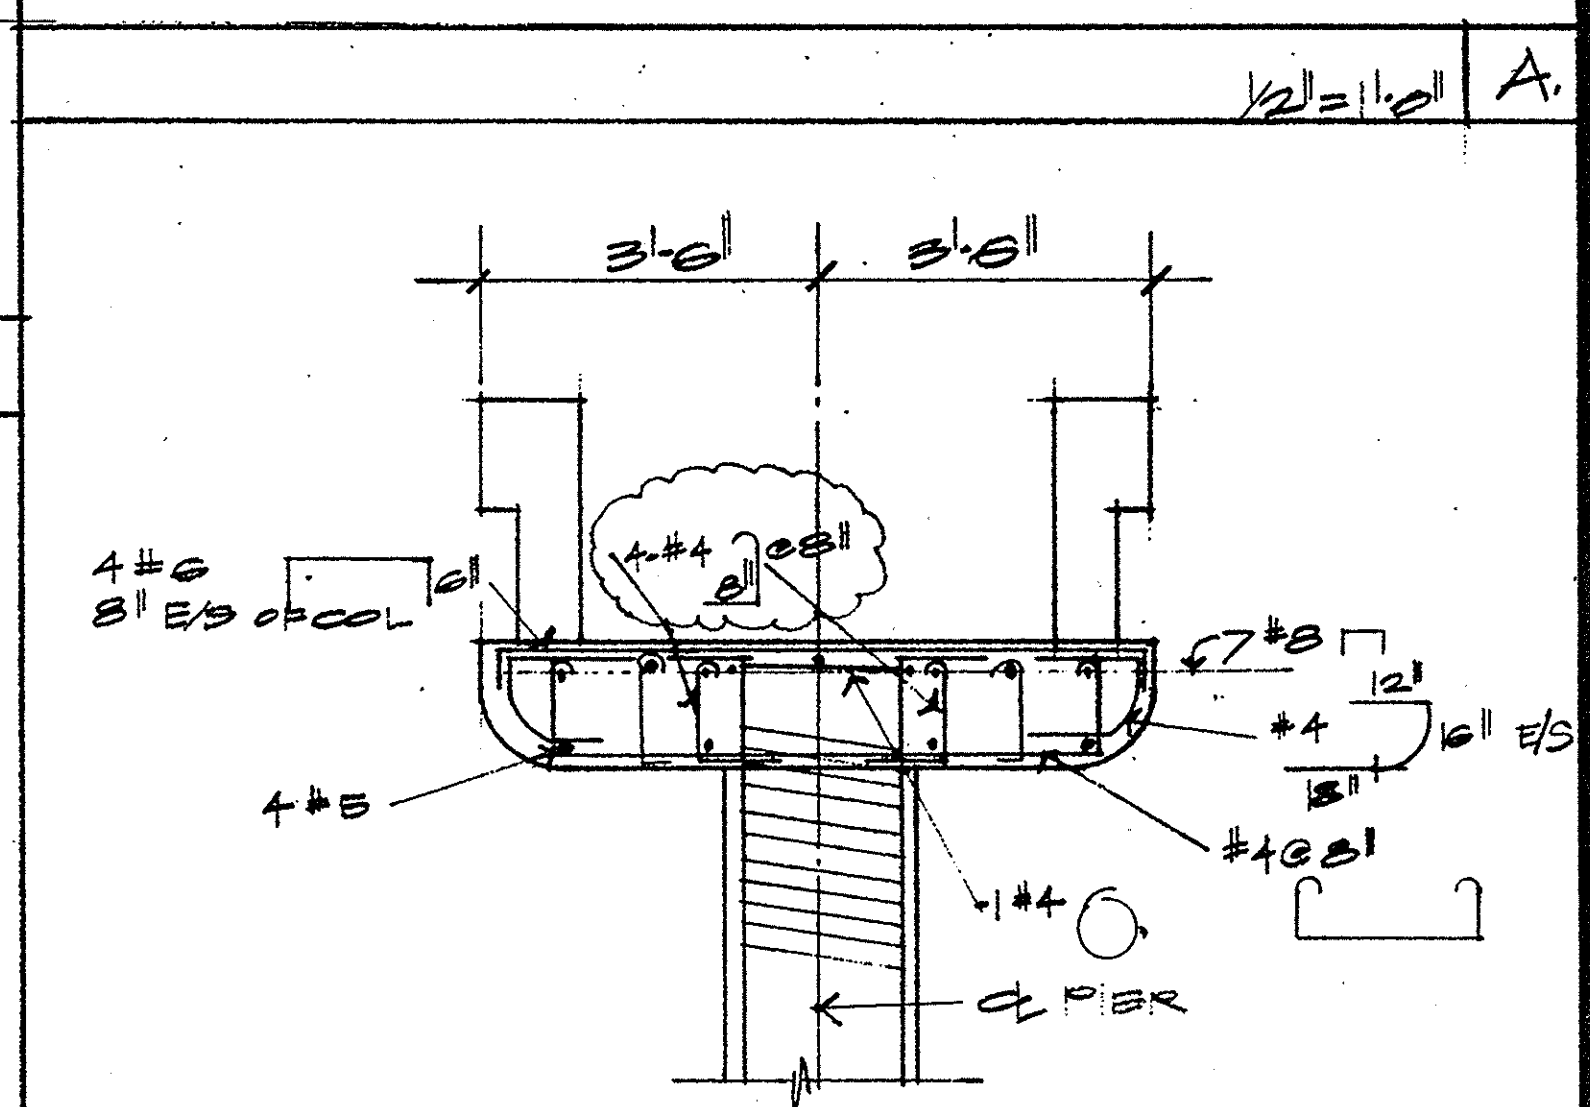
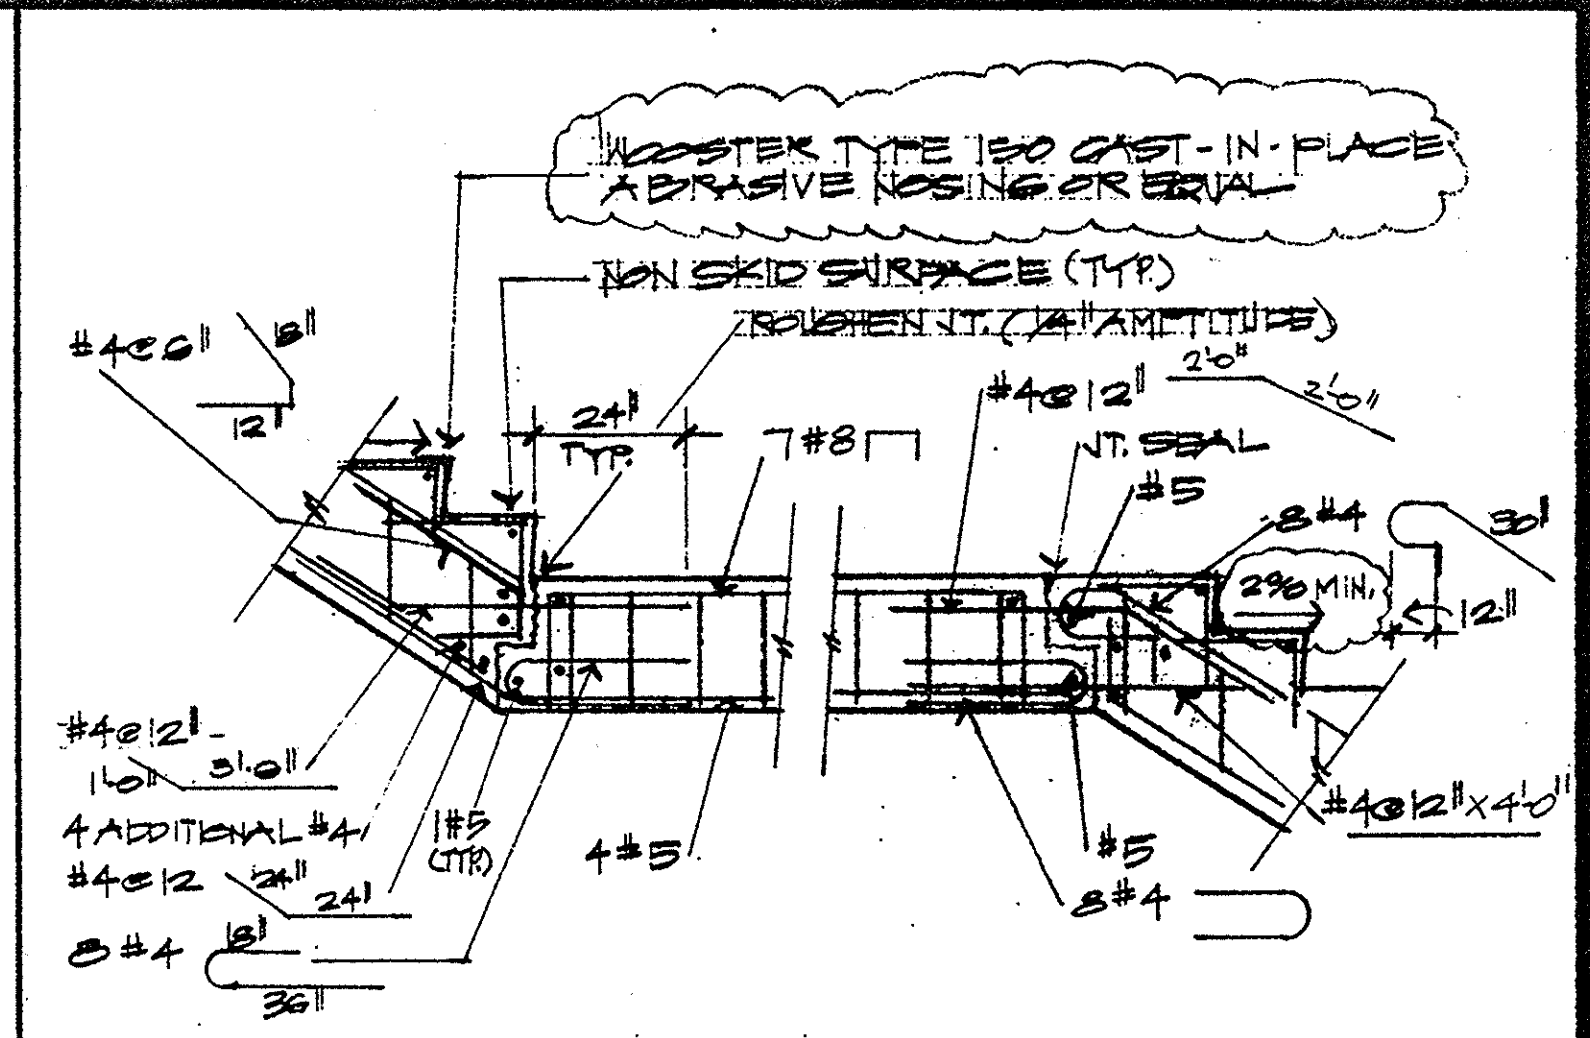
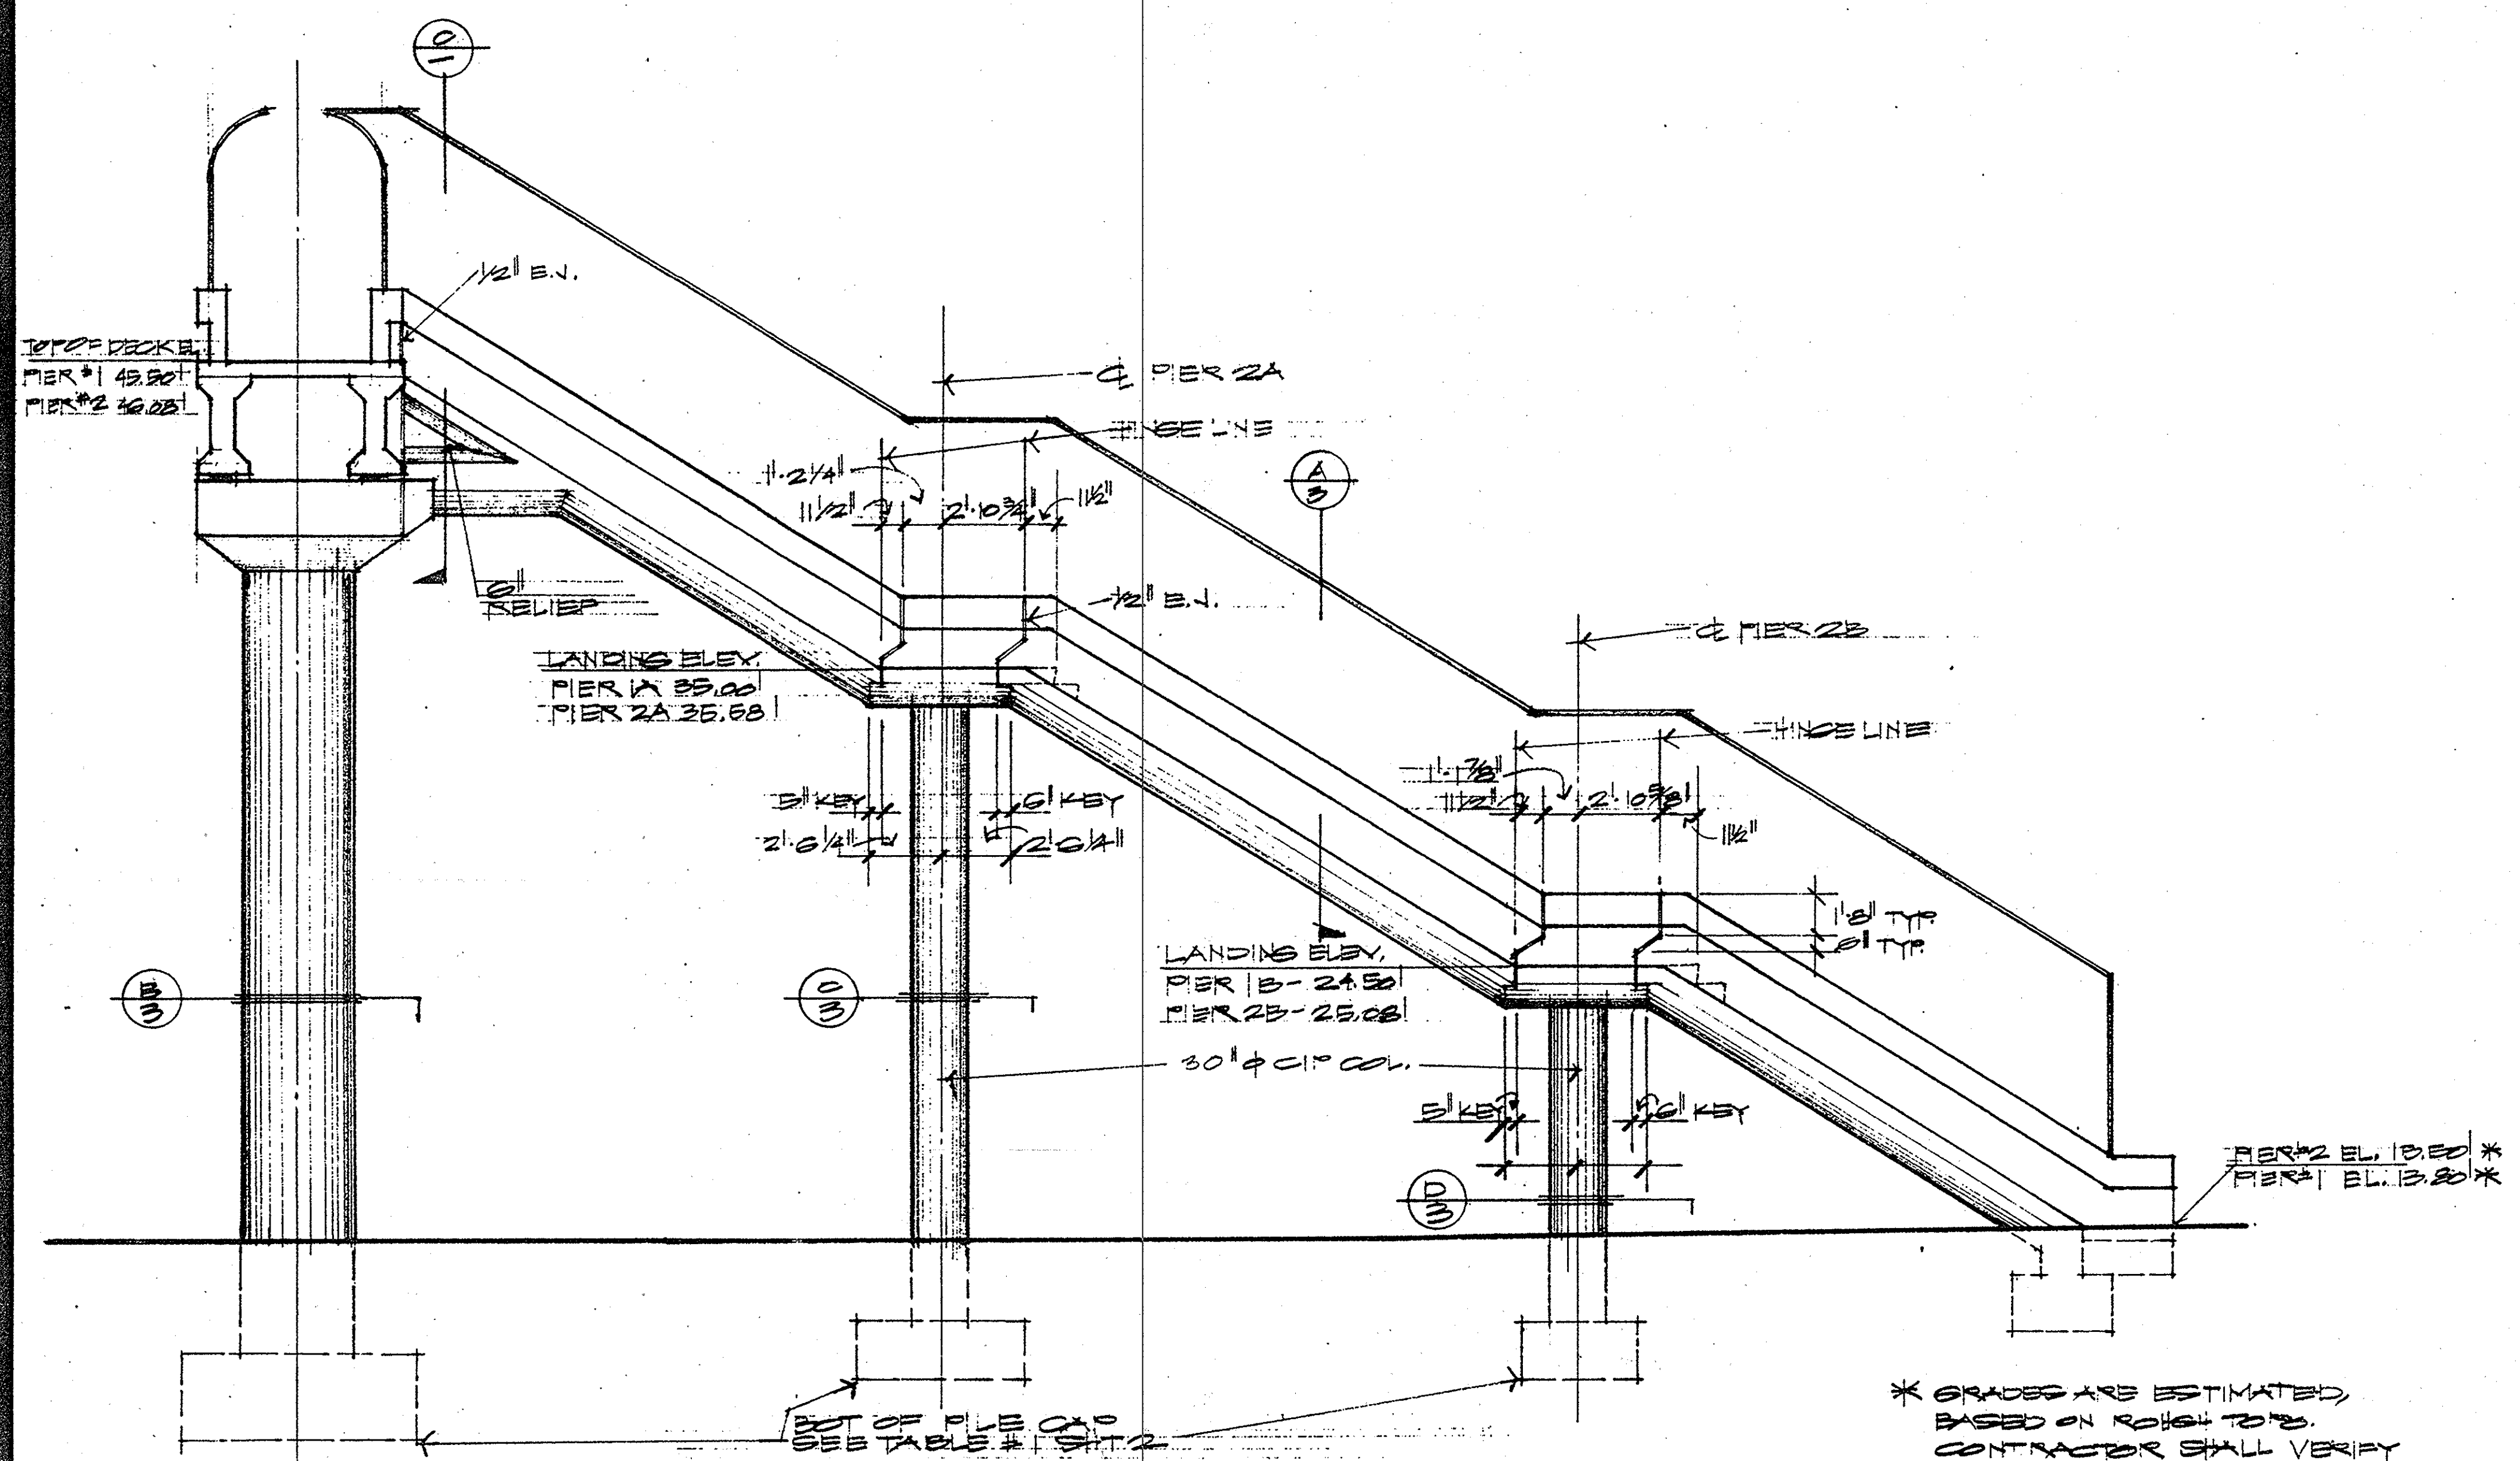


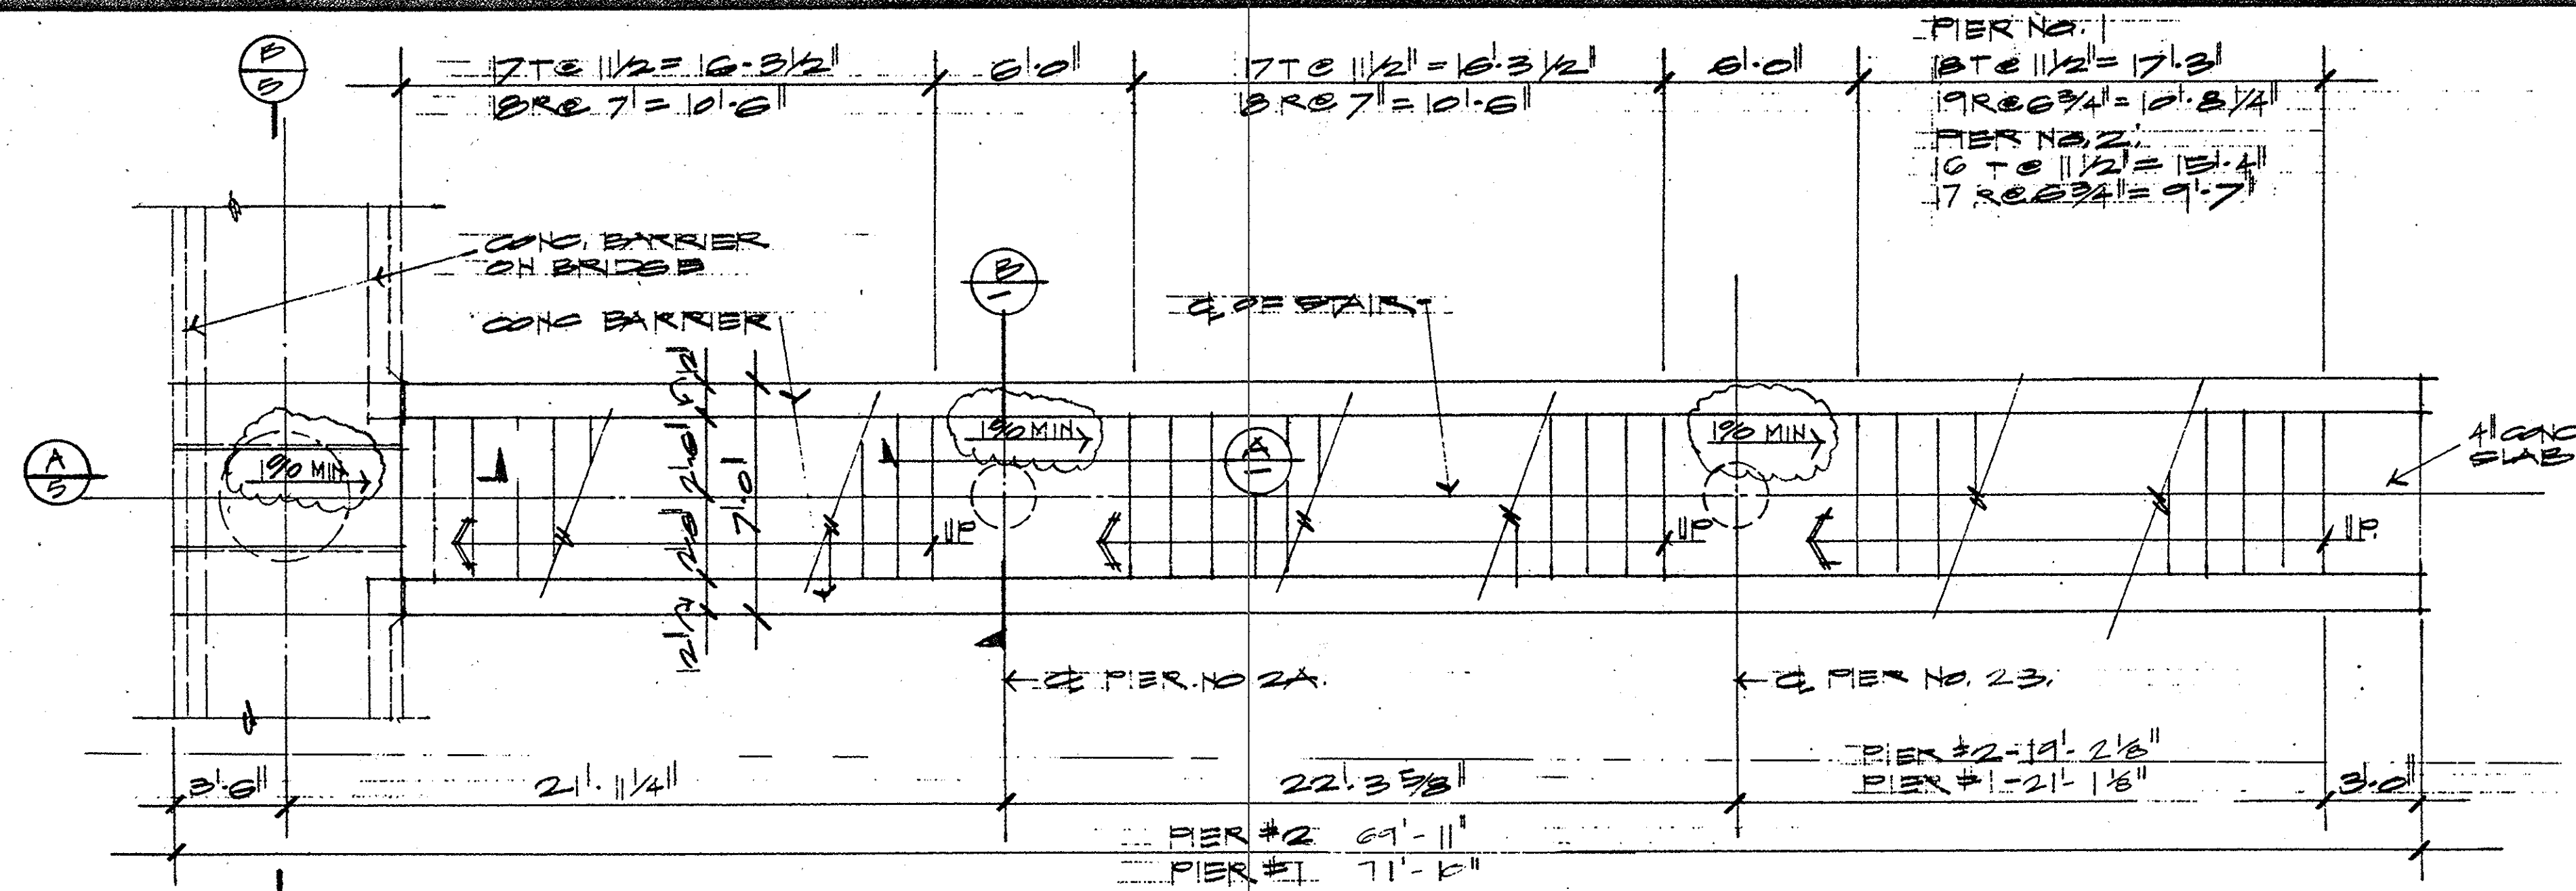

* 0 8 6 9 7 5 0 0 0 0 0 0 0 0
P A S S E D O N P R I V A T E L Y .
O U T F O R G O T T H E V E R Y
I N T H E C O M M O N S P E C I E S ,
D I S T I N G U I S H E D B E -
T W E E N T H E P R I V A T E

SHIT 4 OF 6