


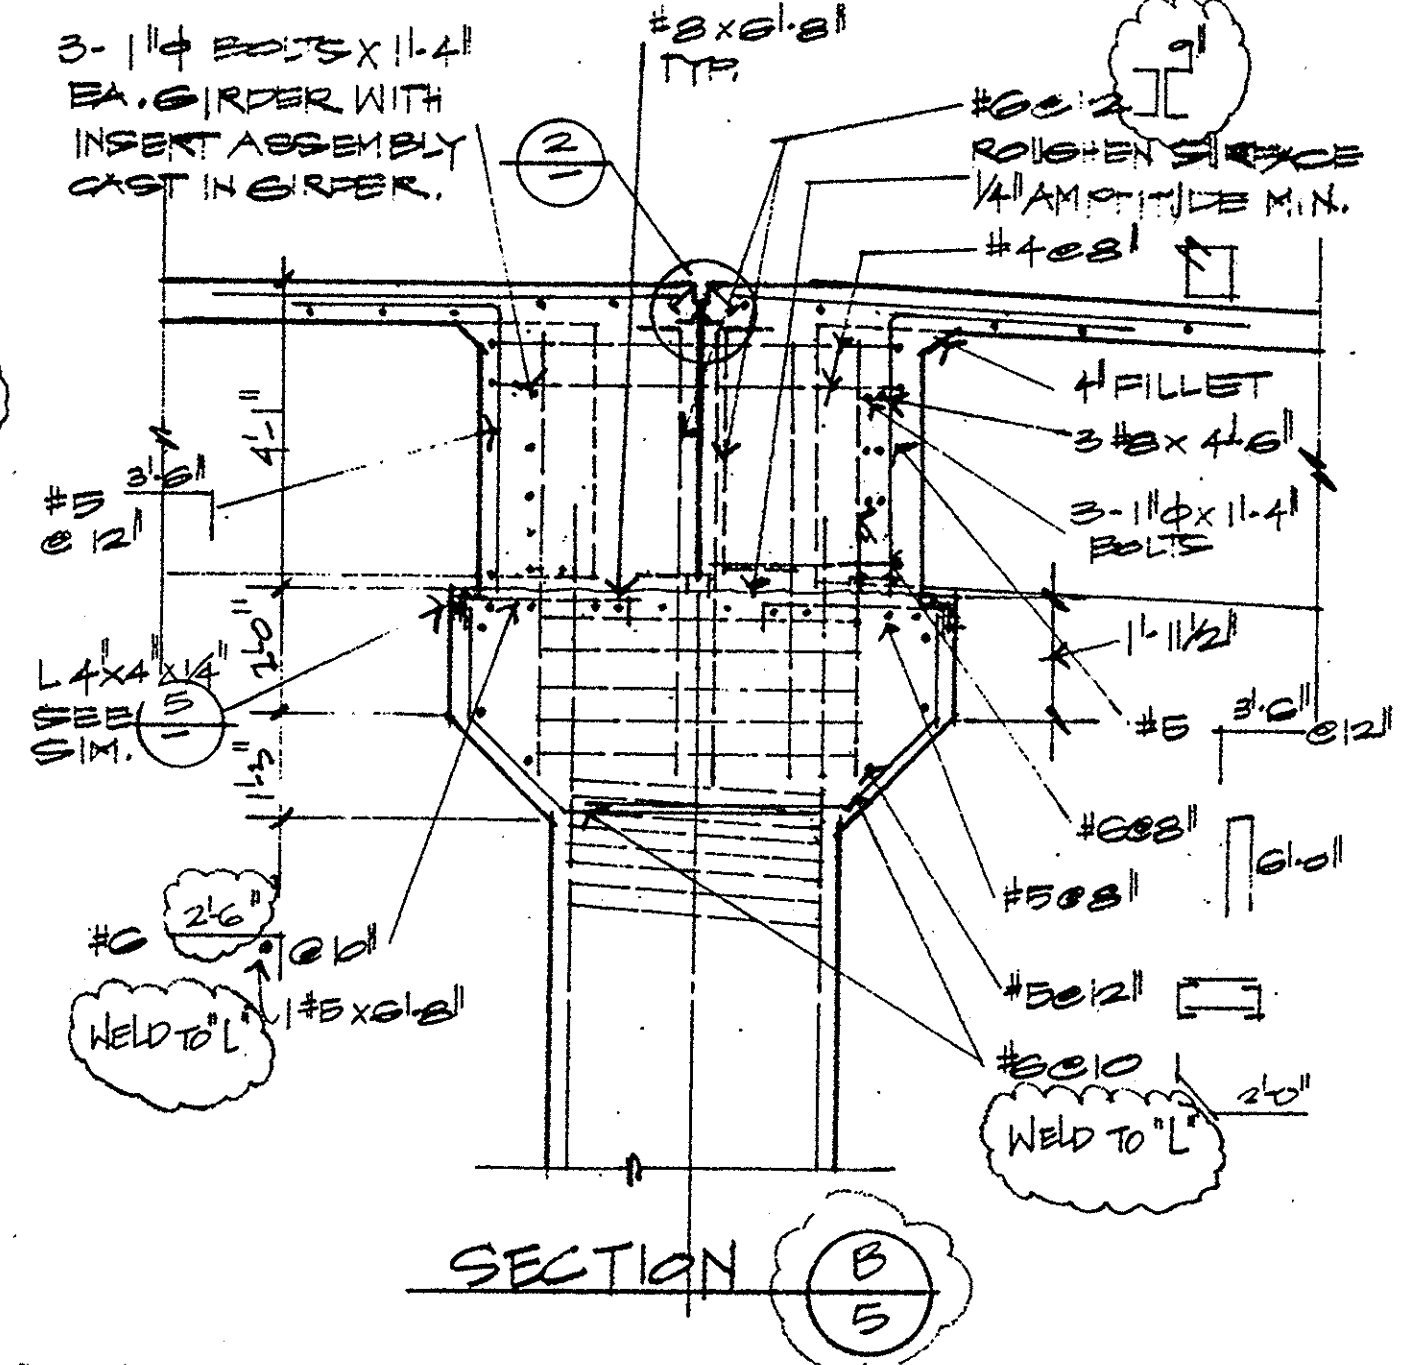

5076