



CONSTRUCTION NOTES

- FURNISH AND PLACE 4" THICK A.C. OVER COMPACTED BACKFILL PER PLAN AND TYPICAL SECTION.
- CONSTRUCT 12" WIDE CONCRETE SWALE PER PLAN AND TYPICAL SECTION.
- PLACE COMPACTED BACKFILL, (95% RELATIVE COMPACTION MIN.)
- CONSTRUCT DRAIN TO CHANNEL PER PLAN AND DETAILS. PLACE BROOKS 462-36 DRAIN BOX OR EQUIVALENT WITH 8" PVC, WITH 4" THICK CONCRETE UNDER DRAIN BOX.
- REPLACE CHAIN LINK FENCING TO MAINTAIN 6'-0" MIN. HEIGHT, PER STD. PLAN APWA 600-0-OC.
- REMOVE 12" WIDE CONC. SLOPE TO 4" BELOW F.L. OF PVC.
- PLACE SIMPSON MODEL NO. PBS66 (OR EQUIVALENT) WITH 1/2" Ø GALVANIZED BOLTS WITH 3" CLR COVER MIN.
- CONSTRUCT 4" THICK x 10' WIDE PCC WALK PER PLAN & DETAIL, EMA STD. PLAN 103-0-OC AND AS DIRECTED BY ENGINEER.
- PATCH CONCRETE CHANNEL LINING TO MATCH EXISTING.
- SET NEW END POSTS FOR EXISTING CHAIN LINK FENCE PER APWA STD. PLAN 600-0-OC. RE-TIE FENCE FABRIC.
- INSTALL 6" SOLID WHITE STRIPE, 18" FROM HINGE POINT.
- PLACE REMOVABLE TRAFFIC BOLLARD (BOTH ABUTMENTS).

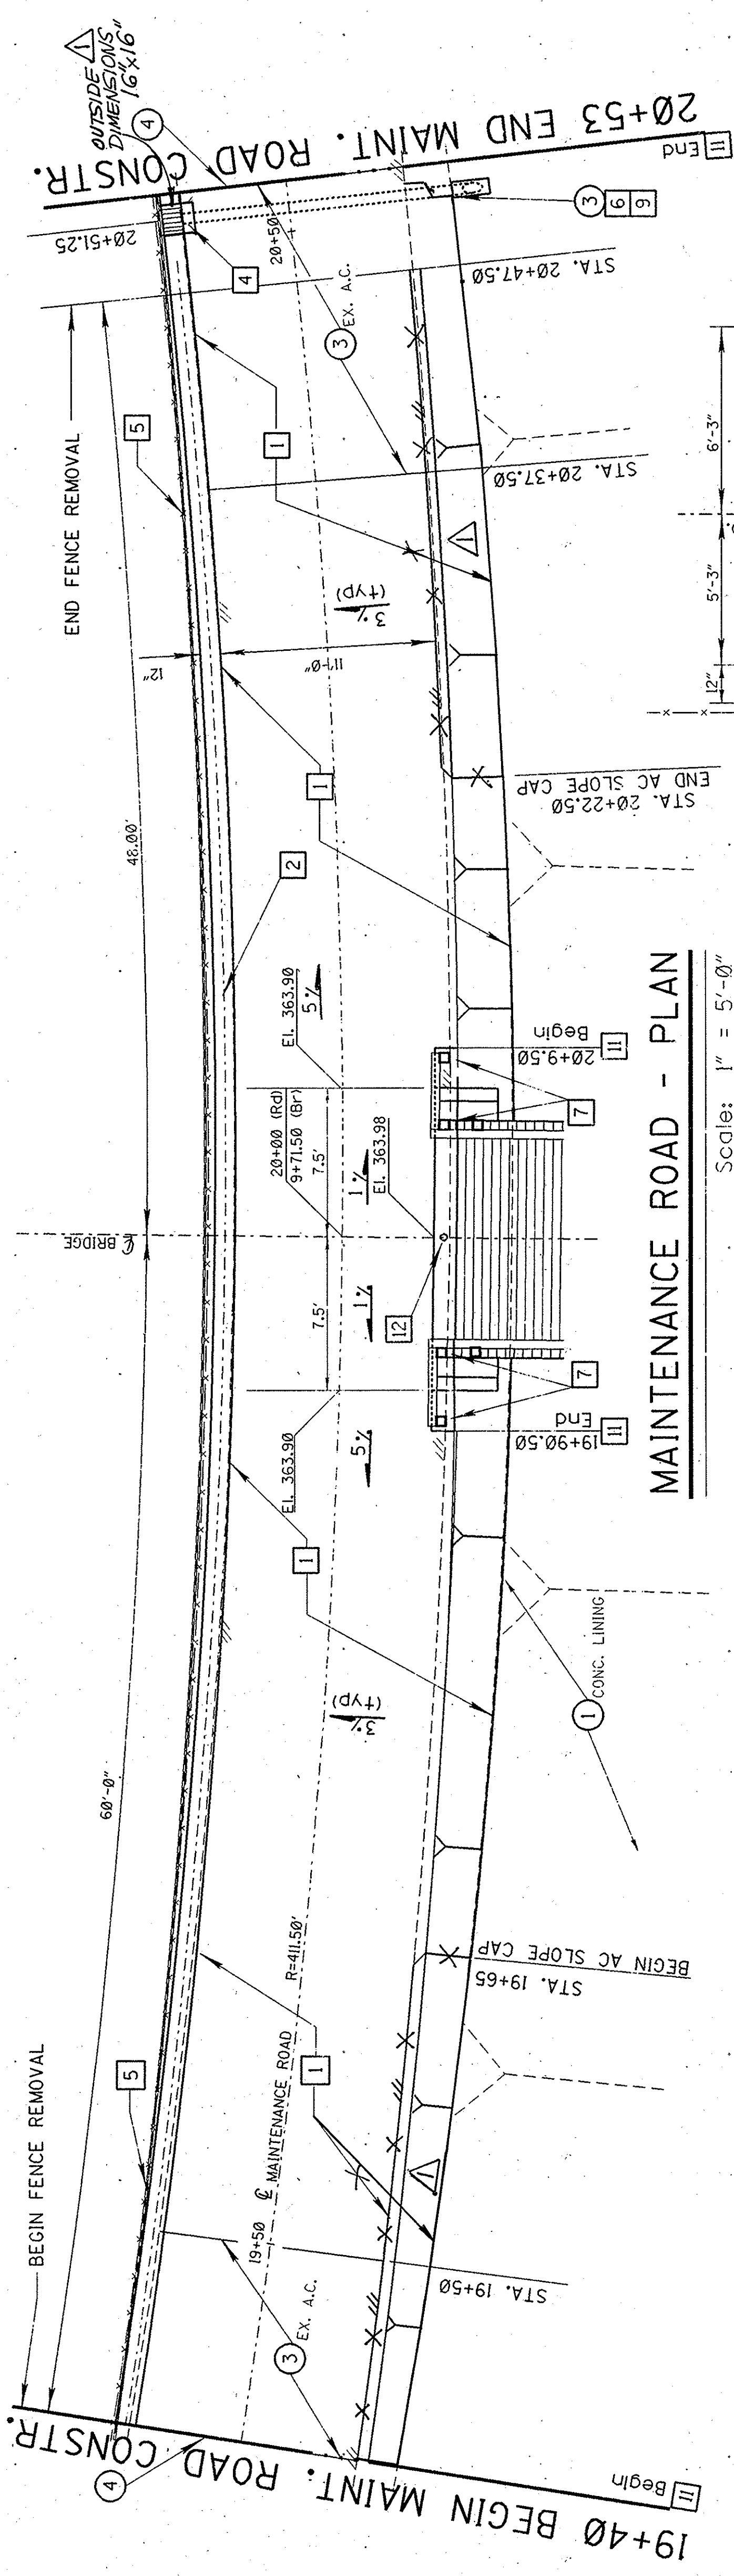

MAINTENANCE ROAD - PLAN

Scale: 1" = 5'-0"

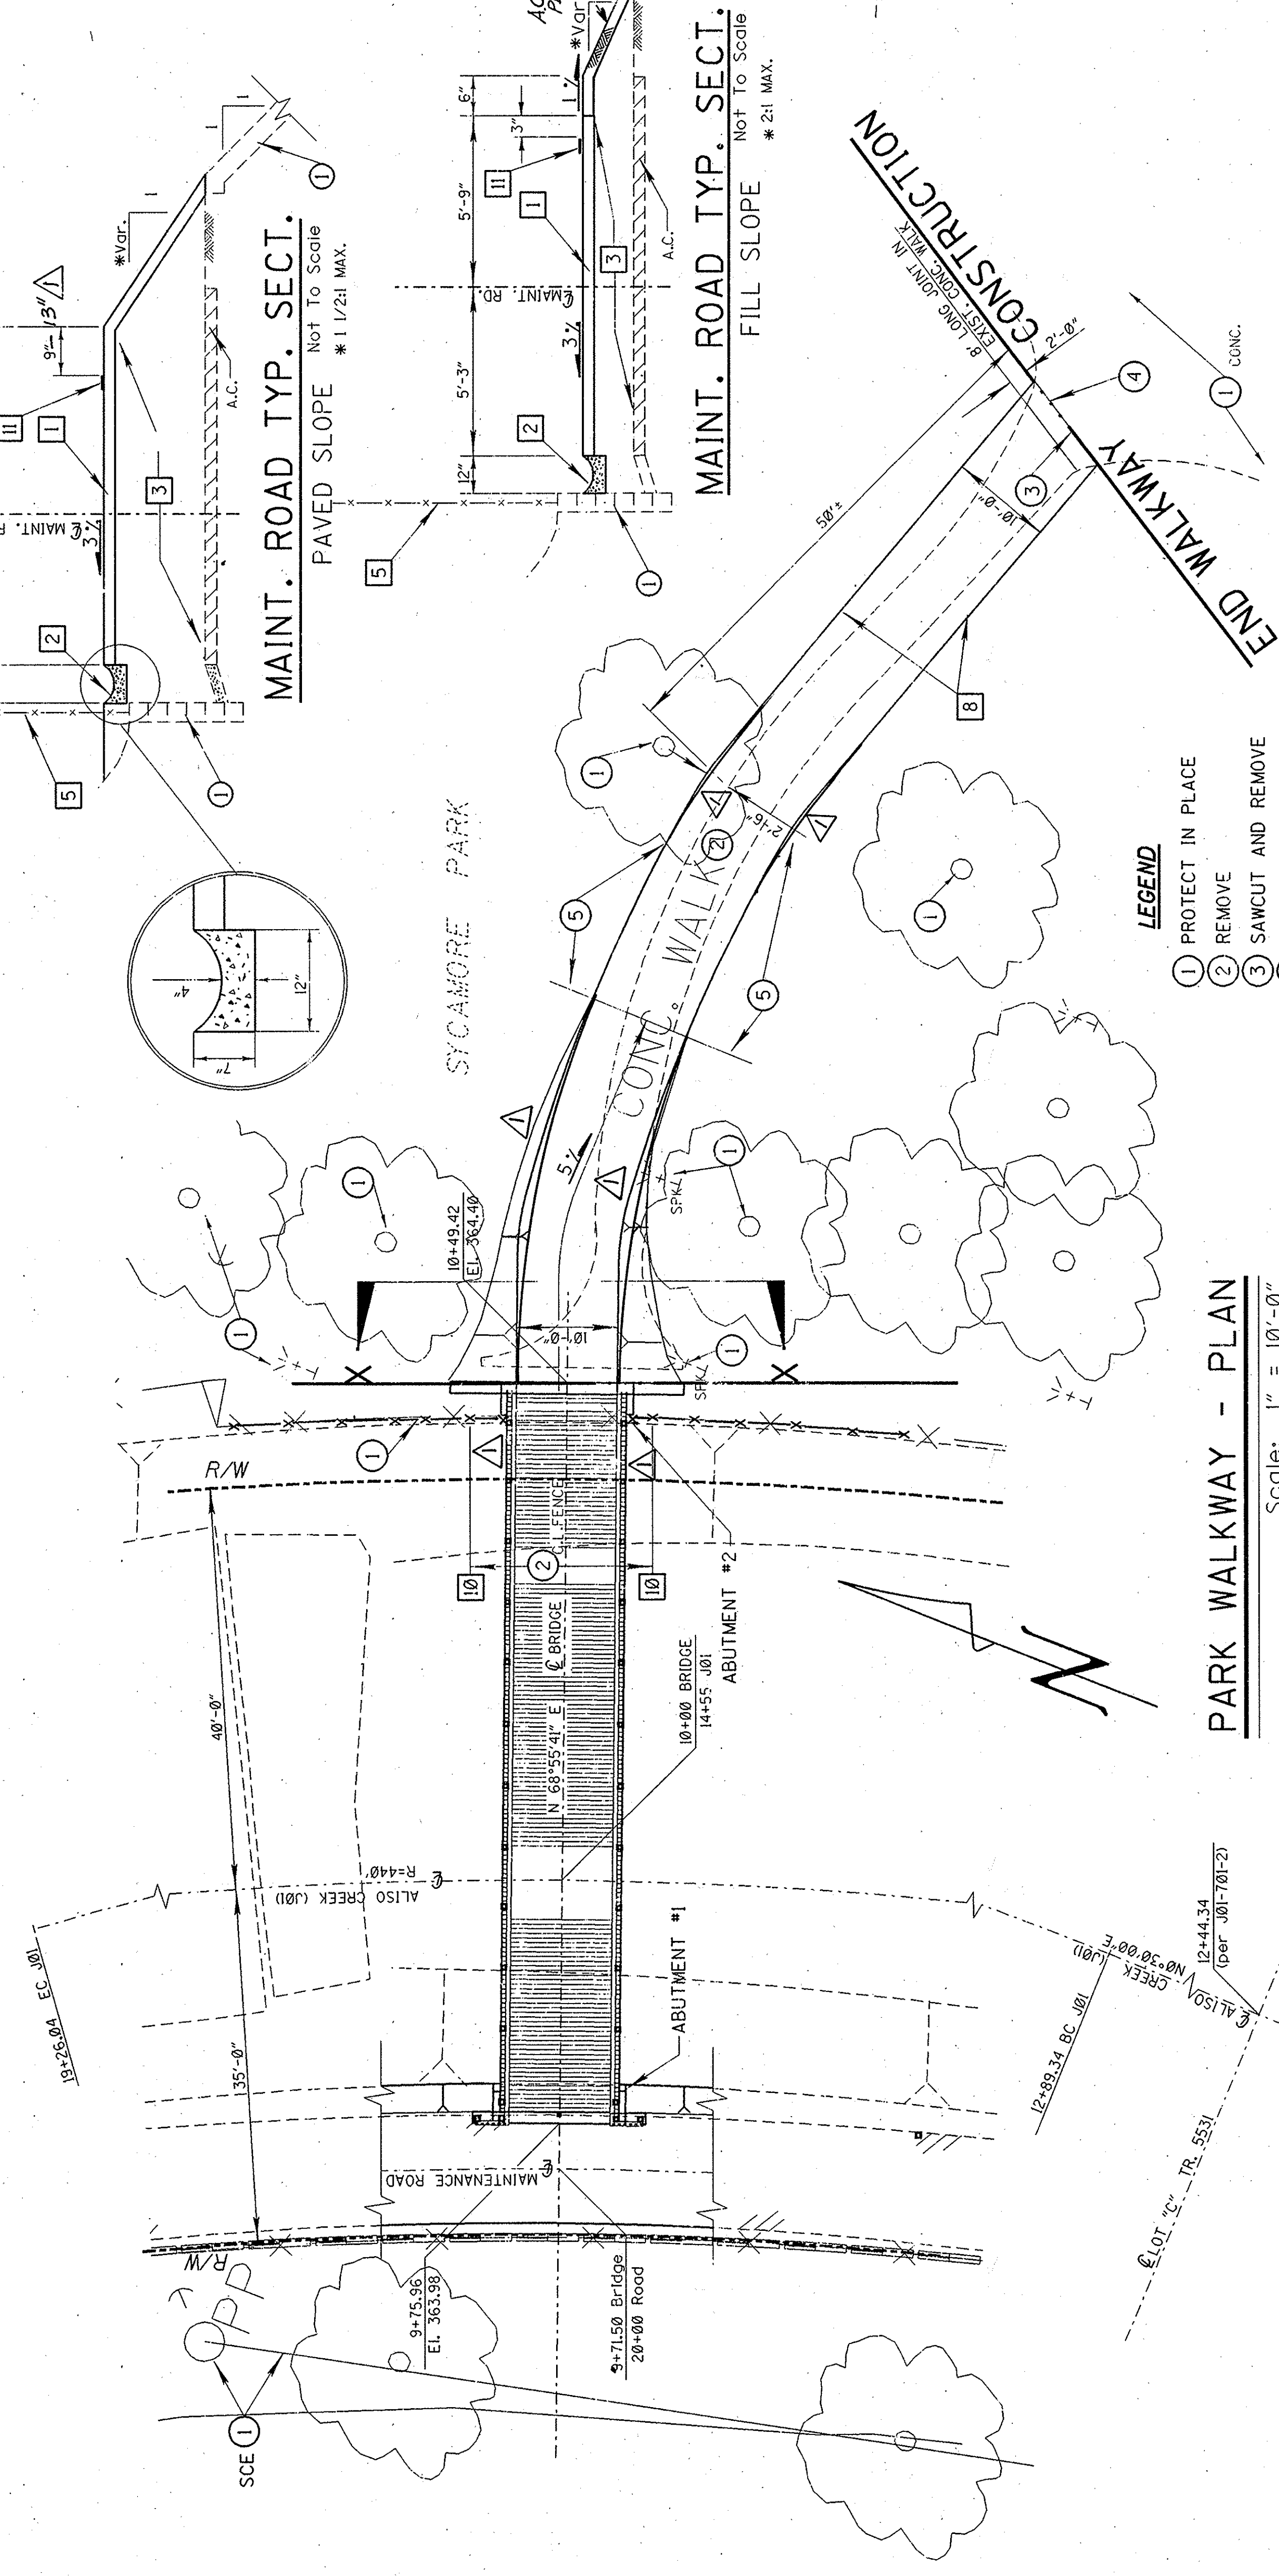

PARK WALKWAY - PLAN

Scale: 1" = 10'-0"

MAINT. ROAD TYP. SECT.

Not To Scale
PAVED SLOPE * 1 1/2% MAX.

PROFILE - DRAIN

Not To Scale

MAINT. ROAD TYP. SECT.

Not To Scale
FILL SLOPE * 2:1 MAX.

SECTION X - X

Not To Scale

LEGEND

- PROTECT IN PLACE
- REMOVE
- SAWCUT AND REMOVE
- MATCH EXISTING
- MATCH EXISTING GRADE

ORANGE COUNTY ENVIRONMENTAL MANAGEMENT AGENCY		ALISO CREEK PEDESTRIAN BRIDGE PARK WALKWAY AND CHANNEL MAINTENANCE ROAD PLAN AND PROFILE	
5-452 AS SHOWN	DATE	DESCRIPTION	REVISIONS
PREPARED BY: RICHARD HART		CHECKED BY: GARCIA	
DATE: 9-91		DRAWING NO. 2	
SCALE: AS SHOWN		SHEET: 2 OF 6	