



CL BRIDGE

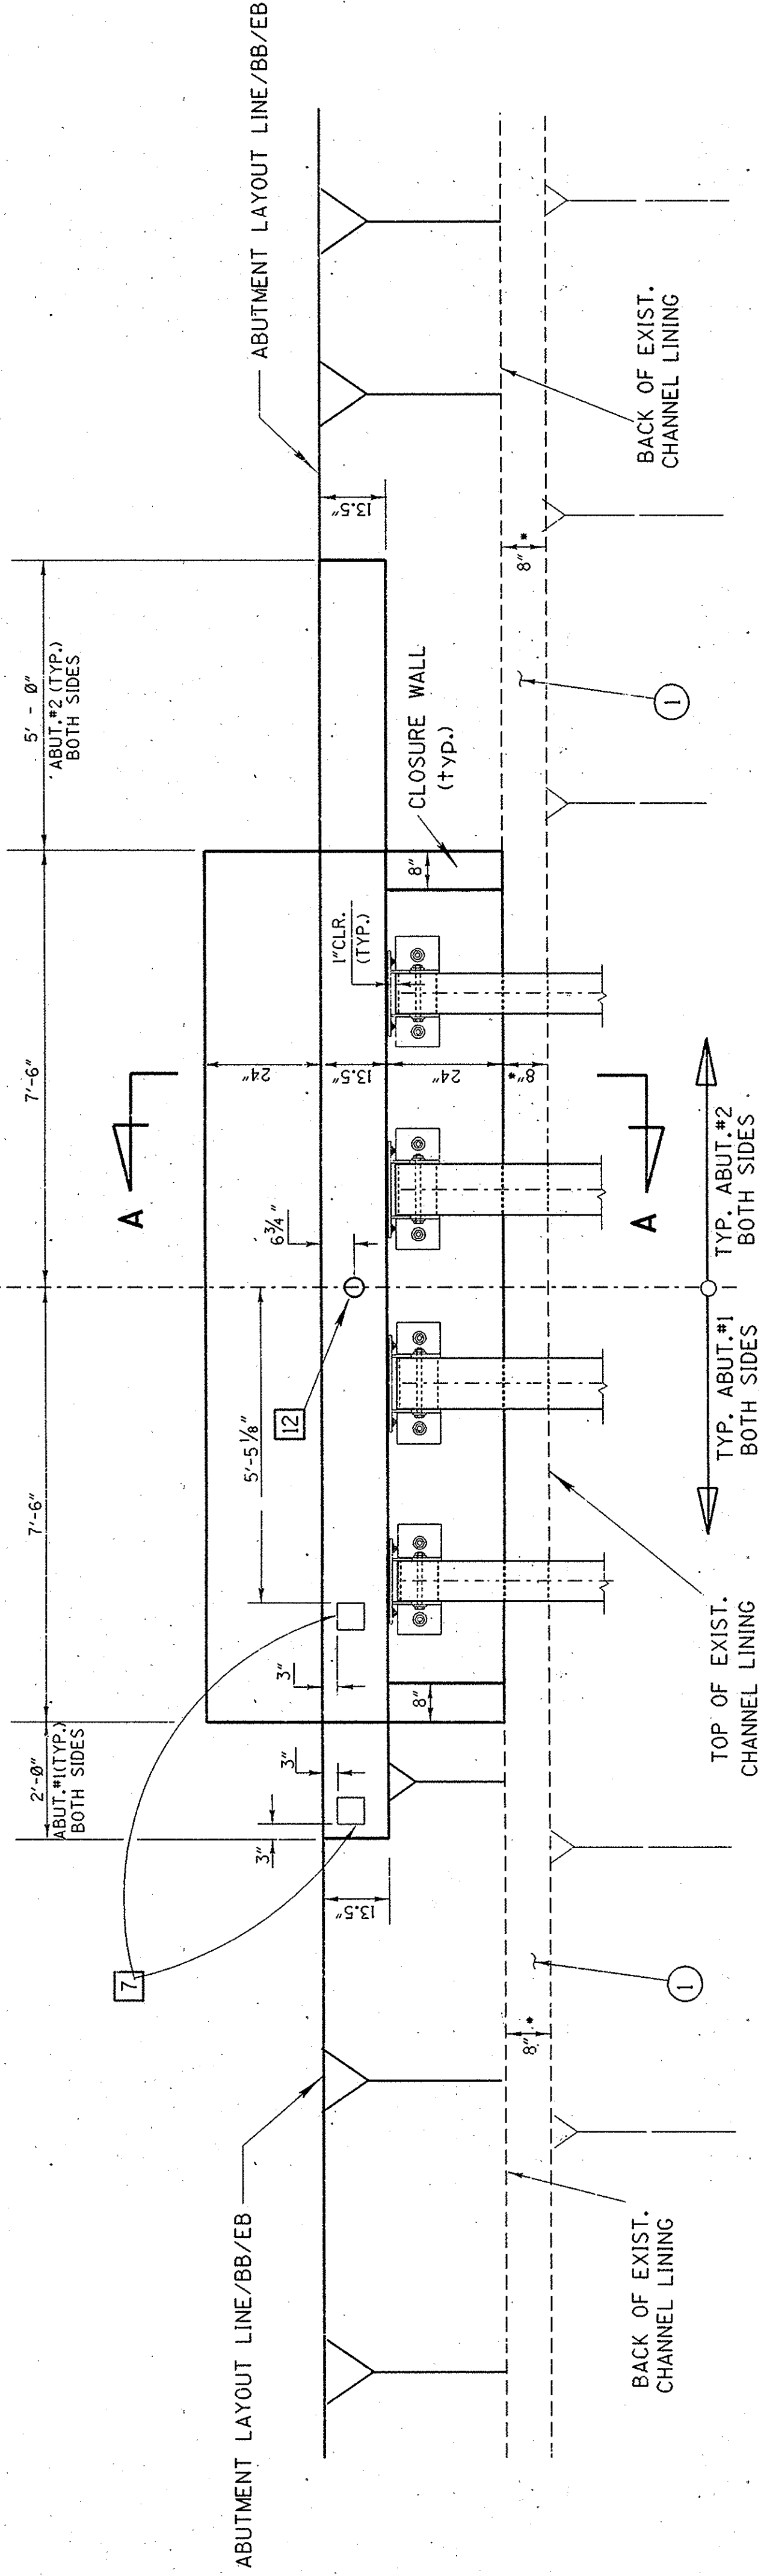


PLAN

SCALE: 1/2"=1'-0"

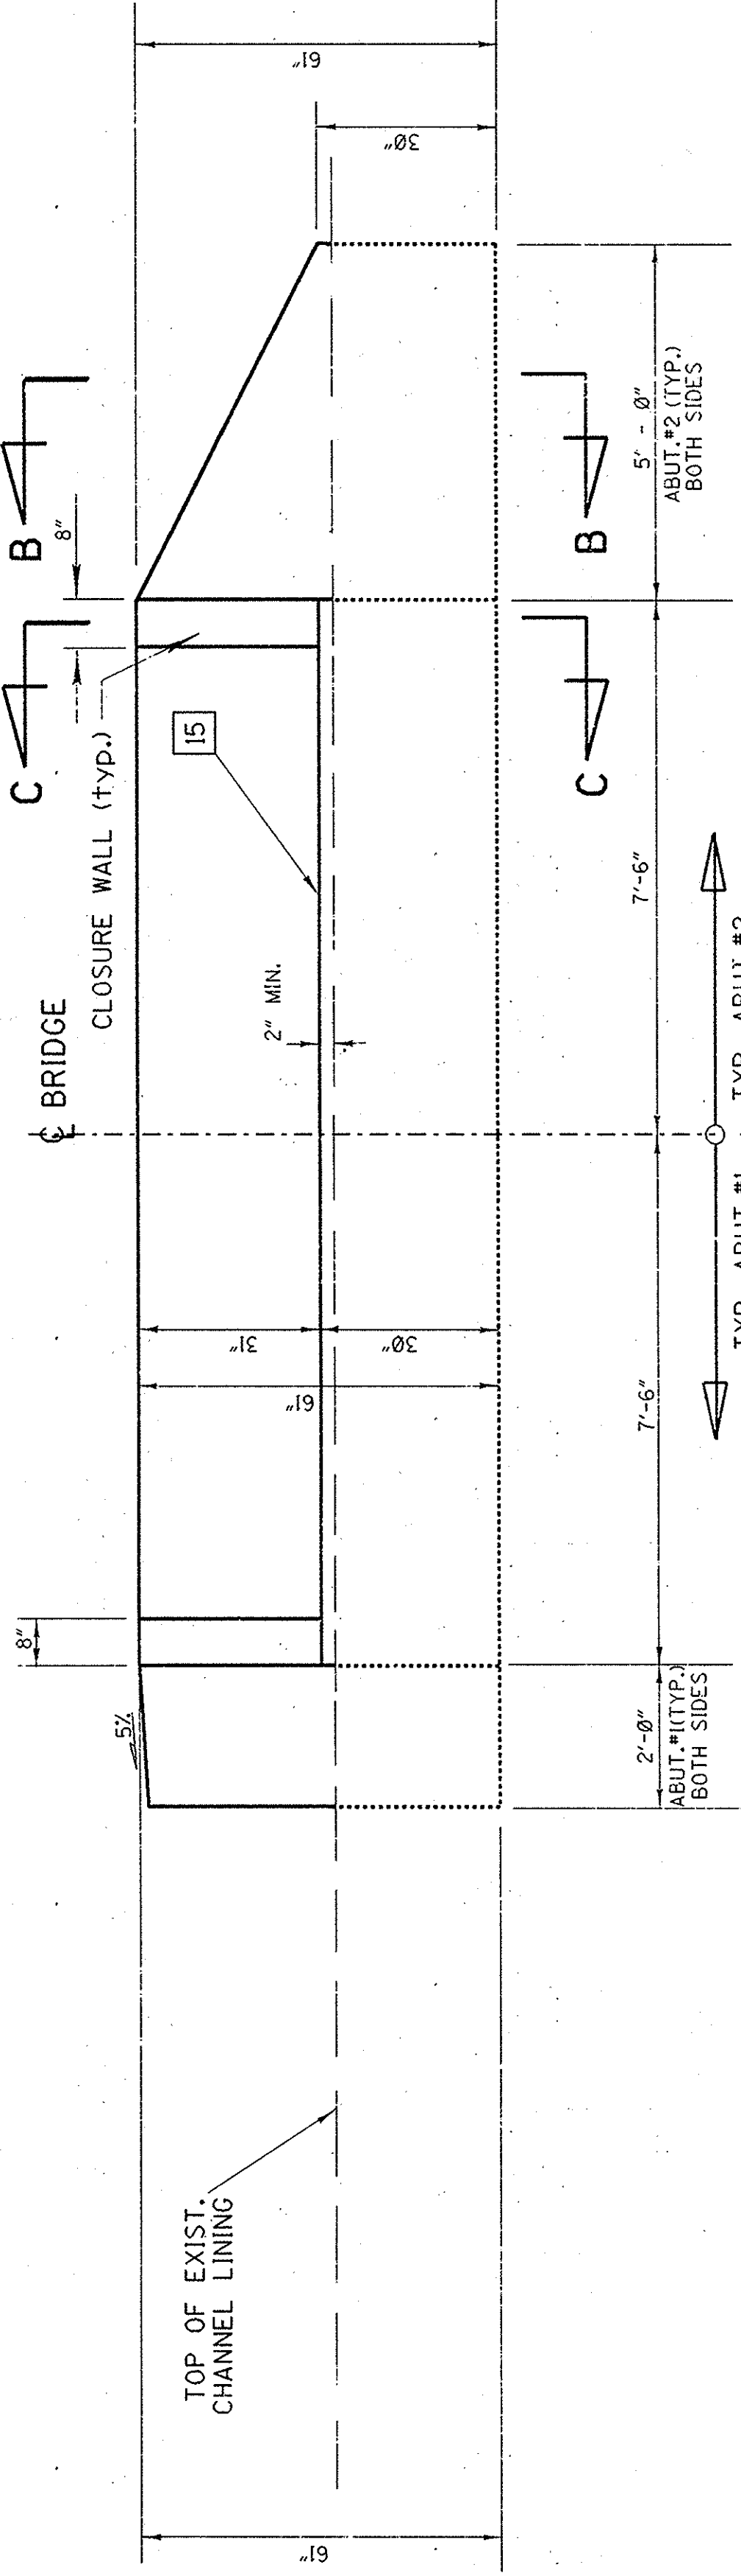

ELEVATION

SCALE: 1/2"=1'-0"

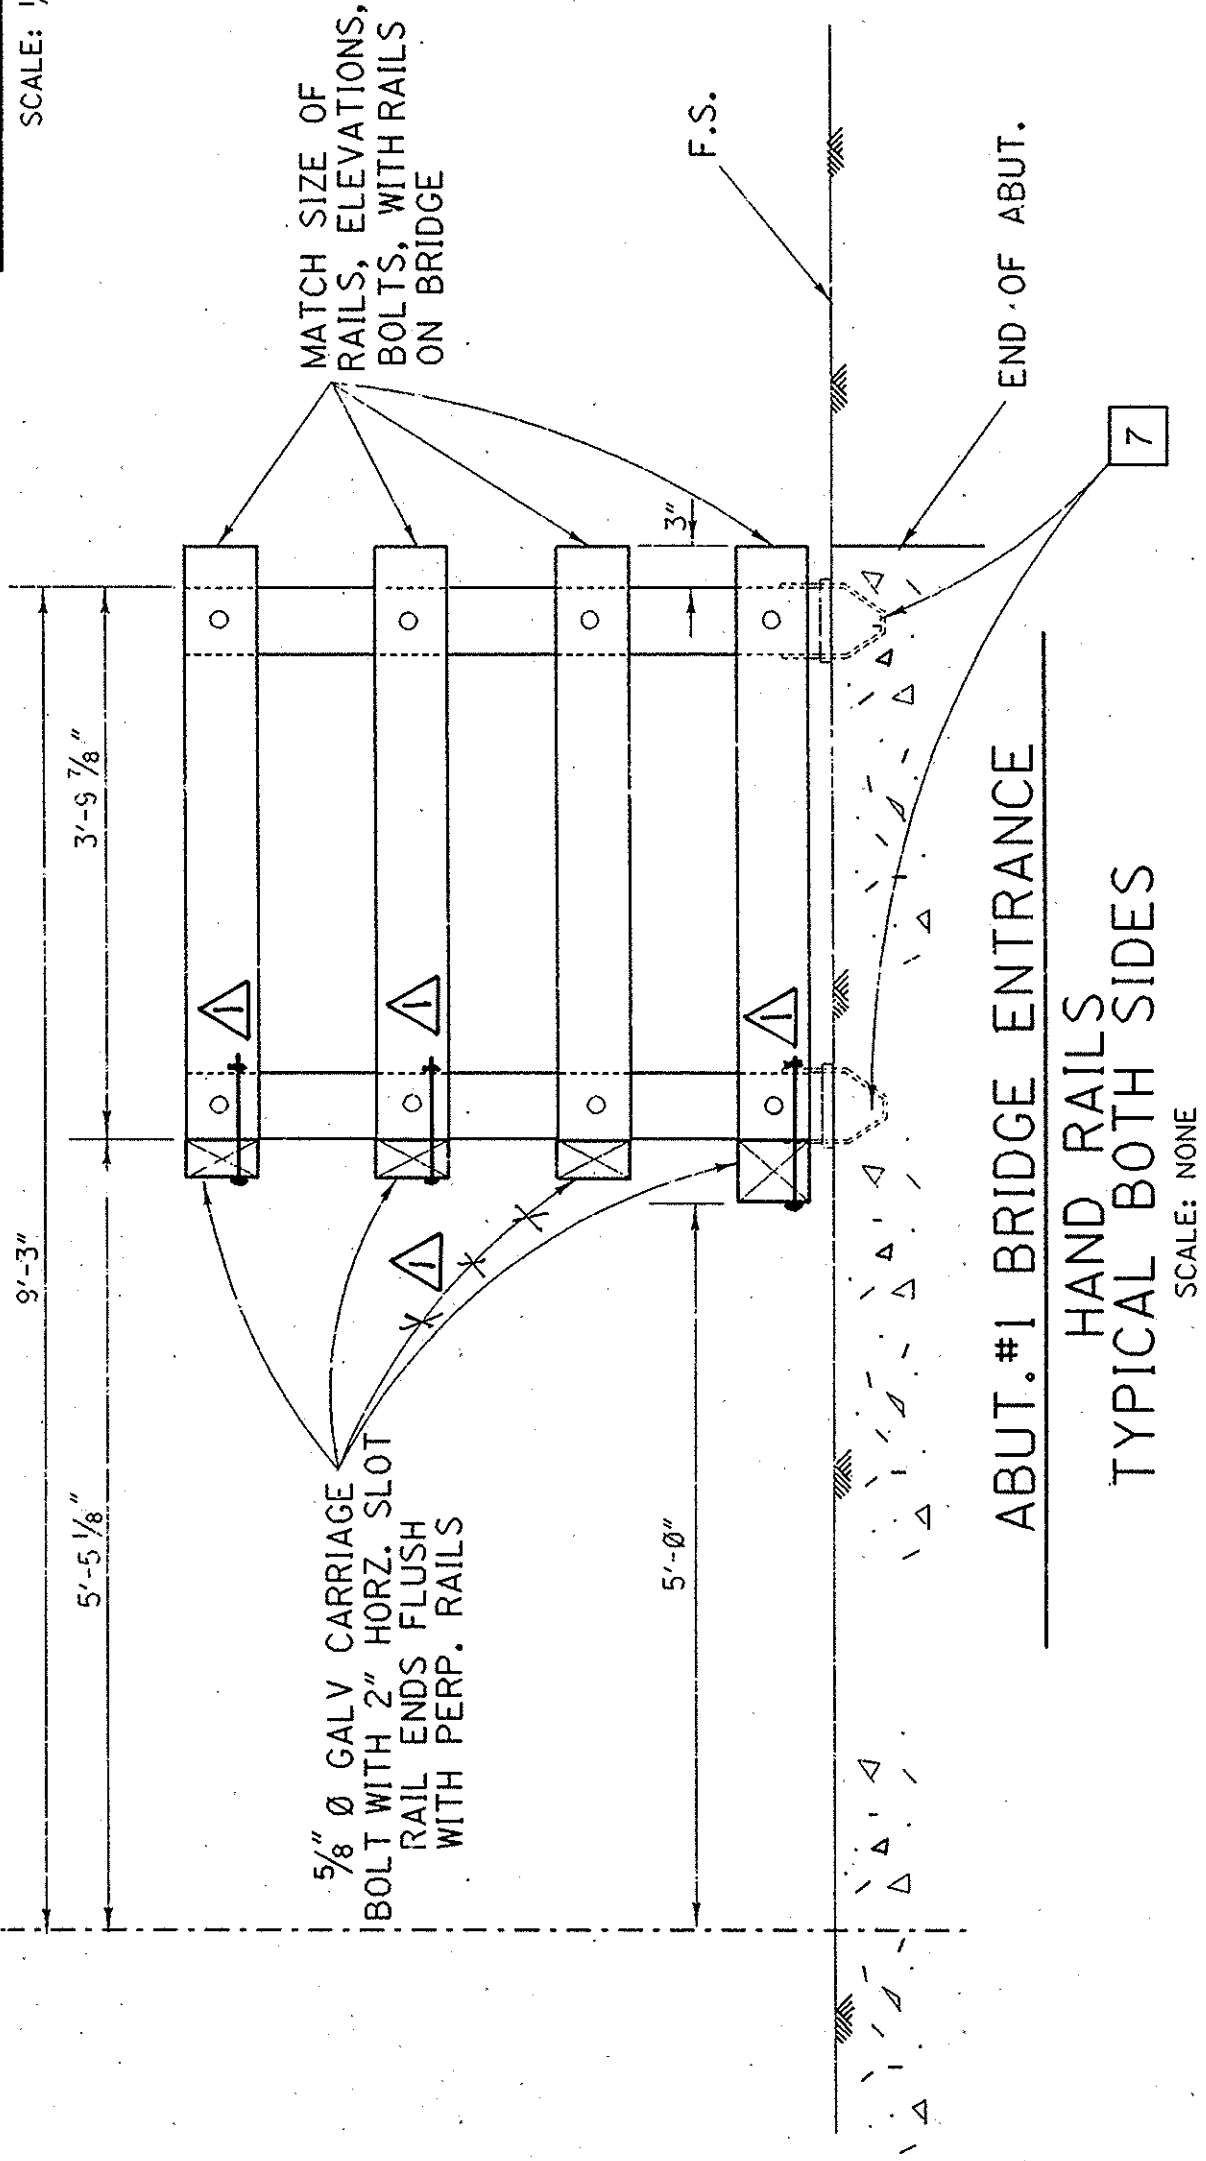

ABUT. #1 BRIDGE ENTRANCE

HAND RAILS

TYPICAL BOTH SIDES

SCALE: NONE

NOTE:

TRAFFIC BOLLARD SHALL BE HOT DIP GALVANIZED AFTER FABRICATION.


REMOVABLE TRAFFIC BOLLARD

SCALE: NONE

CLOSURE WALL DETAIL

SECTION C - C

SCALE: 1"=1'-0"

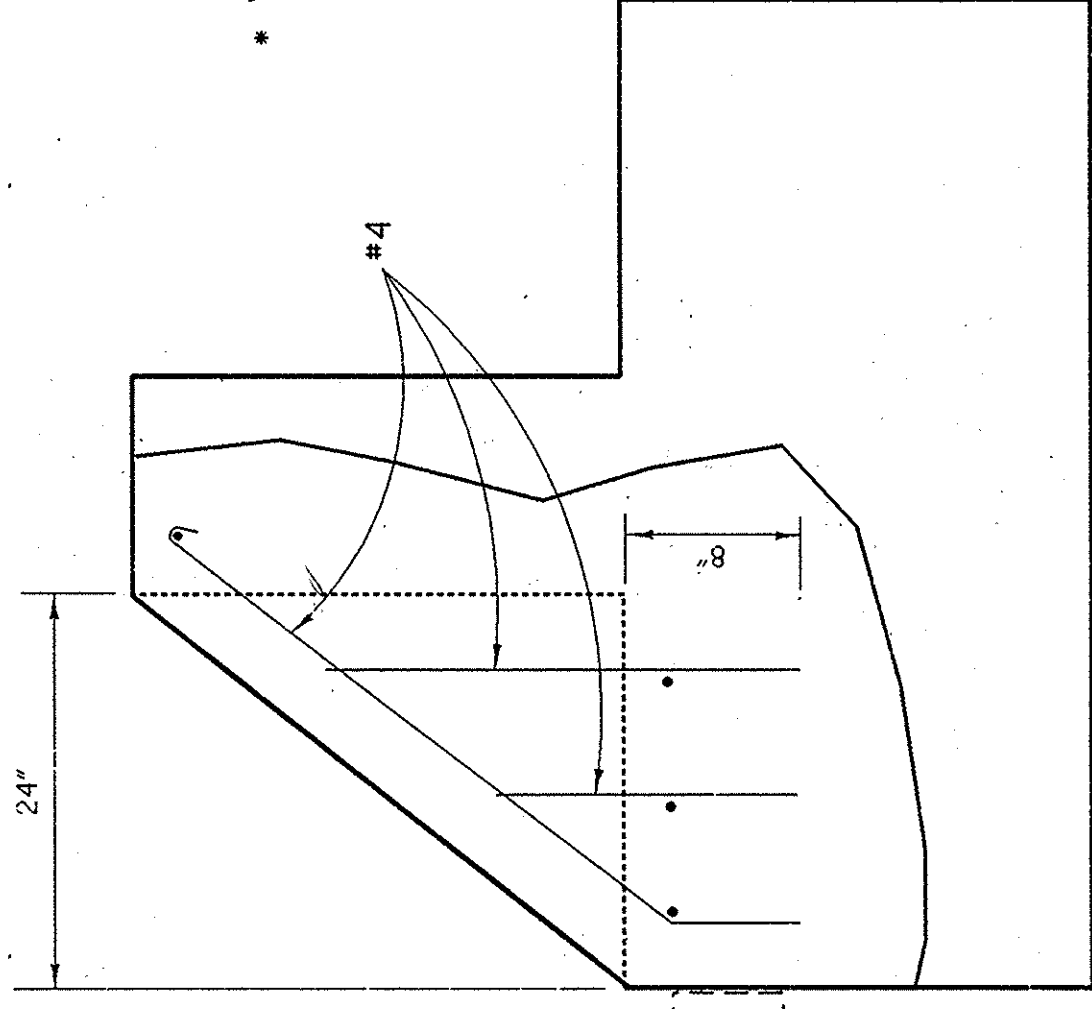


LEGEND

① PROTECT IN PLACE

CONSTRUCTION NOTES

- 7 PLACE SIMPSON MODEL NO. PBS66 (OR EQUIVALENT) WITH 1/2" Ø GALVANIZED BOLTS WITH 3" CLR COVER MINIMUM.
- 12 PLACE REMOVABLE TRAFFIC BOLLARD (BOTH ABUTMENTS).

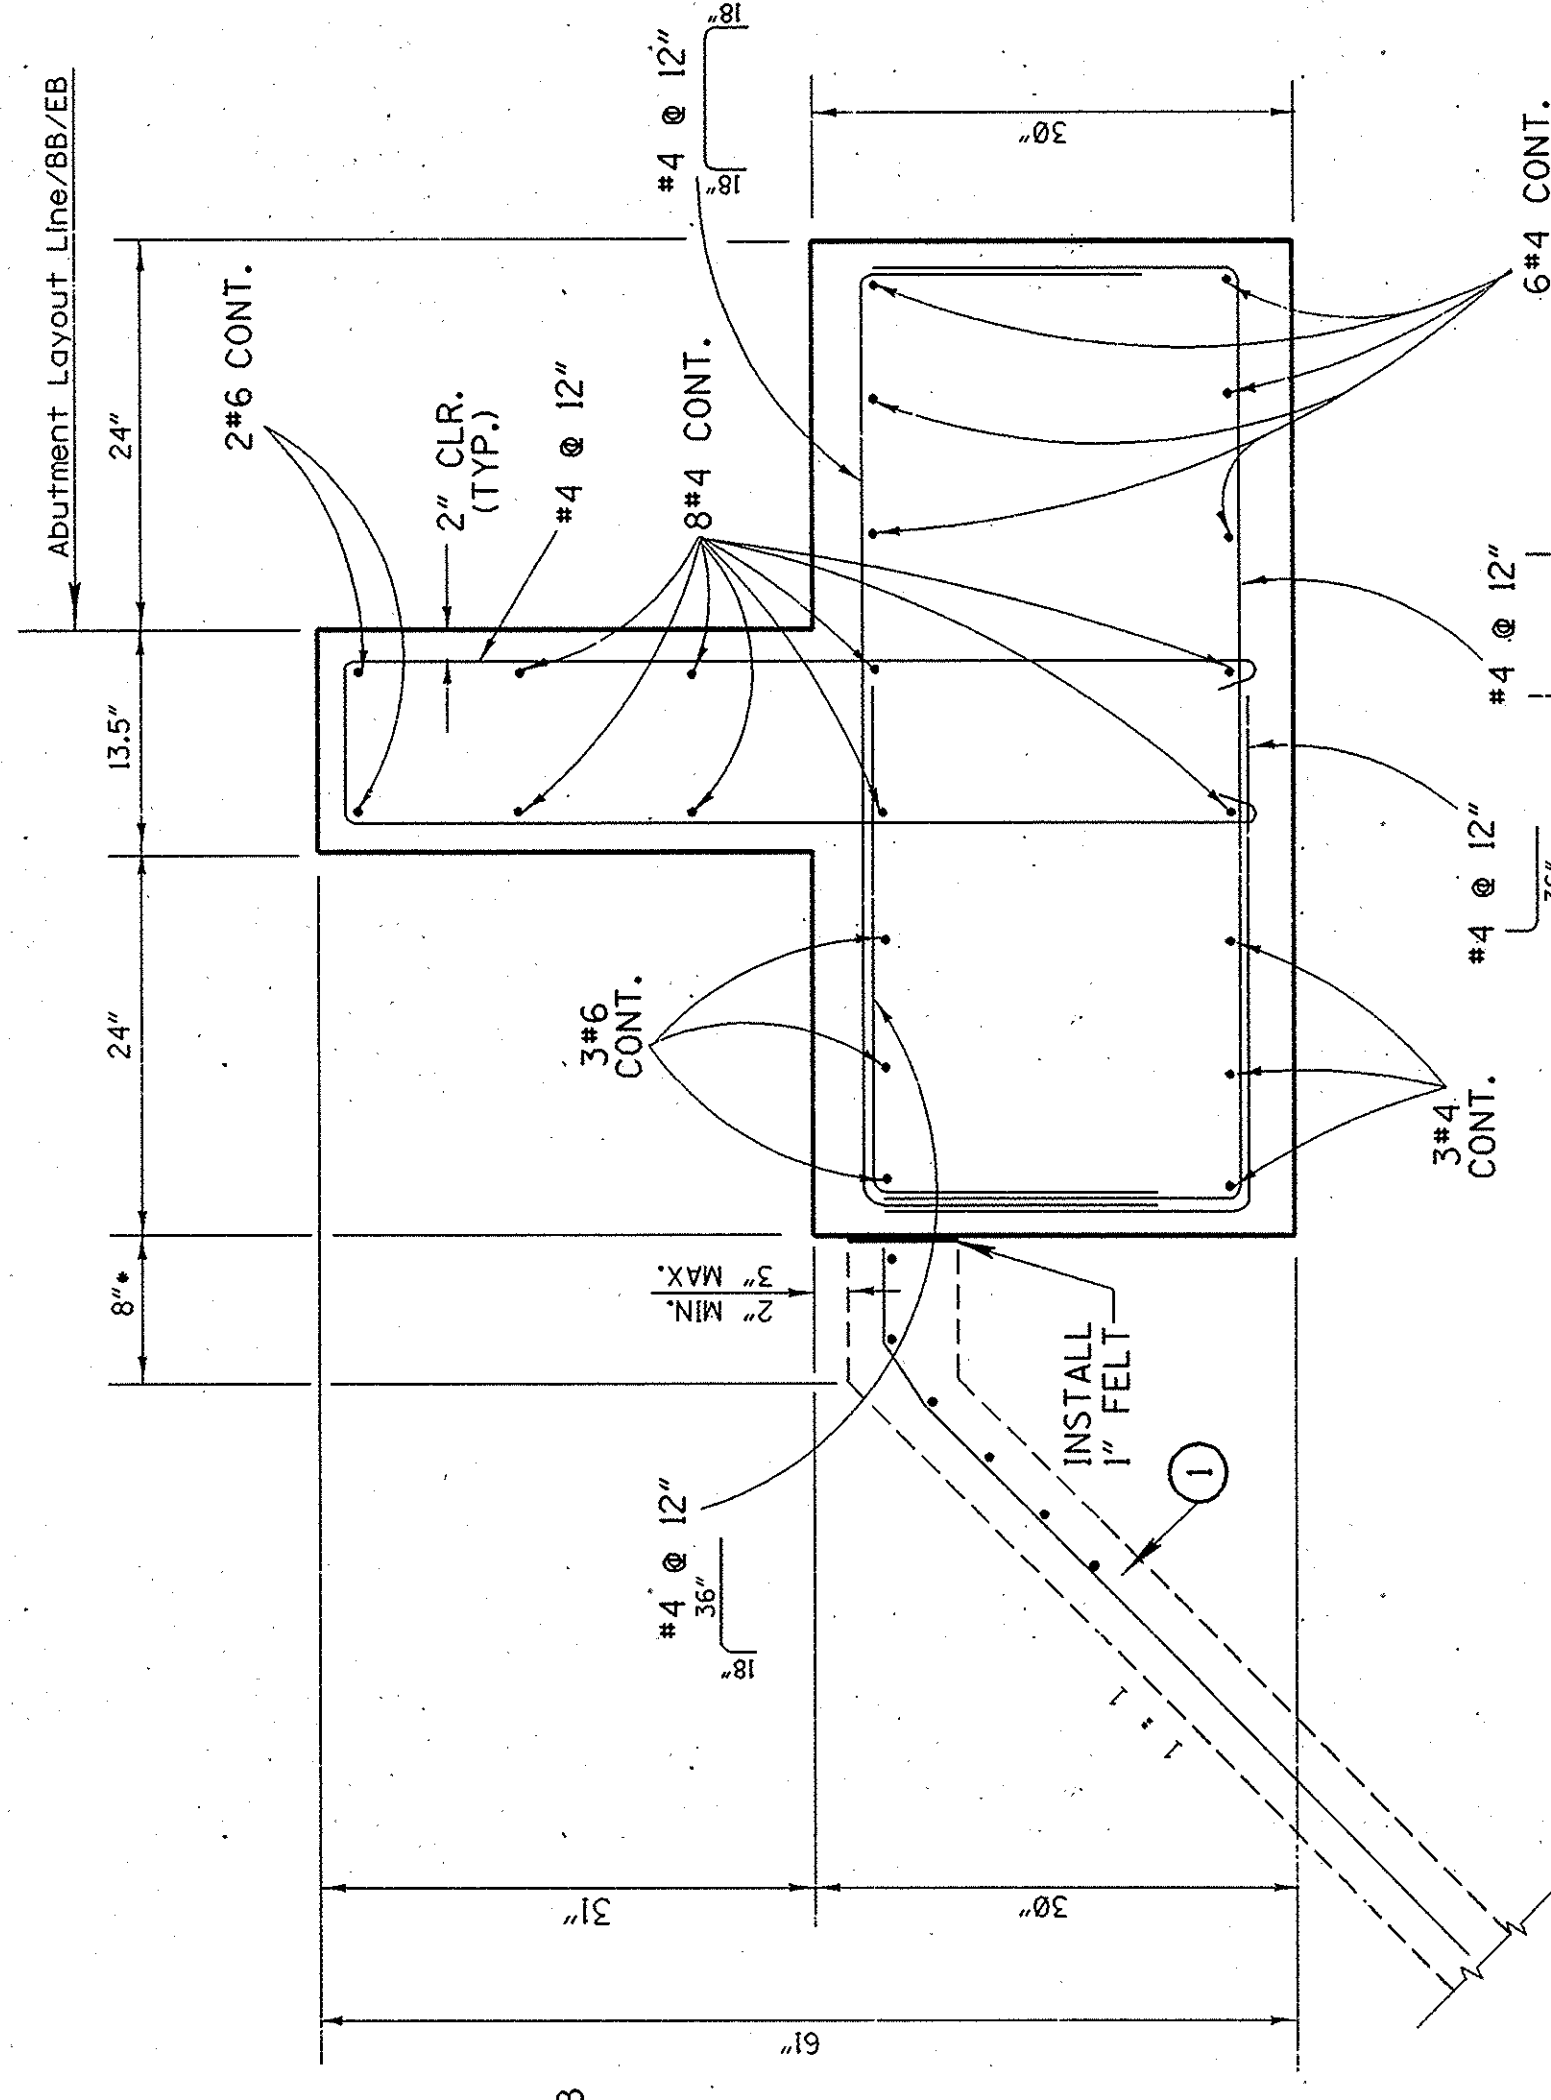


TYPICAL ABUT. #1 & #2

SECTION A-A

SCALE: 1"=1'-0"

* VERIFY DIMENSION PRIOR TO FABRICATION OF GIRDERS.

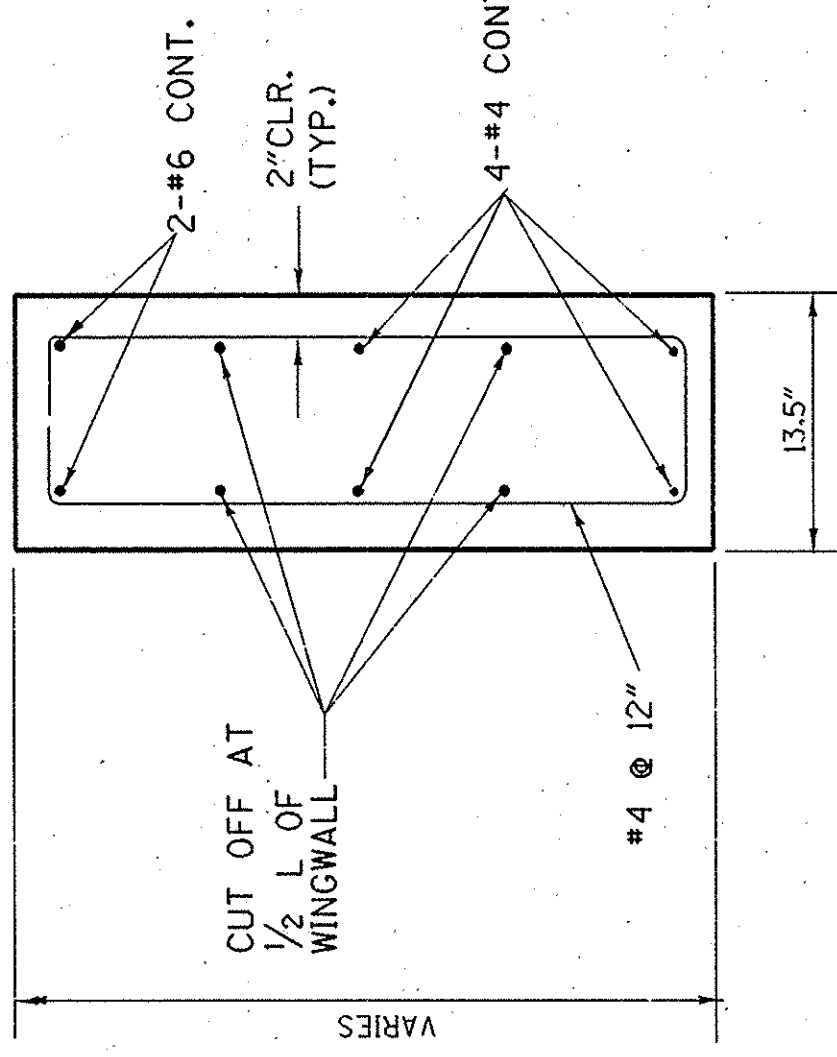

SECTION B-B

TYP. BOTH ABUT.

SCALE: NONE

ORANGE COUNTY ENVIRONMENTAL MANAGEMENT AGENCY		ALISO CREEK (U01) PEDESTRIAN BRIDGE AT SYCAMORE PARK		ABUTMENT	
DESIGNED	RRS	CHECKED	BAH	DATE	9-91
DRAWN	LEHAM	SCALE	AS SHOWN	SHEET	4 OF 6
REVISIONS					
NO.	DATE	DESCRIPTION			
1	5/4/91	AS SHOWN			
PREPARED UNDER CONTRACT NO. 12-31-93					
RICHARD HART RCE 39595 (EXP. 12-31-93)					