
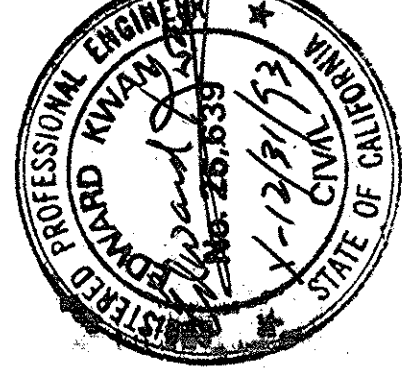
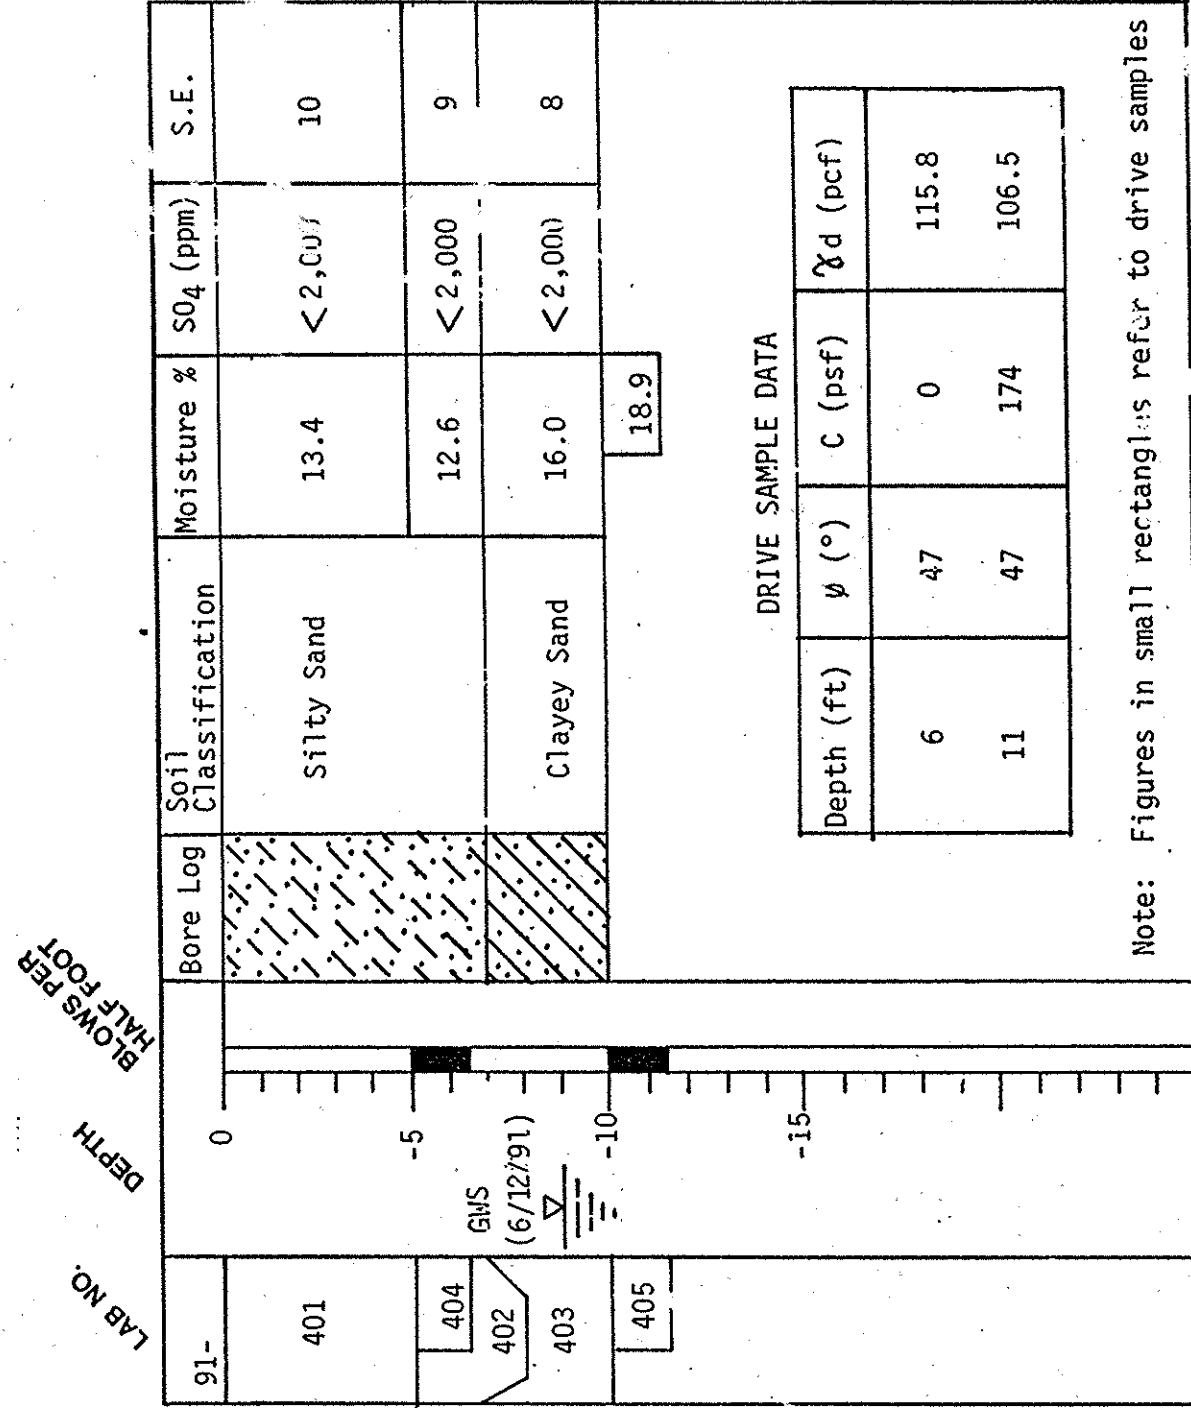
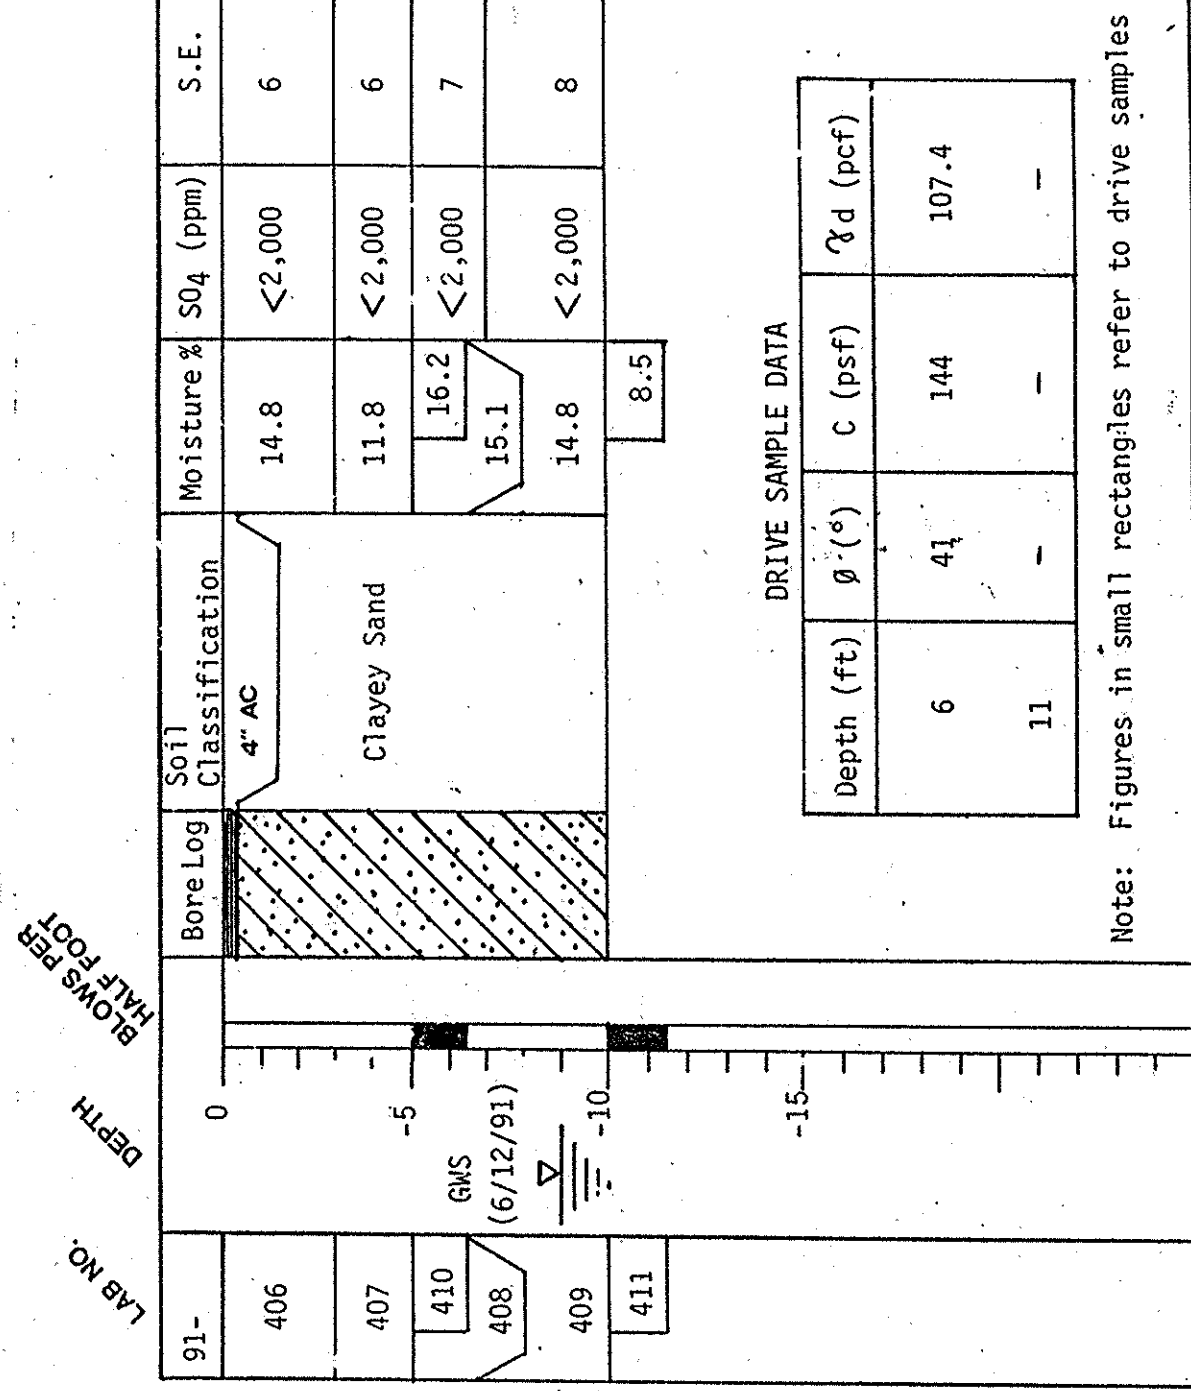
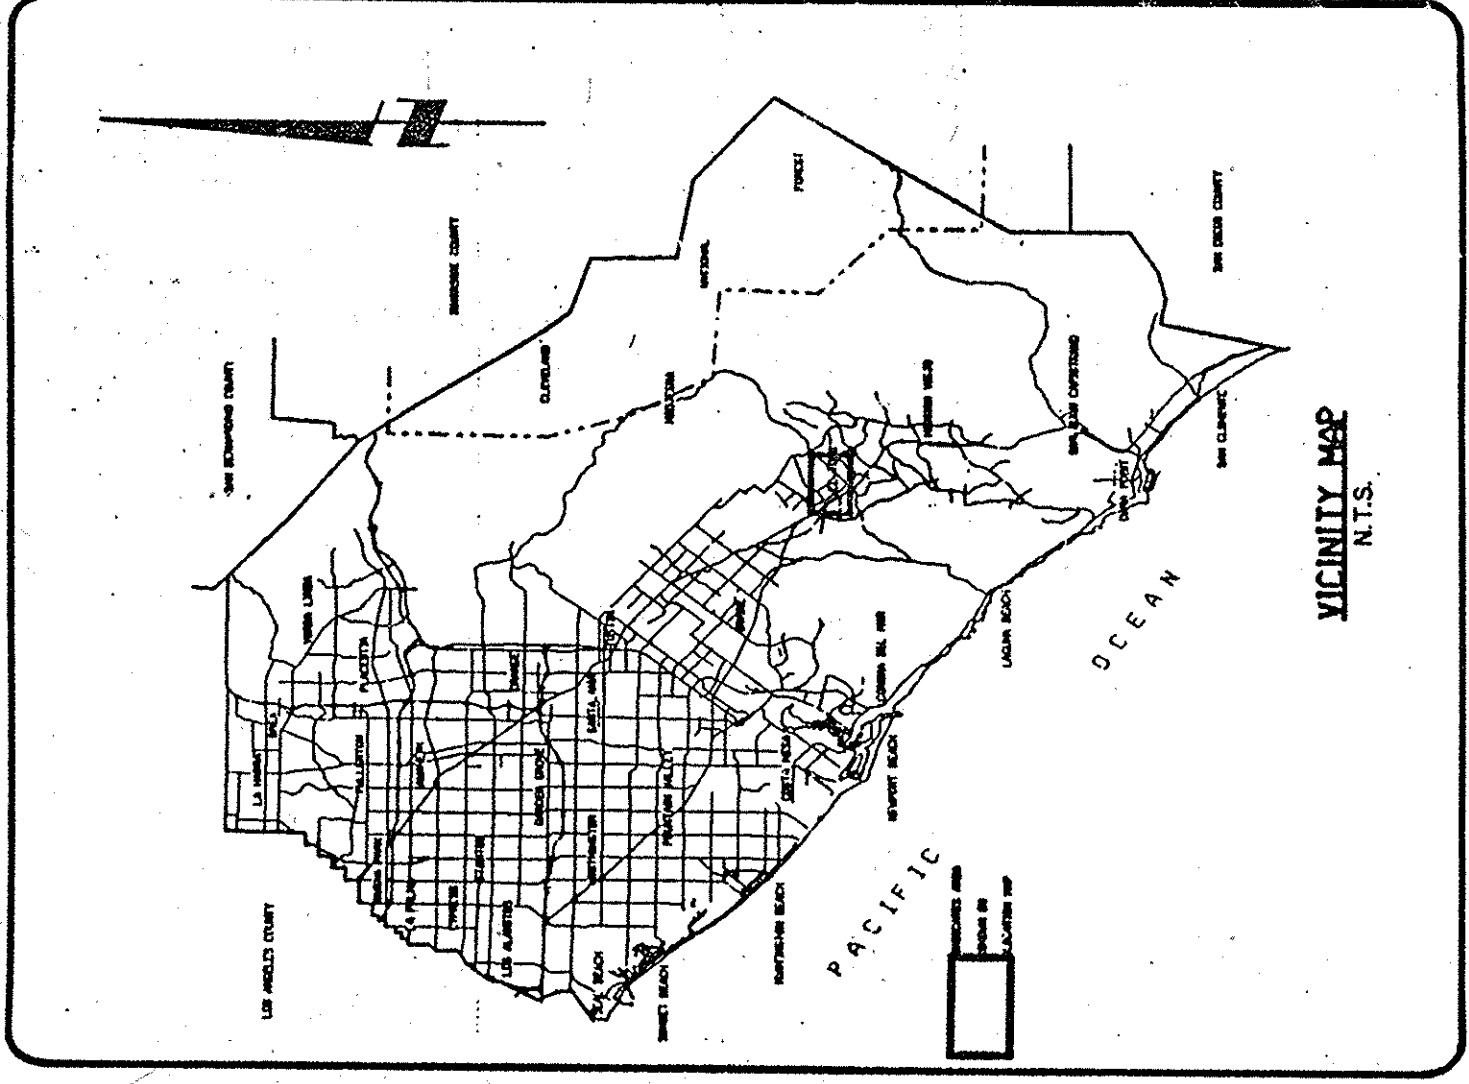
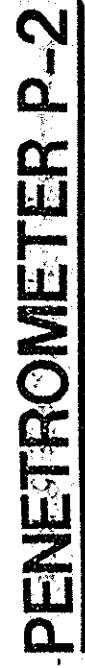
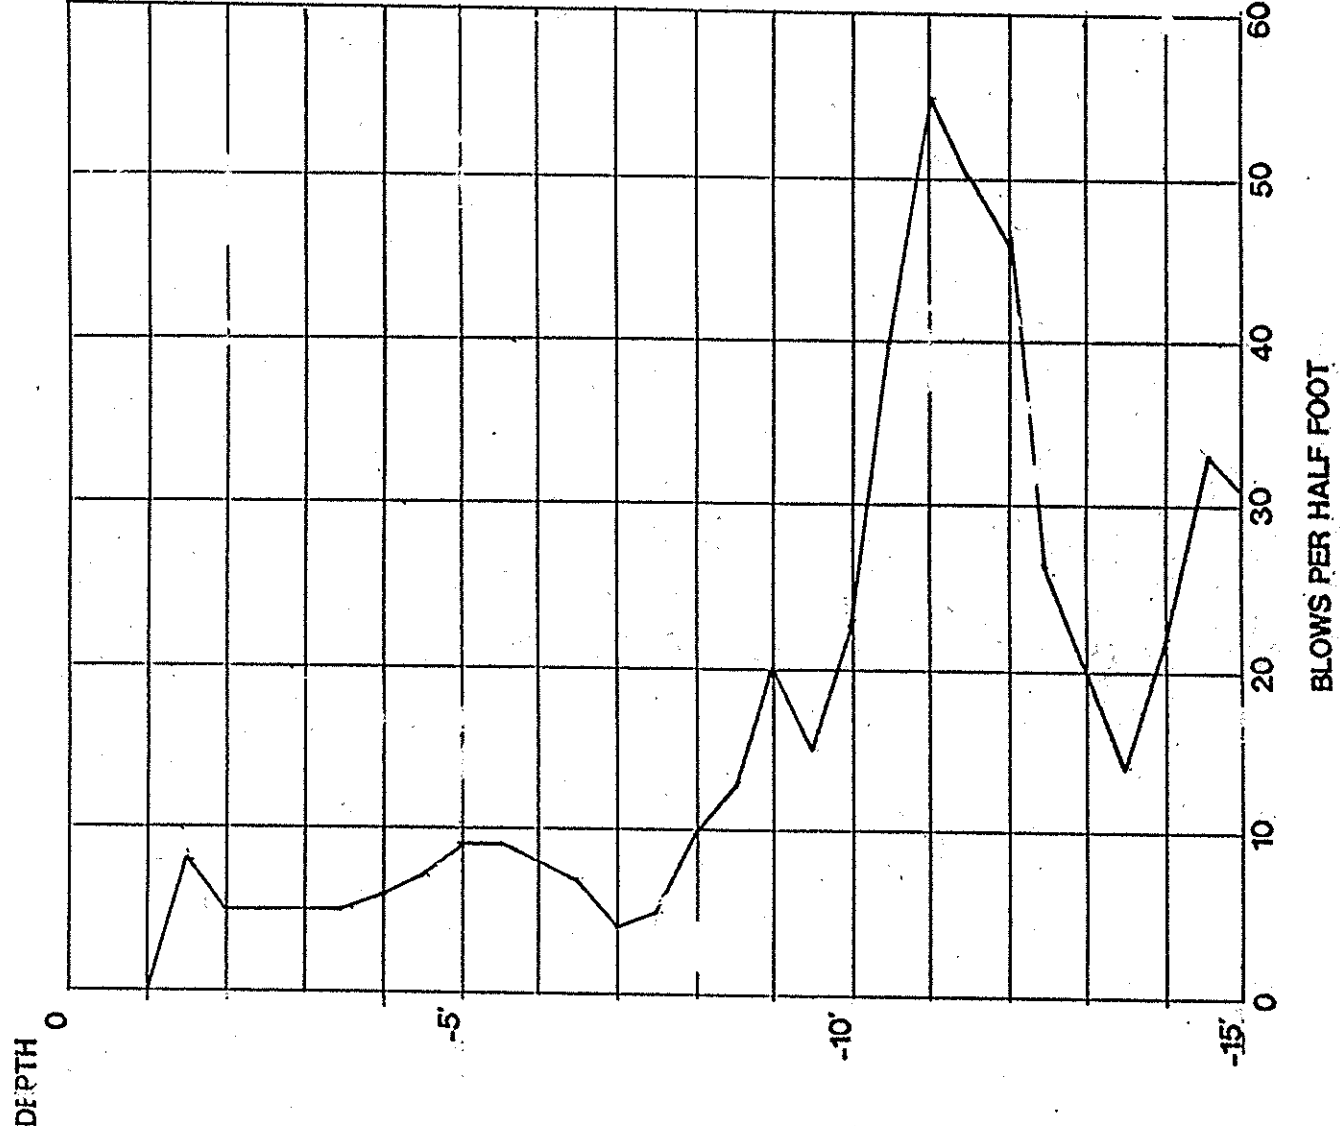


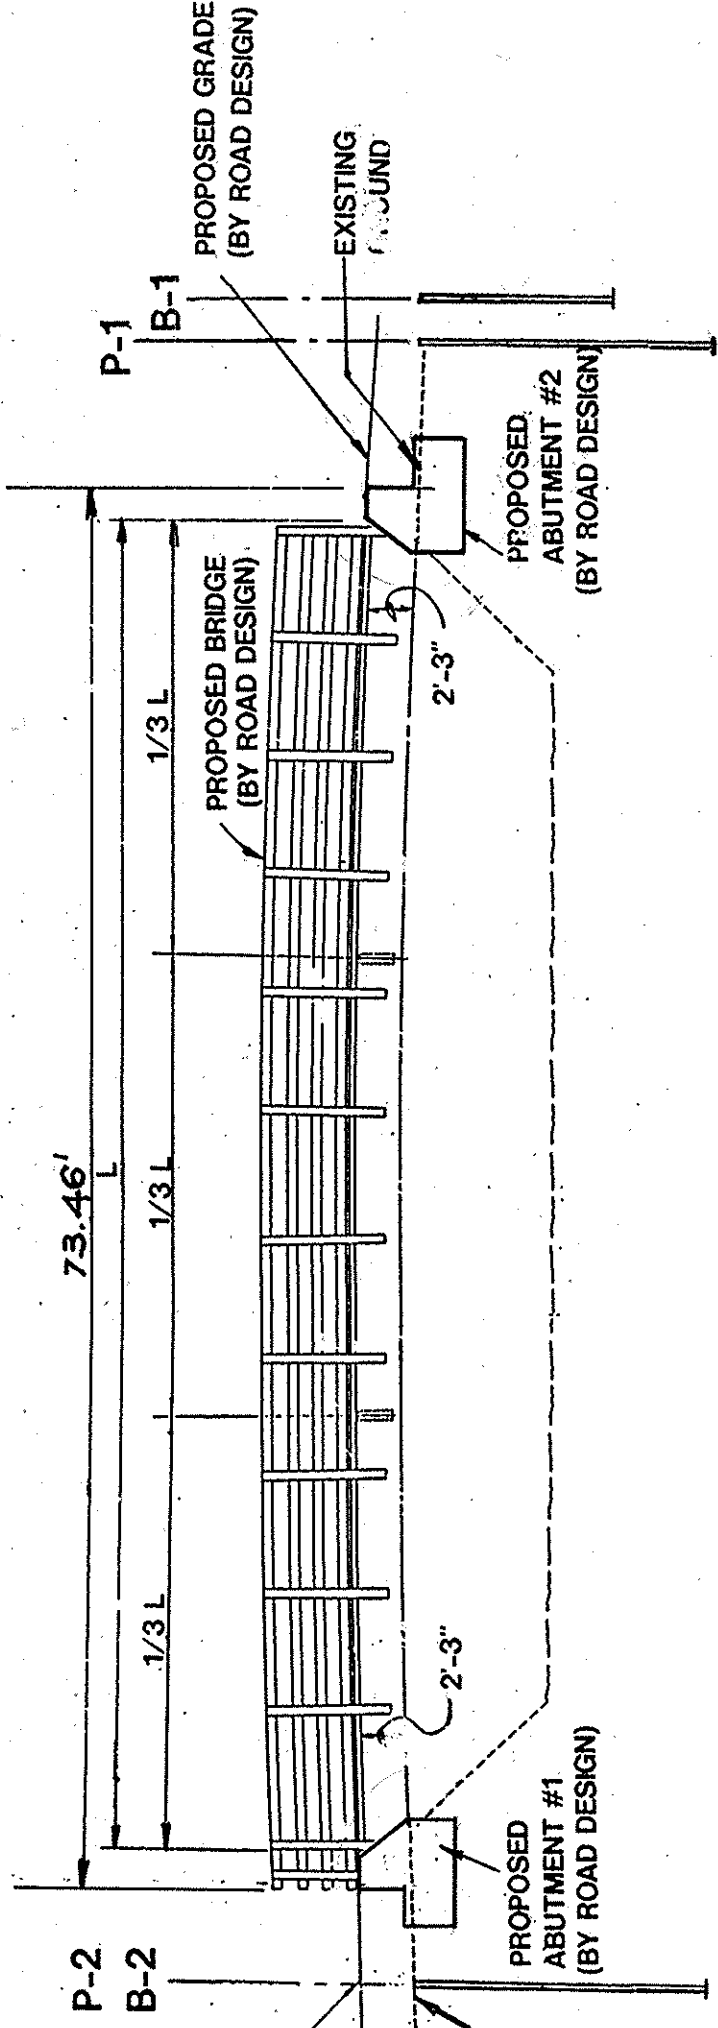

BORING LOG B-2

BORING LOG B-1

1 1/2 0 1 2
5 inches on original drawing

[illegible]