


PUBLIC FACILITIES & RESOURCES DEPARTMENT
SANTA ANA, CALIFORNIA
JOHN SIBLEY, DIRECTOR

RESTORATION OF BRIDGE
OVER SANTIAGO CREEK
IN
MODJESKA CANYON
WILDERNESS PRESERVE

FUNDED BY: F.E.M.A.

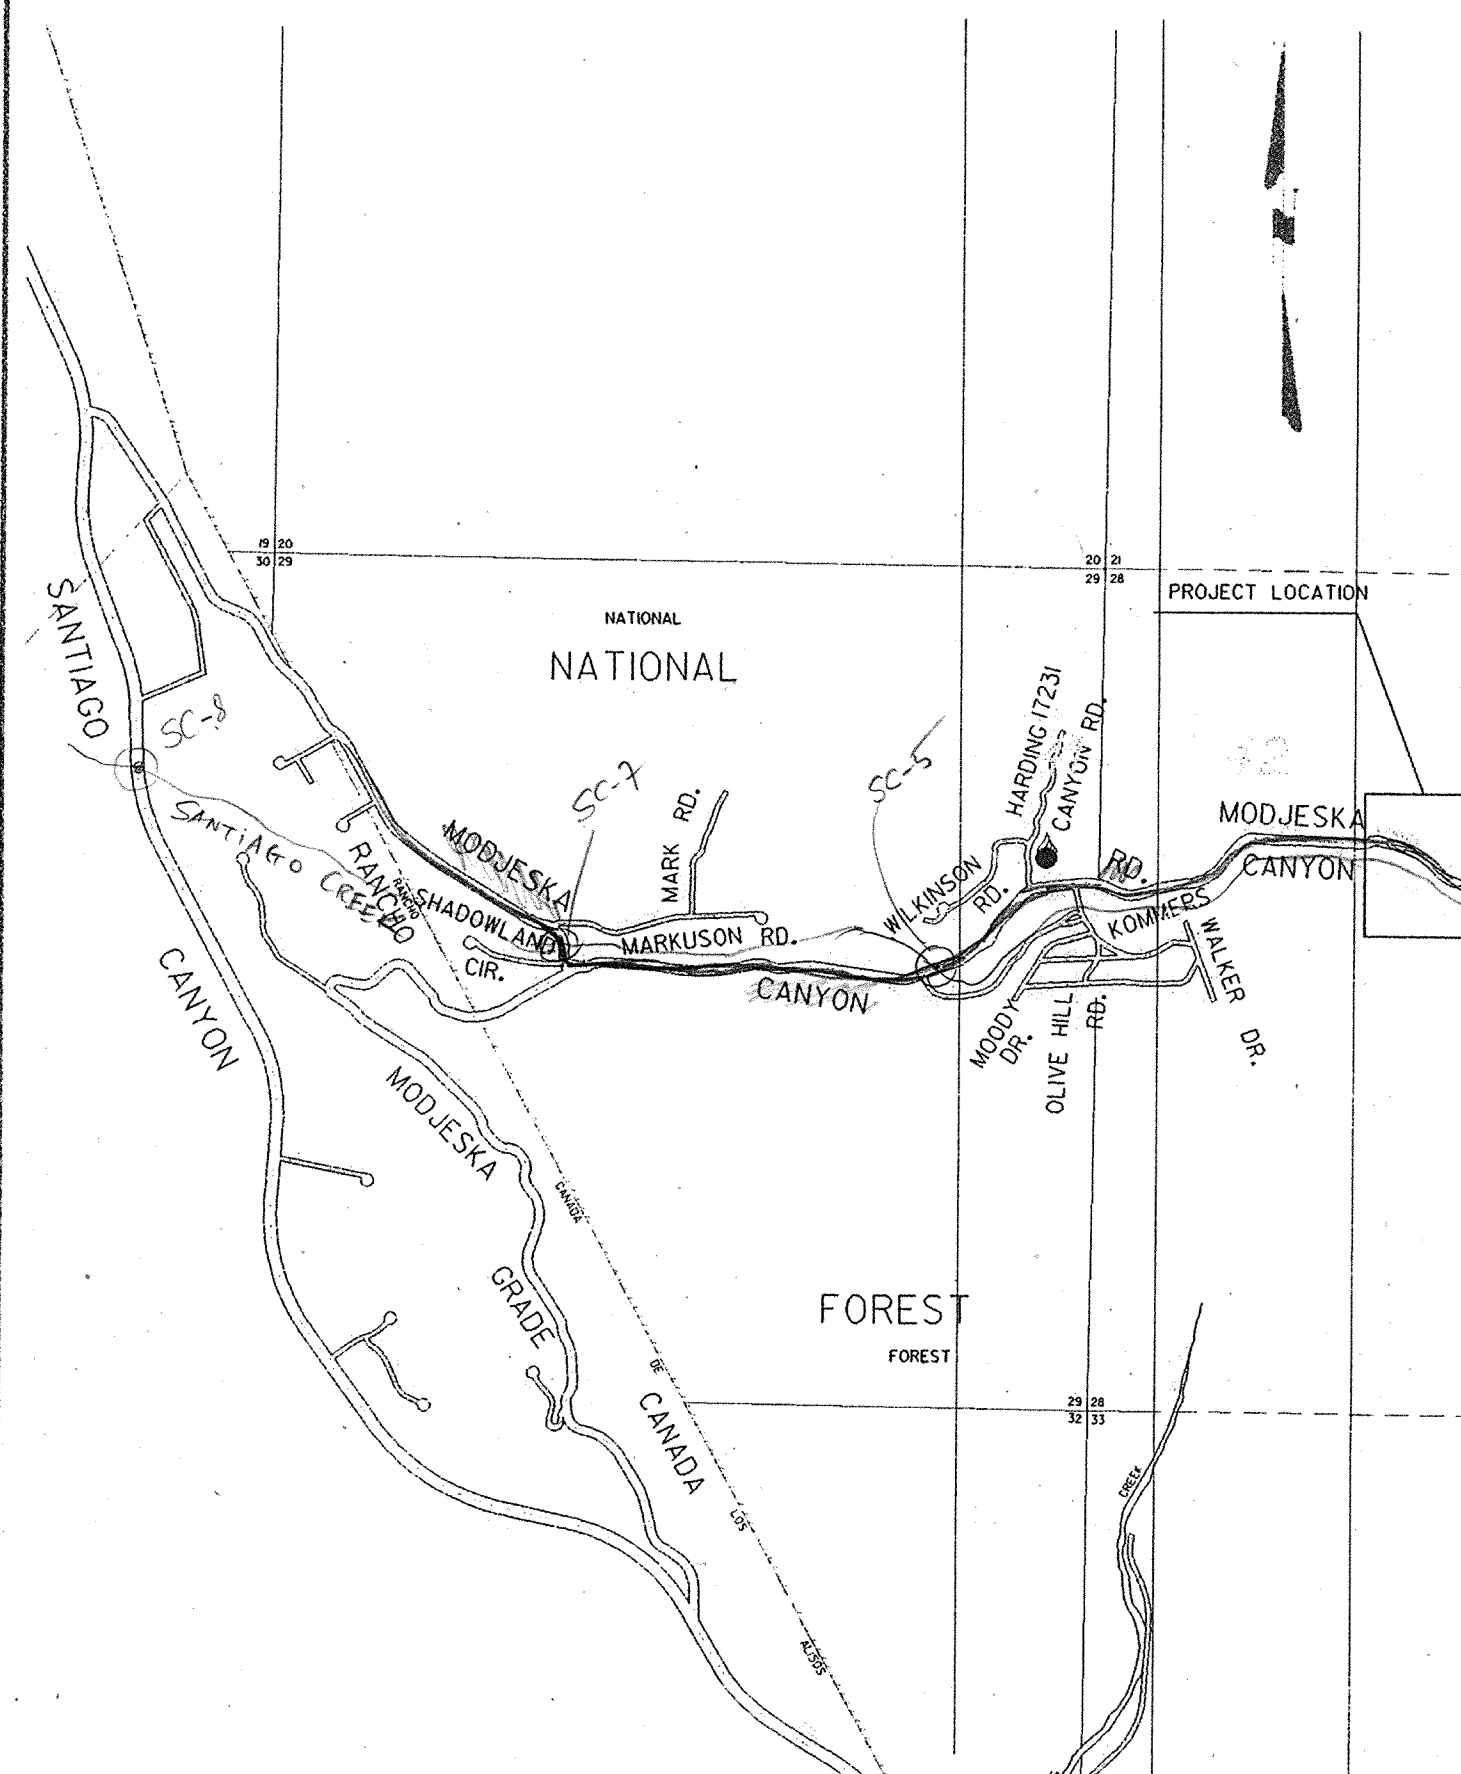

LOCATION MAP

SUBMITTED

REGISTERED PROFESSIONAL ENGINEER
JERRY STERLING
No. 25075
Exp. 12/31/2001
STATE OF TENNESSEE
CIVIL ENGINEERING

12/1/98
DATE

RECOMMENDED

D:  

SECTION CHIEF R.C. 264.000-0000
 EMAPUBLIC WORKS OPERATIONS
 ENGINEERING CONTRACTS

APPROVED.

ED: *KR Smith*
DIRECTOR OF PUBLIC WORKS

4/6/99
DATE

<u>UTILITIES</u>		
UTILITY OWNER	CONTACT	XXX-XXX X XXX

	As built	2	Jamp Stutz 2/99	
DESCRIPTION		SHT.	APPROVED	DATE
REVISIONS				

W. O. NO. XXXX
DWG. NO. XXXX

SHEET 1 OF 5