

PHASE I RIP-RAP

CONSTRUCTION NOTES

- 1 CONSTRUCT GROUTED 3'dia. RIP-RAP ABUTMENT FOR BRIDGE PER PLAN AND DETAIL ON SHEET 3.
- 2 CONSTRUCT 3'dia. WING WALLS PER PLAN & TYPICAL SECTION
- 3 PLACE EXCAVATED MATERIAL IN DISPOSAL SITE

PHASE II BRIDGE

CONSTRUCTION NOTES


- 4 CONSTRUCT REINFORCED CONCRETE BRIDGE ABUTMENT PER PLAN, PROFILE AND DETAIL ON SHEET 3.
- 5 FURNISH AND INSTALL ABUTMENT/BRIDGE PAD PER REQUIREMENTS AND DETAIL ON SHEET 3.
- 6 FURNISH AND INSTALL BRIDGE PER PLAN PROFILE AND MANUFS. REQUIREMENTS.
- 7 CONSTRUCT ROADWAY APPROACH PER DETAIL HEREON
- 8 WELD R.R. BRIDGE AND PLATES PER DETAILS SHEET 4

PHASE III PEDESTRIAN BRIDGE

CONSTRUCTION NOTES

- 8 CONSTRUCT PEDESTRIAN BRIDGE ABUTMENT PER PLAN AND DETAIL ON SHEET 5.
- 9 INSTALL PEDESTRIAN BRIDGE PER PLAN AND DETAIL ON SHEET 5.
- 10 CONSTRUCT PEDESTRIAN BRIDGE APPROACH PER DETAIL ON SHEET 5.

AS BUILT - PEDESTRIAN BRIDGE DELETED

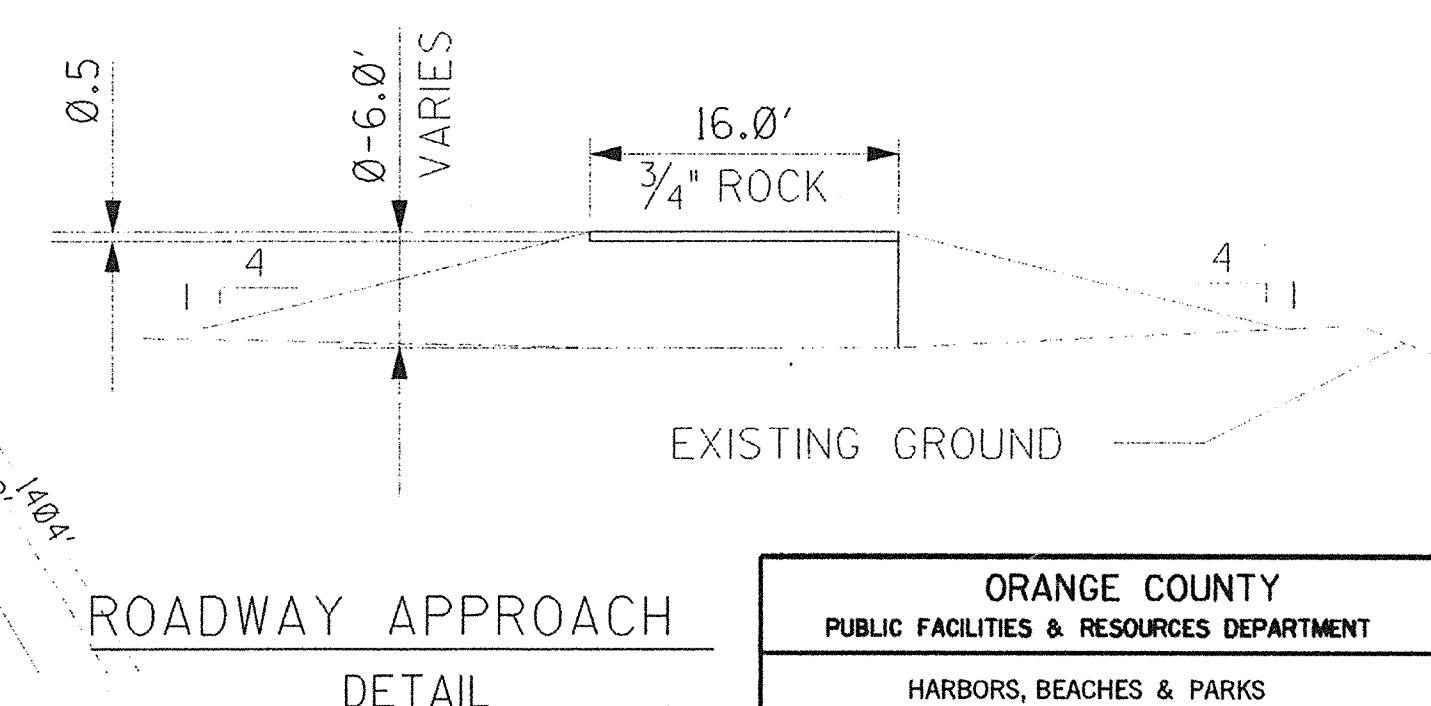

ORANGE COUNTY PUBLIC FACILITIES & RESOURCES DEPARTMENT			
HARBORS, BEACHES & PARKS			
MODJESKA PRESERVE			
RESTORATION PLAN			
PREPARED UNDER SUPERVISION OF	J.D. STERLING	DATE	
SCALE: 1" = 10'	DATE 8/98	DRAWN N.Z.	CHECKED J.D.S.
			SHEET 2 OF 5