

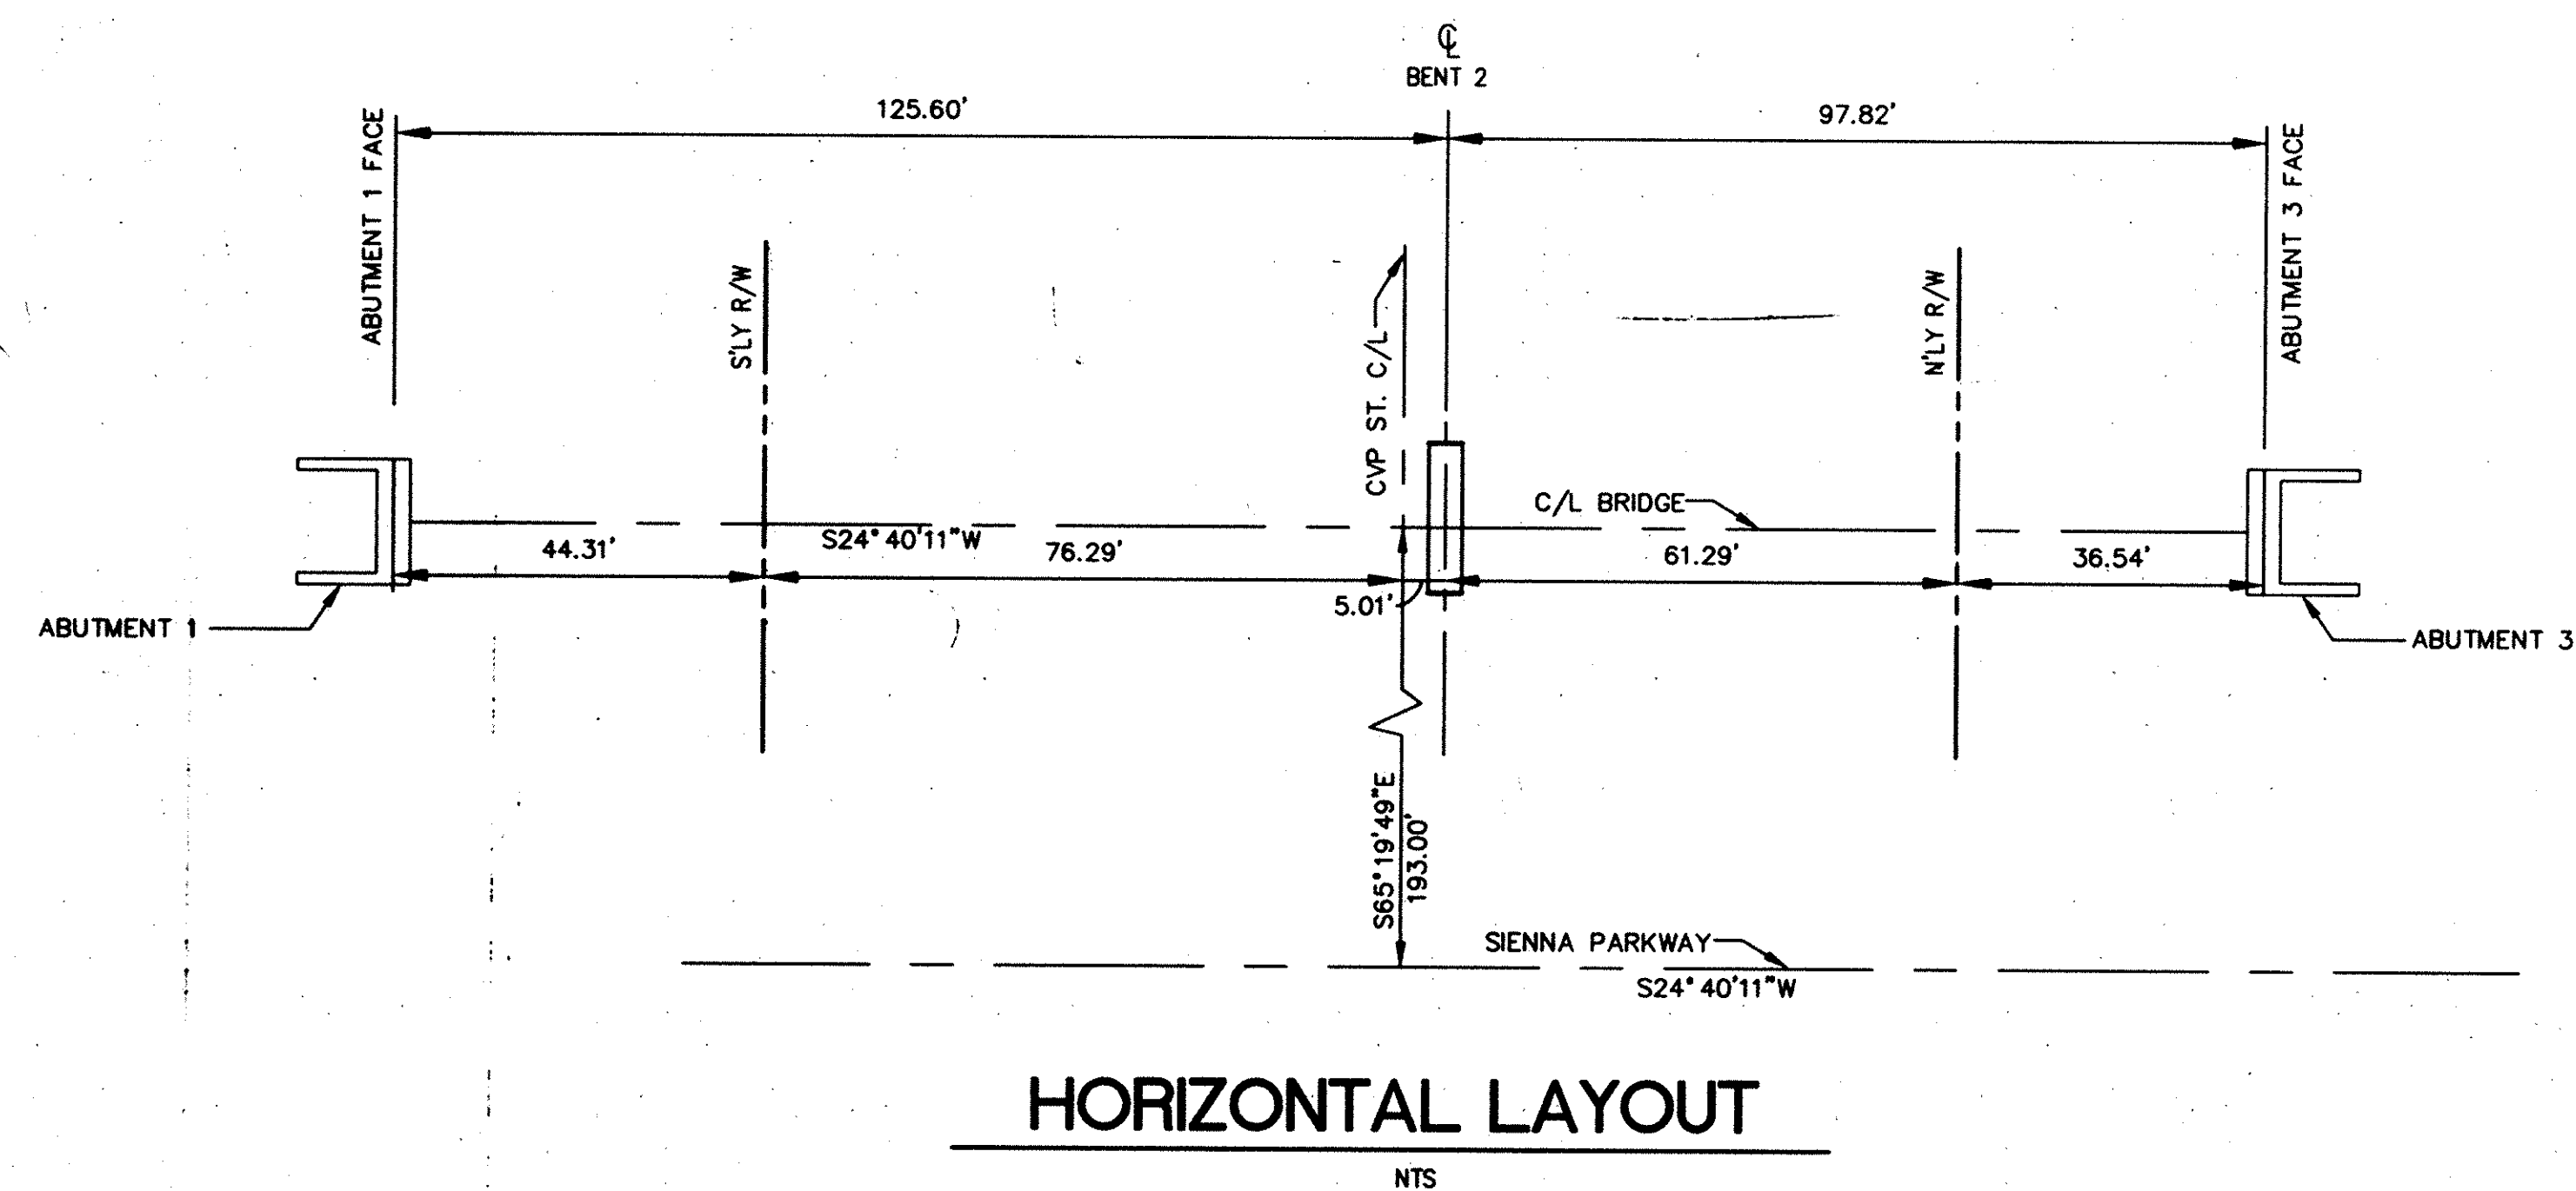


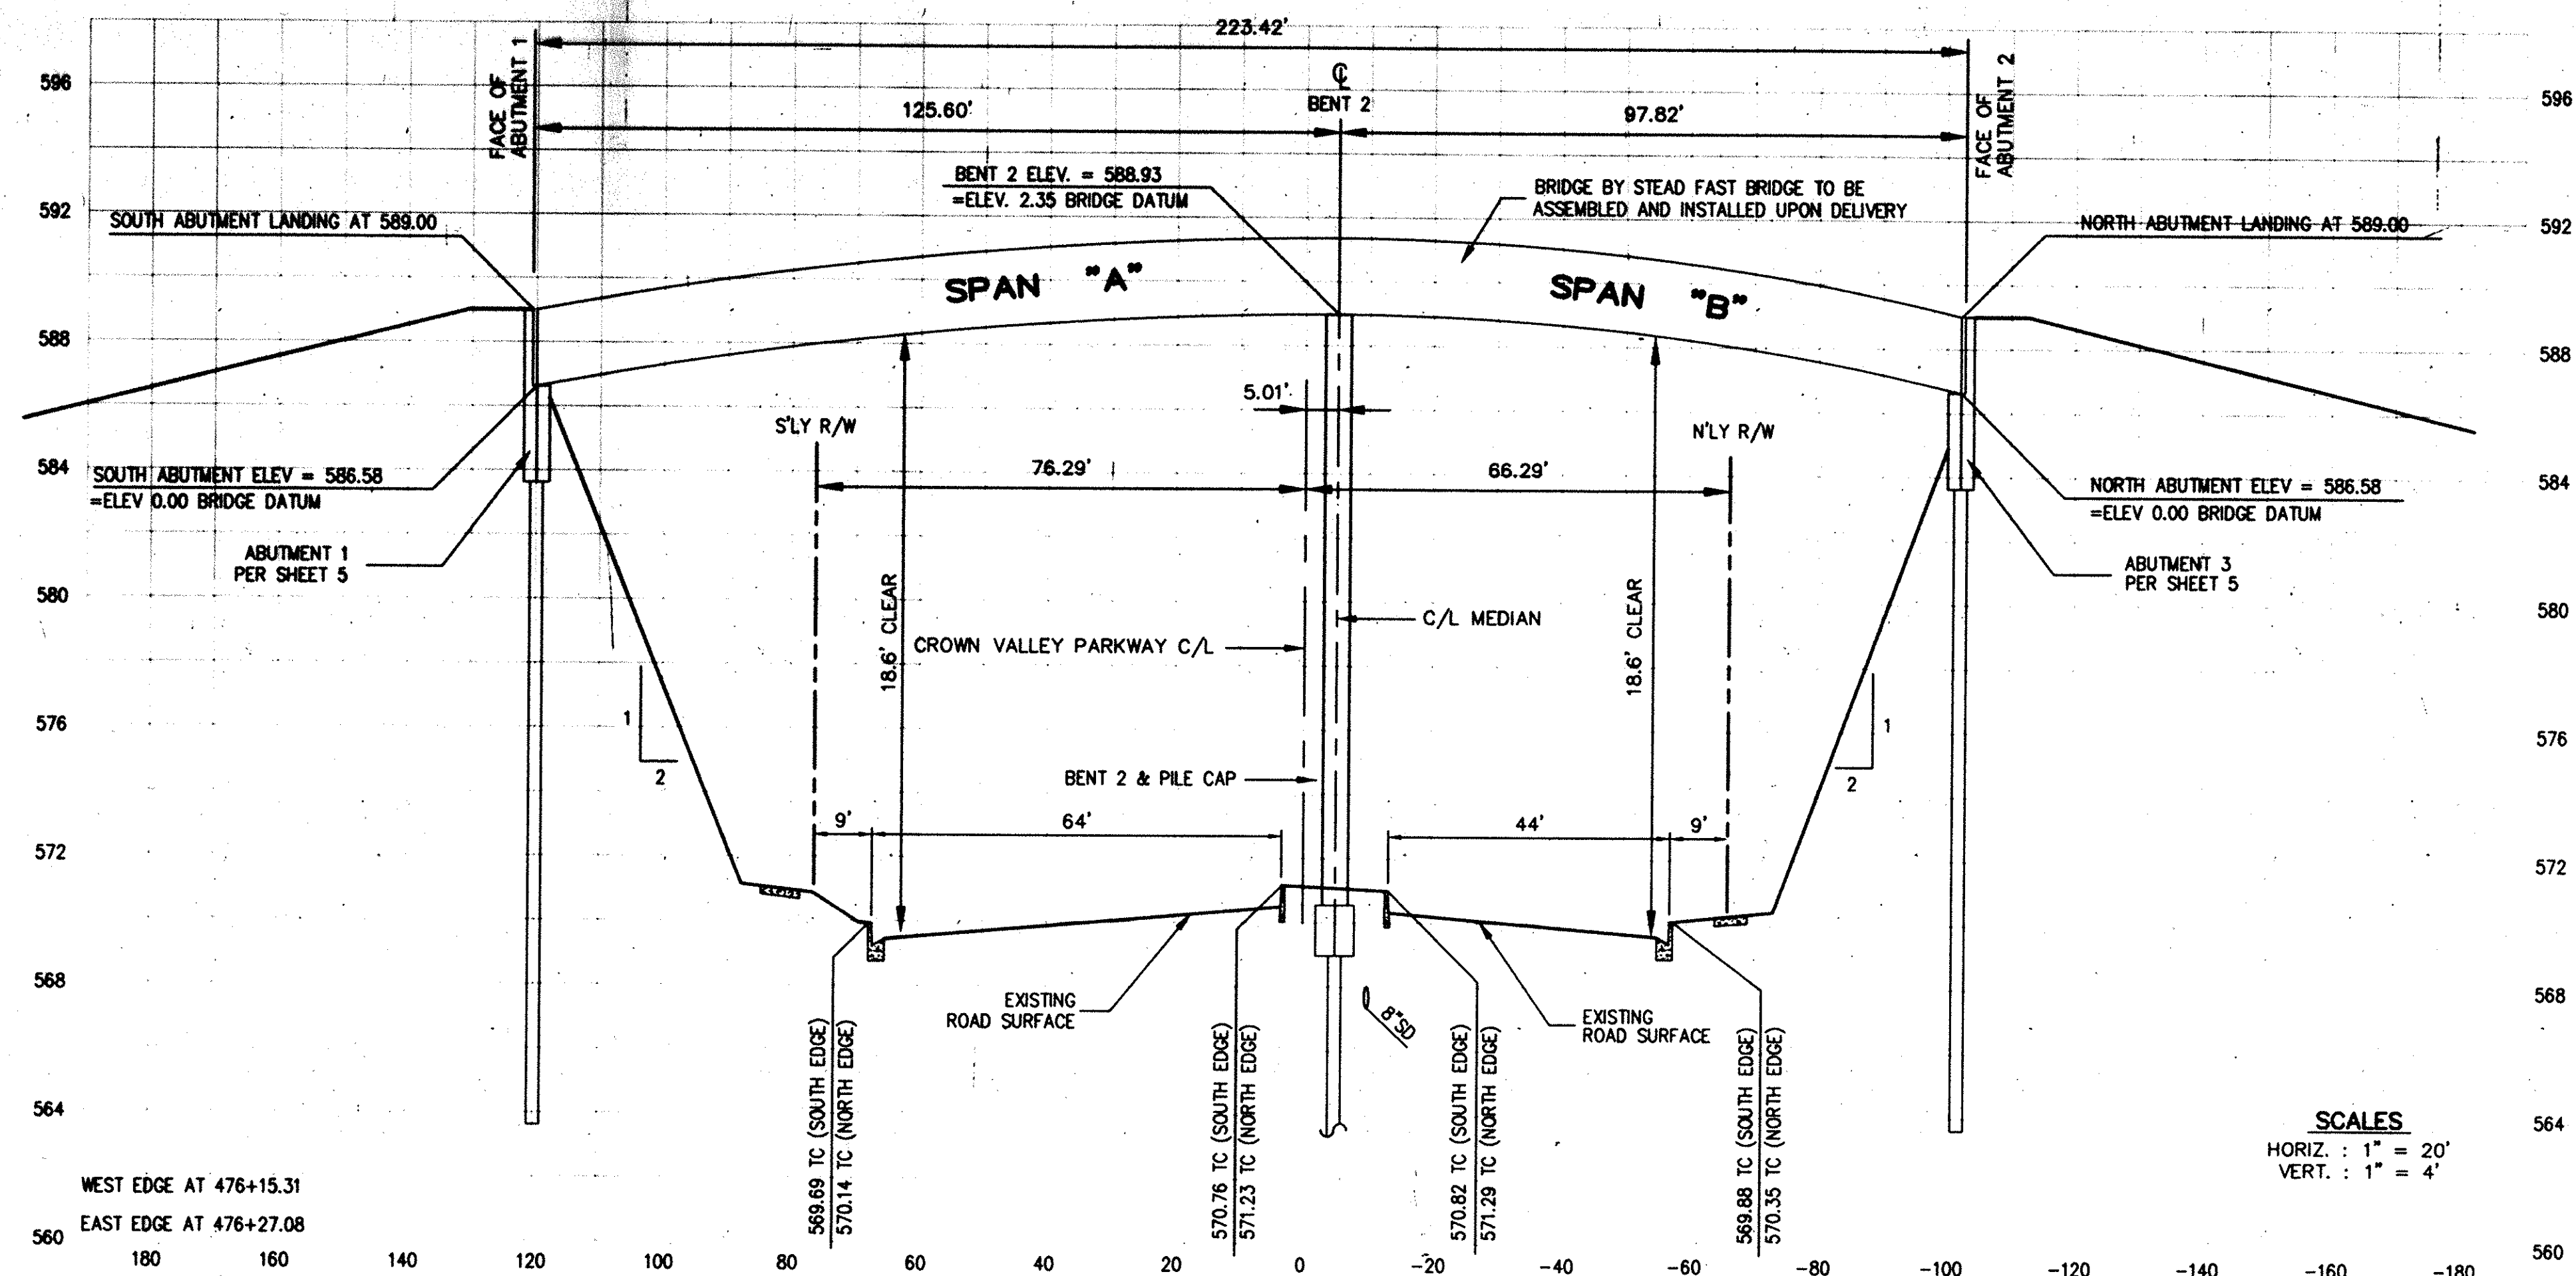

NO.	DATE	REVISIONS	APPROVED

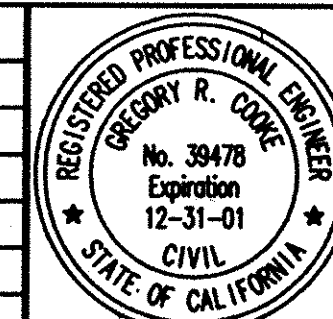

HUITT-ZOLIARS
 Huitt-Zollars, Inc.
 15101 Red Hill Avenue, Tustin, CA 92780 (714) 259-7900
 PREPARED UNDER THE SUPERVISION OF
 GREGORY R. COOKE
 39478 12-31-01
 R.C.E. EXPIRES DATE

DESIGNED BY
 P.L.
 DRAWN BY
 LE
 CHECKED BY
 P.L.

HORIZONTAL CONTROL FOR
LADERA RANCH
 CROWN VALLEY PEDESTRIAN BRIDGE

SHEET
3
 OF
7
 SHEETS
 JOB NO.
 10-0367-12