


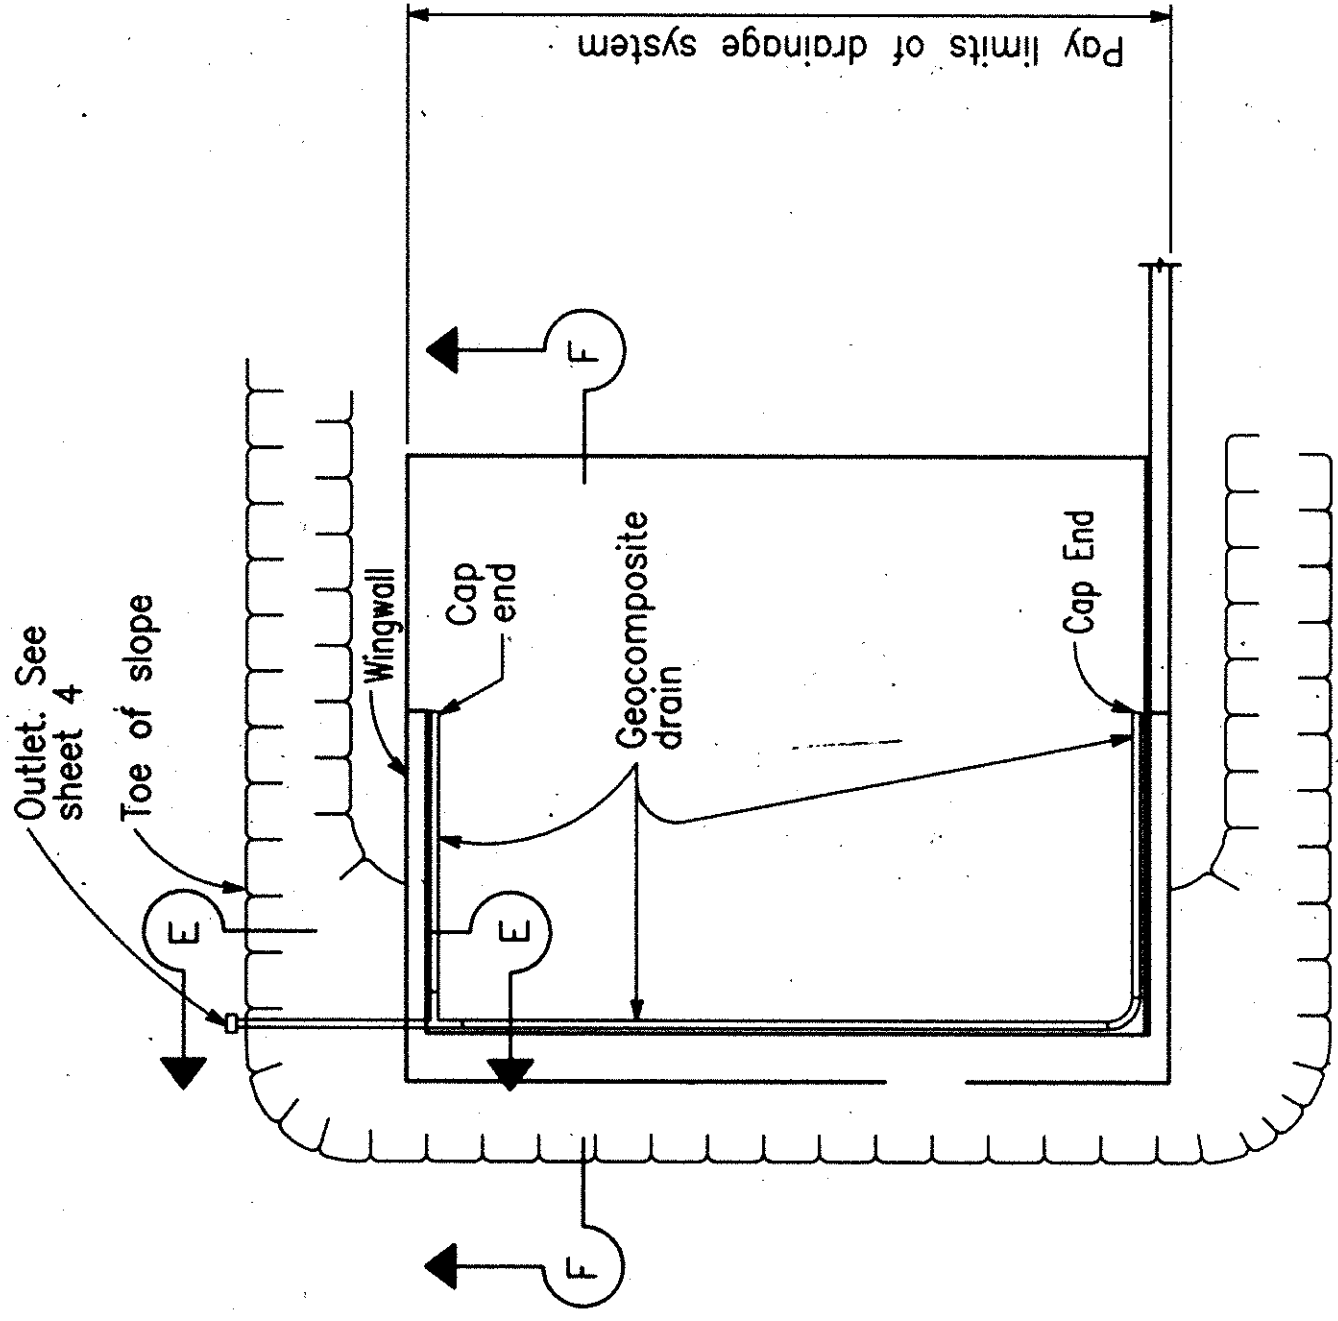


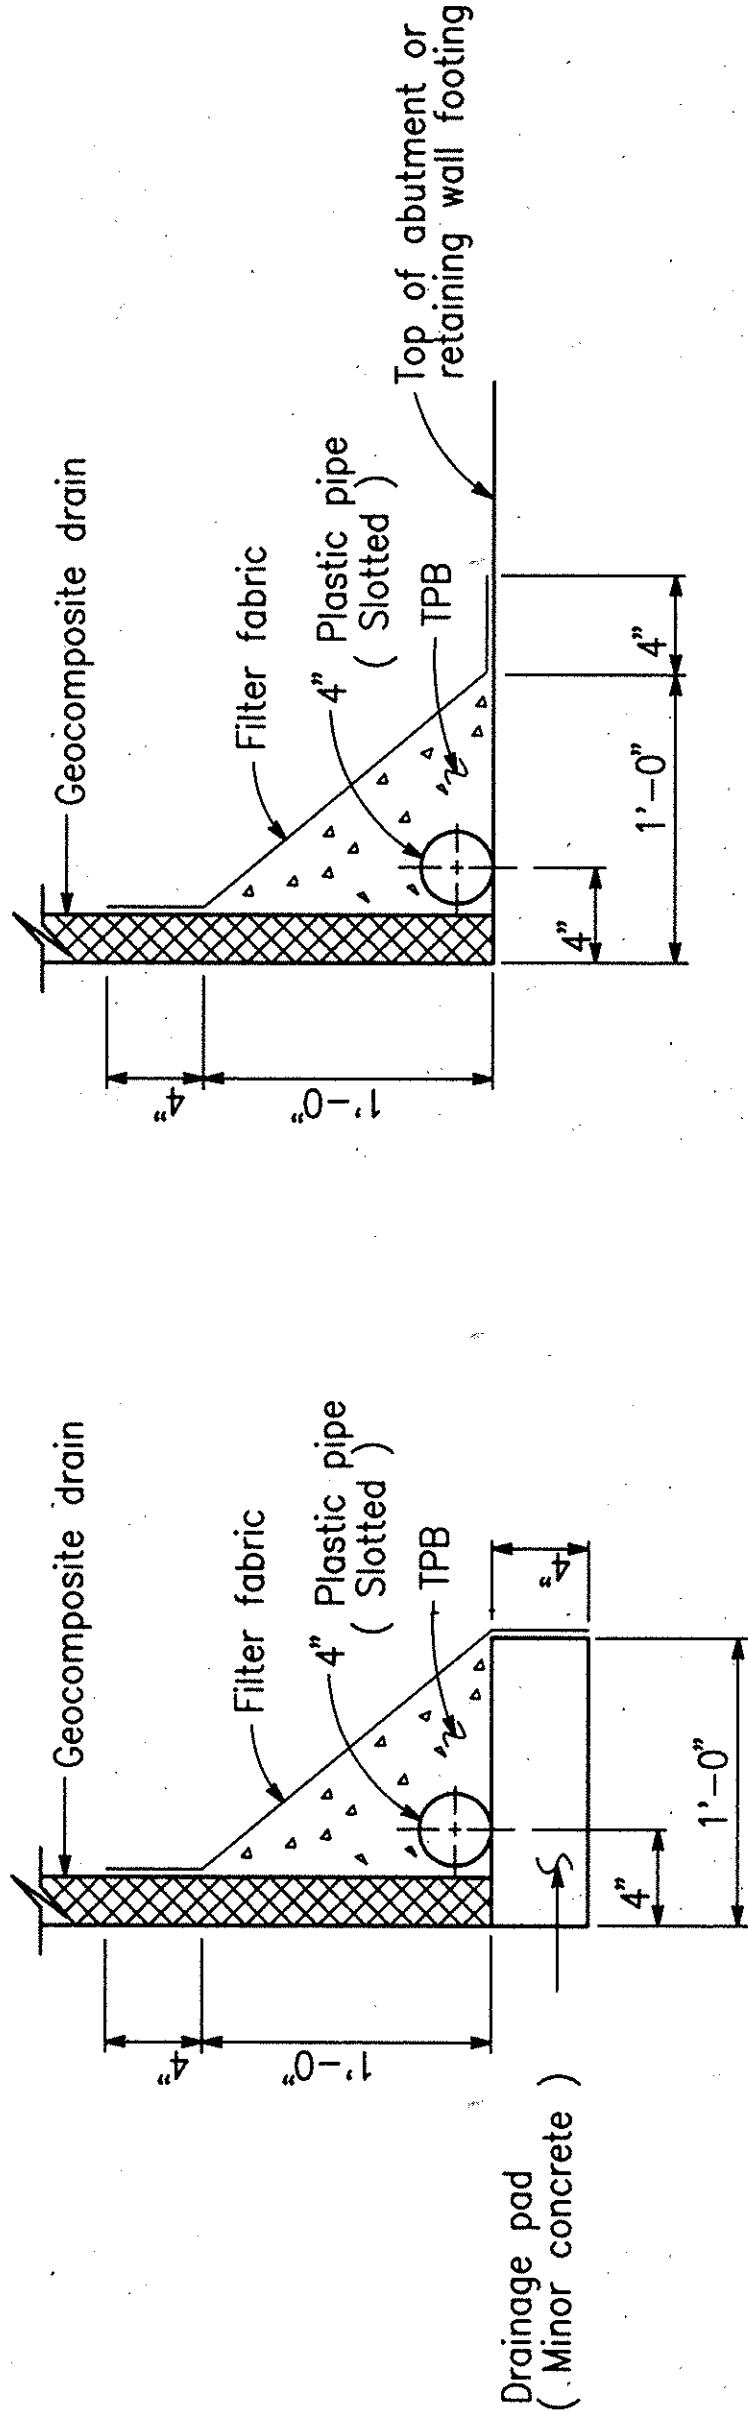

TYPICAL PLAN

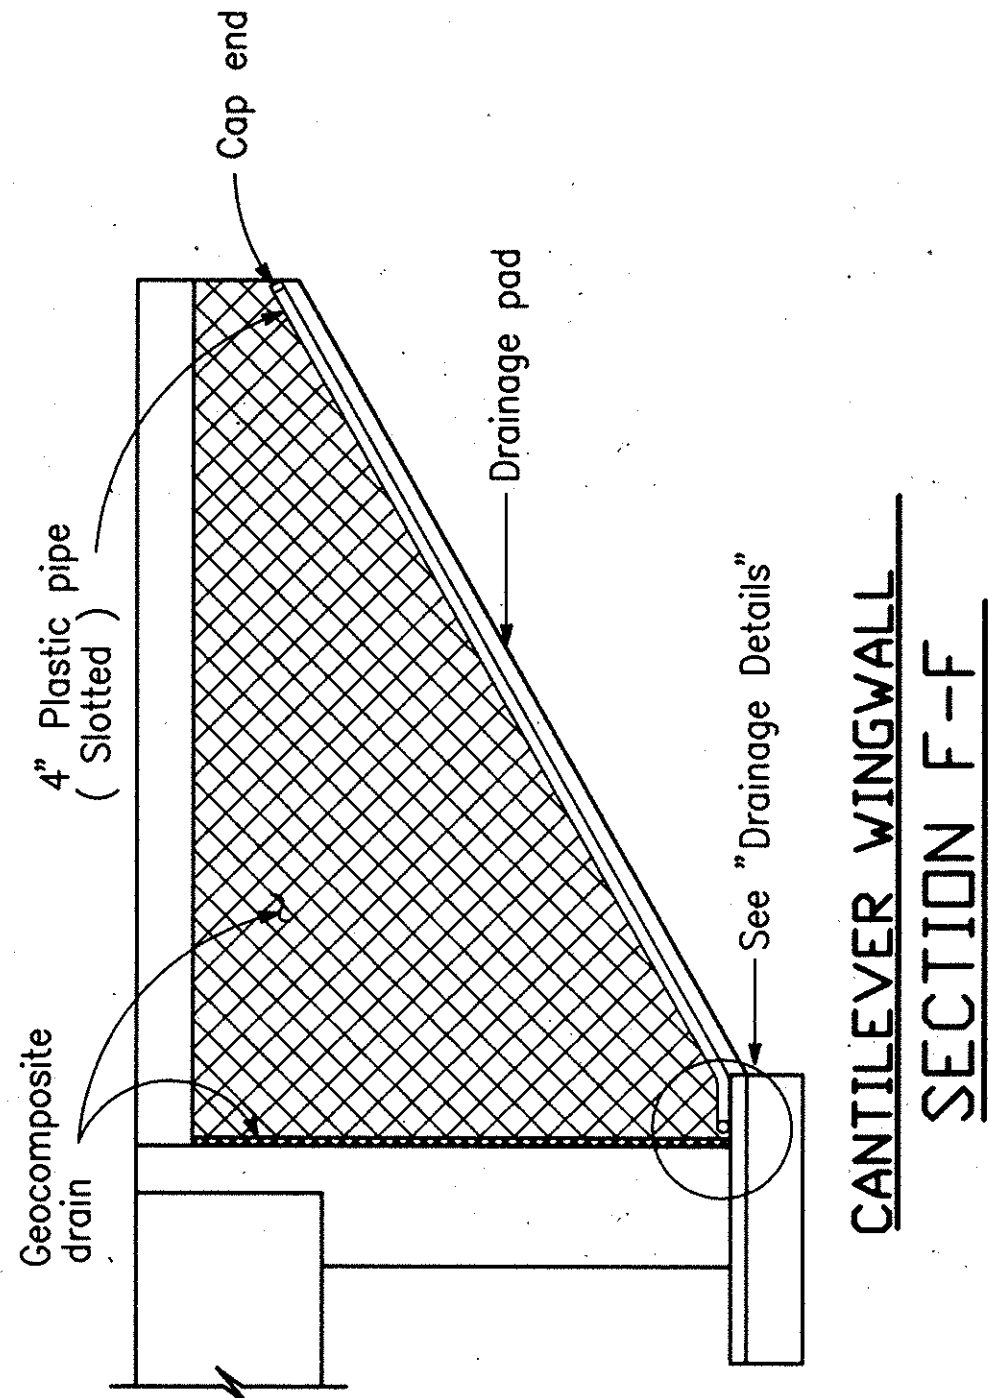

WITHOUT FOOTING
WITH FOOTING
DRAINAGE DETAILS

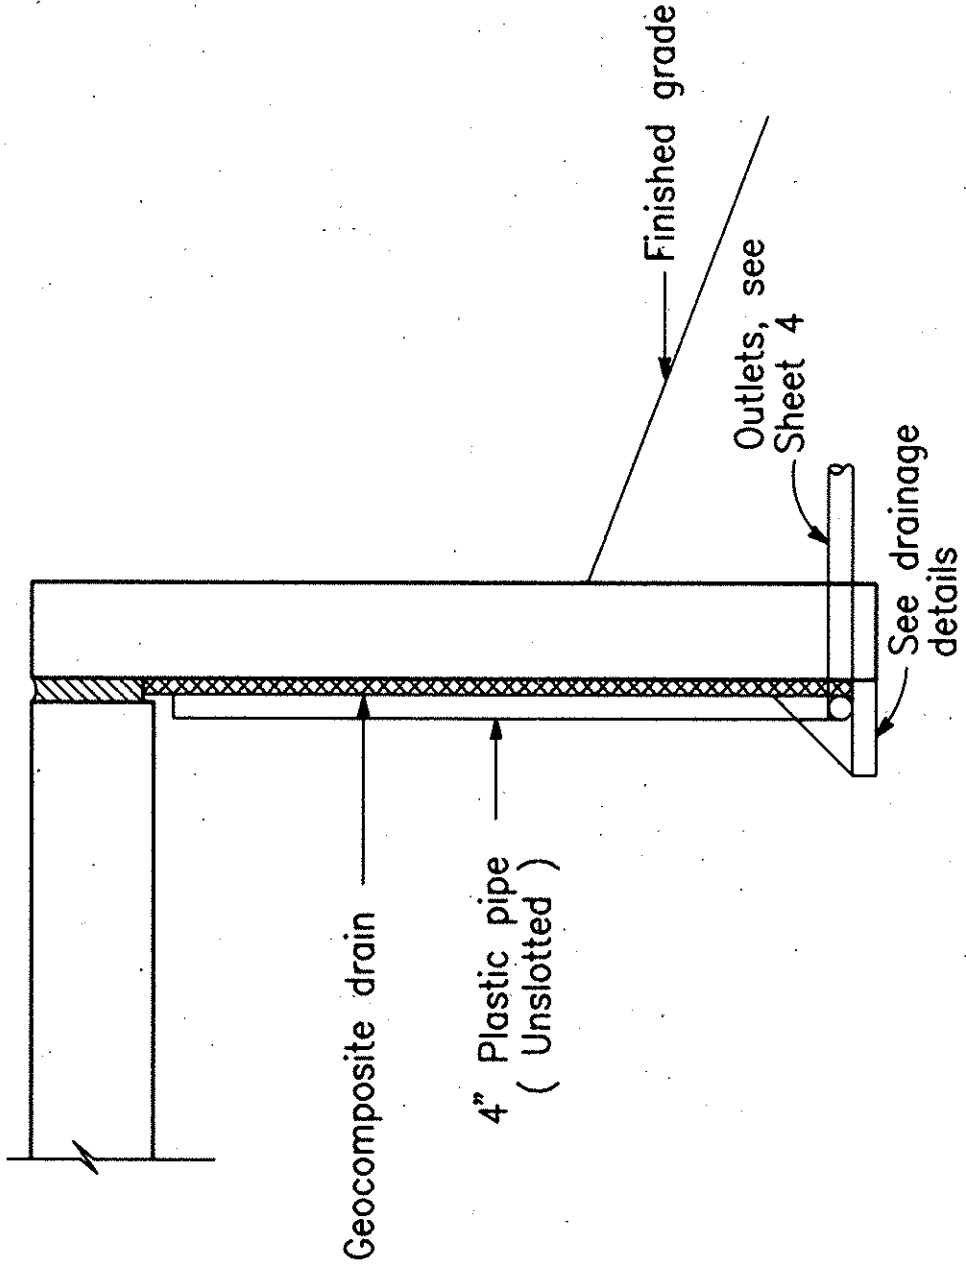


SECTION E-E

Note: Bends and junctions in 4" plastic pipe are 30" radius min.

INDEPENDENT REVIEW BY:

NO.	DATE	REVISIONS	APPROVED

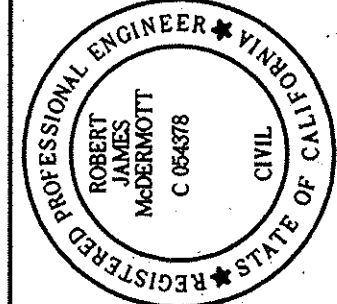

HUITT-ZOLIARS
19001 Pied Hill Avenue, Tustin, CA 92780 (714) 289-7900
PREPARED UNDER THE SUPERVISION OF
Robert J. Maderniott
12/31/00 054378 R.C.E. EXPIRES 12/31/02

DESIGNED BY	CHKD BY	DATE
AWM	LL	

DRAINAGE DETAILS FOR
LADERA RANCH
CROWN VALLEY PEDESTRIAN BRIDGE

SHEET 7 OF 7
10-0387-12