

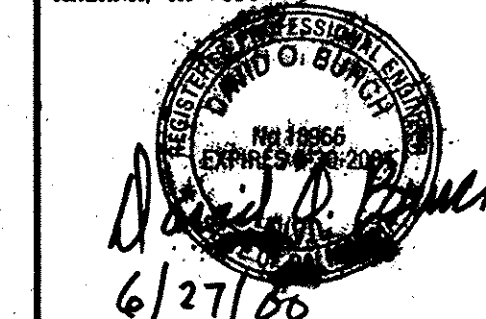
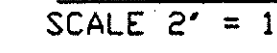
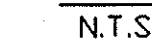
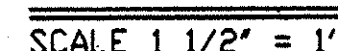
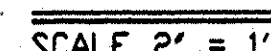
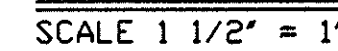
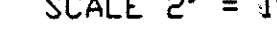
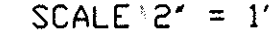
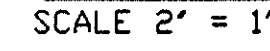
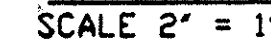
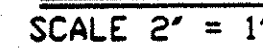
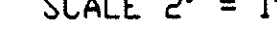
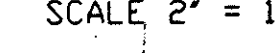


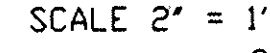

O	REVISED TOE PLATE, REMOVED LIGHT BRACKET, RFF	DDY	6/22/00	
B	REVISED PER CUSTOMER COMMENTS	DDY	5/26/00	
A	RELEASED FOR APPROVAL			
Rev	DESCRIPTION	BY/DATE	CH'D BY	

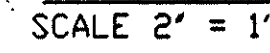

STANDARD ATTACHED OR SEEN FOR
POST AT EACH END OF BRIDGE

STEELFAST BRIDGES
PEDESTRIAN TRAFFIC
LIGHT TRUCKLE
MAXIMUM LOAD
5 TONS

BILTOLAT PRODUCTS INC.
P.O. BOX 1000
DAVE CITY, MISSOURI 64531
TEL: 816-291-1100
FAX: 816-291-1101
WWW.BILTOLAT.COM

**A DIVISION OF
BILTOLAT PRODUCTS INC.**
119 0400 St. NE
FORT PAYNE, AL 35967-8139
1-800-745-7315



ACTIVE MEMBER

JOB: 10-5 1/4" x 223'-4" "KEYSTONE" BRIDGE

FOR: ORANGE COUNTY, CALIFORNIA

ADDRESS: RANCHO MISSION VIEJO, LLC

PO BOX 9

SAN JUAN CAPISTRANO, CA 92693

ARCHITECT: LAND CONCERN, LTD.

CONTRACTOR:
FOR DESCRIPTION:
LADERA RANCH PROJECT NO. 10-0364-12

DRAWN BY: **DDY**

APP'D BY: **RGG**

CHECKED BY: **DAG**

DATE: 12/21/99

SCALE: 1" = 5'

THIS BRIDGE STRUCTURE SHALL NOT BE FIELD MODIFIED IN ANY WAY WITHOUT
PRIOR APPROVAL FROM STEELFAST BRIDGES. THESE DRAWINGS AND DETAILS ARE
THE PROPERTY OF BILTOLAT PRODUCTS INC. AND ARE NOT TO BE COPIED OR
USED IN ANY MANNER WITHOUT THE WRITTEN CONSENT OF BILTOLAT PRODUCTS INC.

9918-5 3 OF 5