

ORANGE COUNTY ROAD DEPT.

STATE OF CALIFORNIA

PLANS FOR CONSTRUCTION OF


BULLARD LANE PEDESTRIAN BRIDGE

OVER

LA COLINA - REDHILL STORM CHANNEL

(O.C.F.C.D. FACILITY NO. F07S01)

TOTAL LENGTH - 0.01 MILE

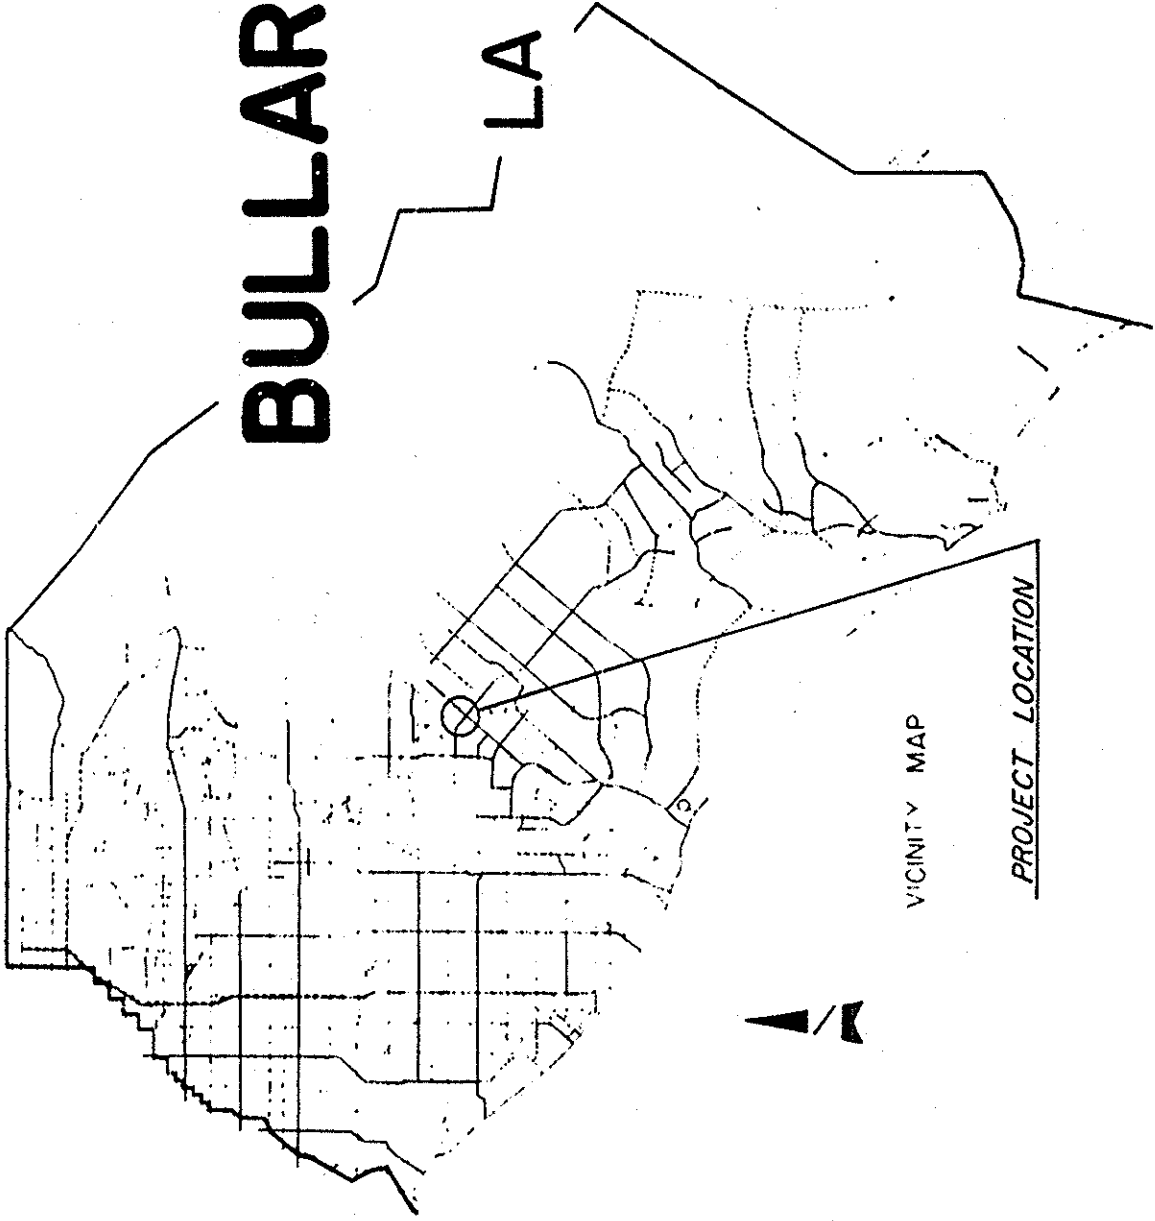


VICINITY MAP

PROJECT LOCATION

BENCH MARK
3E-83-71
ALUMINUM CAP - IN THE EAST PART OF THE INTERSECTION OF REDHILL AVENUE AND IRVINE BOULEVARD; 41' SOUTHEAST FROM THE CENTERLINE OF REDHILL, 77' NORTHEAST FROM THE CENTERLINE OF IRVINE, 65' EAST FROM A POWER POLE (NO. NUMBER), SET ON THE TOP OF A CONCRETE POST, 85' SOUTHEAST FROM THE NORTH-NORTHEAST CORNER RETURN, 0.5' BEHIND THE BACK OF THE SIDEWALK, LEVEL WITH THE SIDEWALK
ELEVATION: 116.481
ADJUSTED 1971

BASIS OF BEARING
1 OF REDHILL AVENUE, N 39° 59' 20" E PER TRACT NO. 1938 AND TRACT NO. 1821

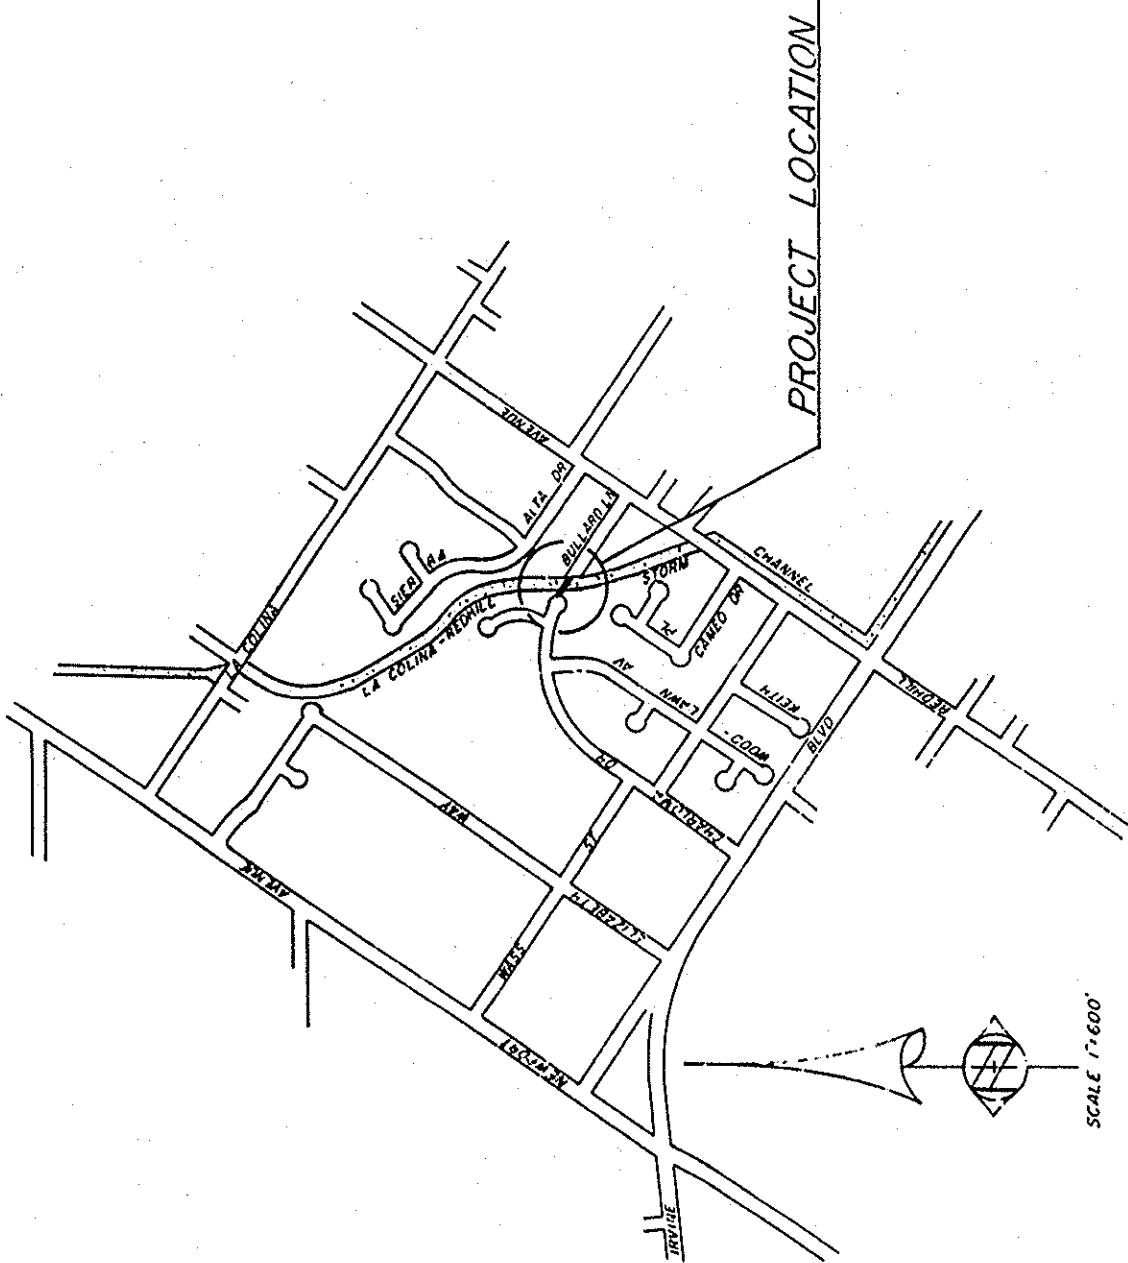

PROJECT LOCATION

SCALE 1"=600'

SHEET NO.	INDEX DESCRIPTION
1	TITLE SHEET
2	PLAN & DETAILS
3	FENCE DETAILS

ORANGE COUNTY FLOOD CONTROL DISTRICT
All installations and work affecting Flood Control District facilities shall conform with District's standard specifications and with the provisions of the construction permit granted by District. Contractor shall maintain a copy of said permit and stamped plans on the job site. Use of District property and conformance with the above shall be subject to inspection and approval by District's duly assigned inspector.
DISTRICT INSPECTOR SHALL BE NOTIFIED PRIOR TO COMMENCEMENT OF ANY WORK IN ACCORDANCE WITH PERMIT PROVISIONS.

CONTRACTOR:
SUNSET CONST.

APPROVED *W.R. Jansen* 6/19/75
FOR ROAD COMMISSIONER R.C.E. #978 DATE

DR. 10 (12-095) #12095
BULLARD Lane Pedestrian BR.
PBR-2 1975
SSC-206
Thomas: 830-022